
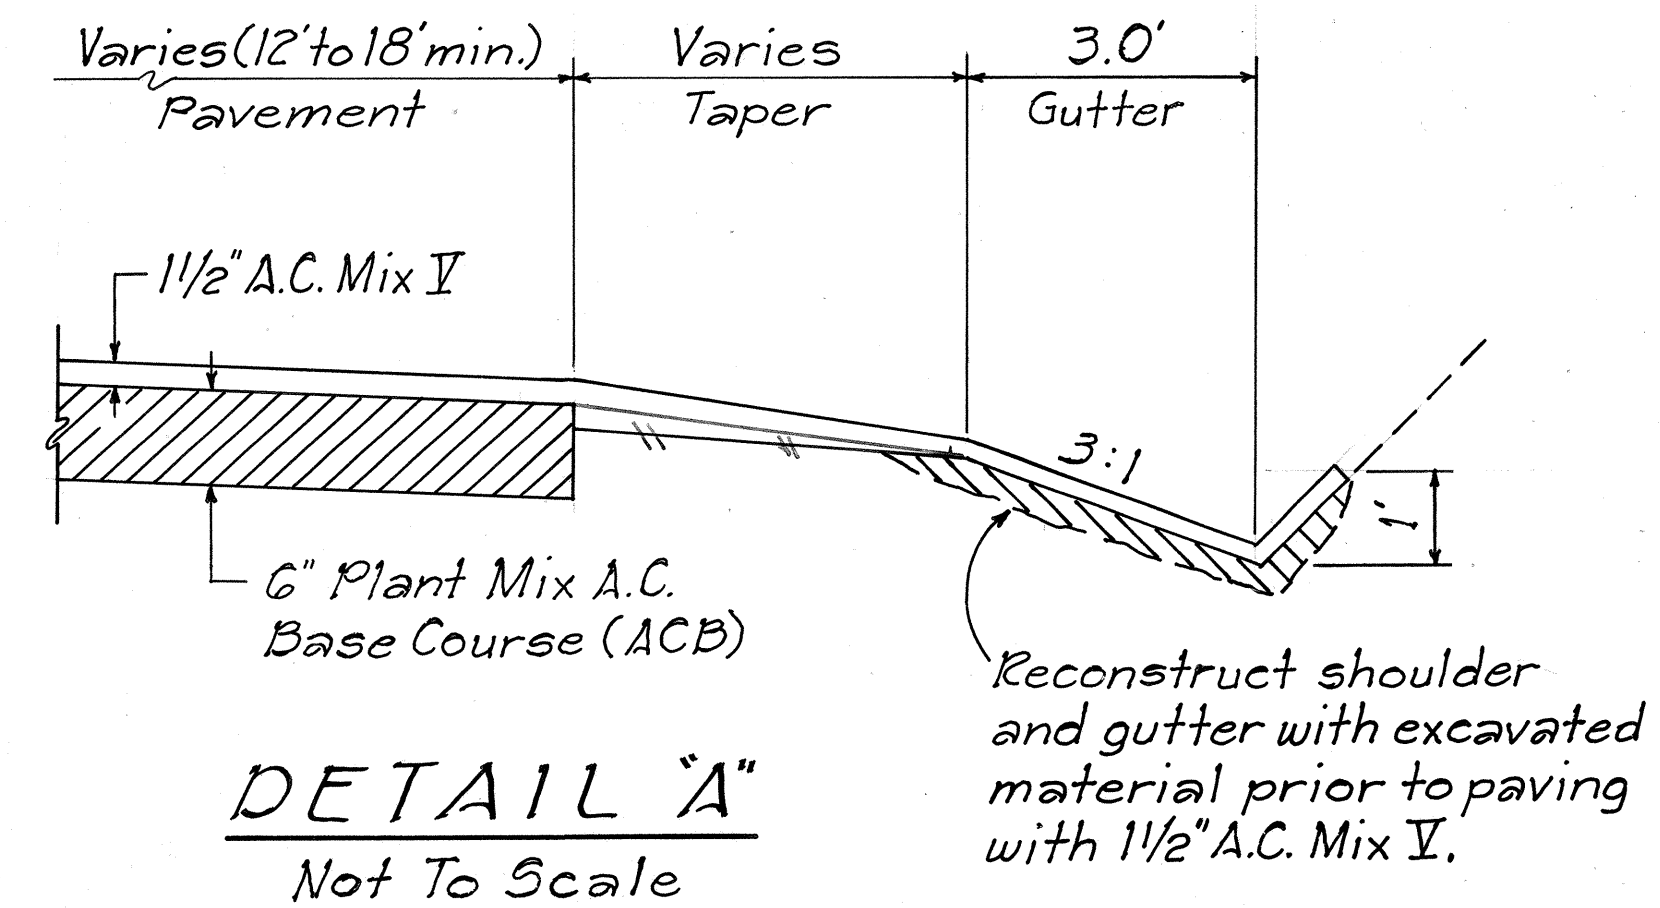
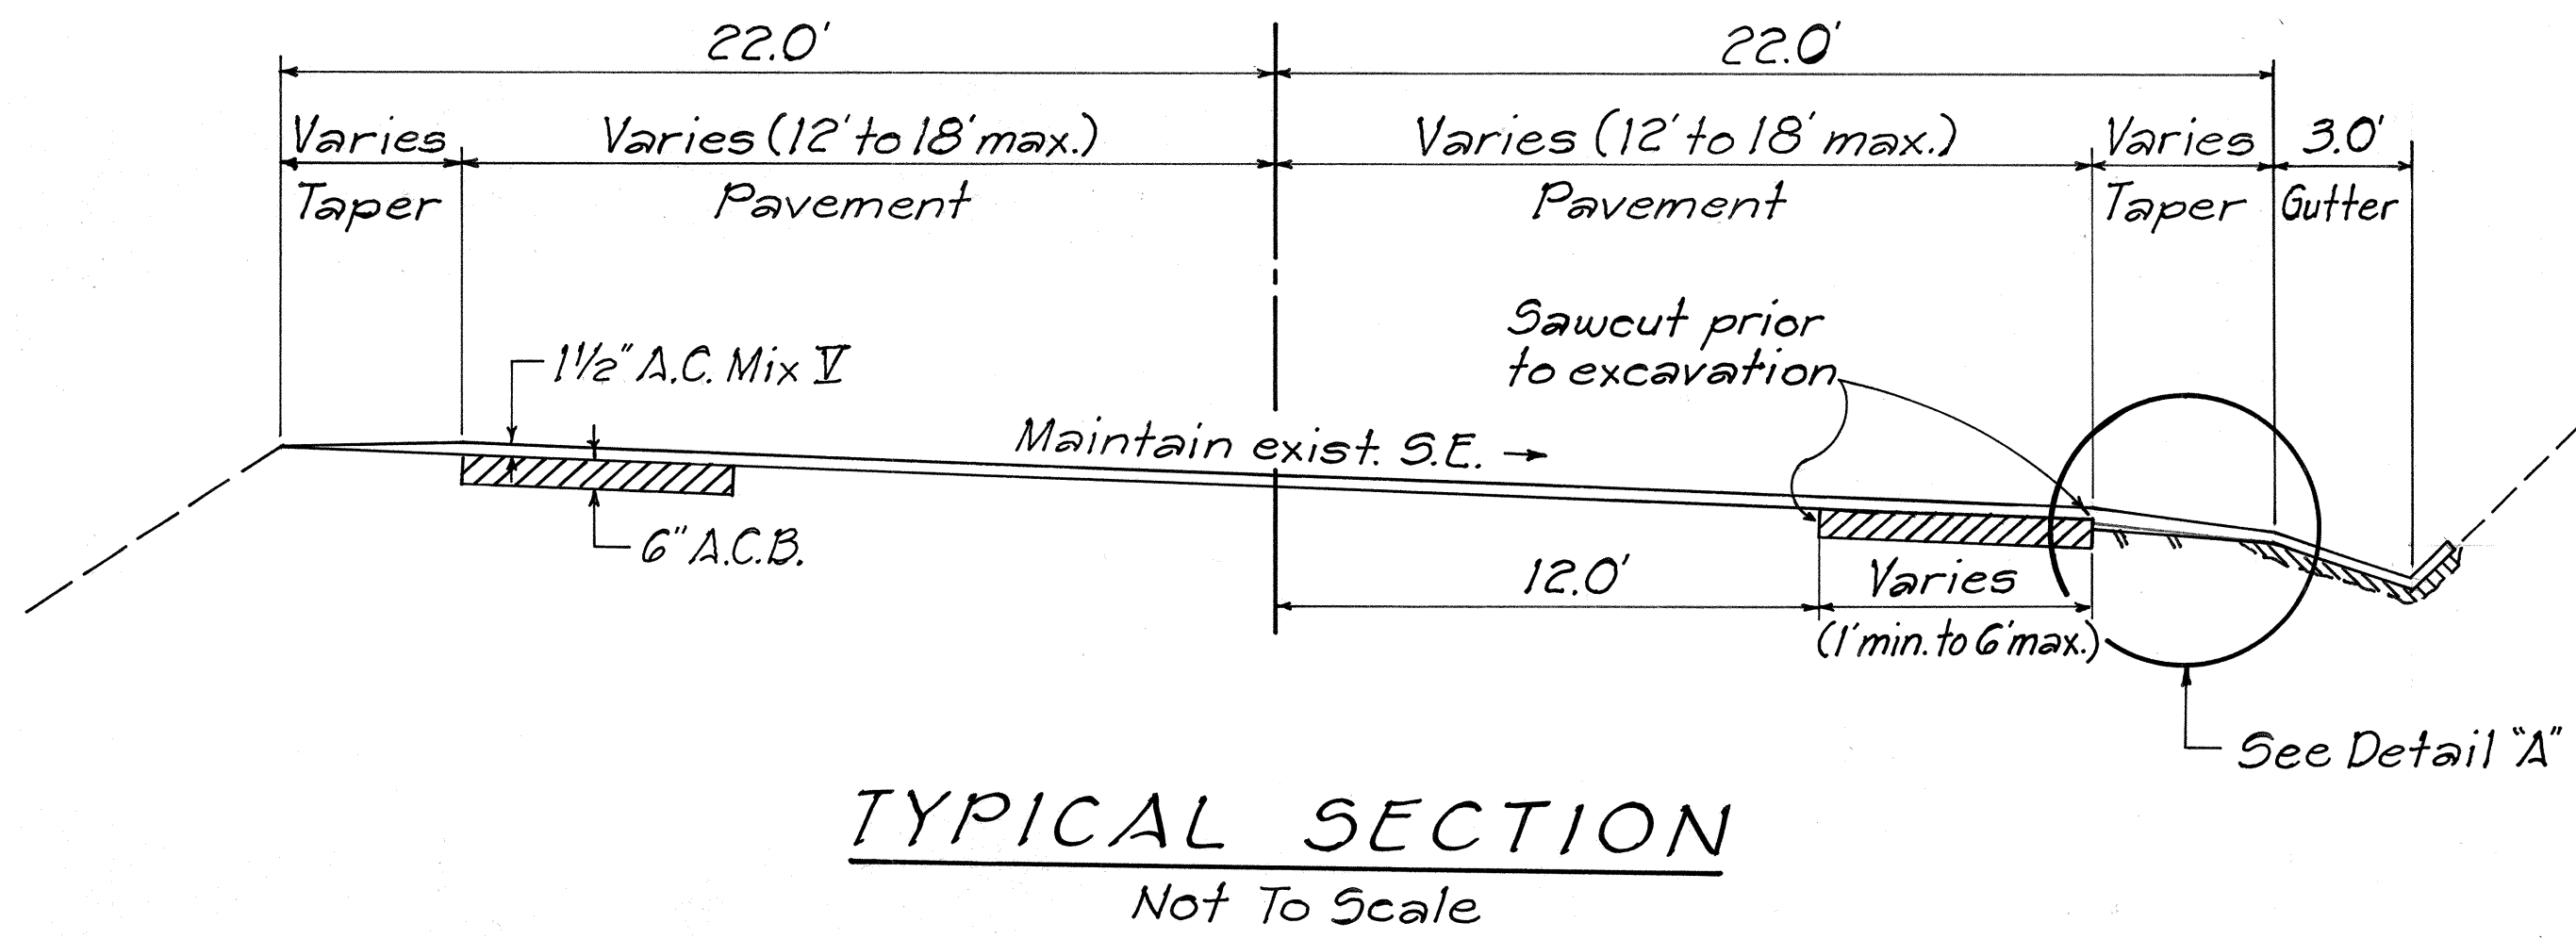
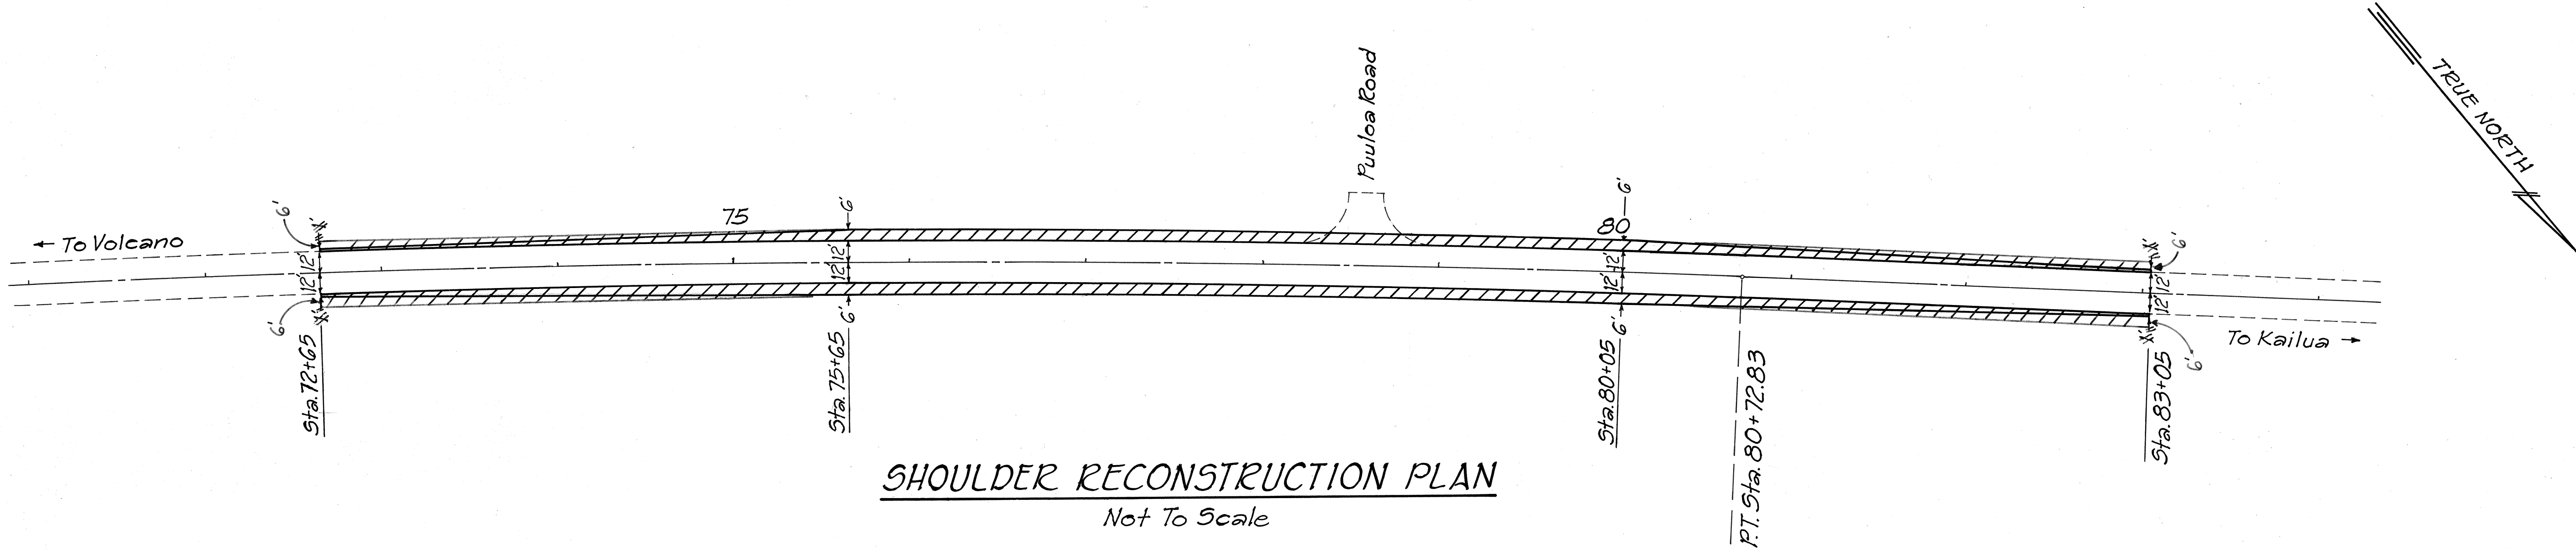


FED. ROAD DIST. NO.	STATE	PROJ. NO.	FISCAL YEAR	SHEET NO.	TOTAL SHEETS
HAWAII	HAW.	11A-01-92M	1992	7	12

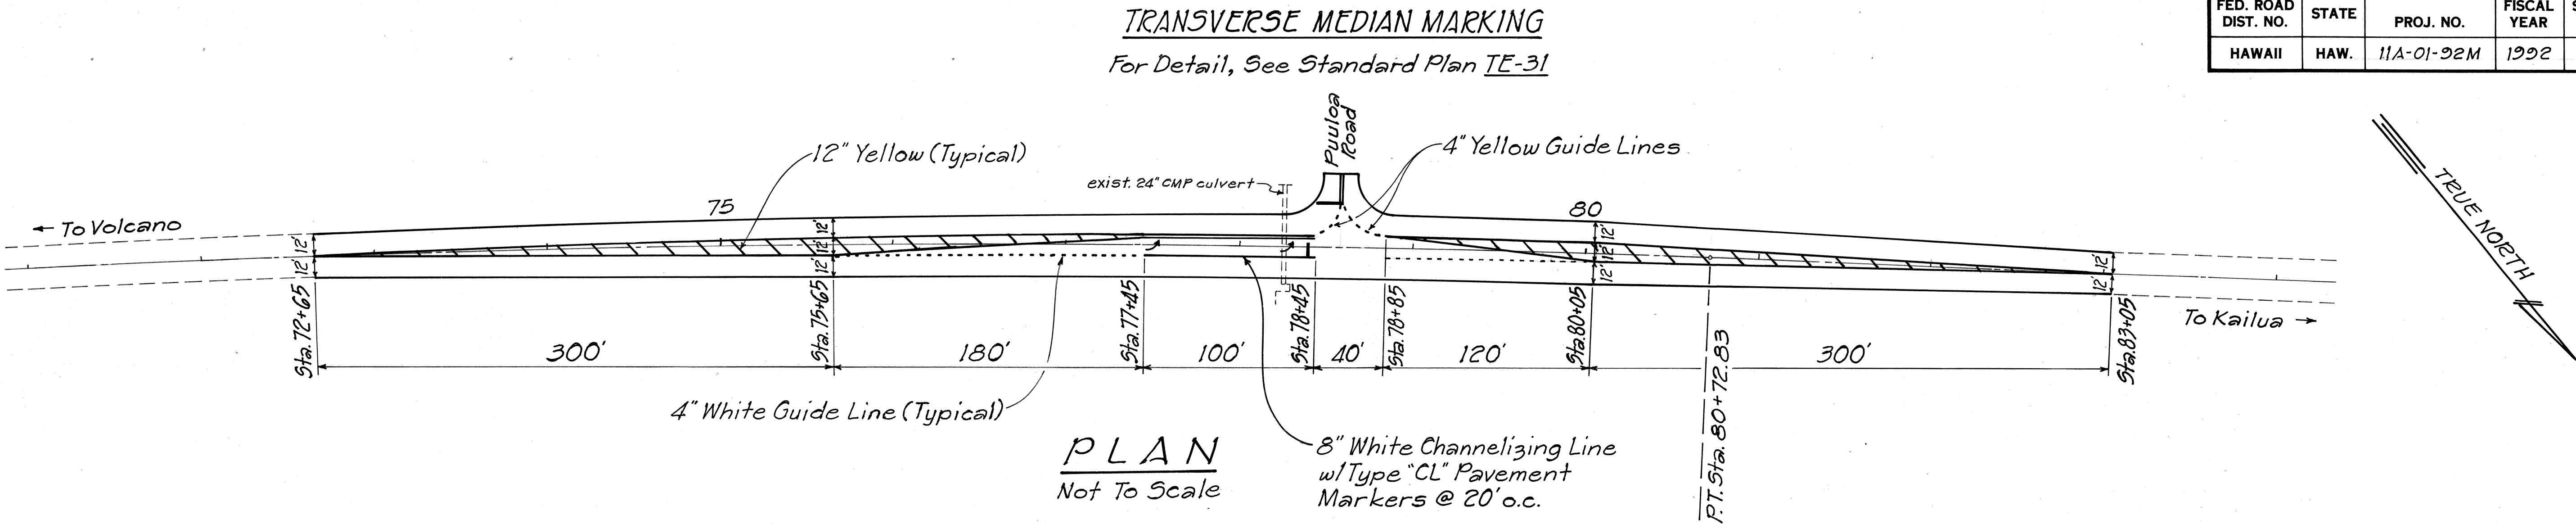

STATE OF HAWAII
DEPARTMENT OF TRANSPORTATION
HIGHWAYS DIVISION

CHANNELIZING DETAIL
PUULOA ROAD INTERSECTION
STA. 72+65 to STA. 83+05
KUAKINI HIGHWAY RESURFACING
HONALO TOWARDS KEAUHOU
PROJECT No. 11A-01-92M

Scale: As Noted Date: July 1991

SHEET No. 1 OF 1 SHEETS

ORIGINAL PLAN	SURVEY PLOTTED BY	DATE
NOTE BOOK	DRAWN BY	
	DESIGNED BY	
	CHECKED BY	