



FED. ROAD DIST. NO.	STATE	PROJ. NO.	FISCAL YEAR	SHEET NO.	TOTAL SHEETS
HAWAII	HAW.	11A-01-22M	1992	11	12

RECONSTRUCTION AREA SCHEDULE

	STATION		OFFSET FROM ± (FT.)		LENGTH (Lin. Ft.)	WIDTH (Ft.)	APPROX. AREA (Sq. Ft.)	
	FROM	TO	LEFT	RIGHT				
0+72.00	0+72.66	1+00	6		173	12	2,076	2,064
0+72.00	0+72.66	0+50	65.5		122	12	1,463	1,464
	1+00	3+70	3		270	6	1,620	
1+49	1+15	3+97	65.5		248	12	2,976	2,976
3+97	2+15	6+72	65.5		275	12	3,300	3,300
	2+80	4+20	5.5		140	11	1,540	
	4+65	6+00	5.5		135	11	1,485	
	6+00	6+50	8		50	6	300	
	6+50	6+70	5.5		20	11	220	
6+72	6+70	7+70	8		98	6.3	600	617.4
7+70	7+00	8+30	5.5		60	12	720	720
	7+70	8+30	65.5		60	12	720	720
	8+30	10+80	9		250	6.3	1,000	1,575
	10+10	10+40	3		30	6	180	
	10+80	11+10	65.5		30	12	330	360
12+00	12+20	13+30	65.5		623	12	7,476	7,476
	13+30	14+80	2.5		90	5	450	
	14+00	15+40	3		530	6.3	3,240	3,395.7
	14+80	15+50	5.5		70	11	770	
	15+50	16+30	9		80	4	320	
	16+30	17+40	5.5		110	11	1,210	
18+23	18+00	21+20	65.5		297	12	3,564	3,564
	19+60	19+90	9		30	4	120	
	20+20	20+80	2.5		60	5	300	
	21+80	27+10	5.5		530	12	5,830	6,360
	22+50	22+70	6.0		20	11	220	
	27+00	29+25	3		225	6	1,350	
	29+25	30+90	8		165	6	990	
	30+90	32+50	5.5		160	12	1,760	1,908
	33+20	33+50	5.5		30	11	330	
	34+20	34+40	5.5		20	11	220	
	48+30	48+50	5.5		20	12	220	240
	48+30	48+50	6.0		20	12	220	240
	60+50	62+50	3		200	6	1,200	
60+51	65+00	62+51	5.5		200	6.3	550	1,260
	65+20	65+80	3.0		60	11	660	
	70+80	72+80	5.5		200	11	2,200	
100+58	100+50	102+20	65.5		131	12	1,572	1,644
	104+90	105+30	5.5		40	11	440	
TOTAL							40,293.6	
							40,784	

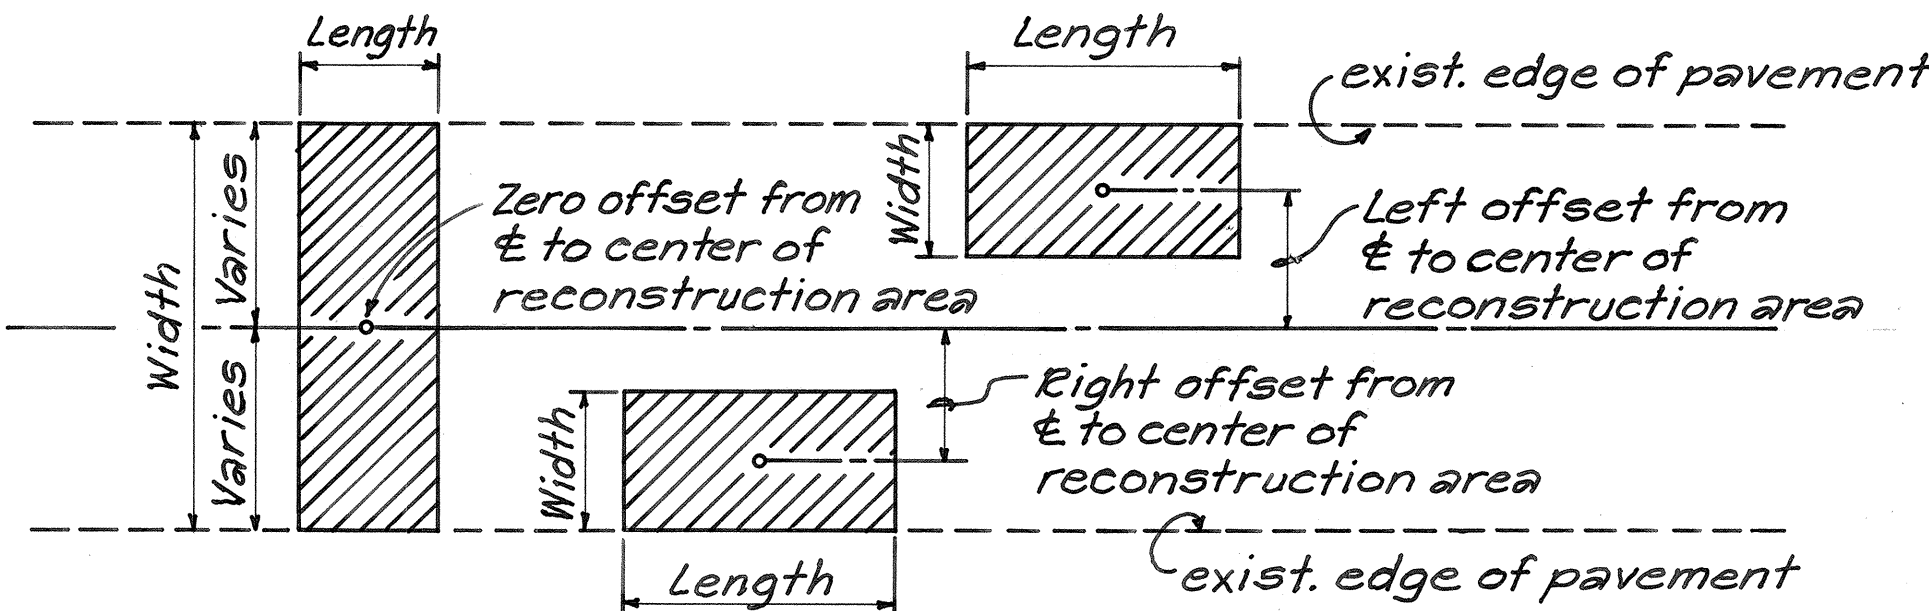

TYPICAL PLAN

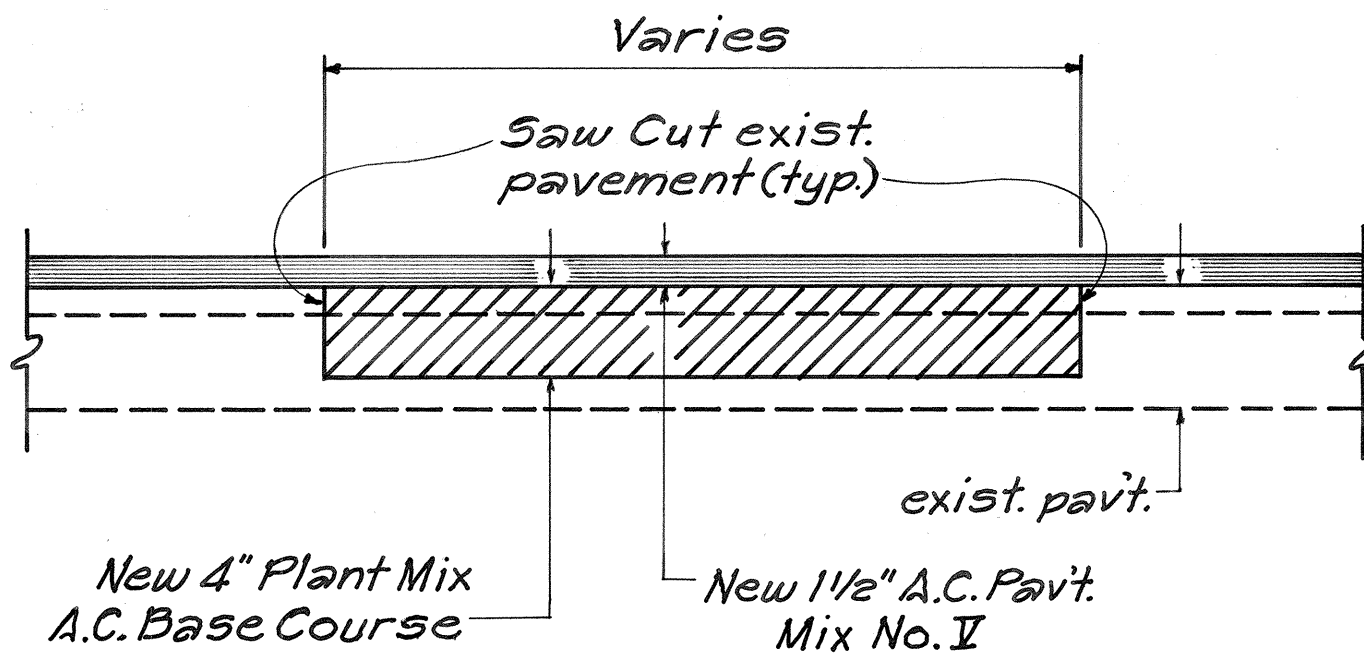

TYPICAL SECTION

PAVEMENT RECONSTRUCTION DETAIL

NOT TO SCALE

ORIGINAL PLAN	DATE
SURVEY PLOTTED BY	
DRAWN BY	
DESIGNED BY	
QUANTITIES BY	
CHECKED BY	
NO.	