


FED. ROAD DIST. NO.	STATE	PROJ. NO.	FISCAL YEAR	SHEET NO.	TOTAL SHEETS
HAWAII	HAW.	11A-01-92M	1992	5	12

CONSTRUCTION SIGNS

For Construction Sign Detail and Schedule, See Plan Sheet No. 12.

STA. 4+00 to STA. 8+50 Lt.

Install 4-sets Rumble Strips
See Plan Sheet No. 8 for Details.

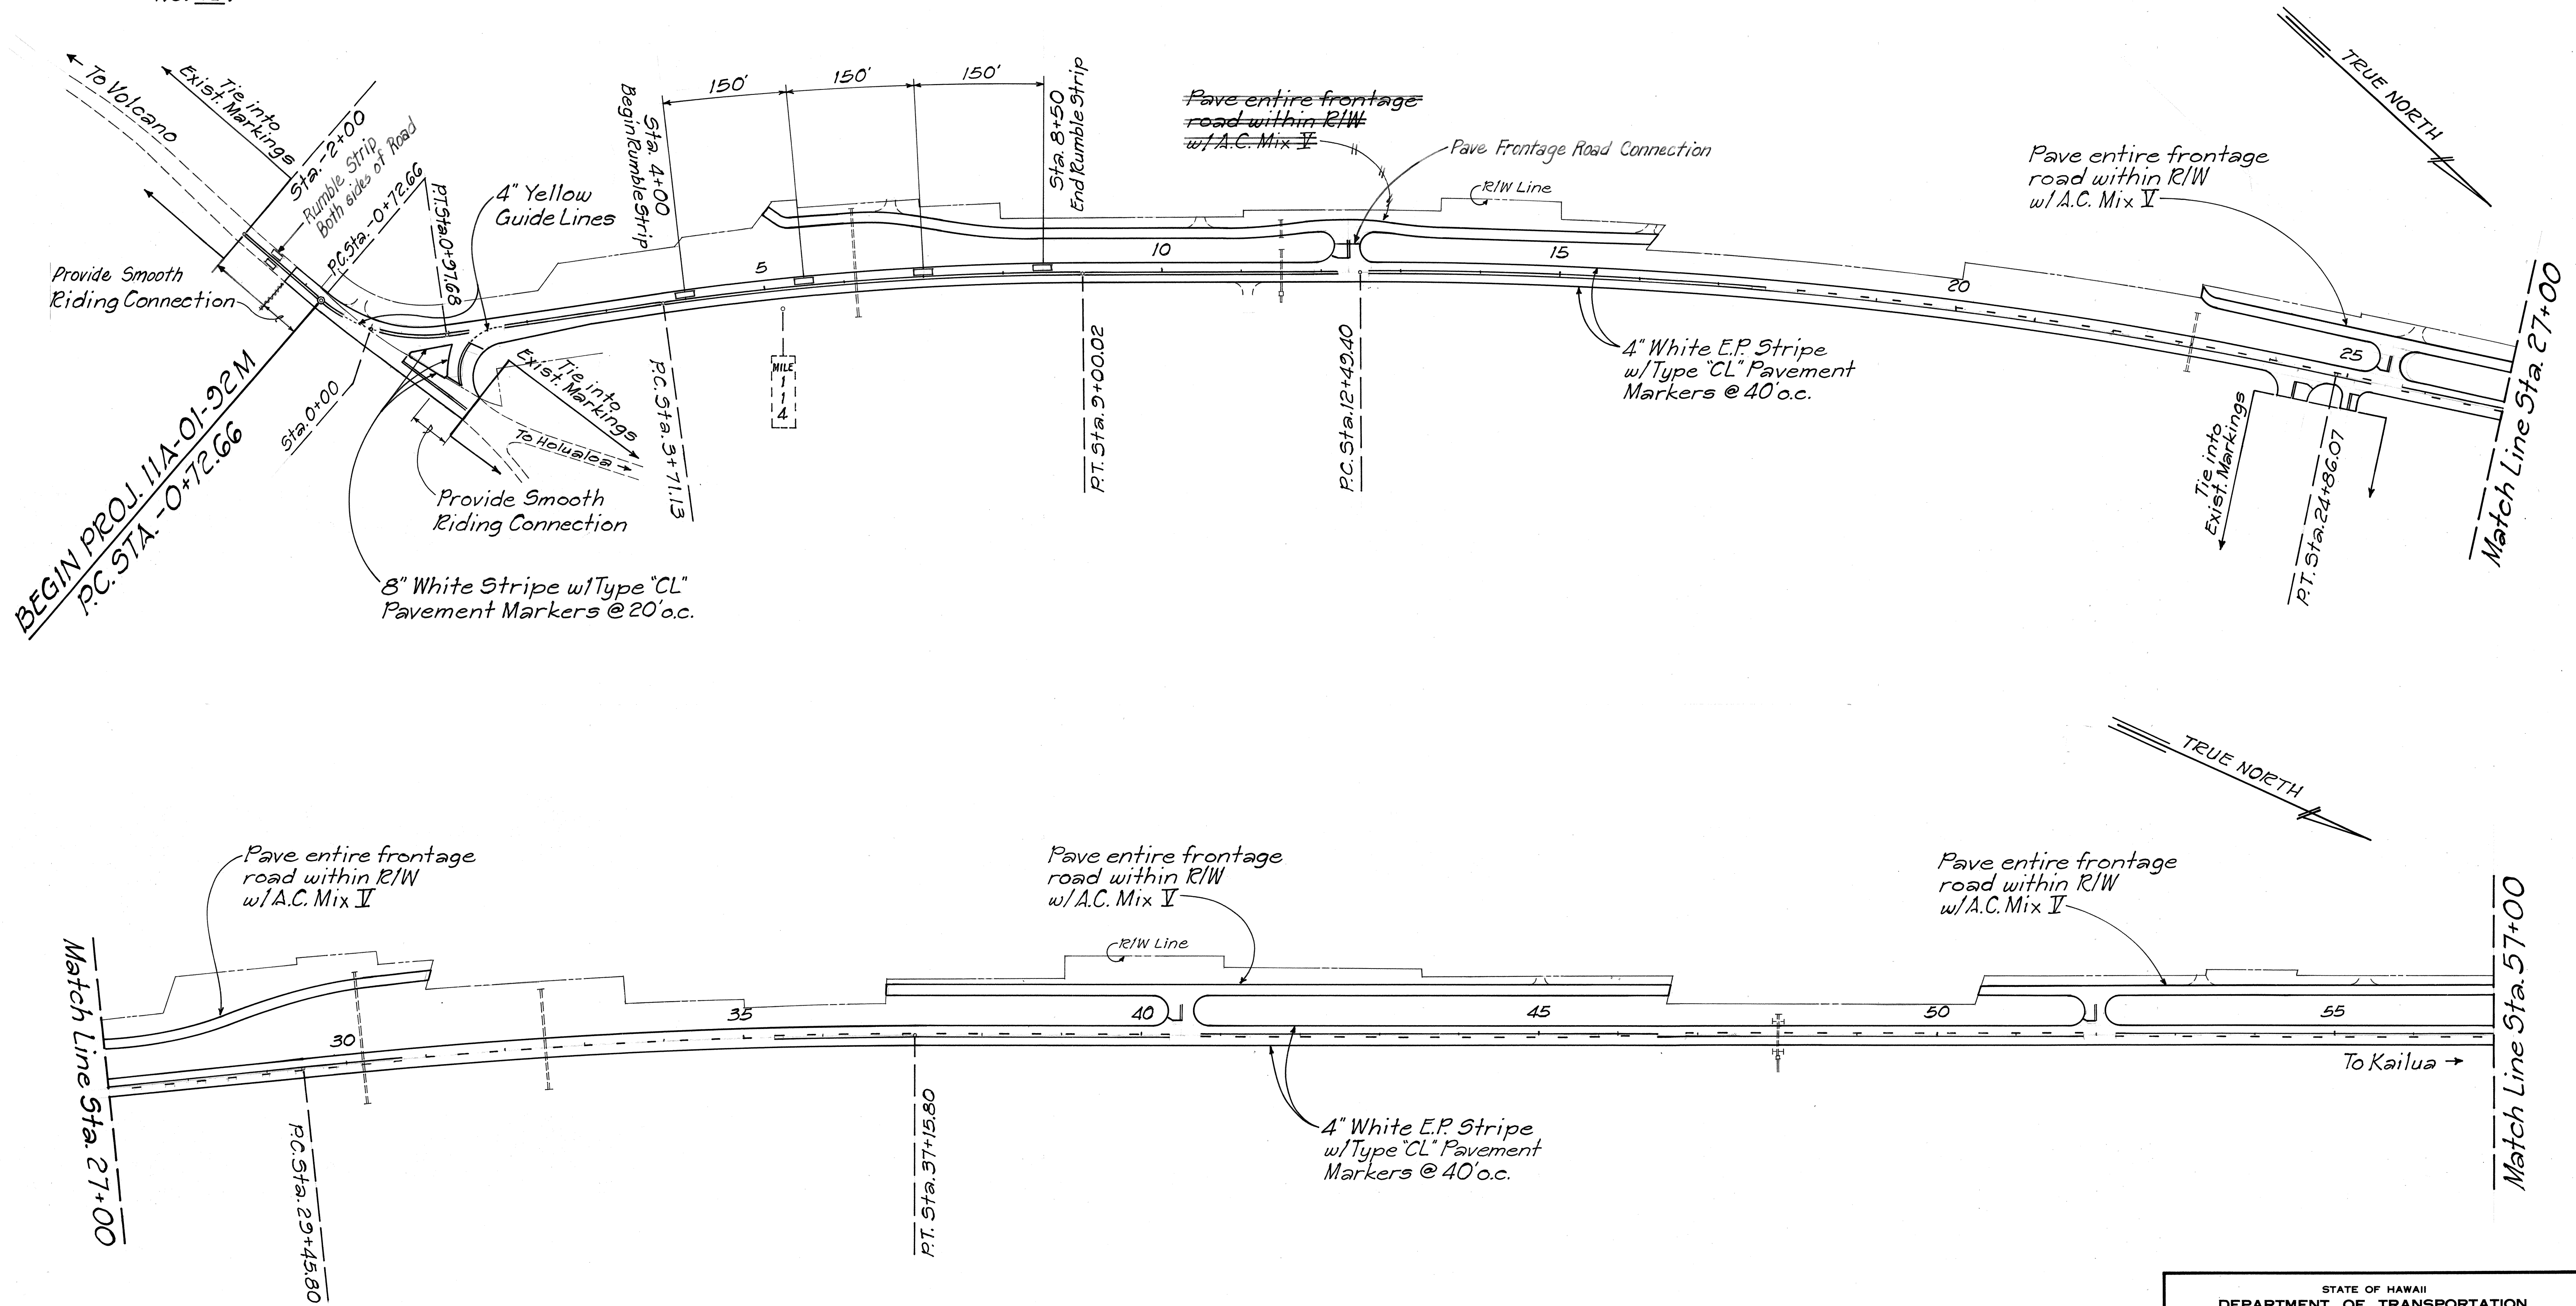

SURVEY PLOTTED BY	DATE
DRAWN BY	
DESIGNED BY	
QUANTITIES BY	
CHECKED BY	
ORIGINAL PLAN	
NOTE BOOK	
No.	

STATE OF HAWAII
DEPARTMENT OF TRANSPORTATION
HIGHWAYS DIVISION

ROADWAY & STRIPING PLAN


KUAKINI HIGHWAY RESURFACING
HONALO TOWARDS KEAUHOU
PROJECT No. 11A-01-92M

Scale: 1"=100' Date: July 1991


SHEET No. 1 OF 2 SHEETS

FED. ROAD DIST. NO.	STATE	PROJ. NO.	FISCAL YEAR	SHEET NO.	TOTAL SHEETS
HAWAII	HAW.	11A-01-92M	1992	6	12

STA. 72+65 to STA. 83+05
 Reconstruct Shoulders for
 Channelized Intersection.
 See Plan Sheet 7.

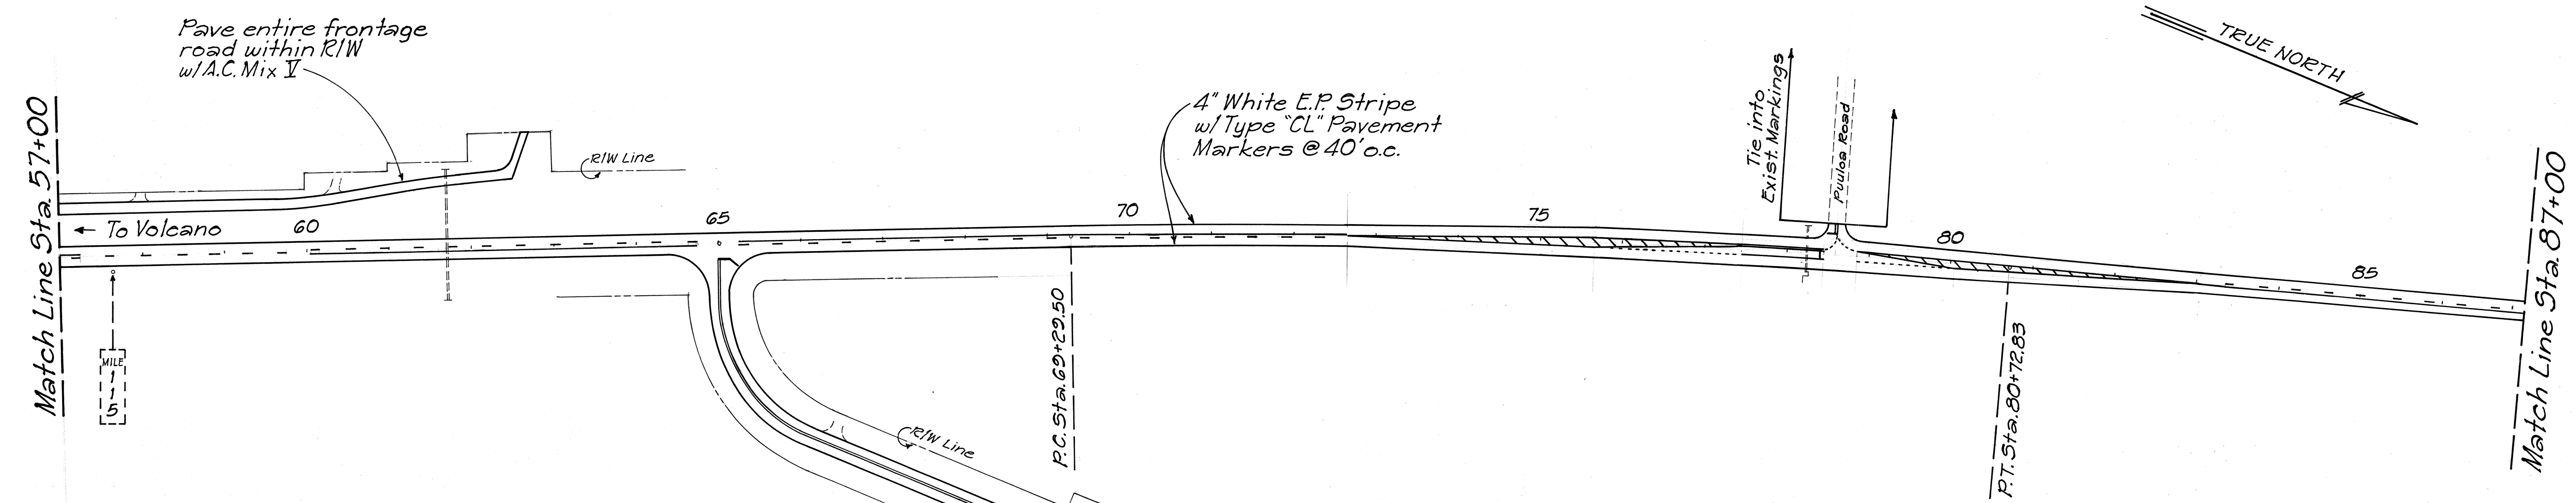

CONSTRUCTION SIGNS
 For Construction Sign
 Detail and Schedule
 See Plan Sheet No. 12.

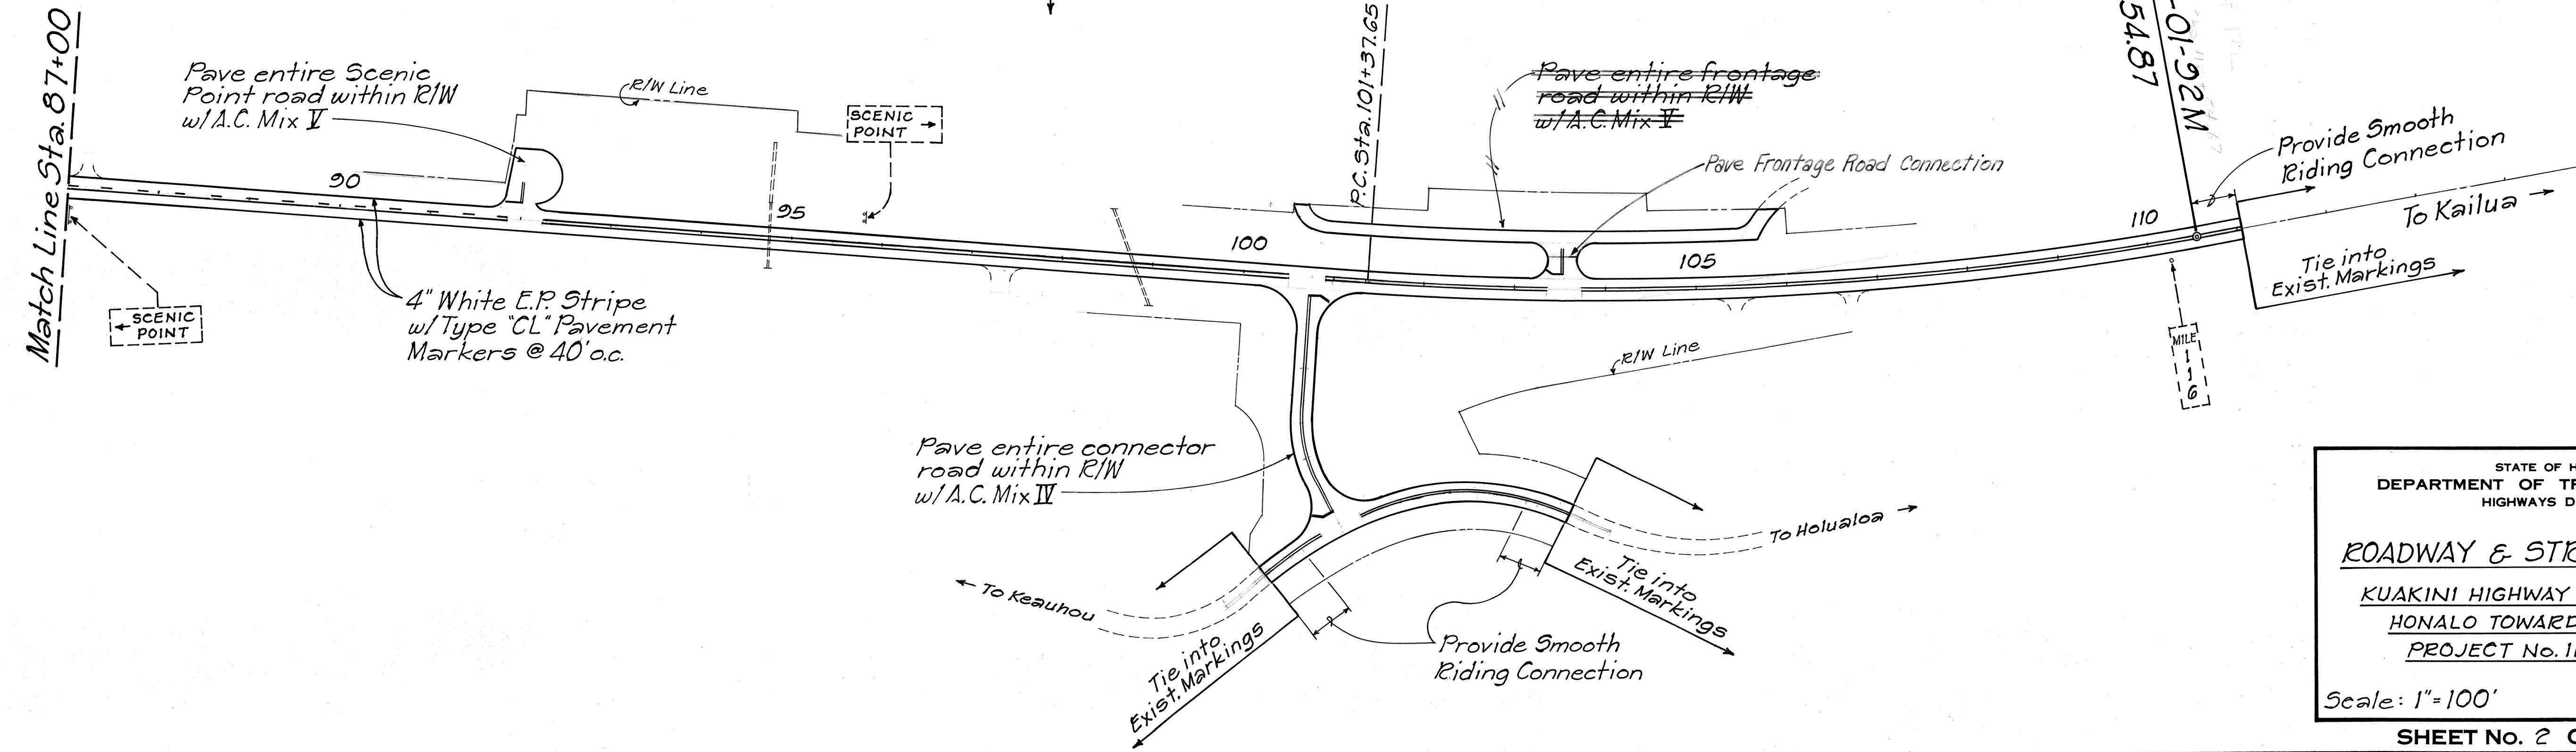

STATE OF HAWAII
 DEPARTMENT OF TRANSPORTATION
 HIGHWAYS DIVISION

ROADWAY & STRIPING PLAN
 KUAKINI HIGHWAY RESURFACING
 HONALO TOWARDS KEAUHOU
 PROJECT No. 11A-01-92M
 Scale: 1"=100' Date: July 1991
 SHEET No. 2 OF 2 SHEETS

SURVEY PLOTTED BY	DATE
DRAWN BY	
DESIGNED BY	
CHECKED BY	
ORIGINAL PLAN	
NOTE BOOK	
No.	