

INDEX TO DRAWINGS	
SHEET NO.	DESCRIPTION
1	TITLE SHEET
2	STANDARD PLANS SUMMARY
3	TYPICAL SECTIONS & DETAILS
4	TYPICAL CONNECTIONS
5-6	ROADWAY & STRIPING PLAN
7	CHANNELIZING DETAIL - PUULOA ROAD INT.
8	PAVEMENT MARKER SCHEDULE, DETAILS & NOTES
9	SIGN, ROUTE & M.P. SCHEDULE
10	REFLECTOR & OBJECT SCHEDULE
11	RECONSTRUCTION DETAIL & SCHEDULE
12	CONSTRUCTION SIGN DETAIL & SCHEDULE

STATE OF HAWAII

DEPARTMENT OF TRANSPORTATION

HIGHWAYS DIVISION

HONOLULU, HAWAII

"AS-BUILT"

PLANS FOR



KUAKINI HIGHWAY RESURFACING

HONALO TOWARDS KEAUHOU

PROJECT NO. IIA - 01 - 92 M

DISTRICT OF NORTH KONA

ISLAND OF HAWAII

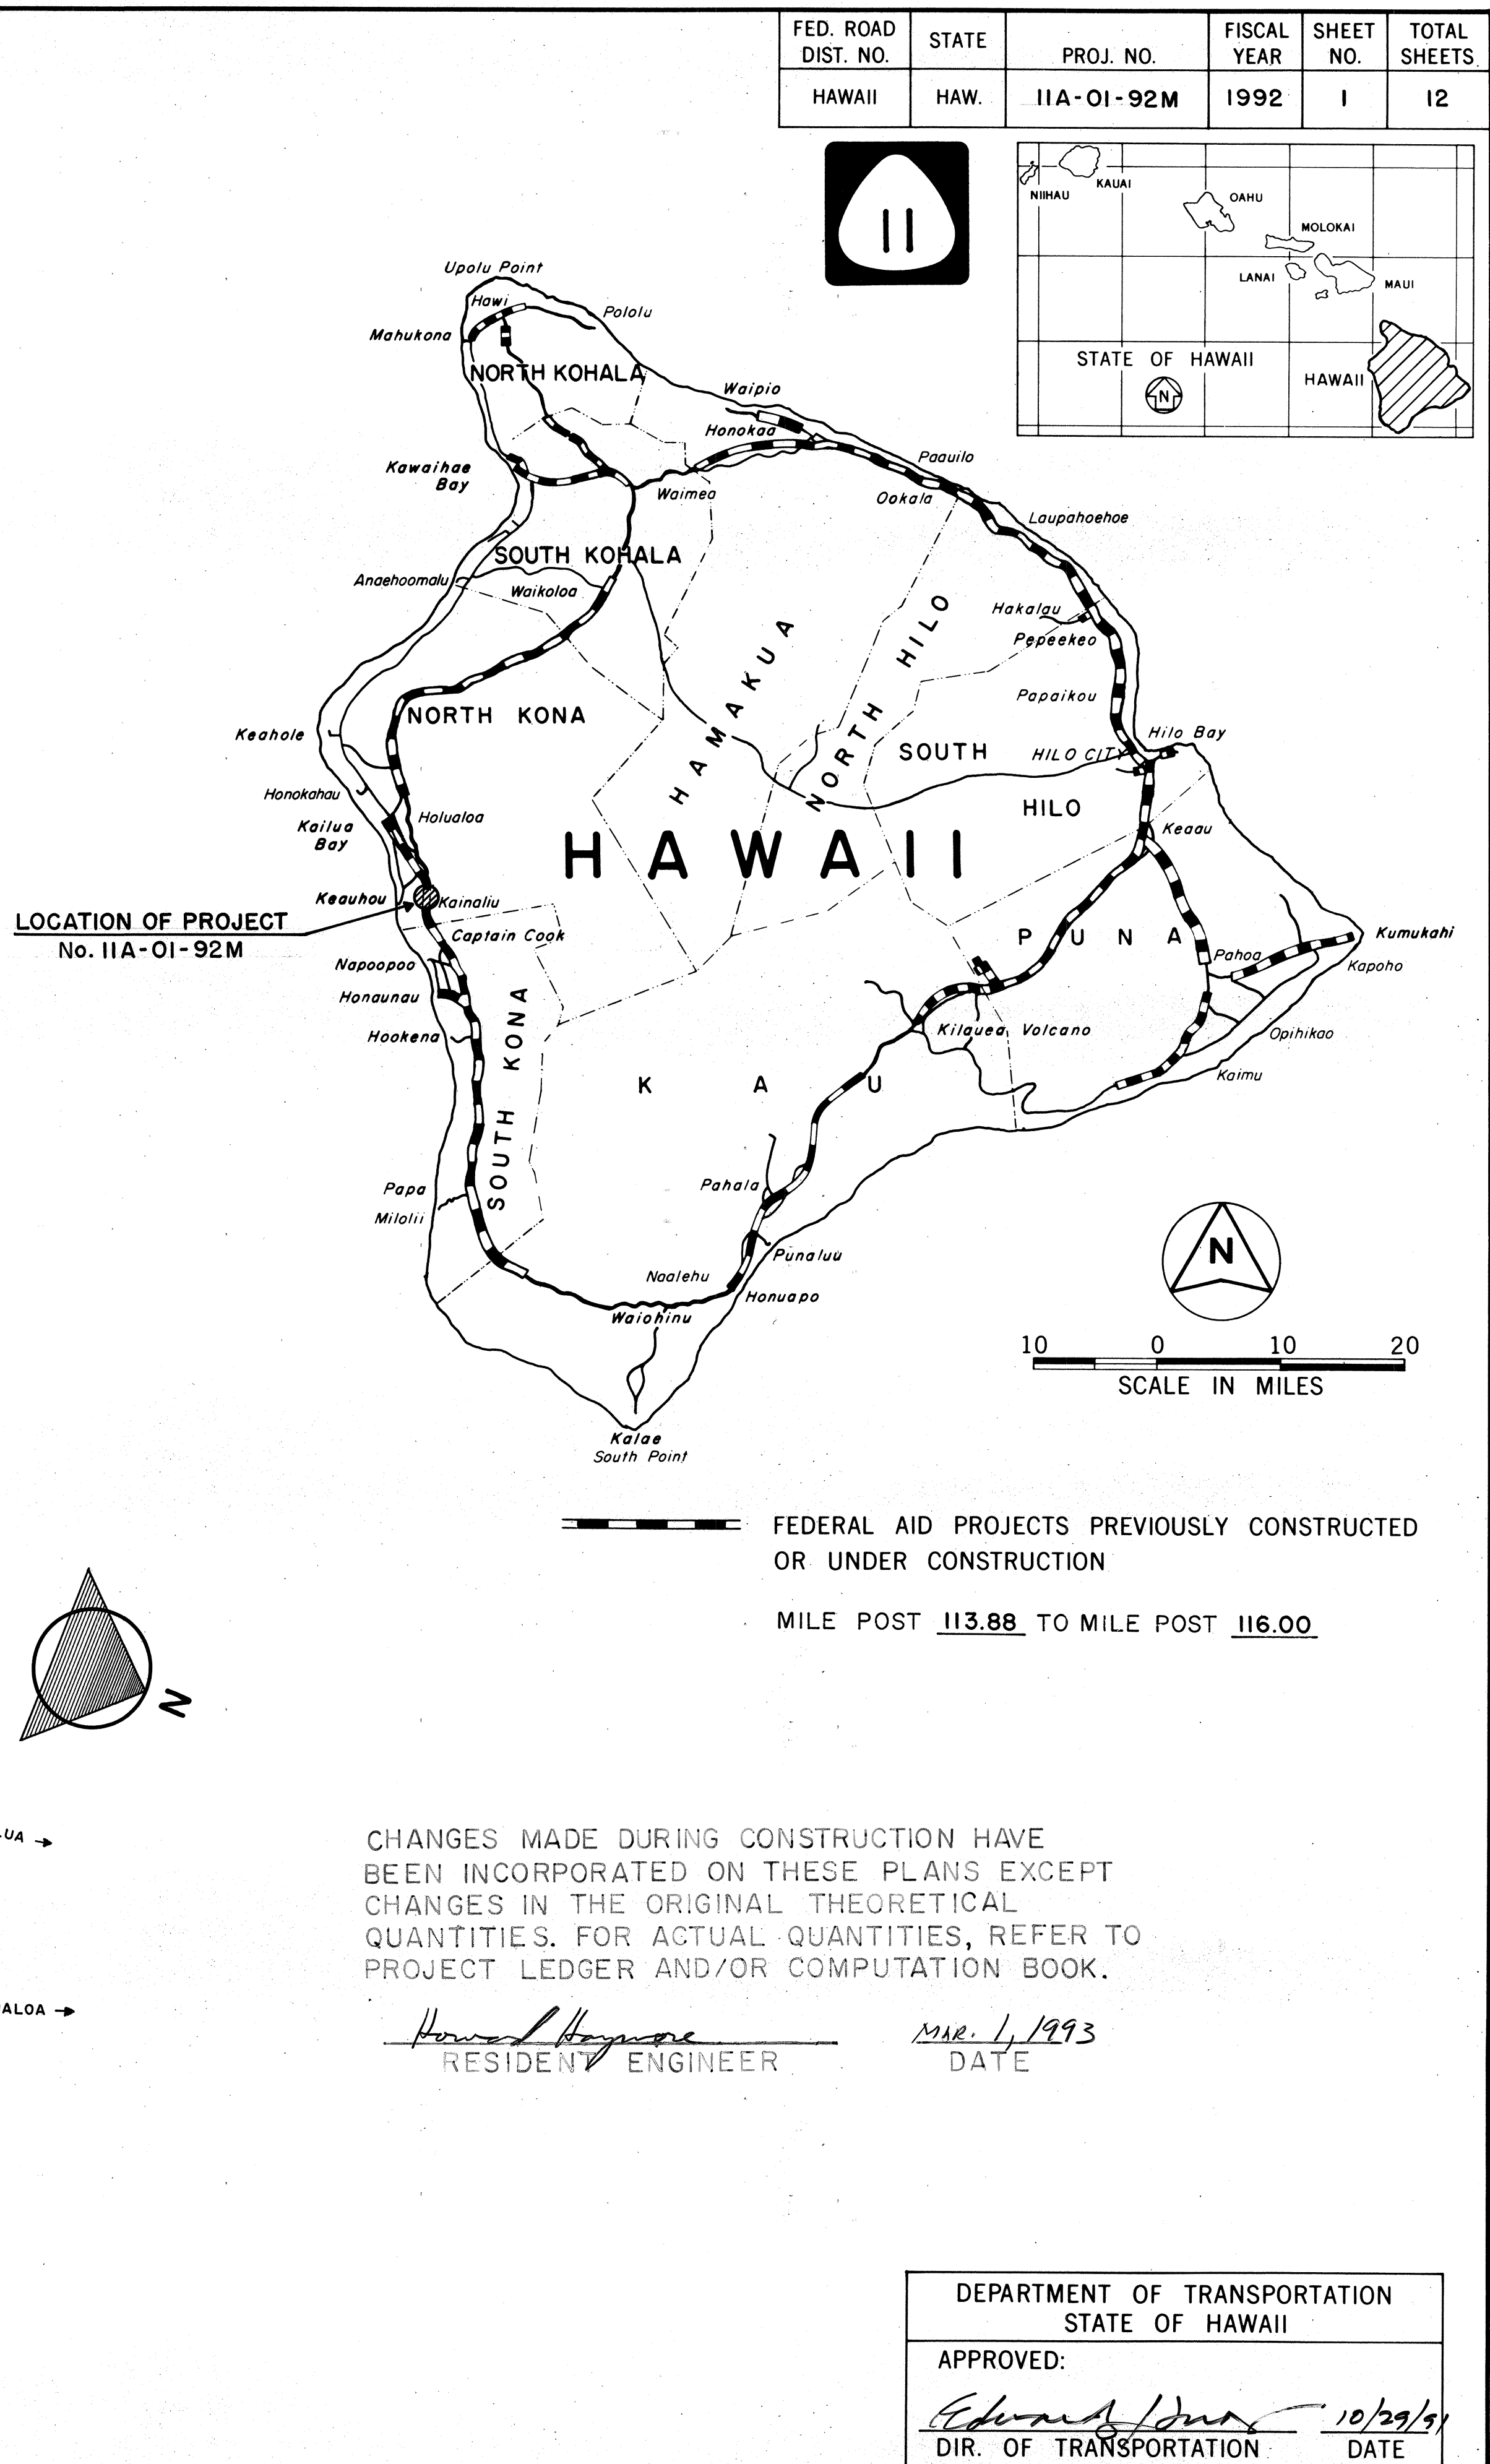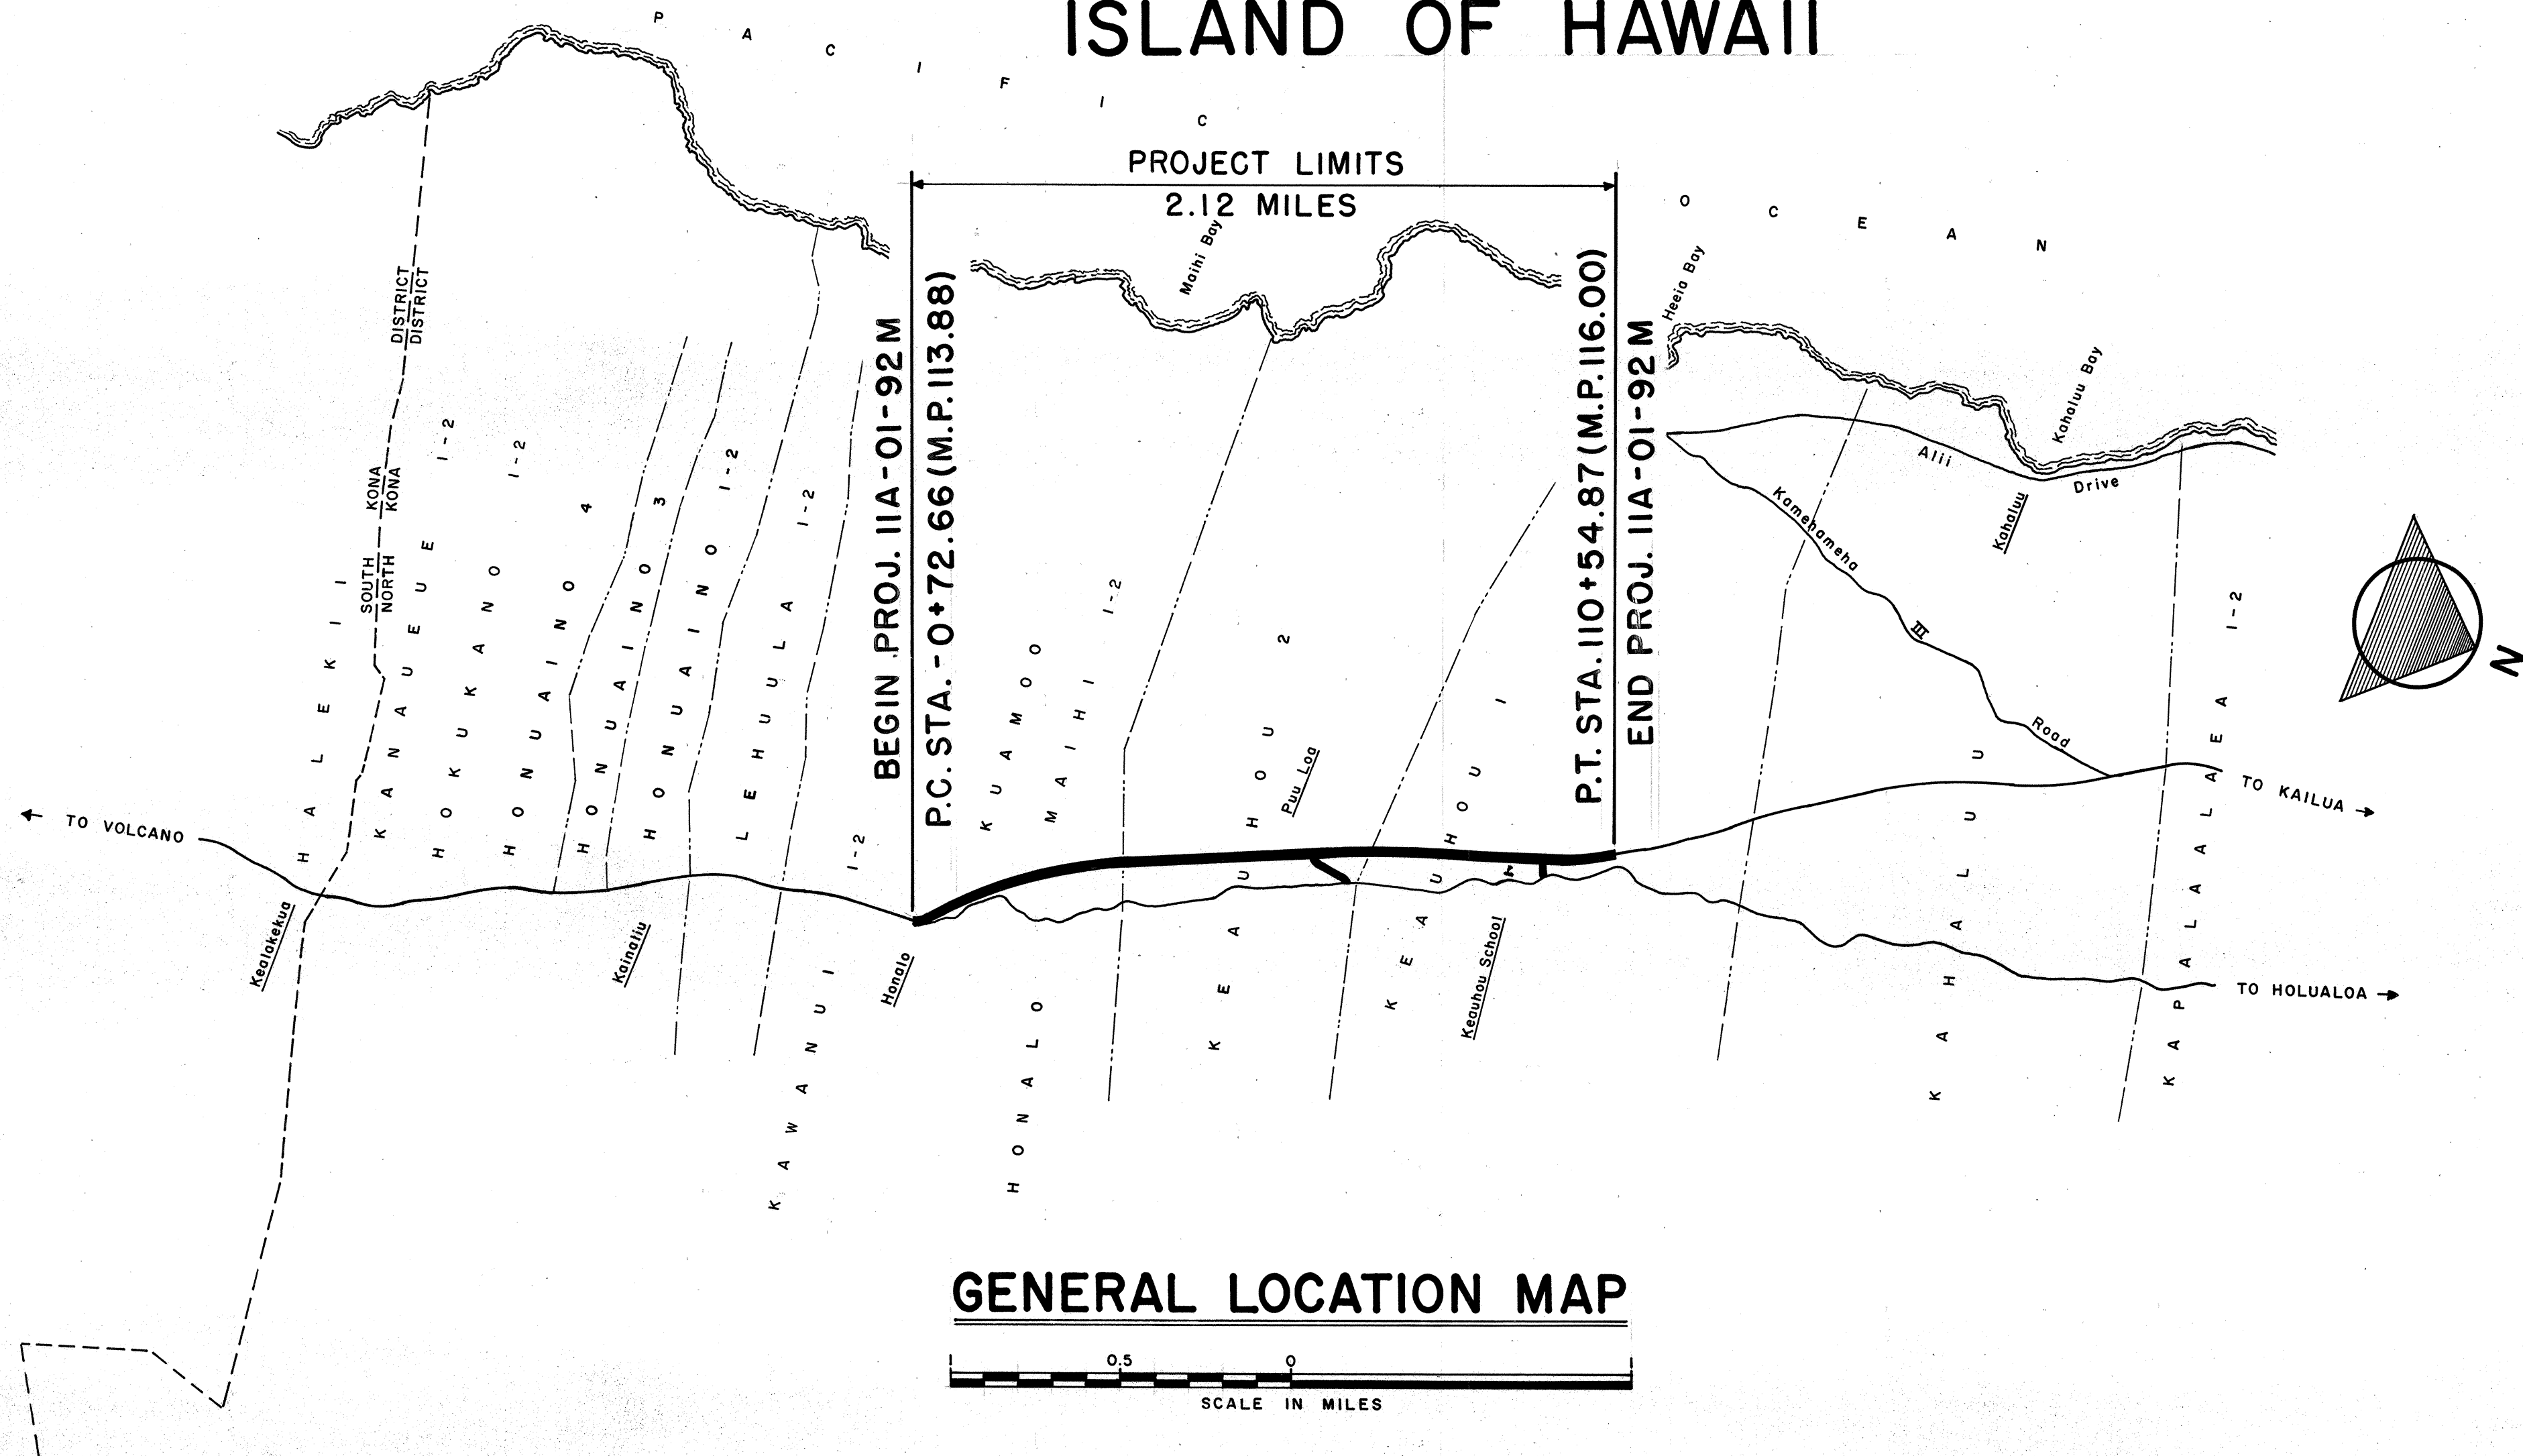

HAWAII DISTRICT

DESIGNED BY

JULIUS B. FRONDA

548-7493

SEPT. 1991

DATE

P. S. & E. BY

PHONE

CHANGES MADE DURING CONSTRUCTION HAVE BEEN INCORPORATED ON THESE PLANS EXCEPT CHANGES IN THE ORIGINAL THEORETICAL QUANTITIES. FOR ACTUAL QUANTITIES, REFER TO PROJECT LEDGER AND/OR COMPUTATION BOOK.

RESIDENT ENGINEER

MAR. 1, 1993

DATE

DEPARTMENT OF TRANSPORTATION

STATE OF HAWAII

APPROVED:

10/29/91

DATE