•	INDEX TO DRAWINGS
SHEET NO.	DESCRIPTION
Į.	TITLE SHEET
2	STANDARD PLANS SUMMARY
3	PLAN, ESTIMATED QUANTITIES & GENERAL NOTES
4	TYPICAL SECTION, BARRIER SCHEDULE, BARRIER & PAVING DETAILS

STATE OF HAWAII

DEPARTMENT OF TRANSPORTATION
HIGHWAYS DIVISION

"AS BUILT "


PLANS FOR

VOLCANO ROAD


SAFETY IMPROVEMENTS VICINITY OF SLAUGHTERHOUSE ROAD

PROJECT NO. IIN-02-91

DISTRICT OF PUNA ISLAND OF HAWAII

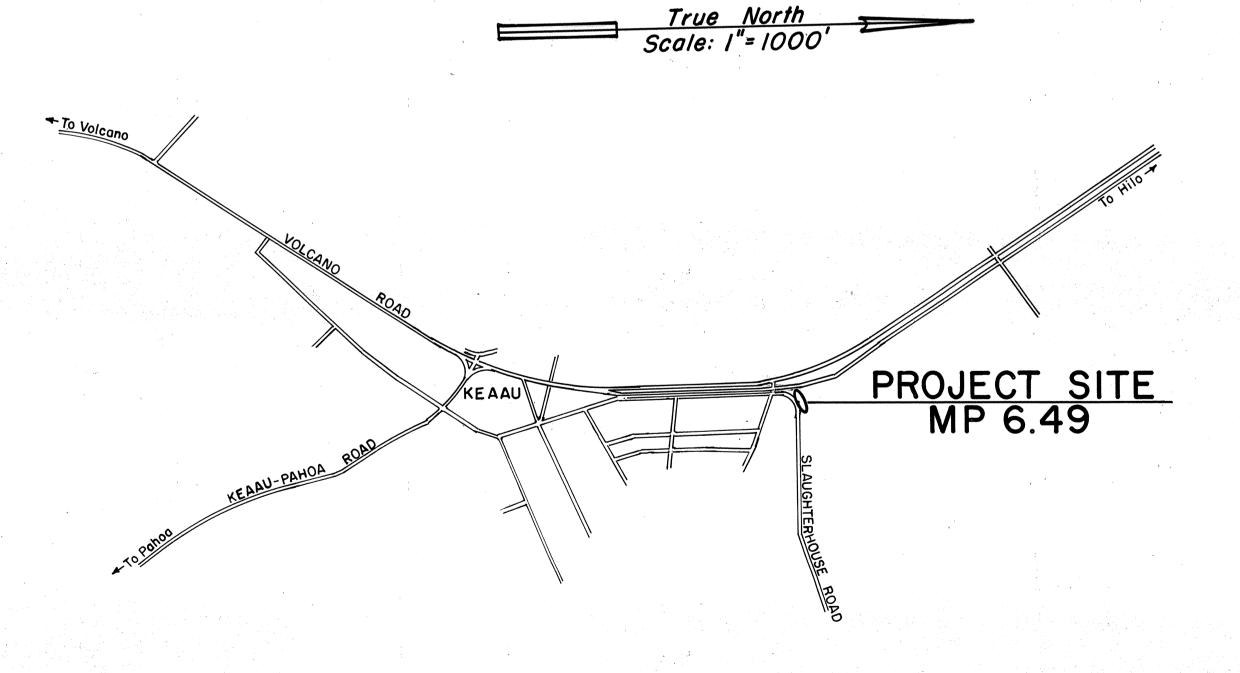

LOCATION PLAN

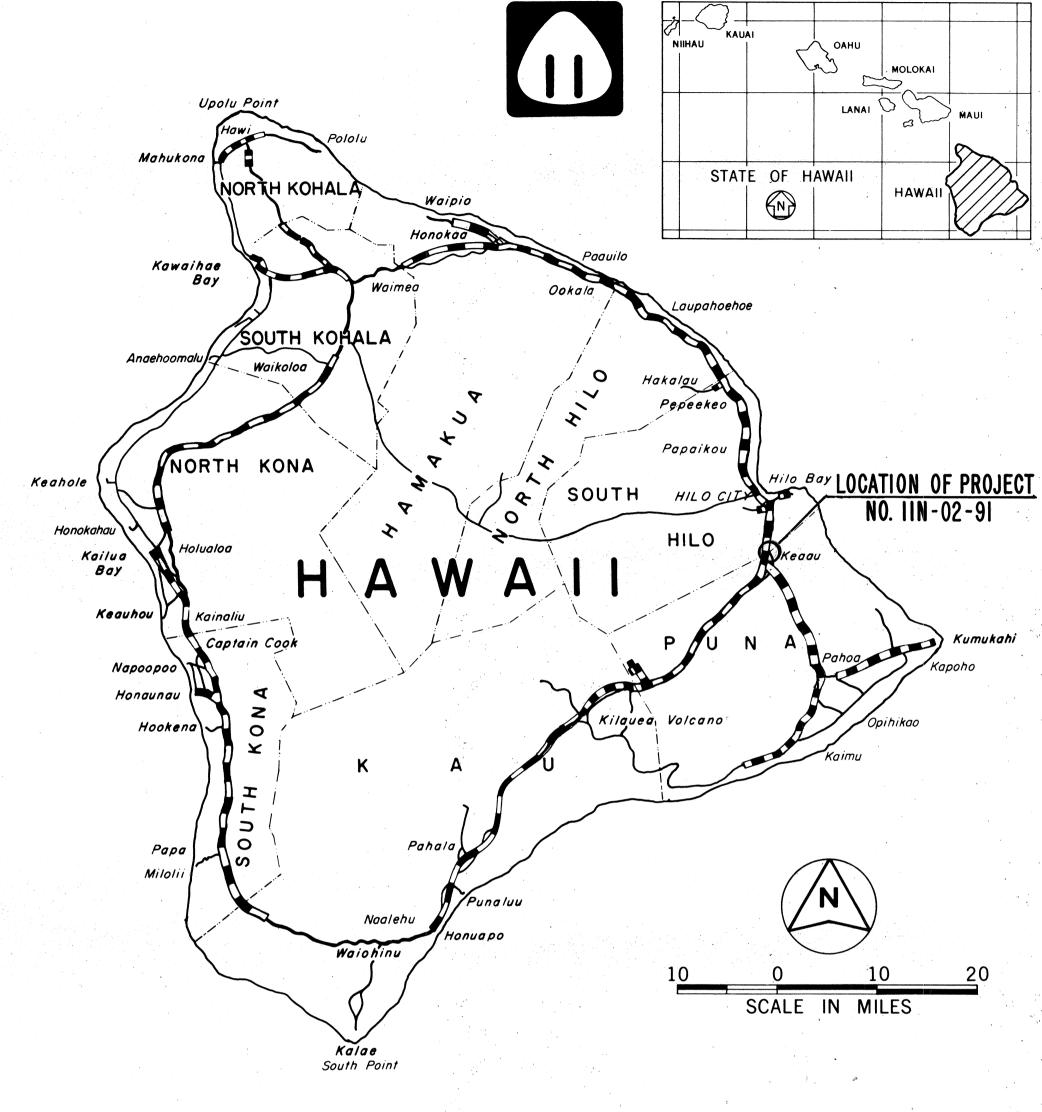

FED. ROAD DIST. NO. FISCAL SHEET YEAR NO.

1992

PROJ. NO.

IIN-02-91

FEDERAL AID PROJECTS PREVIOUSLY CONSTRUCTED
OR UNDER CONSTRUCTION

MILE POST 6.49

CHANGES MADE DURING CONSTRUCTION HAVE BEEN INCORPORATED ON THESE PLANS EXCEPT CHANGES IN THE ORIGINAL THEORETICAL QUANTITIES, FOR ACTUAL QUANTITIES, REFER TO PROJECT LEDGER AND/OR COMPUTATION BOOK.

Roy Shioji 2-1-93
RESIDENT ENGINEER DATE

DEPARTMENT OF TRANSPORTATION
STATE OF HAWAII

APPROVED:

DIR. OF TRANSPORTATION

DATE

A-4-3

HAWAII DISTRICT DESIGNED BY