	INDEX TO DRAWINGS
SHEET NO.	DESCRIPTION
l	TITLE SHEET
2	KAU BASEYARD
3	HAMAKUA BASEYARD
4	TYPICAL TANK & NOTES
	And the same of th

	·
	·

STATE OF HAWAII

DEPARTMENT OF TRANSPORTATION

HIGHWAYS DIVISION HONOLULU, HAWAII

"AS-BUILT"


PLANS FOR

KAU AND HONOKAA BASEYARDS

INSTALL NEW FUEL TANKS AND LEAK DETECTION

PROJECT NO. HWY-H-01-92M

DISTRICT OF KAU AND HAMAKUA
ISLAND OF HAWAII

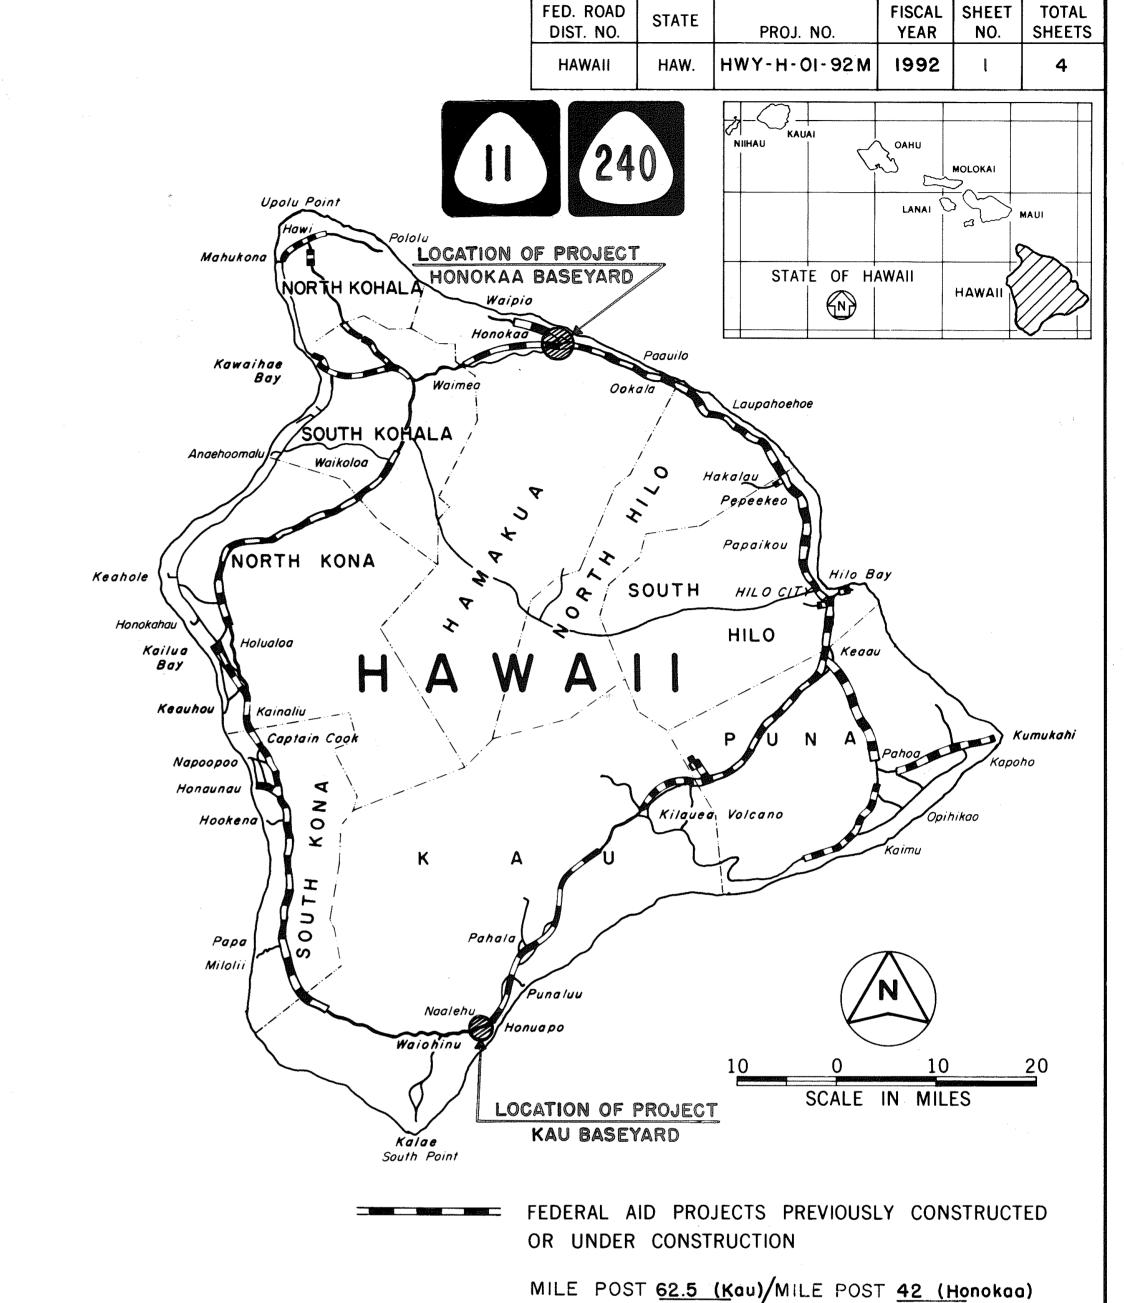

CHANGES MADE DURING CONSTRUCTION HAVE BEEN INCORPORATED ON THESE PLANS EXCEPT CHANGES IN THE ORIGINAL THEORETICAL QUANTITIES, FOR ACTUAL QUANTITIES, REFER TO PROJECT LEDGER AND/OR COMPUTATION BOOK.

Resident Engineer

6/29/93 DATE

DEPARTMENT OF TRANSPORTATION
STATE OF HAWAII

APPROVED:

Staling L. Monlean 07 May 92

M DIR. OF TRANSPORTATION DATE

HAWAII DISTRICT R. TAKAESU 587-2249
DESIGNED BY P. S. & E. BY PHONE

6-1-5