1 (A)	INDEX TO DRAWINGS		
SHEET NO.	DESCRIPTION		
1	TITLE SHEET		
2	STANDARD PLANS SUMMARY		
3	LEGEND AND NOTES		
4	STRIPING AND SIGNING PLAN		
5	TRAFFIC SIGNAL PLAN		
6	STREET SIGN DETAIL		
: : : : : : : : : : : : : : : : : : :			
•			
_			


STATE OF HAWAII


DEPARTMENT OF TRANSPORTATION
HIGHWAYS DIVISION
HONOLULU, HAWAII

"AS-BUILT"

PLANS FOR

KUAKINI HIGHWAY
TRAFFIC SIGNAL SYSTEM
AT LAKO STREET
PROJECT NO. STP-OII-I(I9)
DISTRICT OF NORTH KONA
ISLAND OF HAWAII

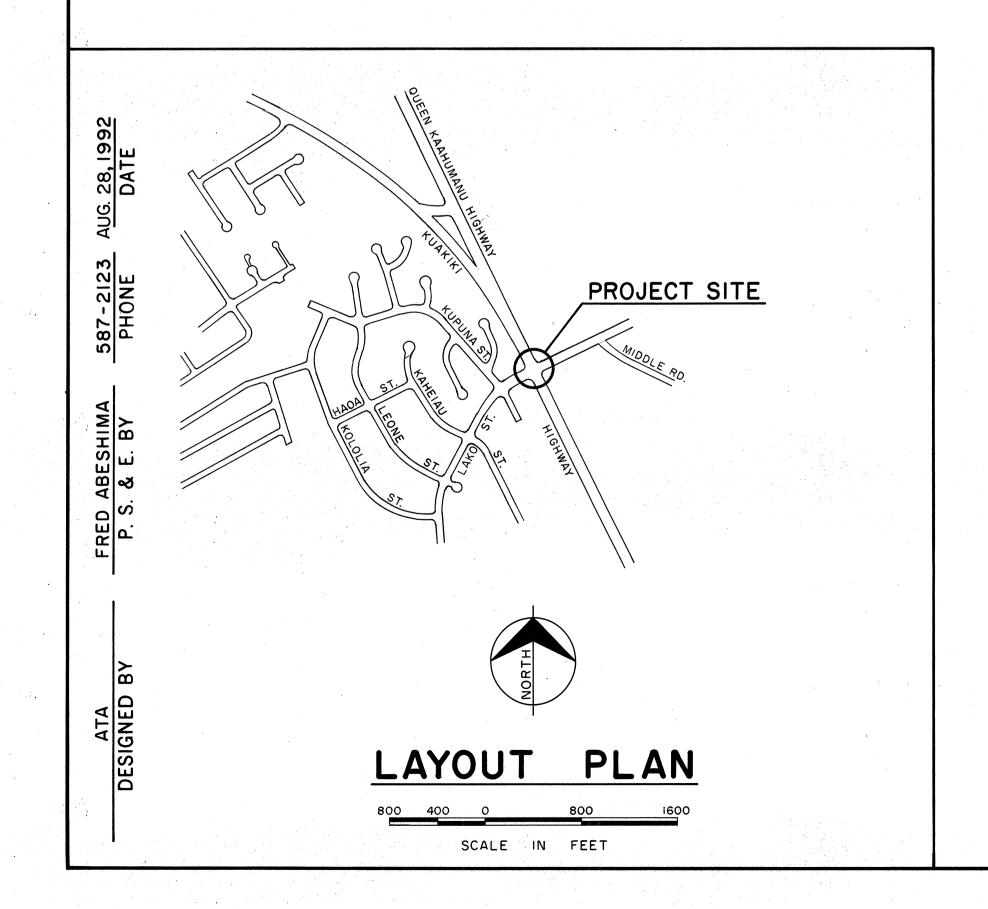

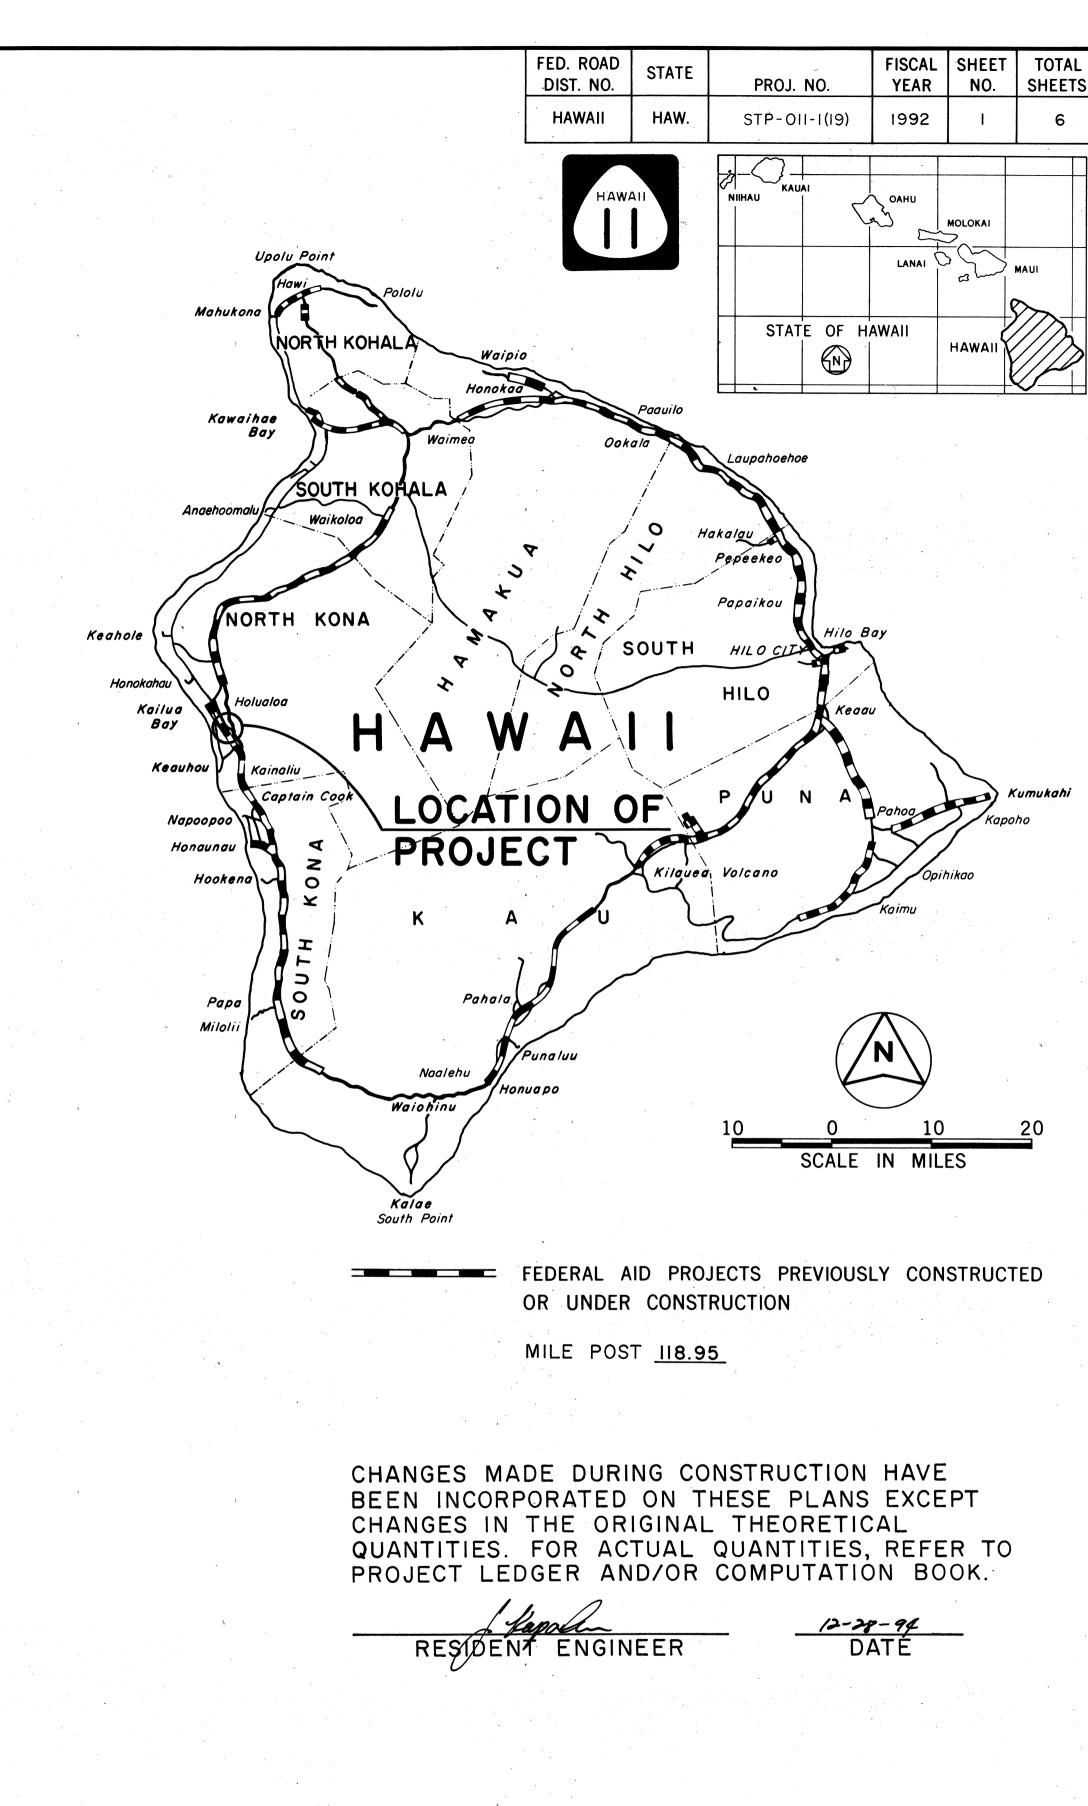

	DEPARTMENT OF TRANSPOR	RTATION
	APPROVED:	
,	Harano	7/9/92
于	DIR. OF TRANSPORTATION	DATE