


FED. ROAD DIST. NO.	STATE	PROJ. NO.	FISCAL YEAR	SHEET NO.	TOTAL SHEETS
HAWAII	HAW.	11MN-01-93M	1993	10	13

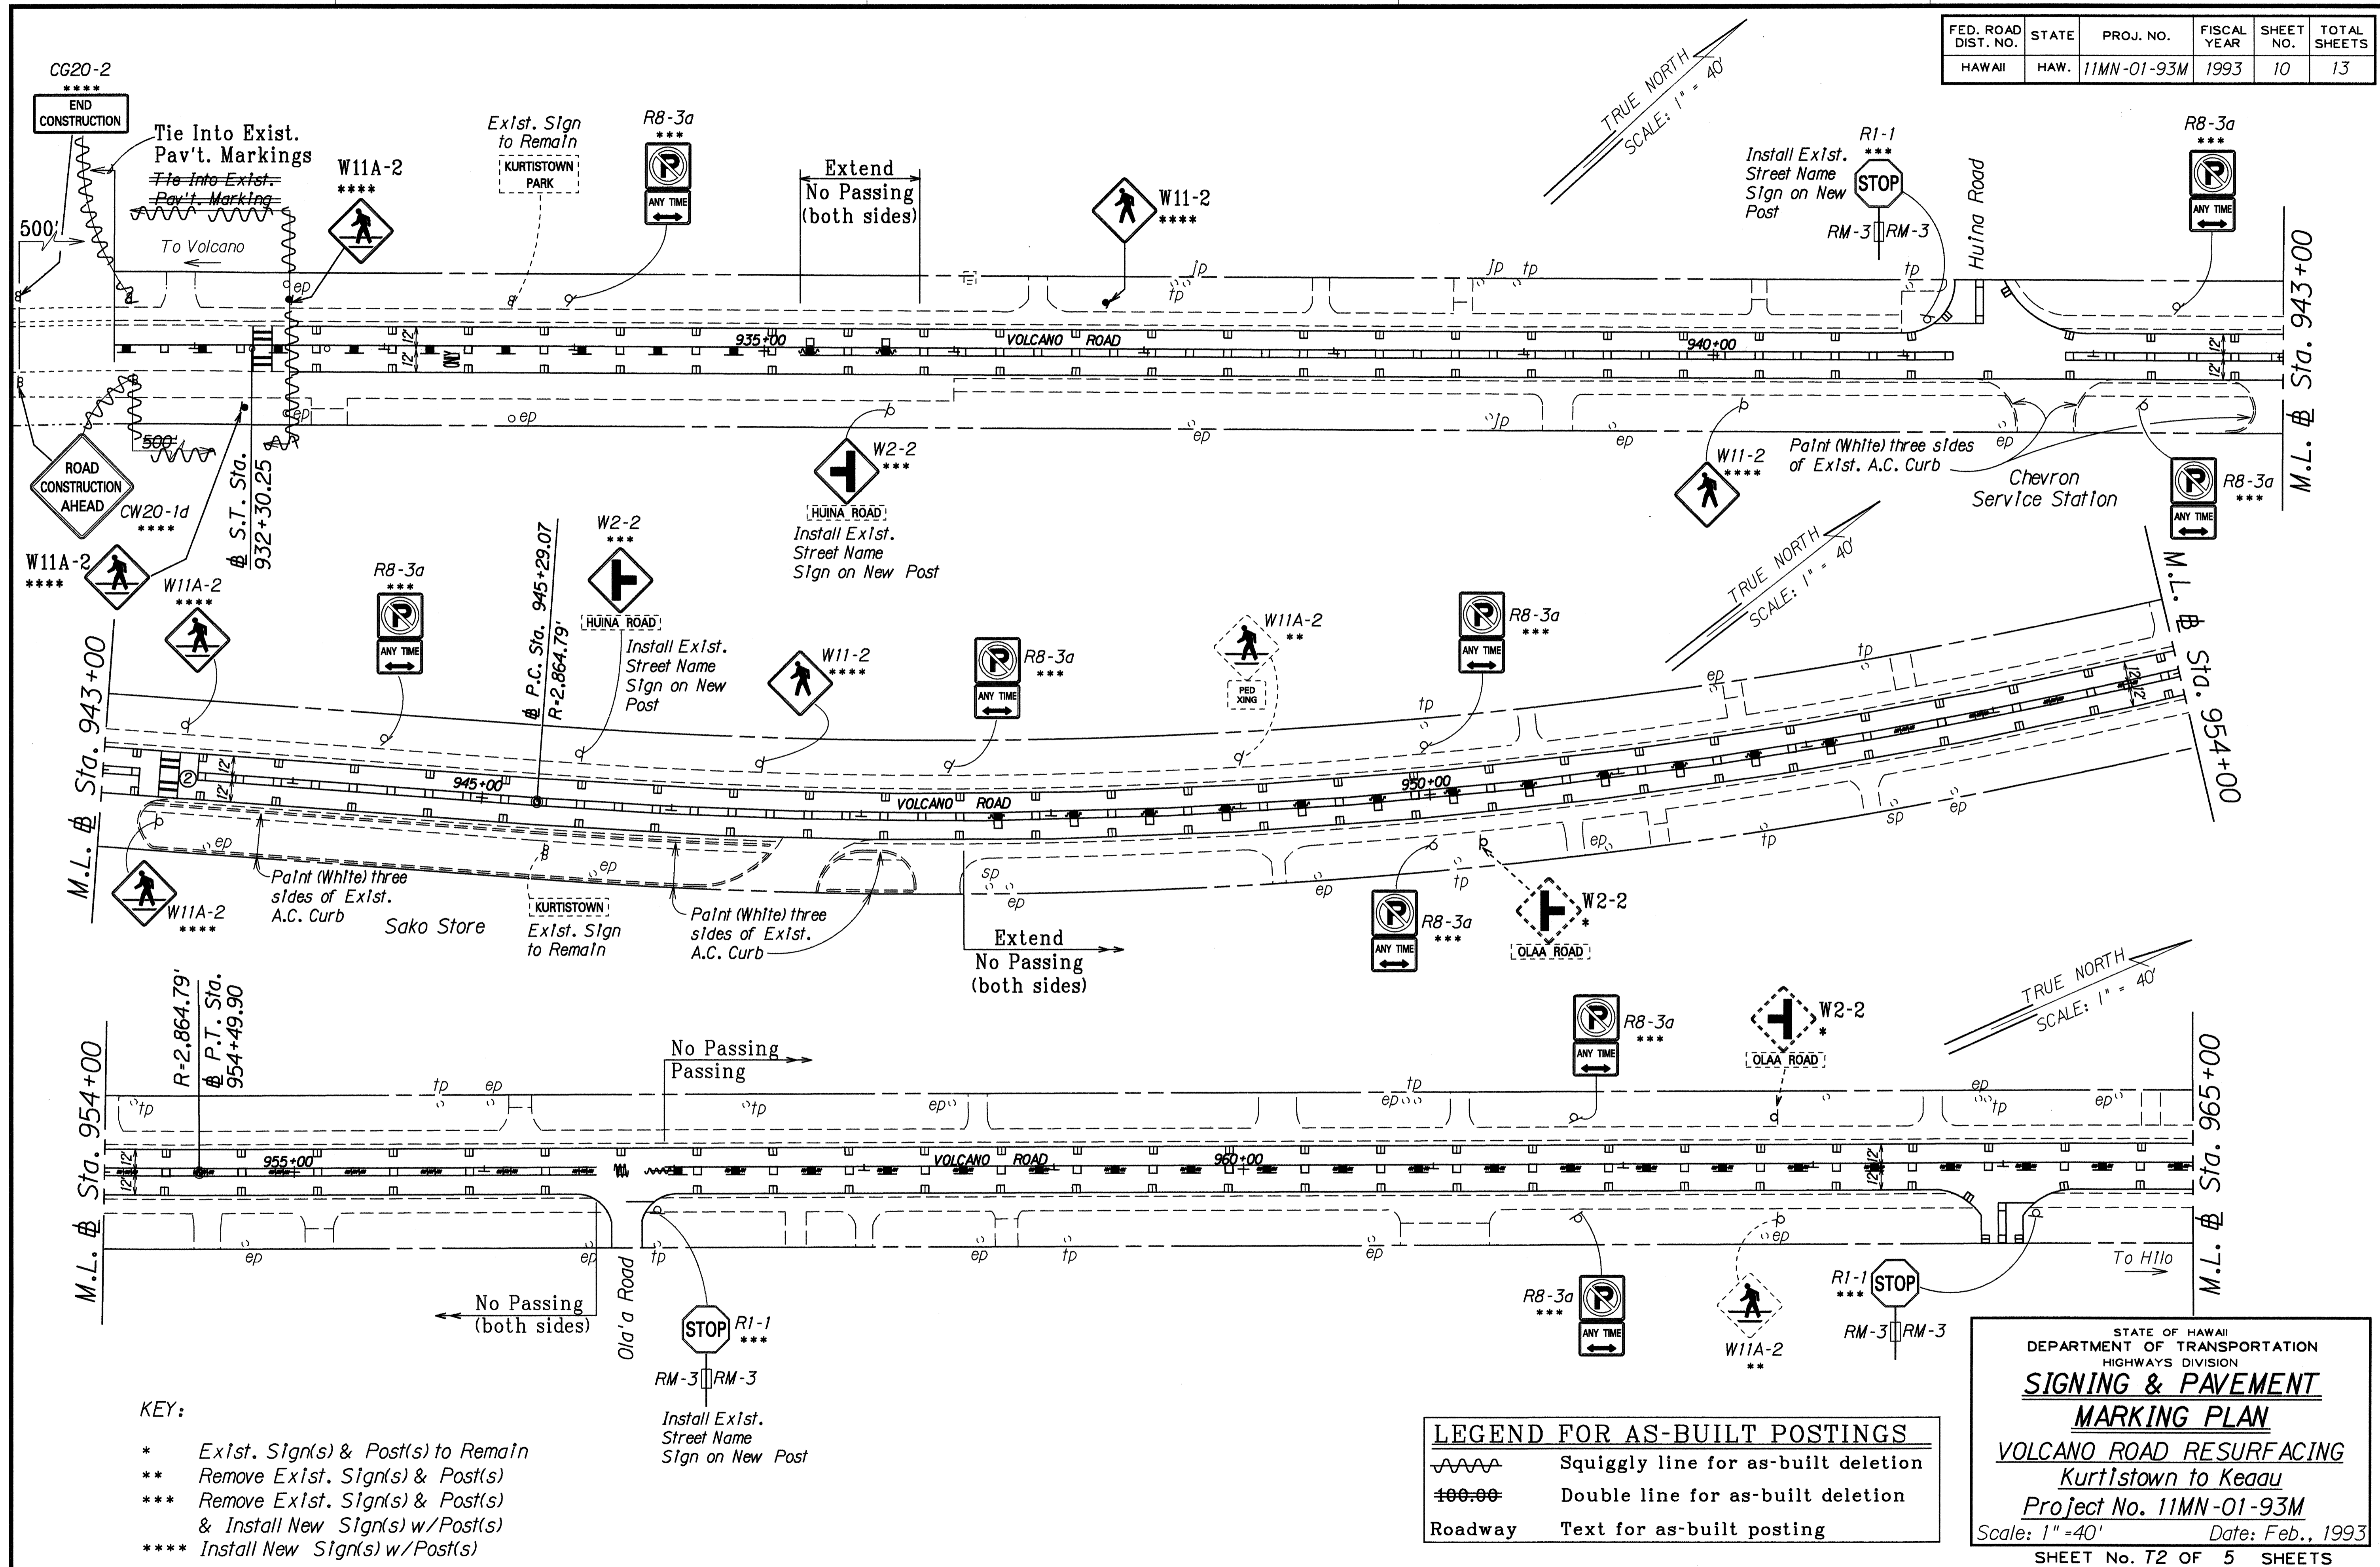

SURVEY PLOTTED BY	DATE
DRAWN BY	
DESIGNED BY	
NOTE BOOK	
QUANTITIES BY	
CHECKED BY	

- KEY:**
- * Exist. Sign(s) & Post(s) to Remain
 - ** Remove Exist. Sign(s) & Post(s)
 - *** Remove Exist. Sign(s) & Post(s) & Install New Sign(s) w/Post(s)
 - **** Install New Sign(s) w/Post(s)

Install Ex1st. Street Name Sign on New Post

LEGEND FOR AS-BUILT POSTINGS

	Squiggly line for as-built deletion
	Double line for as-built deletion
Roadway	Text for as-built posting


STATE OF HAWAII
DEPARTMENT OF TRANSPORTATION
HIGHWAYS DIVISION

SIGNING & PAVEMENT MARKING PLAN

VOLCANO ROAD RESURFACING
Kurtistown to Keaau
Project No. 11MN-01-93M
Scale: 1"=40' Date: Feb., 1993

SHEET No. T2 OF 5 SHEETS

FED. ROAD DIST. NO.	STATE	PROJ. NO.	FISCAL YEAR	SHEET NO.	TOTAL SHEETS
HAWAII	HAW.	11MN-01-93M	1993	11	13

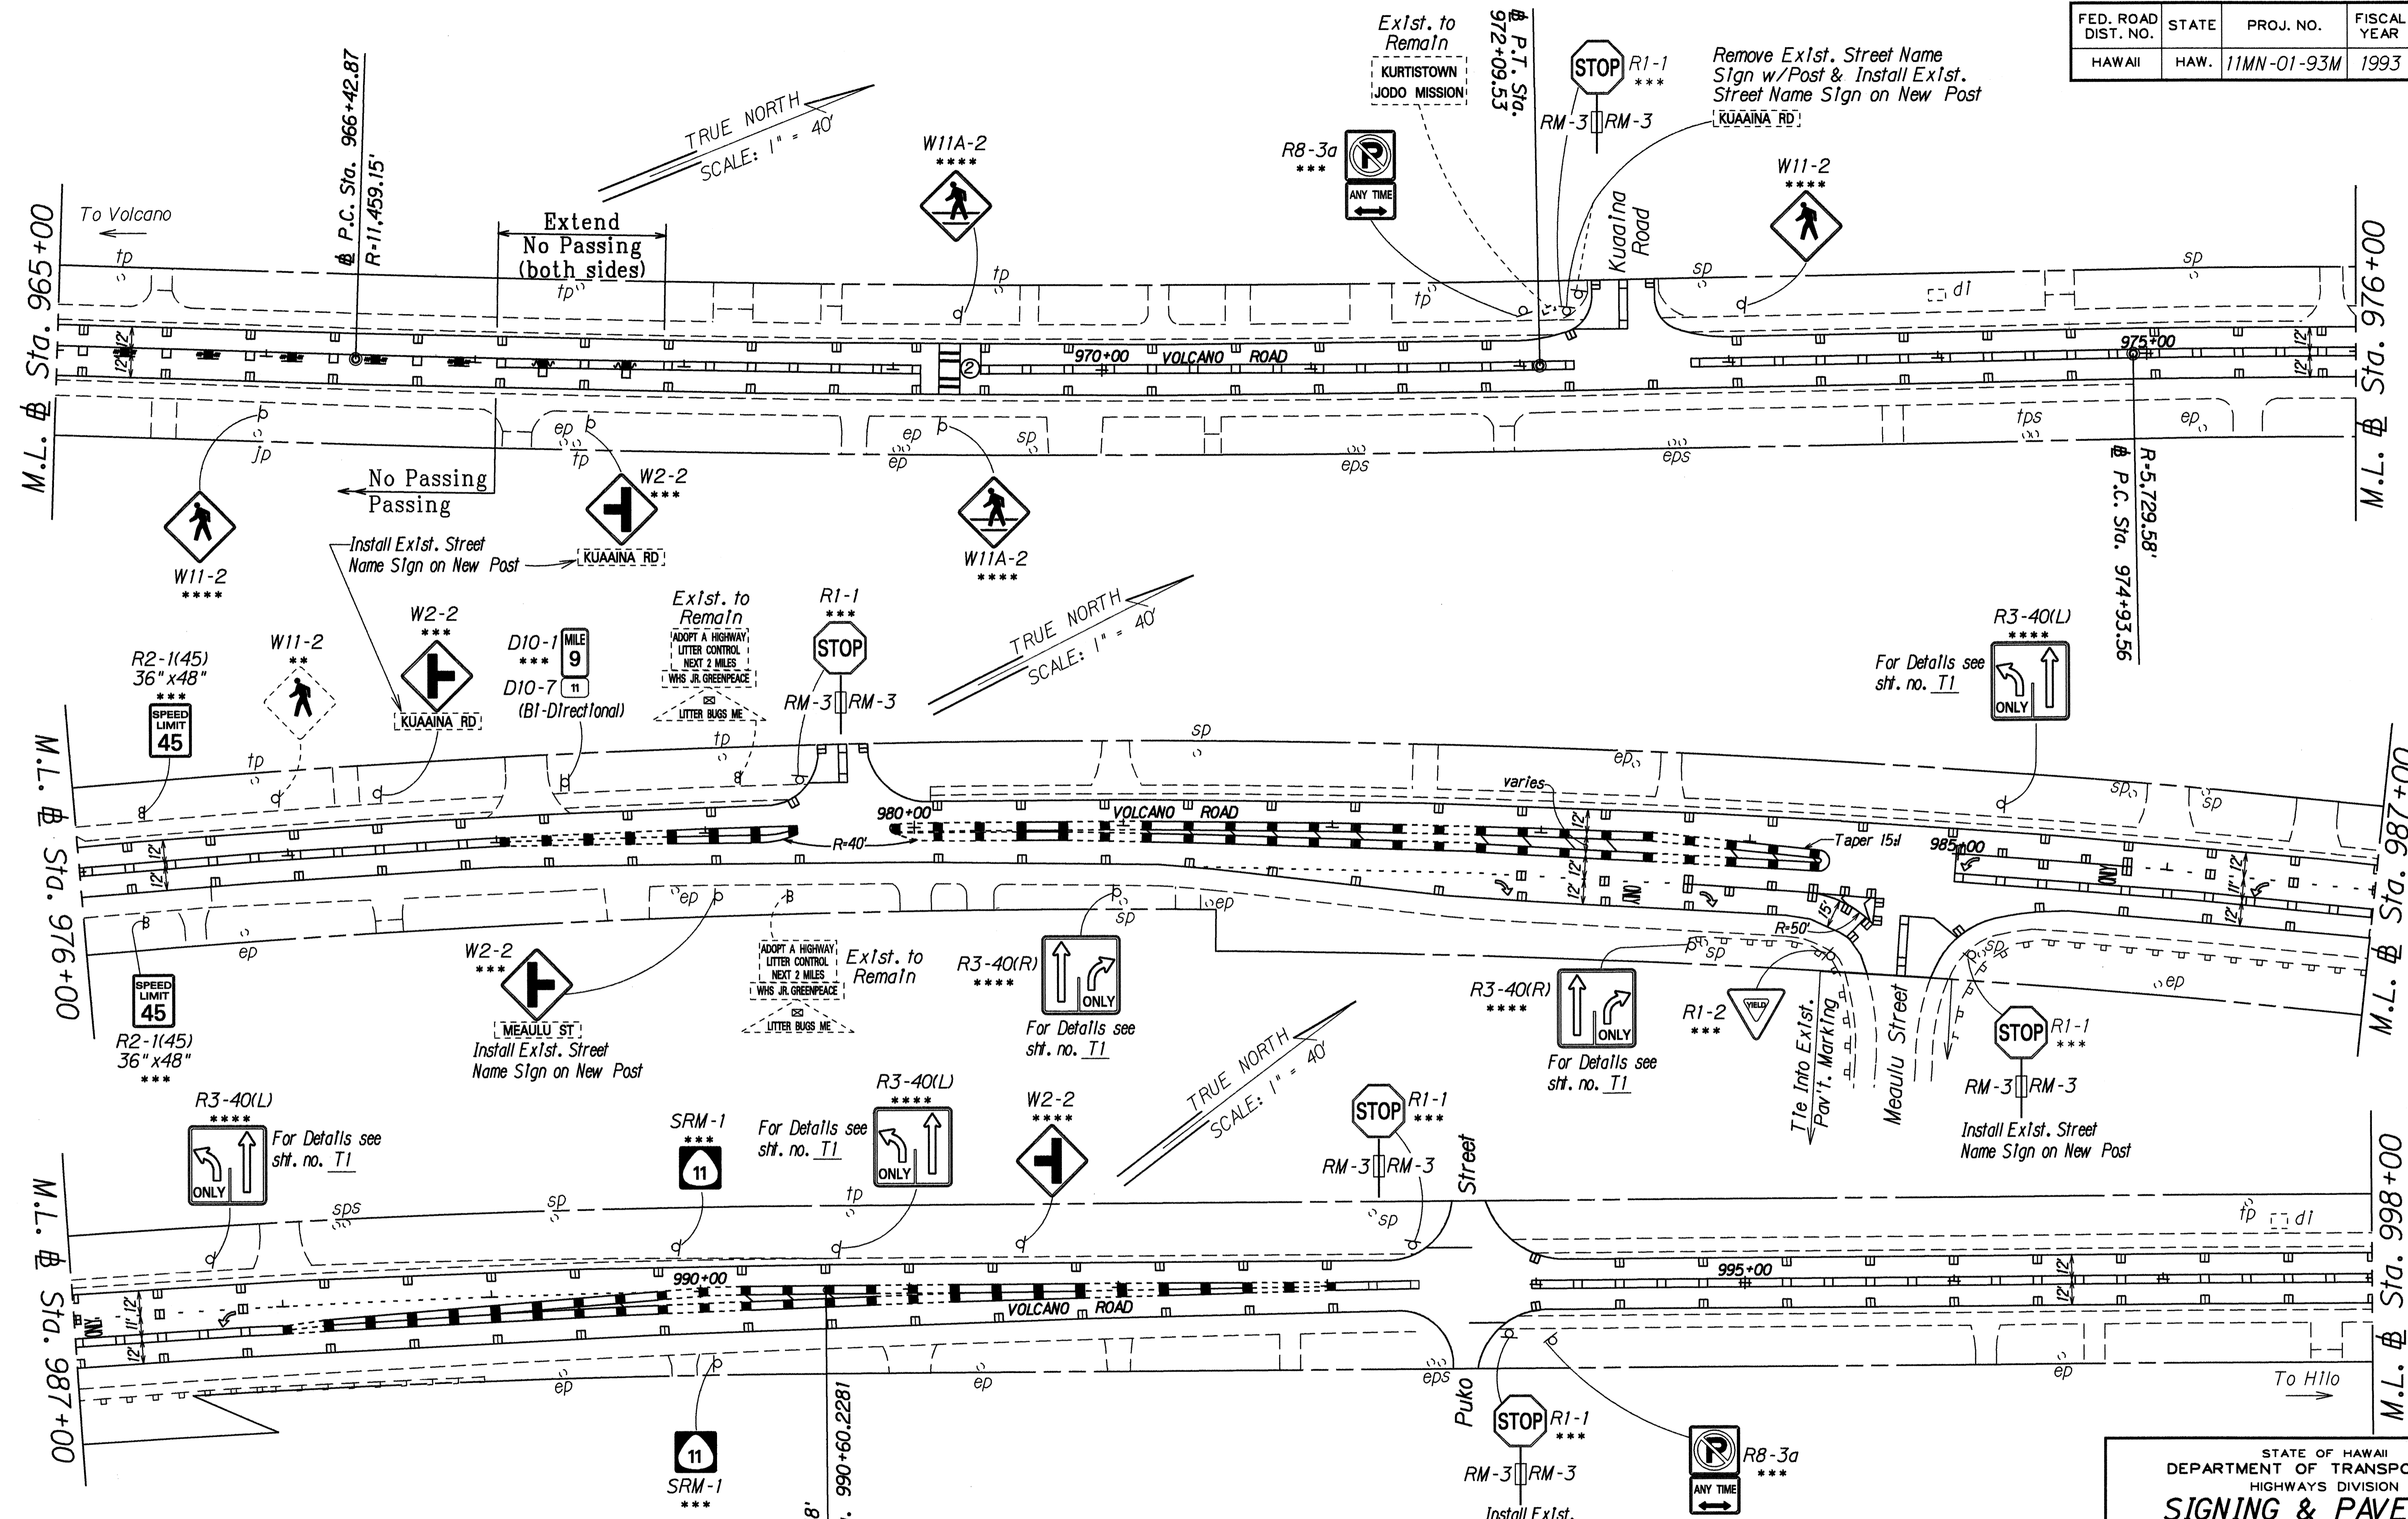

- KEY:**
- * Exlst. Sign(s) & Post(s) to Remain
 - ** Remove Exlst. Sign(s) & Post(s)
 - *** Remove Exlst. Sign(s) & Post(s) & Install New Sign(s) w/Post(s)
 - **** Install New Sign(s) w/Post(s)

LEGEND FOR AS-BUILT POSTINGS

	Squiggly line for as-built deletion
	Double line for as-built deletion
Roadway	Text for as-built posting

SURVEY PLOTTED BY	DATE
DRAWN BY	
TRACED BY	
NOTE BOOK	
QUANTITIES BY	
CHECKED BY	

STATE OF HAWAII
DEPARTMENT OF TRANSPORTATION
HIGHWAYS DIVISION



SIGNING & PAVEMENT MARKING PLAN

VOLCANO ROAD RESURFACING
Kurtistown to Keahu

Project No. 11MN-01-93M
Scale: 1"=40' Date: Feb., 1993

SHEET No. T3 OF 5 SHEETS

FED. ROAD DIST. NO.	STATE	PROJ. NO.	FISCAL YEAR	SHEET NO.	TOTAL SHEETS
HAWAII	HAW.	11MN-01-93M	1992	12	13

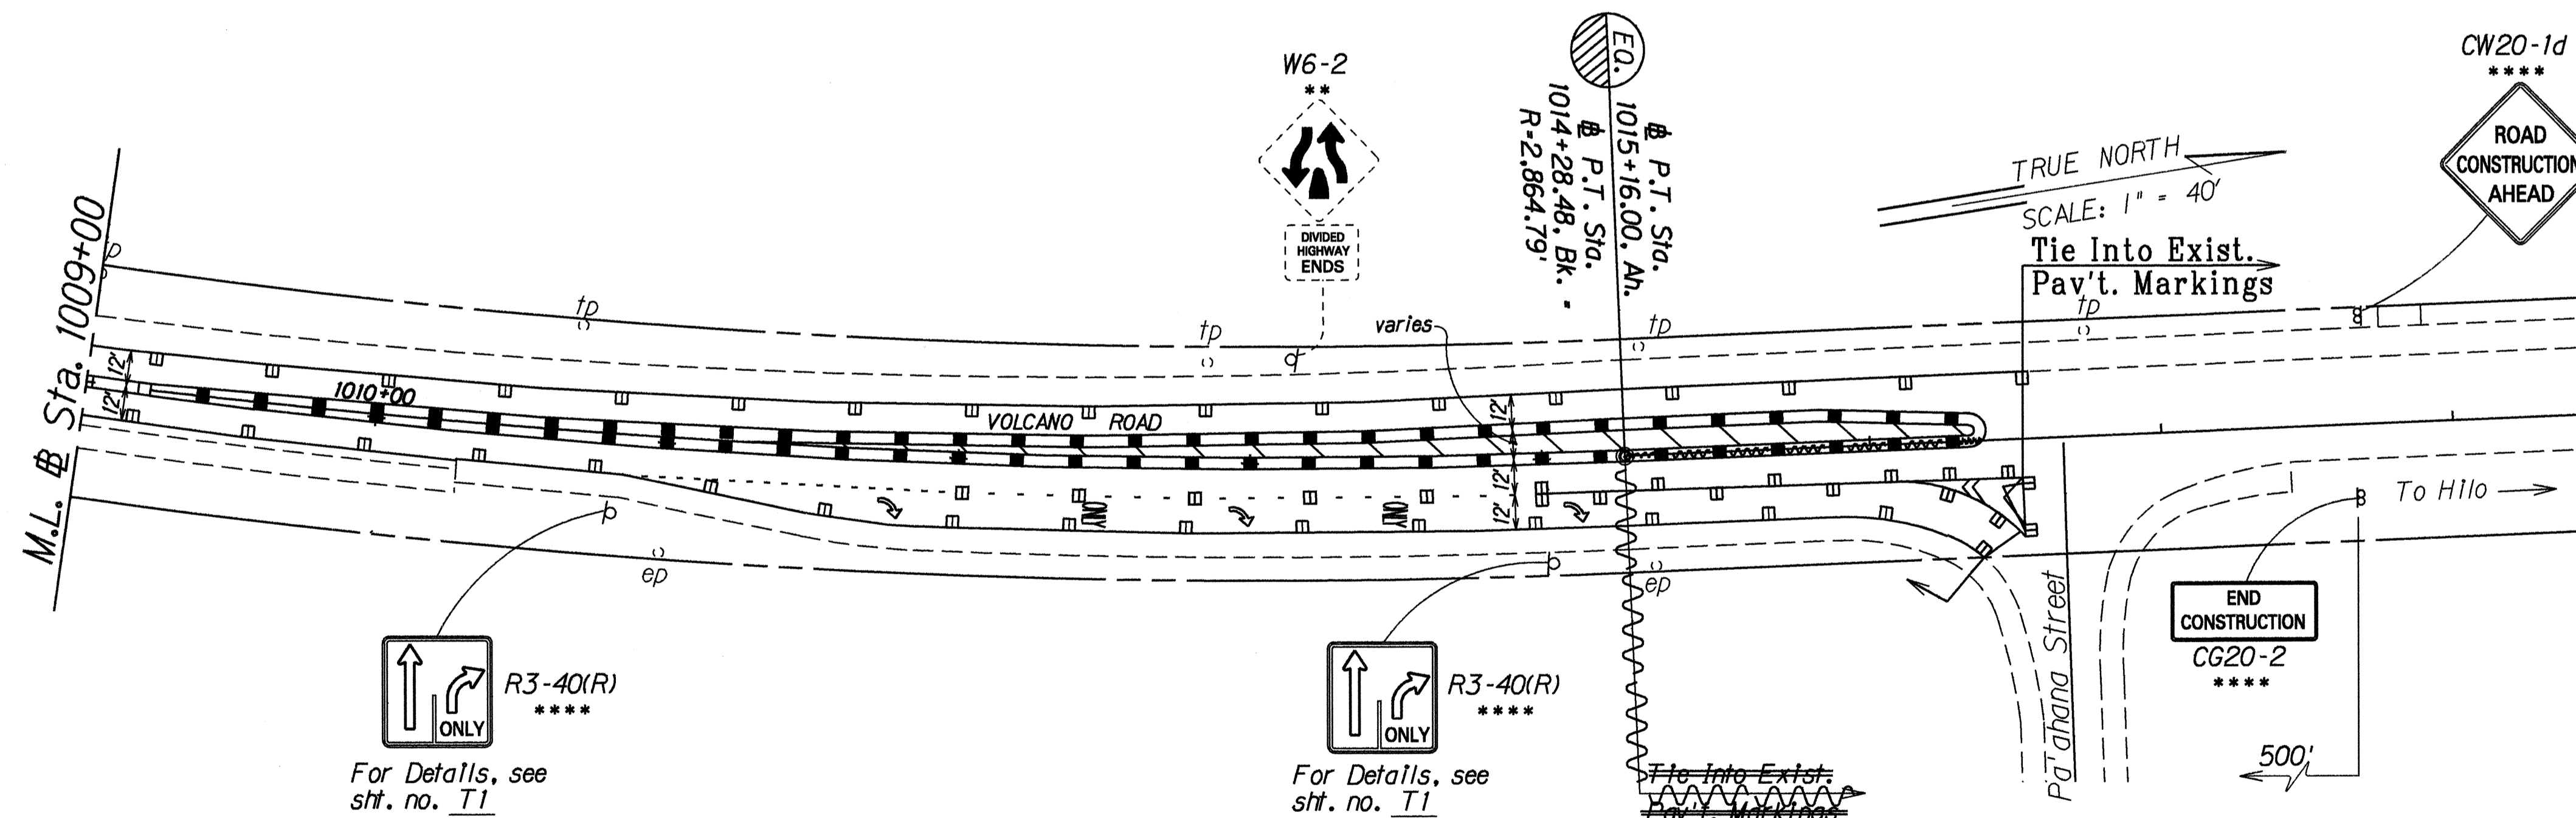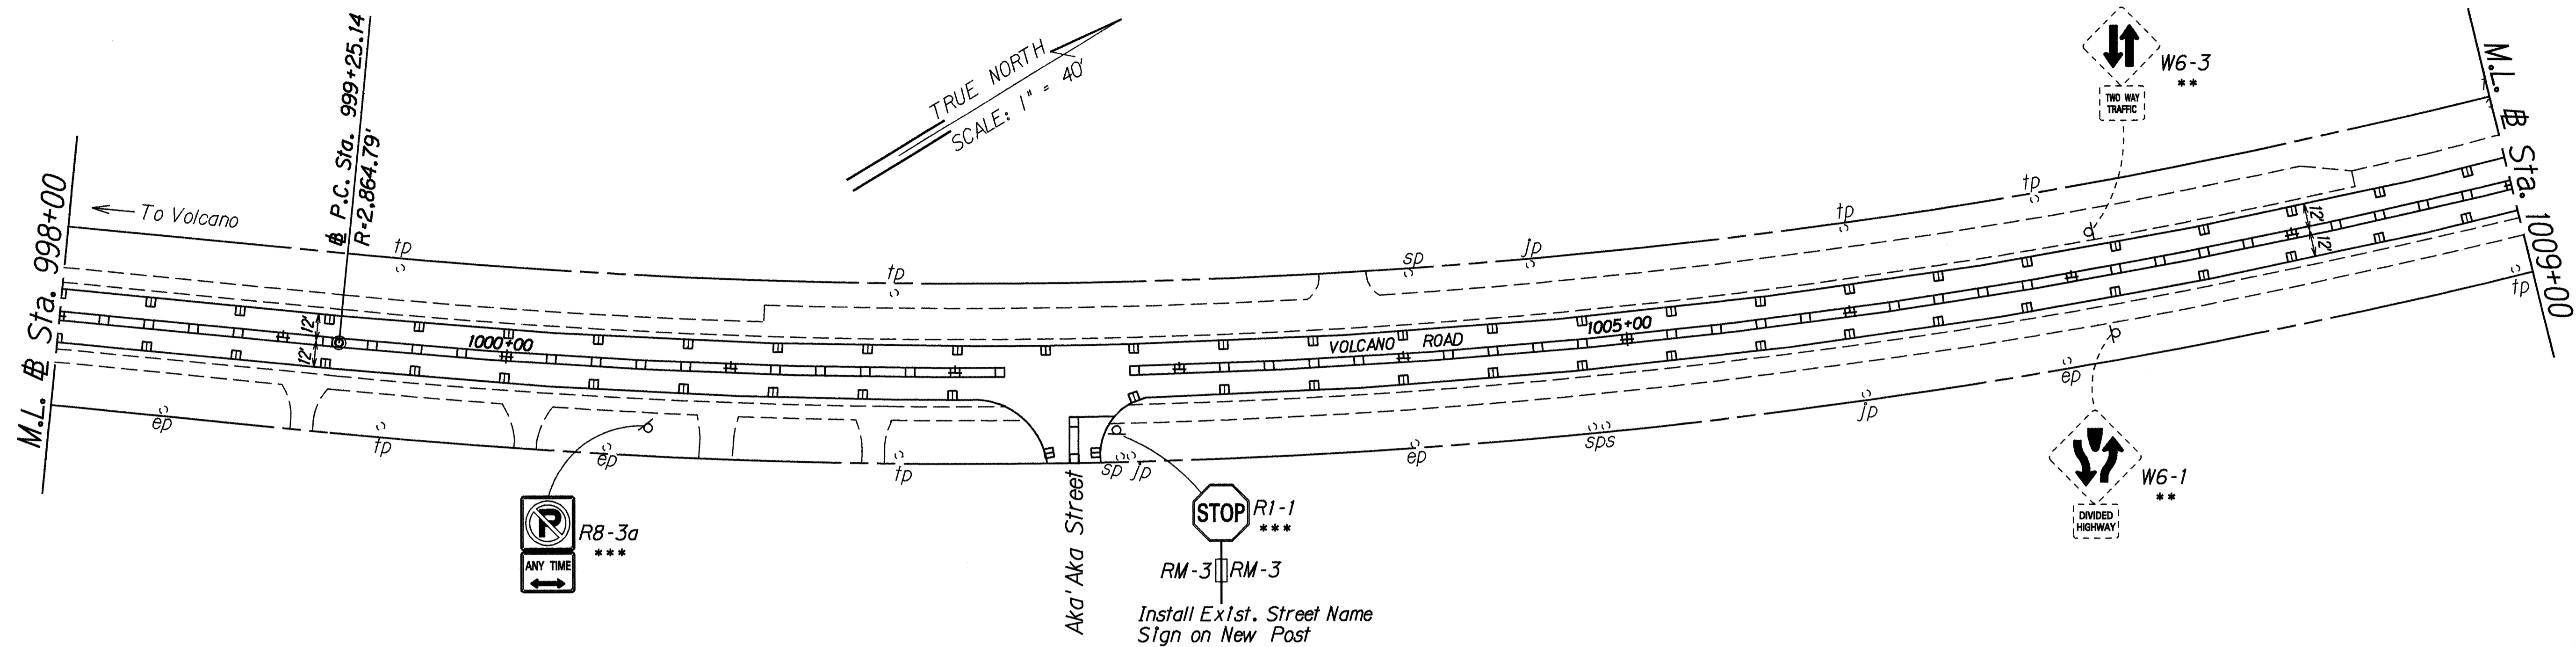

ORIGINAL PLAN	SURVEY PLOTTED BY	DATE
NOTED	DRAWN BY	
NOTES	TRACED BY	
QUANTITIES	CHECKED BY	
CHECKED BY		

KEY:

- * Exist. Sign(s) & Post(s) to Remain
- ** Remove Exist. Sign(s) & Post(s)
- *** Remove Exist. Sign(s) & Post(s) & Install New Sign(s) w/Post(s)
- **** Install New Sign(s) w/Post(s)

LEGEND FOR AS-BUILT POSTINGS

- Squiggly line for as-built deletion
- Double line for as-built deletion
- Roadway Text for as-built posting

STATE OF HAWAII
DEPARTMENT OF TRANSPORTATION
HIGHWAYS DIVISION
**SIGNING & PAVEMENT
MARKING PLAN**
VOLCANO ROAD RESURFACING
Kurtistown to Keaau
Project No. 11MN-01-93M
Scale: 1"=40' Date: Feb., 1993
SHEET No. 14 OF 5 SHEETS