


FED. ROAD DIST. NO.	STATE	PROJ. NO.	FISCAL YEAR	SHEET NO.	TOTAL SHEETS
HAWAII	HAW.	11MN-01-93M	1993	5	13


ADJUSTMENT SCHEDULE			
# Location O/s Left	*Item No. 604.1000 Adjusting Water Manhole	*Item No. 604.2000 Adjusting Water Valve	Item No. 604.1000 613.0200 Adjusting Reference Survey Monument
Sta. 932+30.25			1
Sta. 941+50±		2	
Sta. 942+00±		NA	
Sta. 945+29.07			1
Sta. 954+49.90			1
Sta. 963+86		1	
Sta. 966+42.87			1
Sta. 972+09.53			1
Sta. 972+50±		4	
Sta. 973+00±		NA	
Sta. 974+93.56			1
Sta. 981+03		1	
Sta. 984+68±		3	
Sta. 990+60.23			1
Sta. 992+50±		2	
Sta. 993+50		1	
Sta. 999+25.14			1
Sta. 1002+10±		1	
Sta. 1005+30±	1	NA	
Sta. 1014+28.48			1
TOTAL	1	15 NA	9 NA

*Note: Existing utilities shall be adjusted flush to the roadway finish grade.

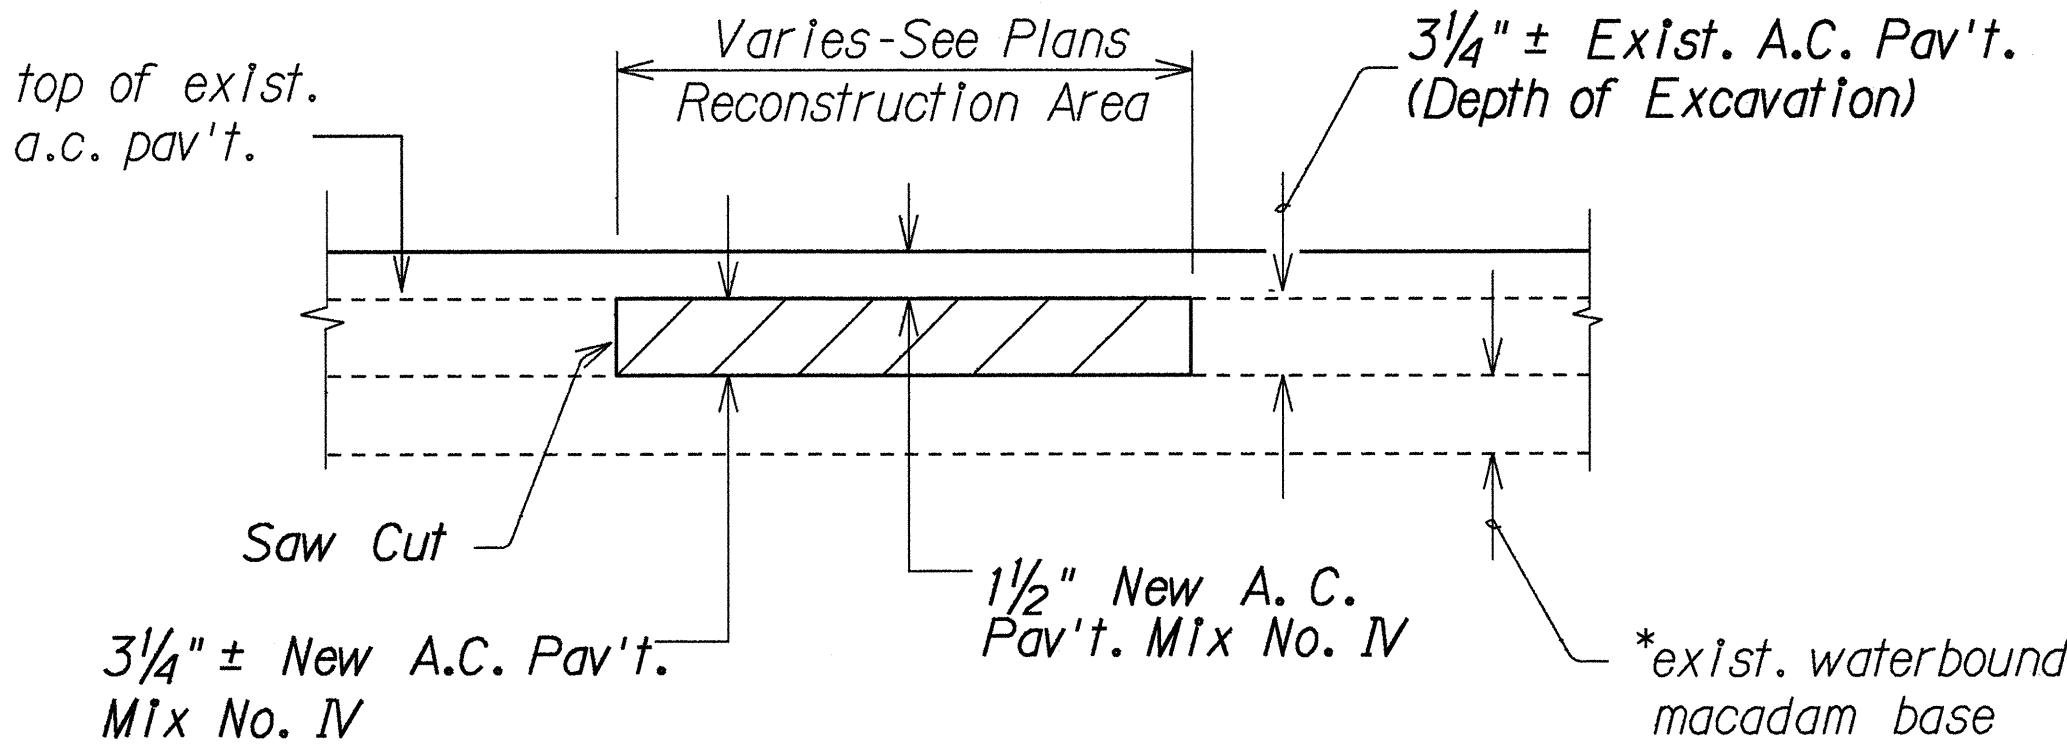


*Note: Do not disturb existing Waterbound Macadam Base Course under the A. C. Pavement.

PAVEMENT RECONSTRUCTION DETAIL
Not to Scale

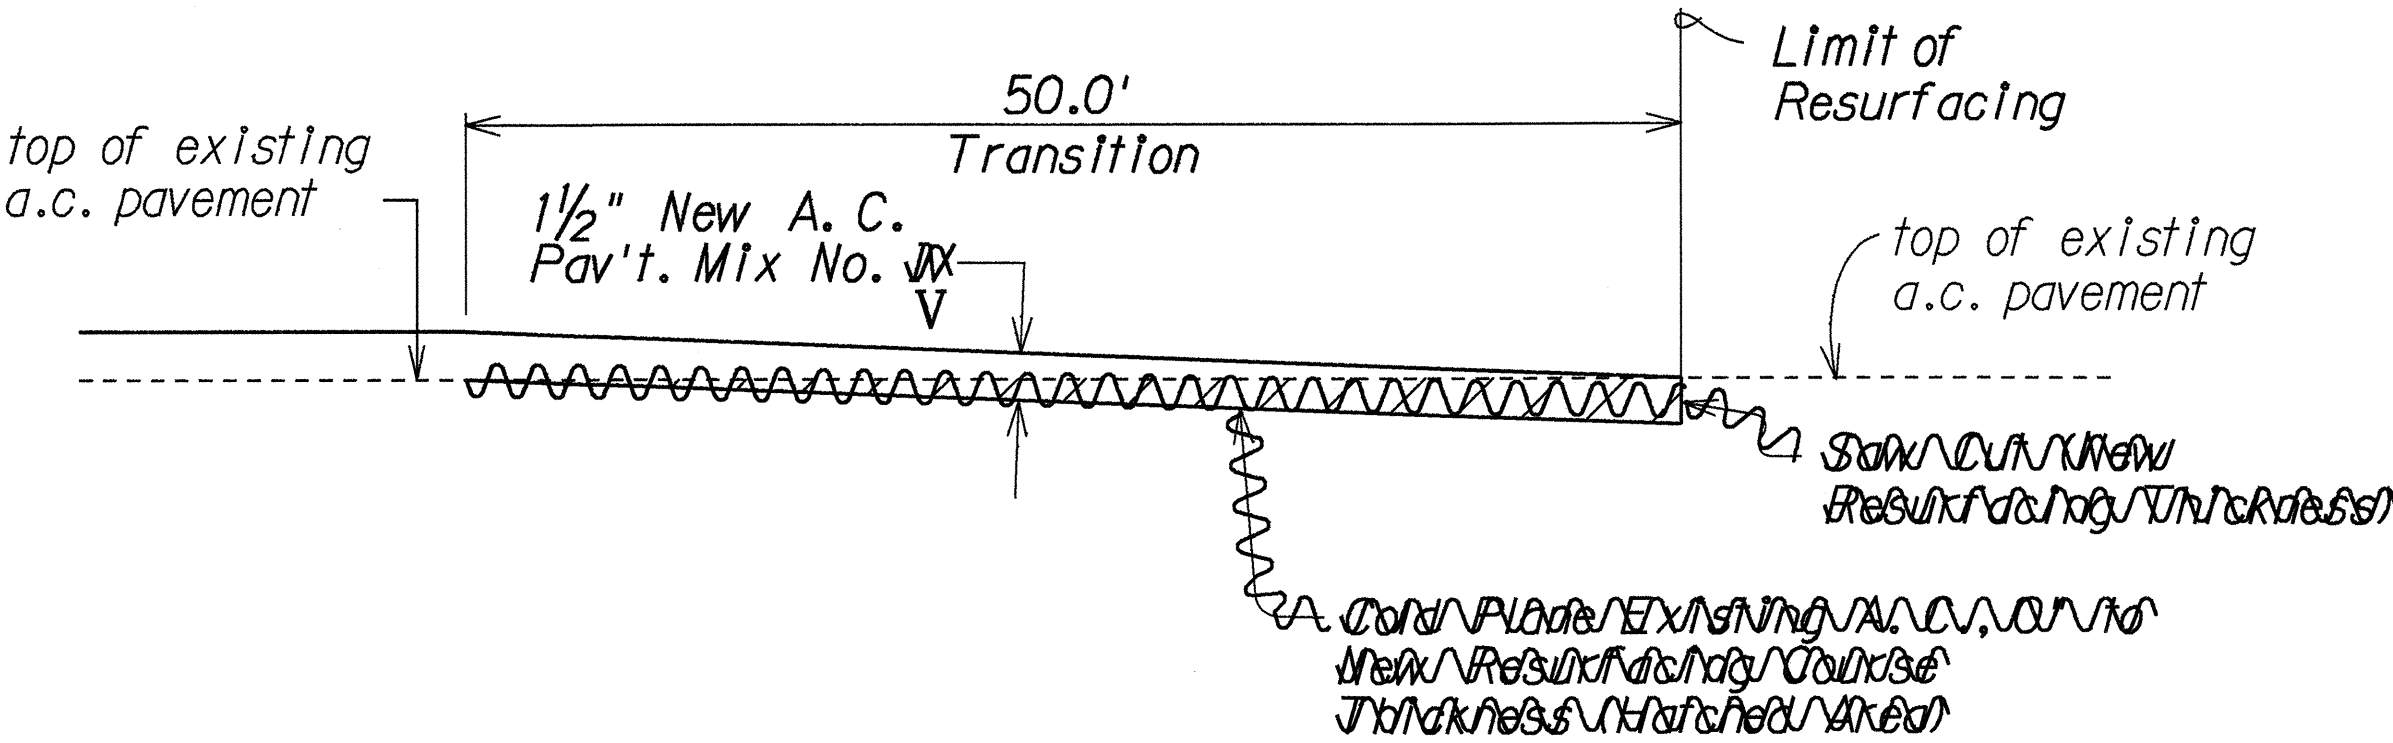

TYPICAL LONGITUDINAL TRANSITION
SECTION AT BEGINNING AND END OF PROJECT
Not to Scale

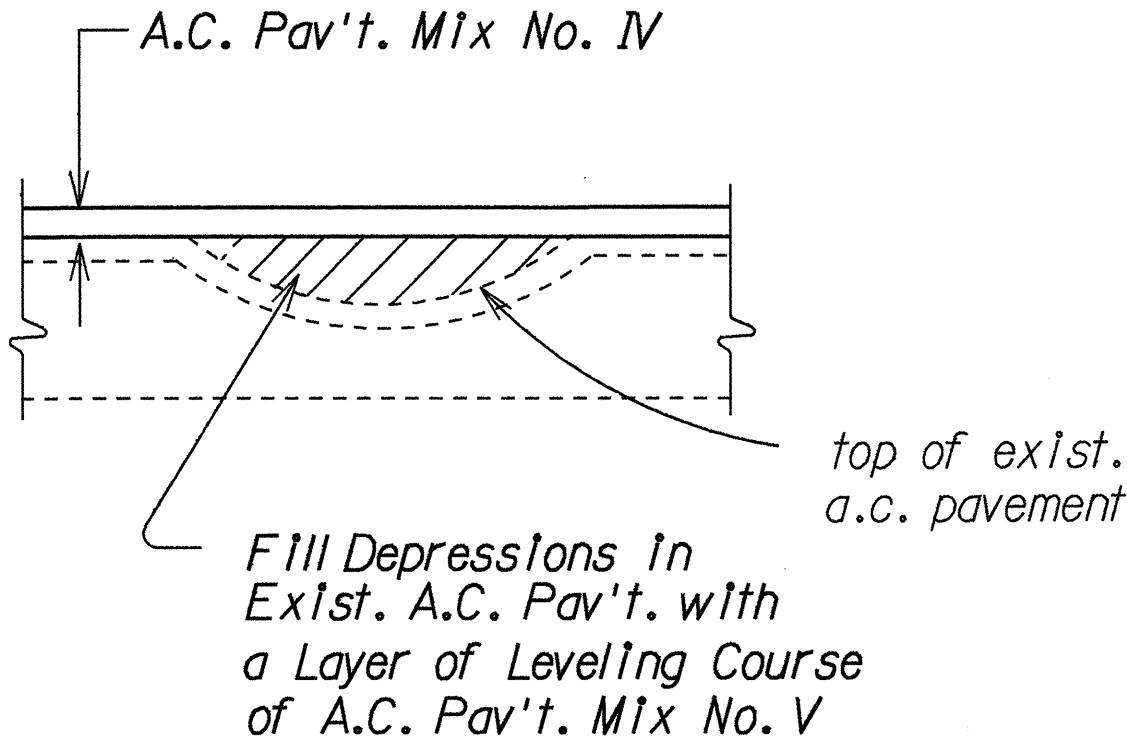

LEVELING COURSE DETAIL
Not to Scale

ORIGINAL PLAN	SURVEY PLOTTED BY	DATE
NOTE BOOK	DRAWN BY	
DESIGNED BY	TRACED BY	
CHECKED BY	DESIGNED BY	
IN. 1/4/93	CHECKED BY	

LEGEND FOR AS-BUILT POSTINGS	
	Squiggly line for as-built deletion
	Double line for as-built deletion
Roadway	Text for as-built posting

5/03/93	Revise Leveling Course from Mix IV to Mix V
DATE	REVISION
STATE OF HAWAII DEPARTMENT OF TRANSPORTATION HIGHWAYS DIVISION TYPICAL DETAILS & SCHEDULE VOLCANO ROAD RESURFACING Kurtistown to Keaau Project No. 11MN-01-93M Scale: As Shown Date: March, 1993 SHEET No. 1 OF 1 SHEETS	