



FED. ROAD DIST. NO.	STATE	PROJ. NO.	FISCAL YEAR	SHEET NO.	TOTAL SHEETS
HAWAII	HAW.	11MN-01-93M	1993	4	13

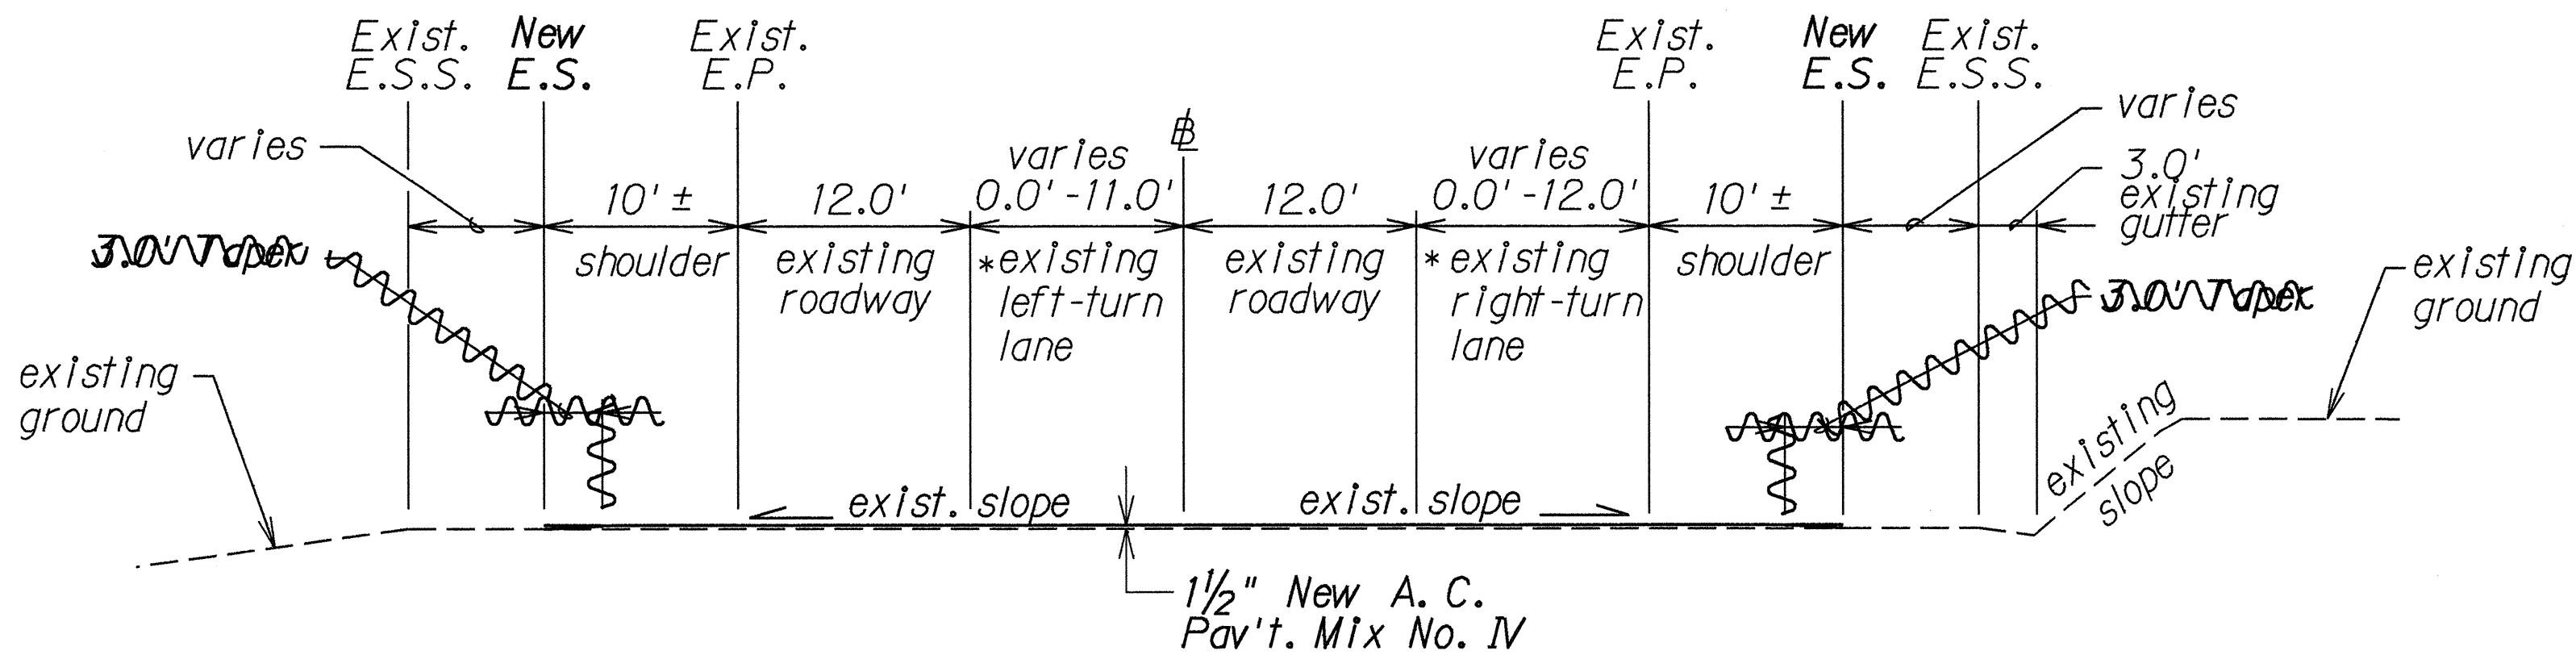


TYPICAL ROADWAY SECTION

Scale: 1/8" = 1' - 0"
 *For Right Turn Lanes
 and Left Turn Lanes,
 See Plan

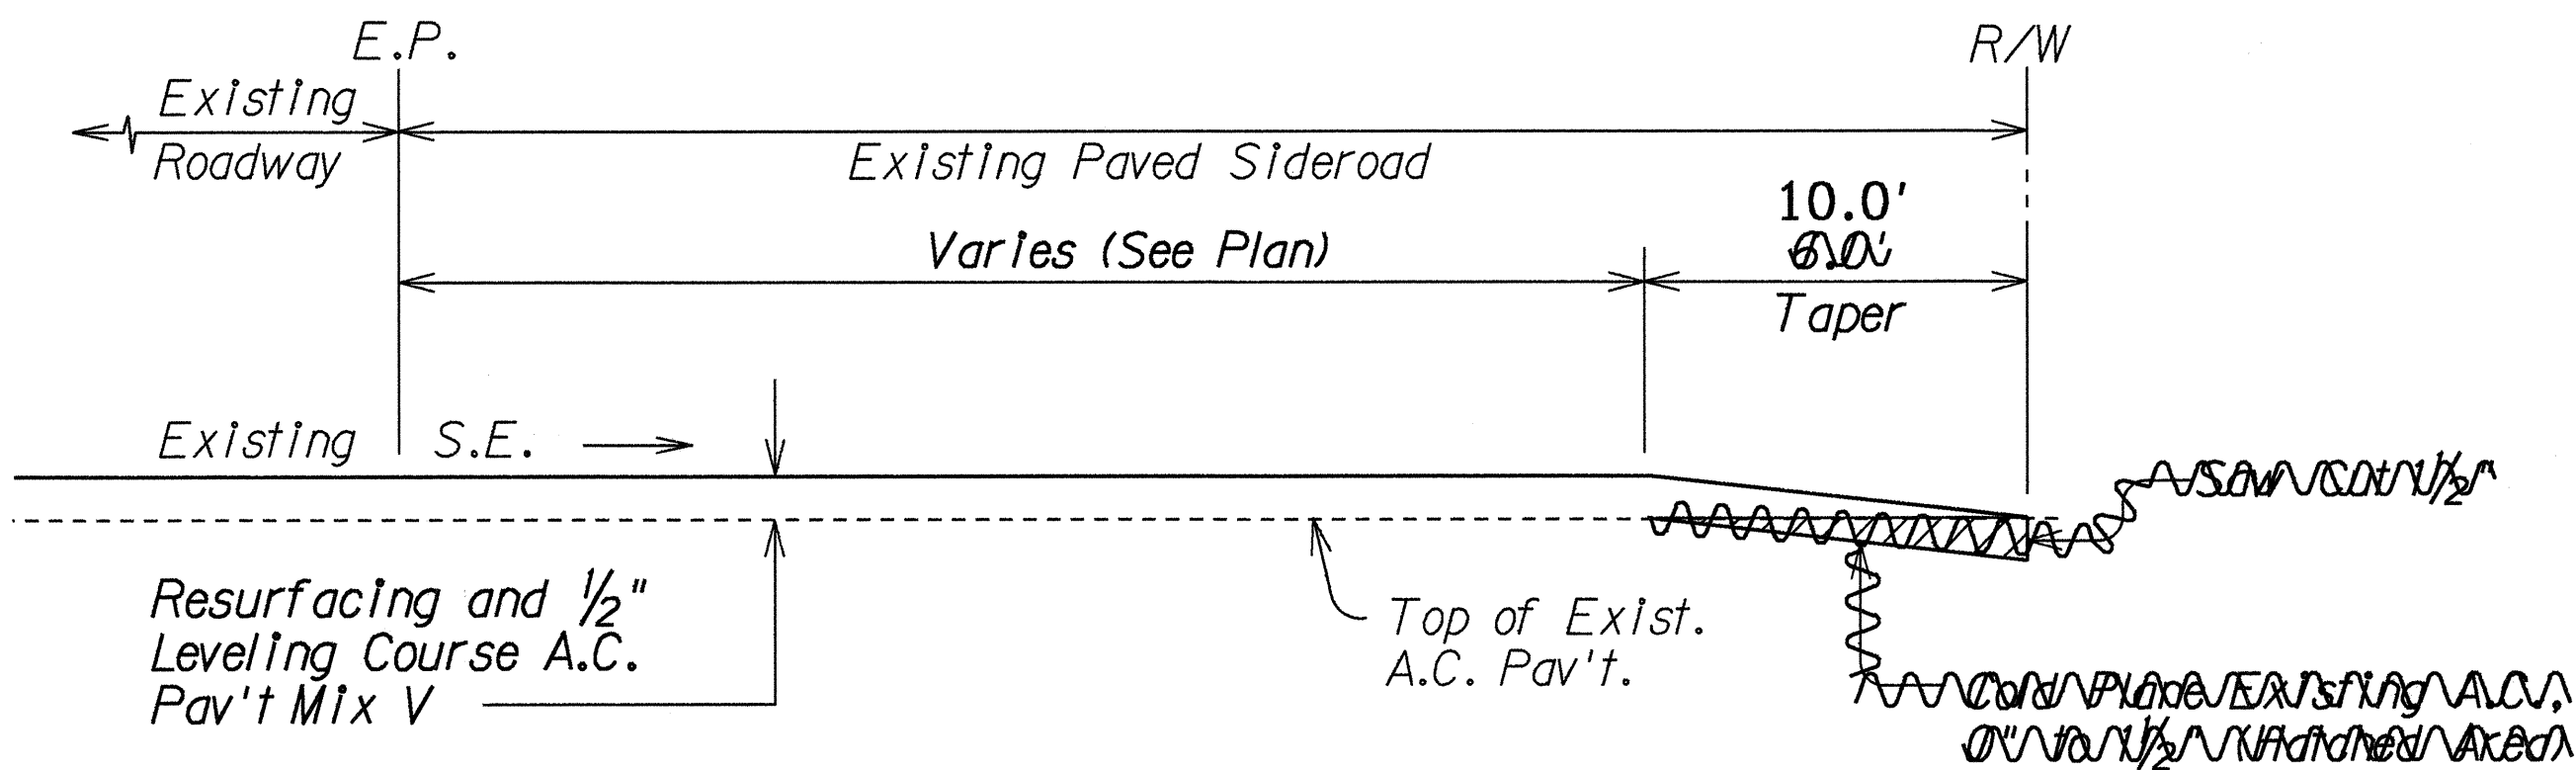

A.C. RESURFACING AT PAVED SIDEROAD DETAIL
 Not to Scale

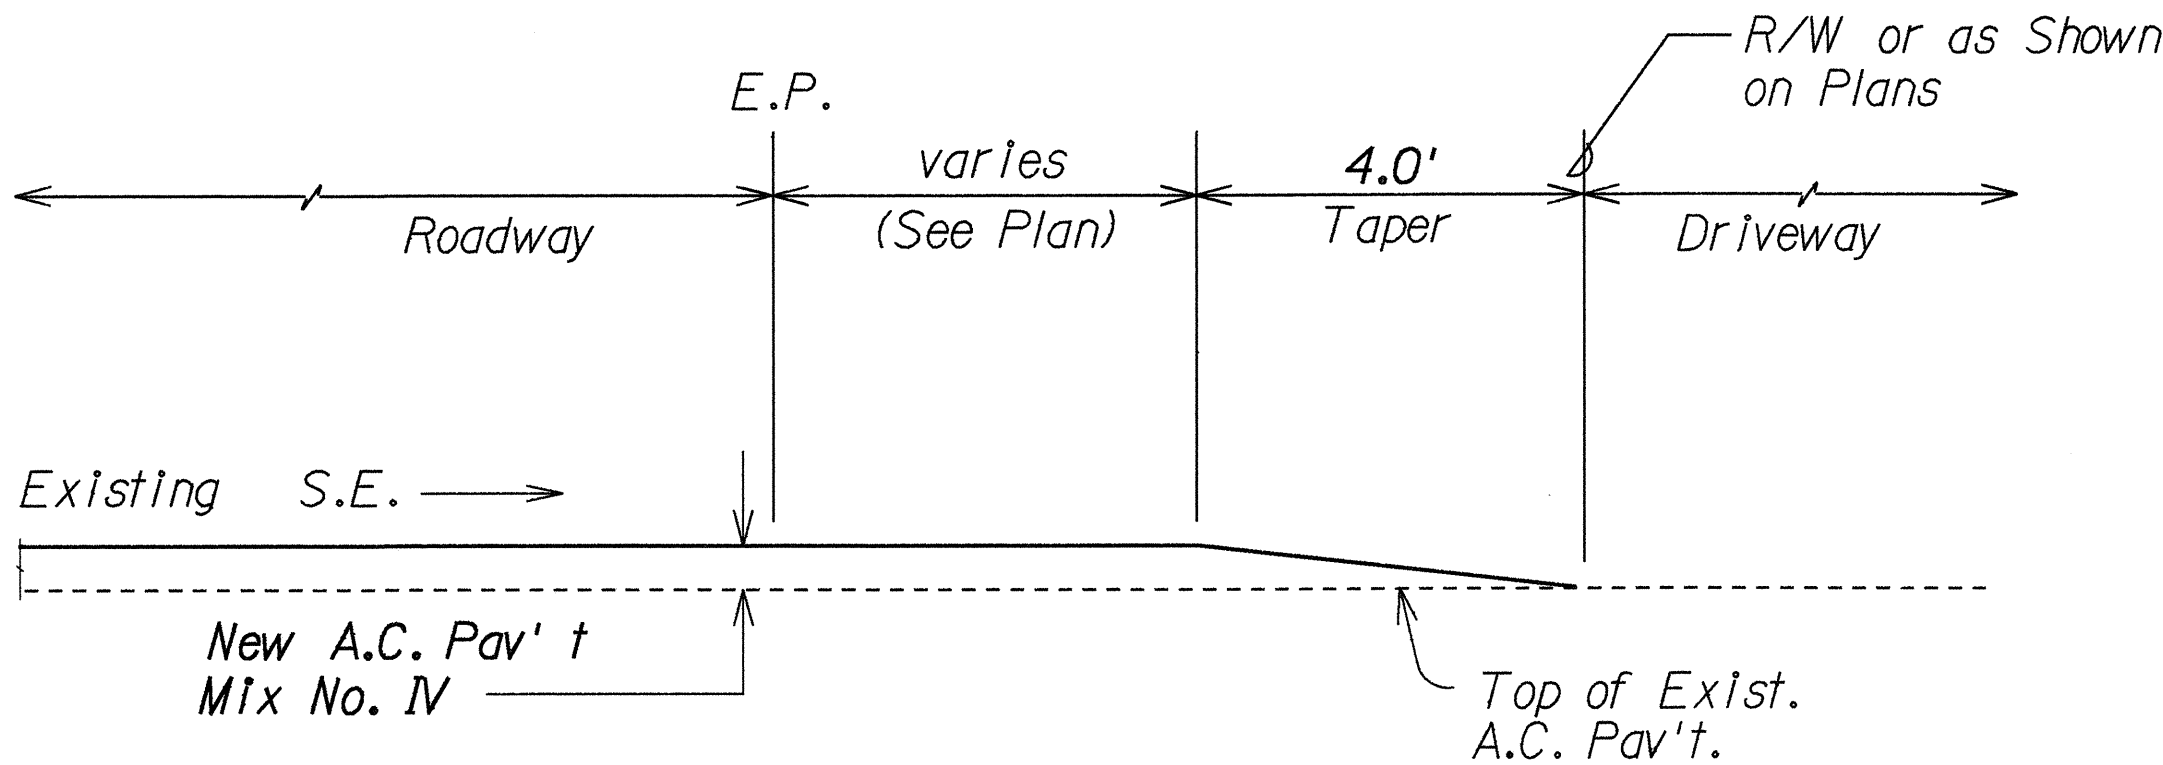

A.C. RESURFACING AT PAVED DRIVEWAY DETAIL
 Not to Scale

DATE	_____
SURVEY PLOTTED BY	_____
DRAWN BY	_____
DESIGNED BY	_____
CHECKED BY	_____
ORIGINAL PLAN	_____
NOTE BOOK	_____
DATE	_____
BY	_____
NO.	_____

LEGEND FOR AS-BUILT POSTINGS	
	Squiggly line for as-built deletion
	Double line for as-built deletion
Roadway	Text for as-built posting

5/03/93	Revise Leveling Course from Mix IV to Mix V.
---------	--

DATE	REVISION
------	----------

STATE OF HAWAII DEPARTMENT OF TRANSPORTATION HIGHWAYS DIVISION	
<u>TYPICAL SECTION & DETAILS</u>	
VOLCANO ROAD RESURFACING Kurtistown to Keau	
Project No. 11MN-01-93M	
Scale: As Shown	Date: March, 1993
SHEET No. 1 OF 1 SHEETS	