

FED. ROAD DIST. NO.	STATE	PROJ. NO.	FISCAL YEAR	SHEET NO.	TOTAL SHEETS
HAWAII	HAW.	11L-01-91M	1991	7	7

NOTES:

1. Pavement markings and striping shall be Thermoplastic Extrusion or Preformed Pavement Marking Tape.
2. Layout of pavement markings and striping shall be done by the Contractor and approved by the Engineer prior to any installation work.
3. Pavement areas to receive pavement markers, striping and markings shall be broomed off prior to installation.
4. Contractor's attention is directed to the "Typical Edge of Pavement Markings" detail. Type "CL" pavement markers shall be installed along the white edge of pavement stripe.
5. Final locations of all Stop Lines shall be approved by the Engineer prior to installation.
6. All construction signs shall be reflectorized with high intensity reflective sheeting.
7. Final locations of all signs shall be approved by the Engineer prior to any installation work.


PAVEMENT MARKER SCHEDULE							
Exist. Proj. No.	STATION		DESCRIPTION	TYPE			
	FROM	TO		CL	DL	HL	J
S-0144(1)	332+00	341+50	PASSING-L NO PASSING-R	44	22	20	80
	341+50	345+00	NO PASSING-BOTH SIDES	18	18		
	345+00	355+00	NO PASSING-L PASSING-R	50	25	25	100
	355+00	358+00	PASSING-BOTH SIDES	16	8		28
	358+00	360+68.38 360+35.82	PASSING-L NO PASSING-R	14	8	7	28
F-011-2(5)	360+68.38 360+35.82	368+00	PASSING-L NO PASSING-R	38	20	18	72
	368+00	378+00	NO PASSING-L PASSING-R	50	26	25	100
	378+00	402+33	PASSING-BOTH SIDES	122	61		240
	402+33	407+33	PASSING-L NO PASSING-R	26	13	14	56
	407+33	407+84	OPEN	8	6		
	407+84	412+84	NO PASSING-L PASSING-R	28	13	14	56
	412+84	448+75	PASSING-BOTH SIDES	180	90		356
	448+75	459+20	PASSING-L NO PASSING-R	52	27	27	108
	459+20	464+20	NO PASSING-BOTH SIDES	26	26		
	464+20	464+60	OPEN	4	3		
	464+60	469+60	NO PASSING-L PASSING-R	28	13	14	56
	469+60	556+35	PASSING-BOTH SIDES	434	217		864
	556+35	561+35	PASSING-L NO PASSING-R	26	12	13	52
	561+35	561+85	OPEN	4	3		
	561+85	581+50	NO PASSING-BOTH SIDES	100	99		
	407+84	416+04	NO PASSING-BOTH SIDES		42		
	416+04	421+04	NO PASSING-L PASSING-R		13	13	52
	421+04	448+75	PASSING-BOTH SIDES		69		276
	TOTALS			1,268	731	176	2,112

CENTERLINE & REFERENCE SURVEY MONUMENT SCHEDULE					
Exist. Proj. No.	STATION	*RECONSTRUCT (Item No. 613.1000)	ADJUST EXIST. (Item No. 613.2000)	± OFFSET (FT.)	EXIST. DEPTH (FT.)
S-0144(1)	R/W P.C. 336+29.71		1	2.7' Lt.	0.11
	R/W P.T. 350+00.82		1	0.2' Rt.	0.12
	P.C. 354+65.86		1	0.4' Rt.	0.12
	P.T. 360+68+36 Bk. P.T. 360+35+82 Ah.		1	1.0' Rt.	0.14
	372+00		1	0.2' Rt.	0.08
F-011-2(5)	± P.O.T. 402+00		1	0.4' Lt.	0.00
	± P.O.T. 437+00	1		0.33' Lt.	0.35
	R/W P.C. 454+54.18	1		0.35' Rt.	0.22
	S.C. 456+20.85	1		0.5' Rt.	0.26
	C.S. 460+17.52	1		0.8' Rt.	0.45
	R/W P.T. 461+84.61	1		0.7' Rt.	0.22
	± P.O.T. 493+00		1	0.35' Lt.	0.00
	P.O.T. 523+00		1	1.11' Lt.	0.00
	P.O.T. 554+00		1	0.3' Lt.	0.00
	R/W P.C. 568+67.38		1	0.67' Lt.	0.00
	S.C. 570+34.33		1	0.45' Lt.	0.00
	C.S. 578+54.00		1	0.35' Lt.	0.00
	R/W P.T. 580+20.41		1	0.2' Lt.	0.08
	TOTALS	5	13		

* Remove existing ± monument. Refer to Standard Plan D-06 for Details of New ± Monument Installation.


CONSTRUCTION SIGN SCHEDULE		
Exist. Proj. No.	STATION	ITEM No. 621.7120
S-0144(1)	323+00	CW-20-1d
	328+00	CG 20-2
	333+00	CG 20-1(4.7)
F-011-2(5)	581+50	CG 20-1(4.7)
	586+50	CG 20-2
	591+50	CW 20-1d
TOTAL		6 Each

SIDE ROADS & DRIVEWAYS PAVEMENT MARKER SCHEDULE		
STATION	TYPE	
	CL	DL
414+60	4	
415+75	4	
416+75	4	3
512+97	4	3
536+50	4	3
TOTALS	20/12	9

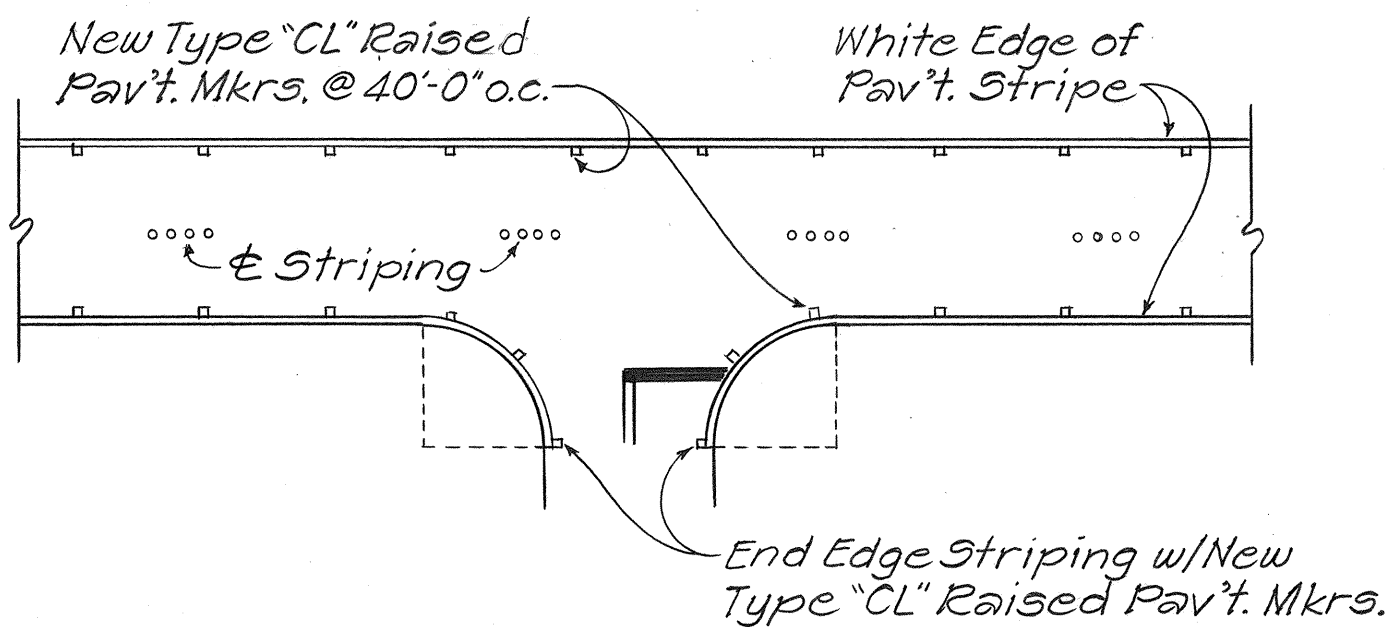

TYPICAL EDGE OF PAVEMENT MARKINGS

Not To Scale

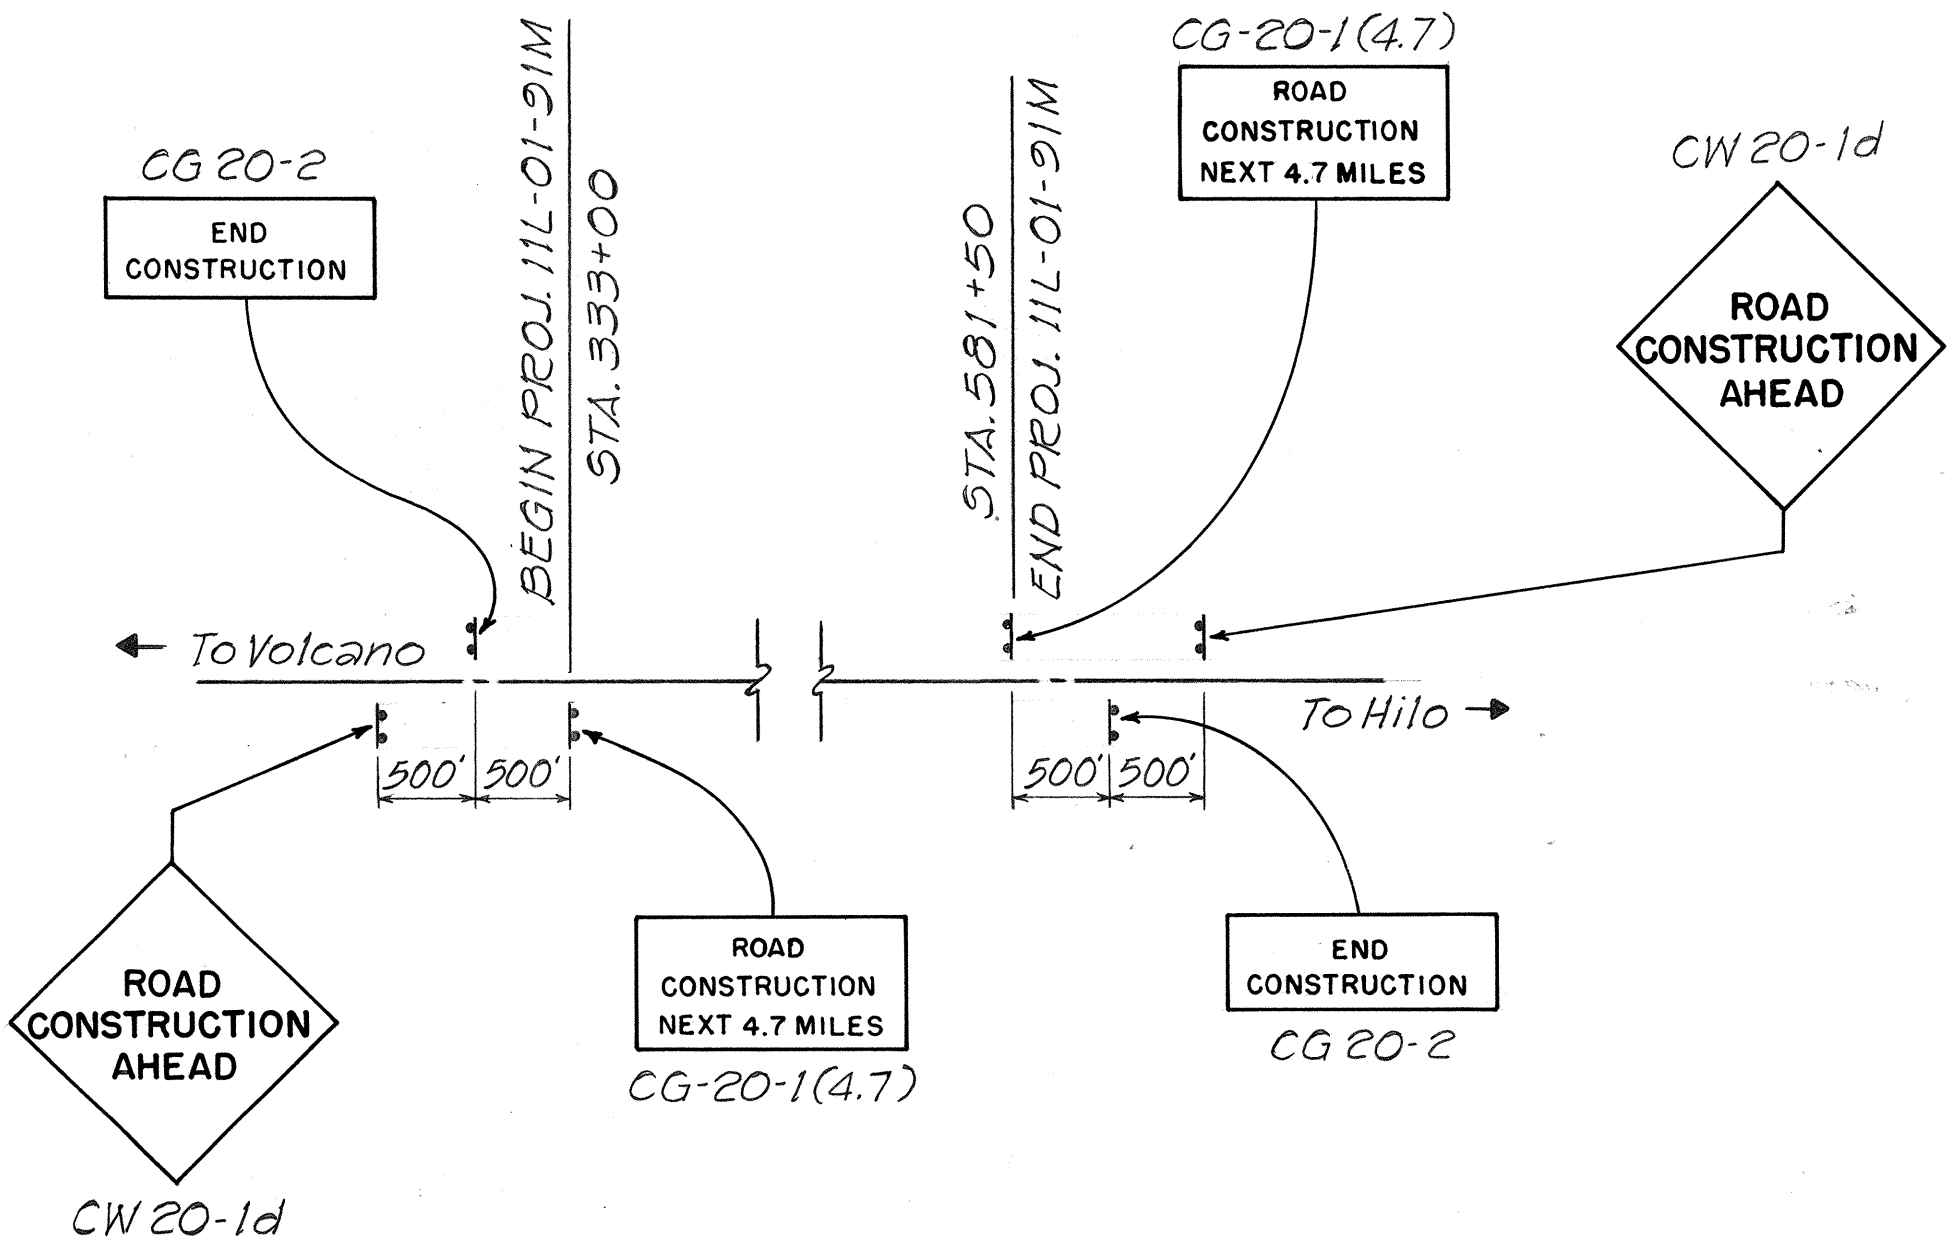

SIGN DETAIL

Not To Scale

STATE OF HAWAII
DEPARTMENT OF TRANSPORTATION
HIGHWAYS DIVISION

CONSTRUCTION SIGN DETAIL,
SIGN & MISC. SCHEDULES
VOLCANO RD. RESURFACING
PROJ. No. 11L-01-91M
Scale: As Noted Date: Oct. 1990
SHEET No. 1 OF 1 SHEETS