


FED. ROAD DIST. NO.	STATE	PROJ. NO.	FISCAL YEAR	SHEET NO.	TOTAL SHEETS
HAWAII	HAW.	11L-01-22M	1992	4	8

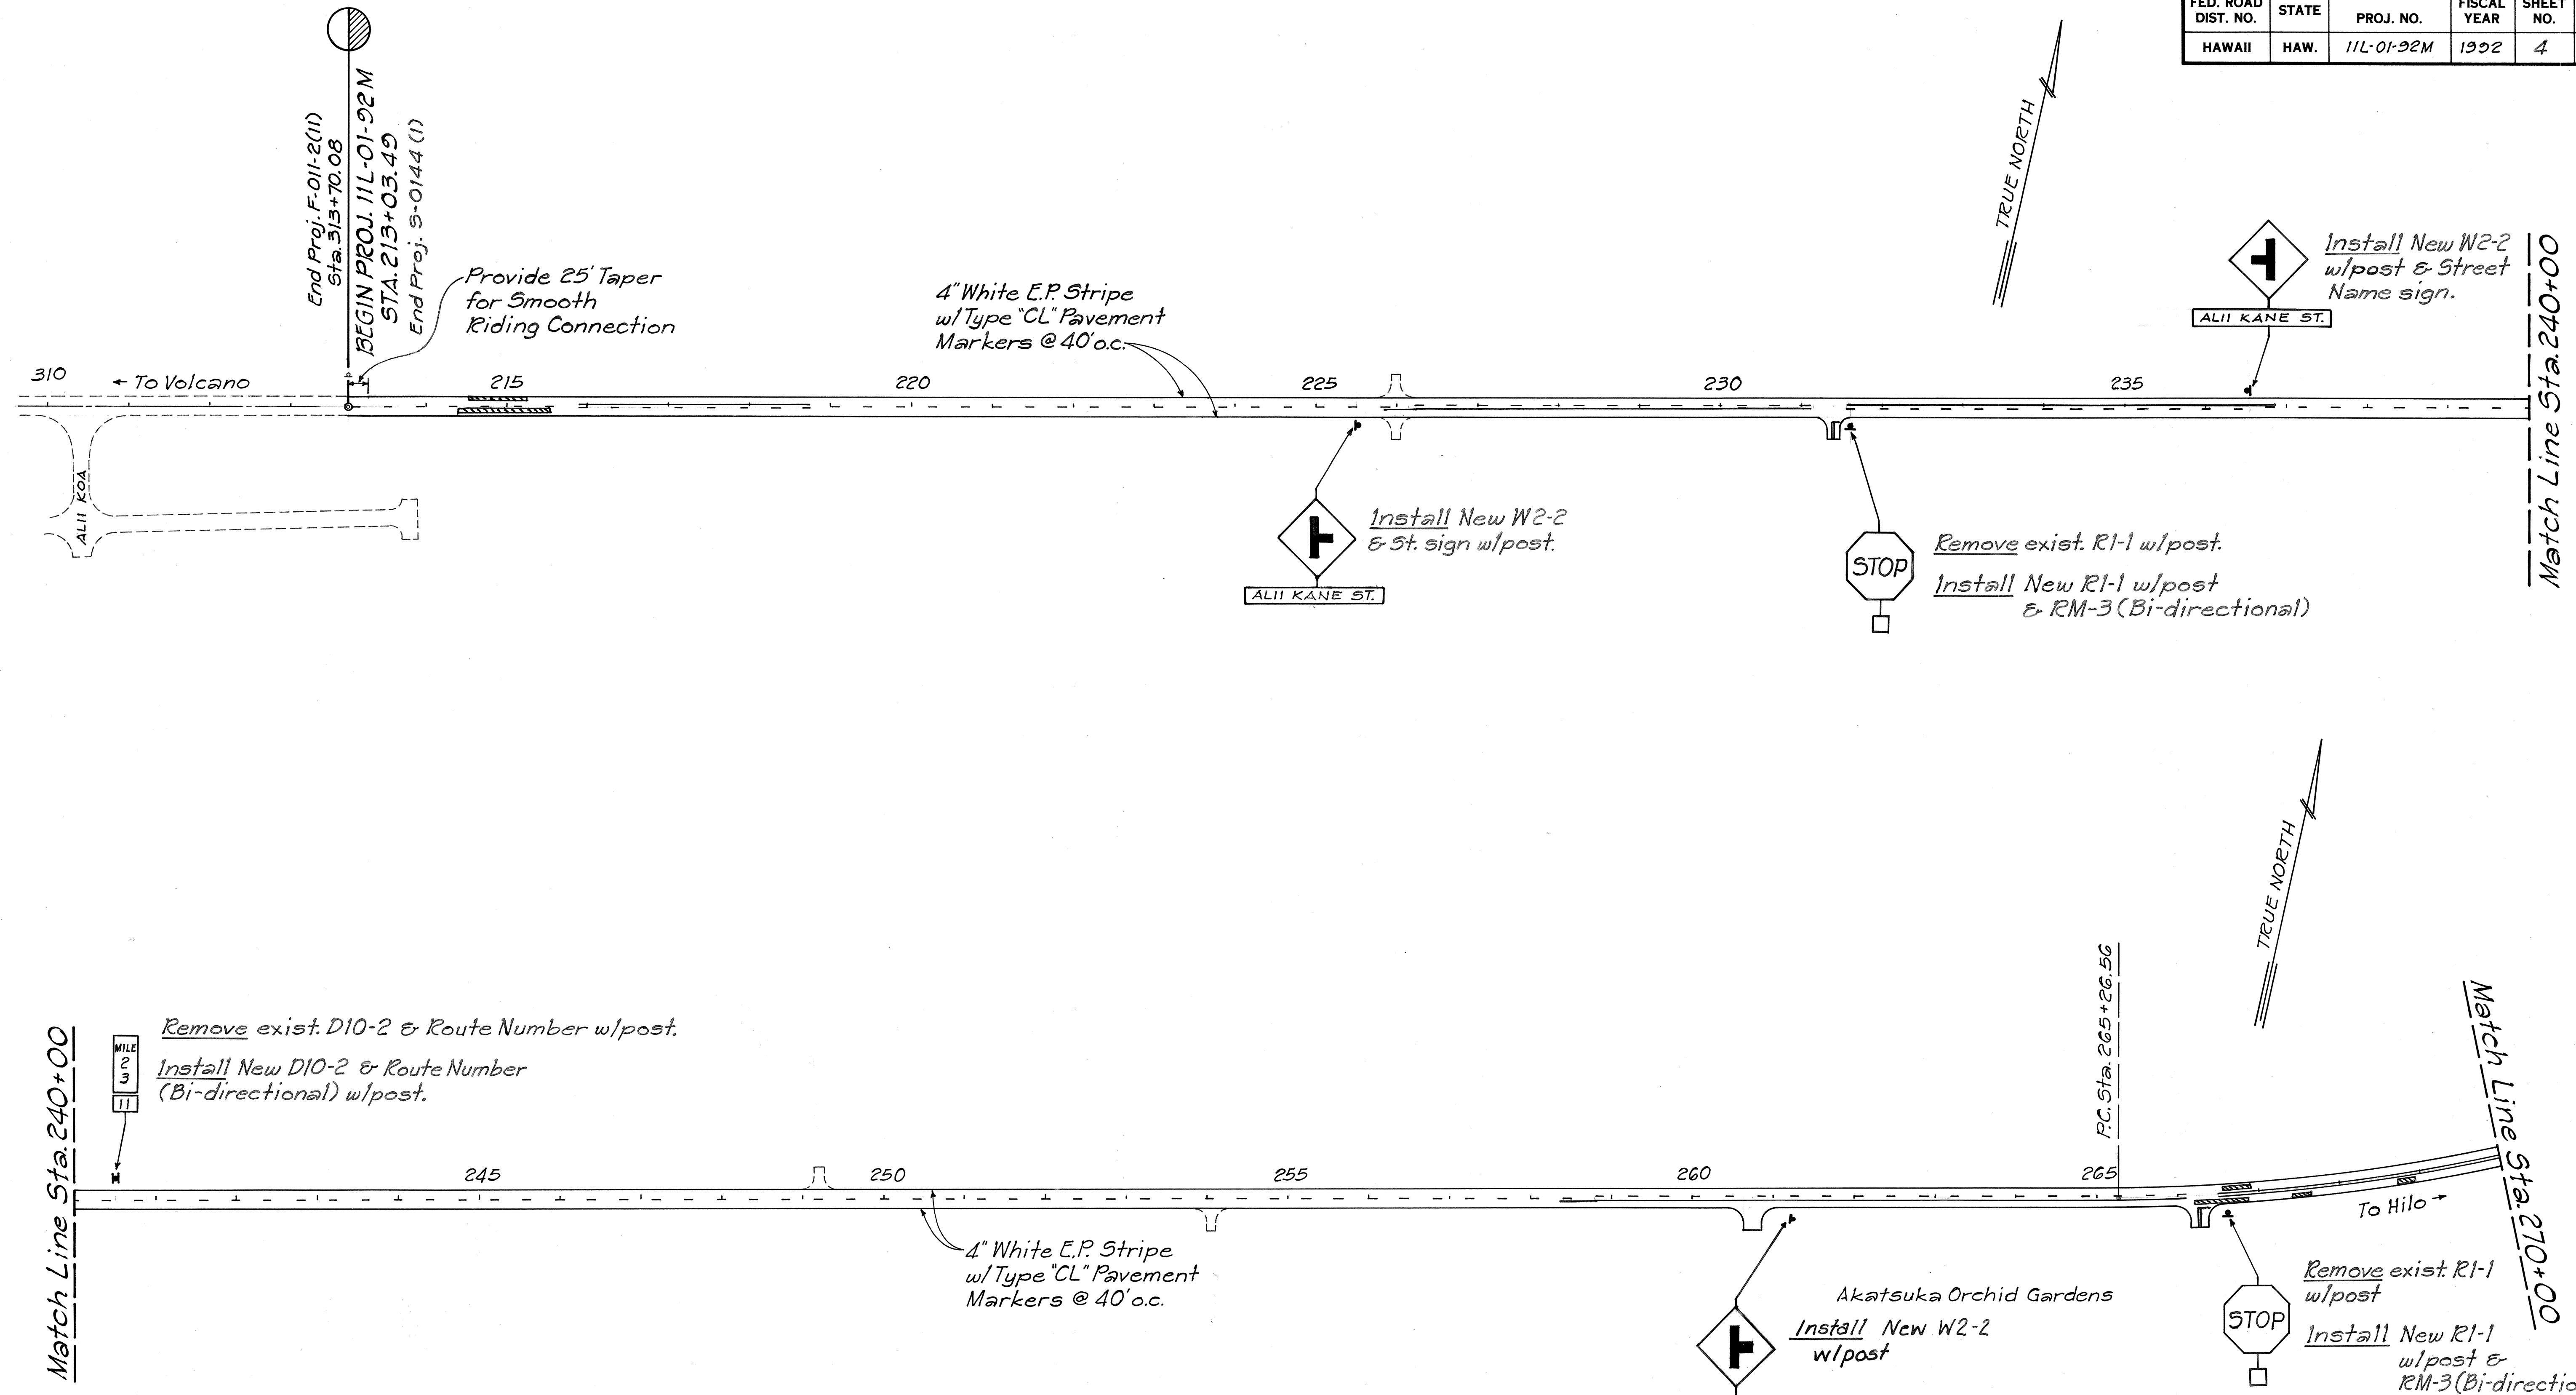

ORIGINAL PLAN	SURVEY PLOTTED BY	DATE
NOTE BOOK	DRAWN BY	
No.	DESIGNED BY	
	CHECKED BY	

STATE OF HAWAII
DEPARTMENT OF TRANSPORTATION
HIGHWAYS DIVISION


ROADWAY & STRIPING PLAN

VOLCANO ROAD RESURFACING
GLENWOOD
PROJECT No. 11L-01-22M

Scale: 1"=100' Date: Dec. 1991

SHEET NO. 1 OF 3 SHEETS

FED. ROAD DIST. NO.	STATE	PROJ. NO.	FISCAL YEAR	SHEET NO.	TOTAL SHEETS
HAWAII	HAW.	11L-01-02M	1992	5	8


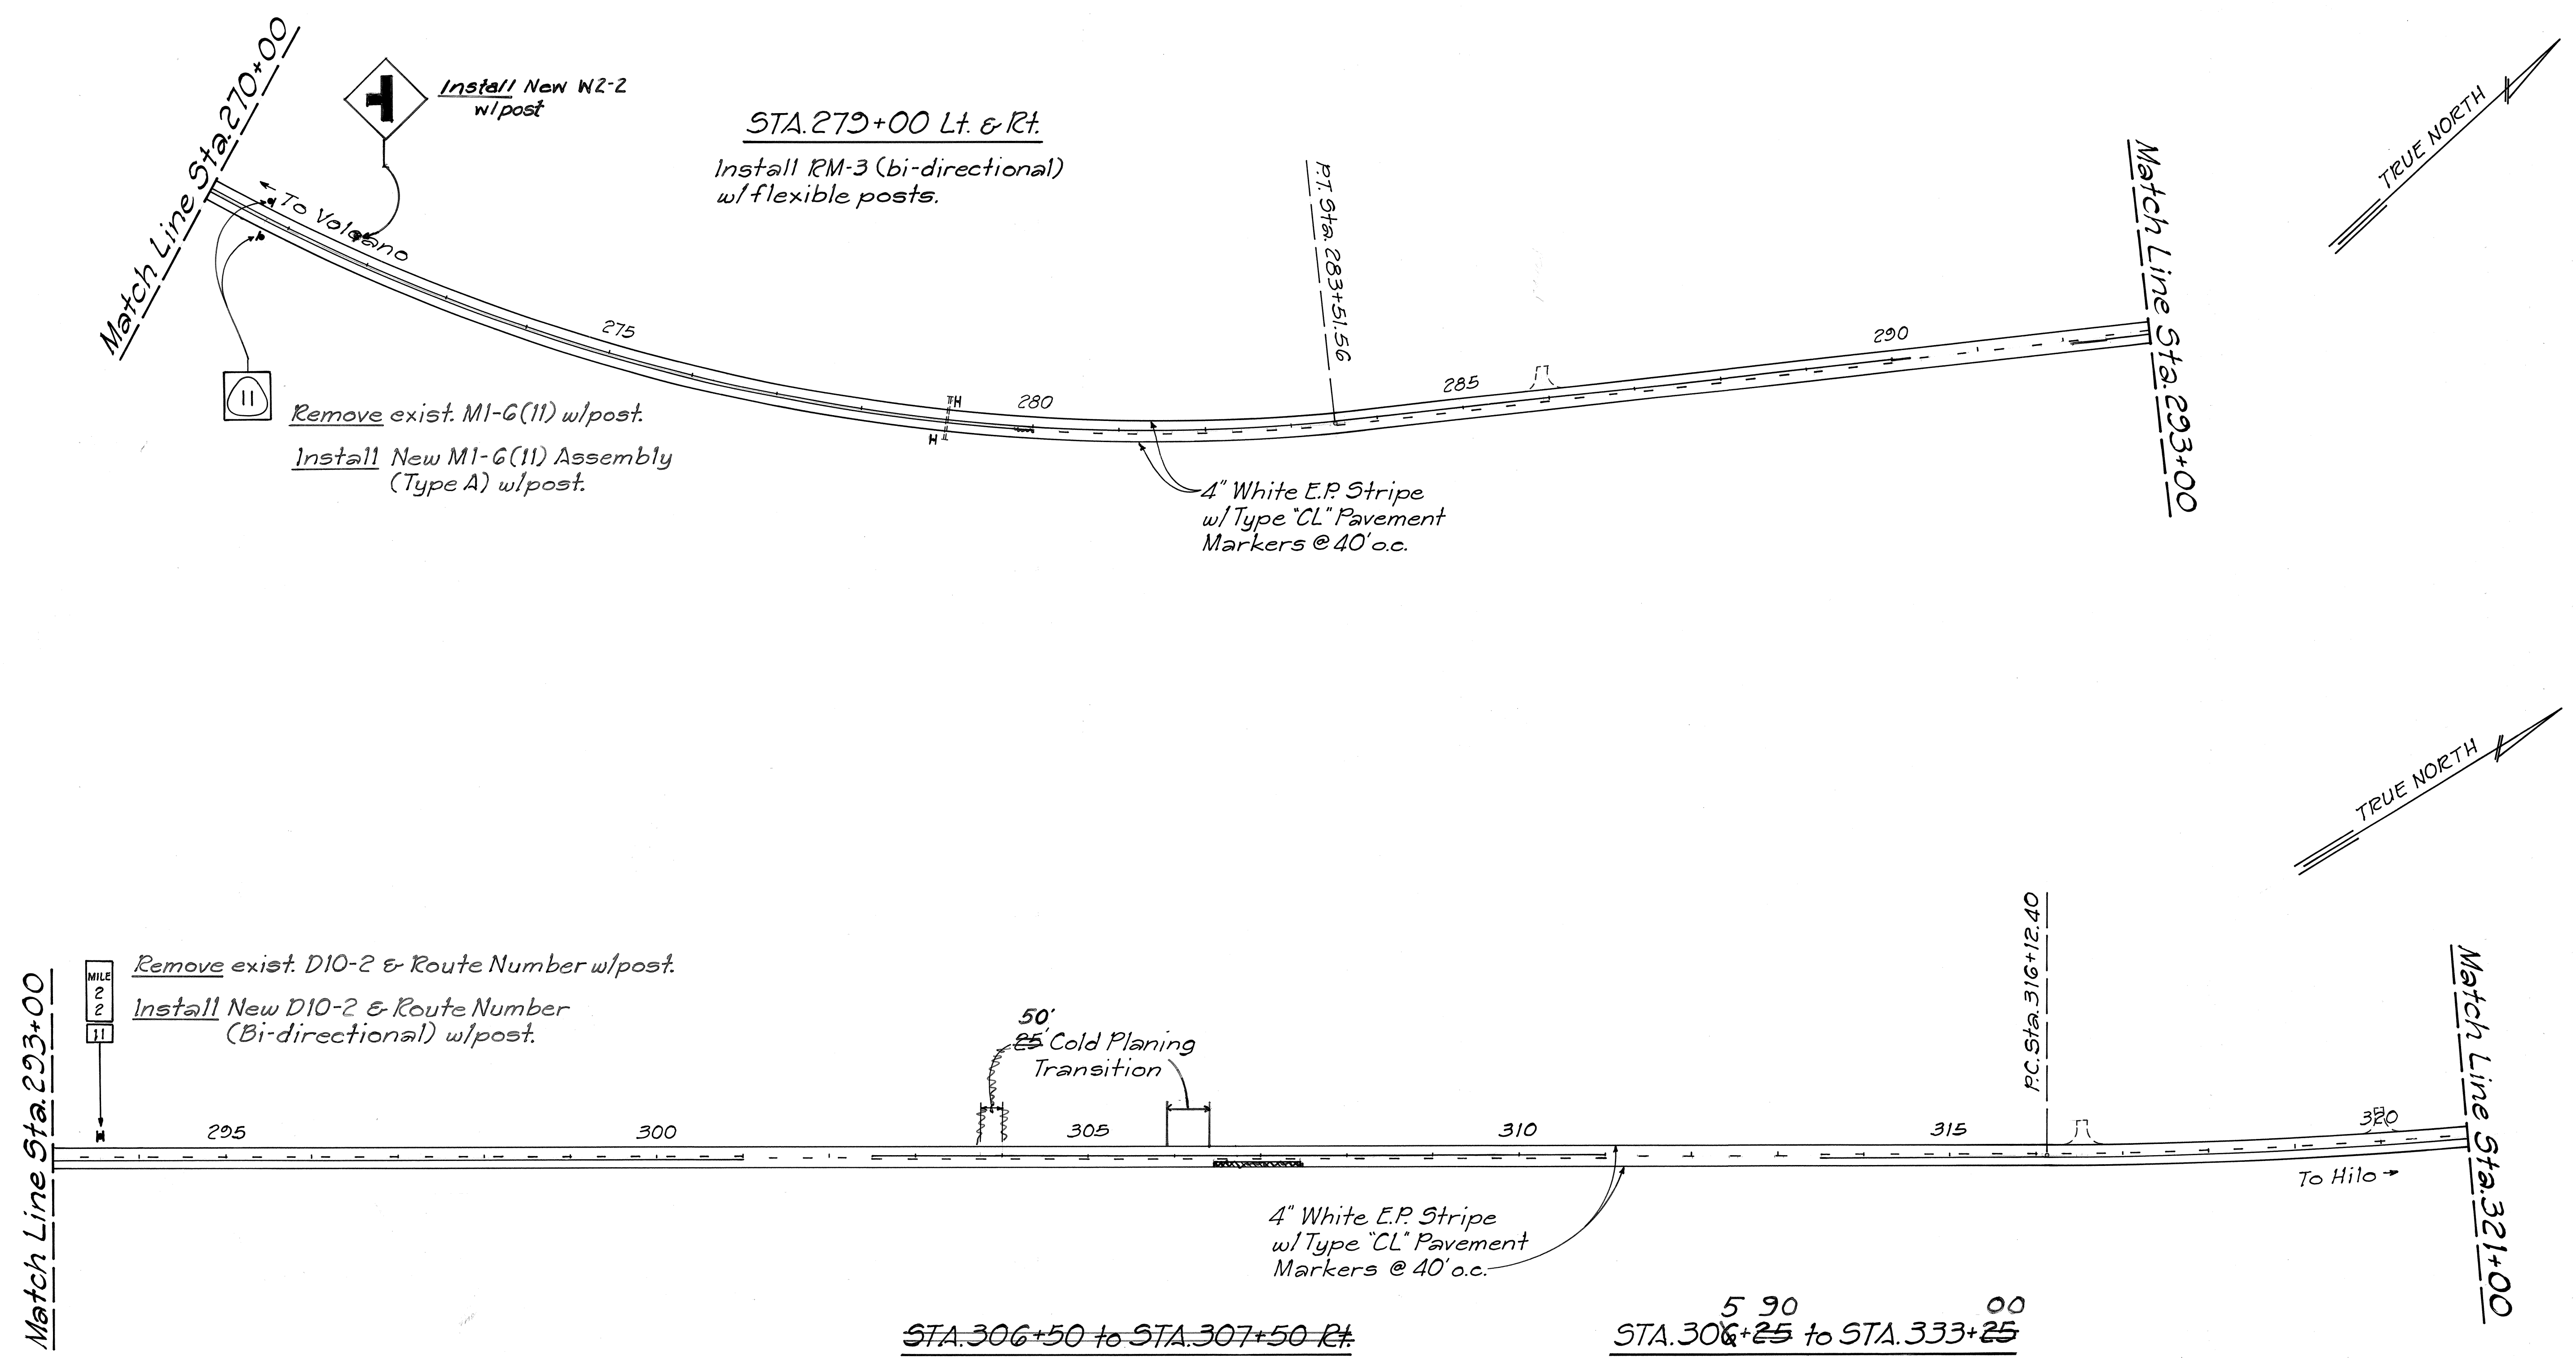


ORIGINAL PLAN	DATE
SURVEY PLOTTED BY	
DRAWN BY	
DESIGNED BY	
CHECKED BY	
NOTE BOOK	
No.	


STATE OF HAWAII
DEPARTMENT OF TRANSPORTATION
HIGHWAYS DIVISION

ROADWAY & STRIPING PLAN
VOLCANO ROAD RESURFACING
GLENWOOD
PROJECT No. 11L-01-02M
Scale: 1" = 100' Date: Dec. 1991
SHEET NO. 2 OF 3 SHEETS

FED. ROAD DIST. NO.	STATE	PROJ. NO.	FISCAL YEAR	SHEET NO.	TOTAL SHEETS
HAWAII	HAW.	11L-01-92M	1992	6	8

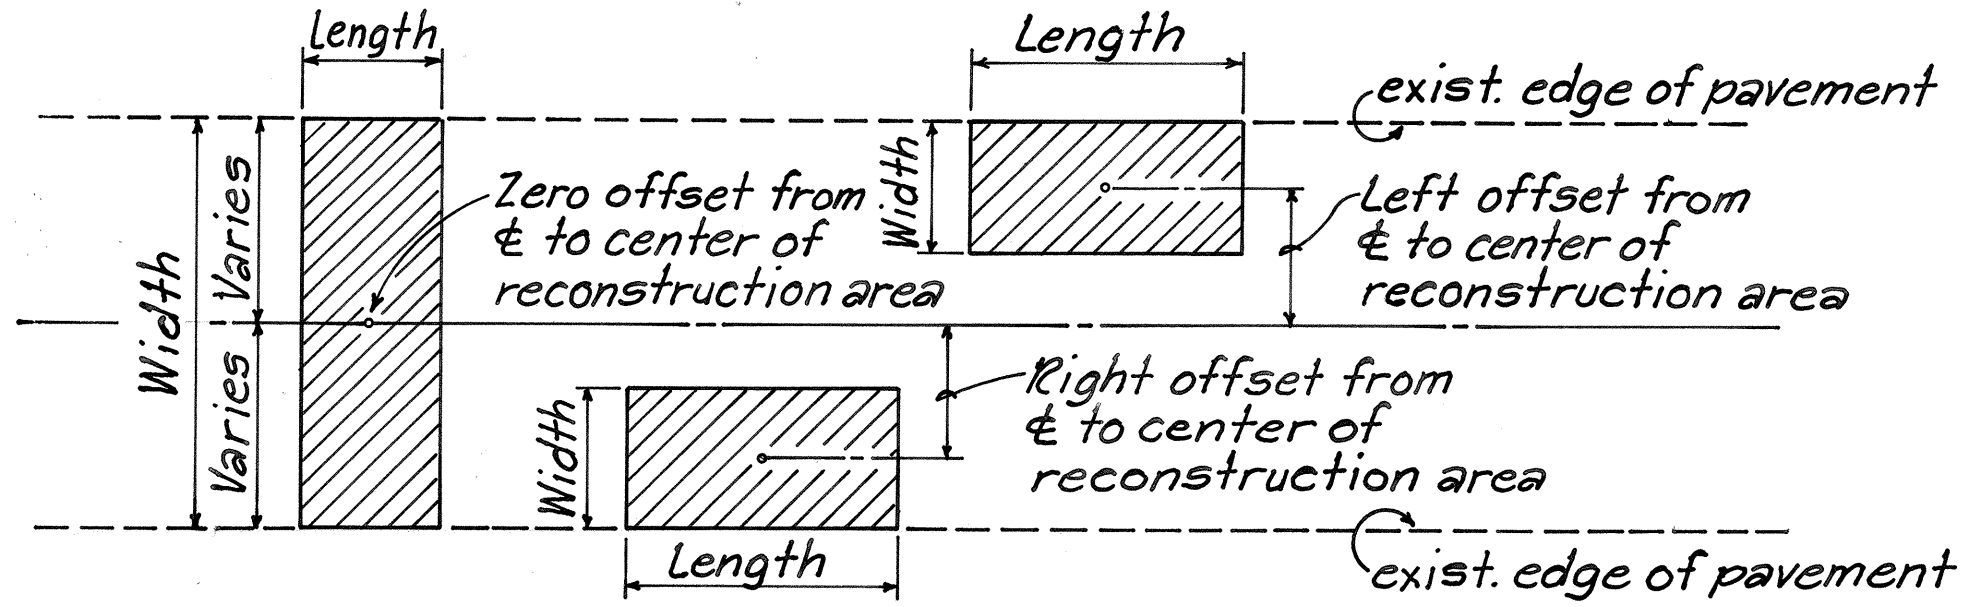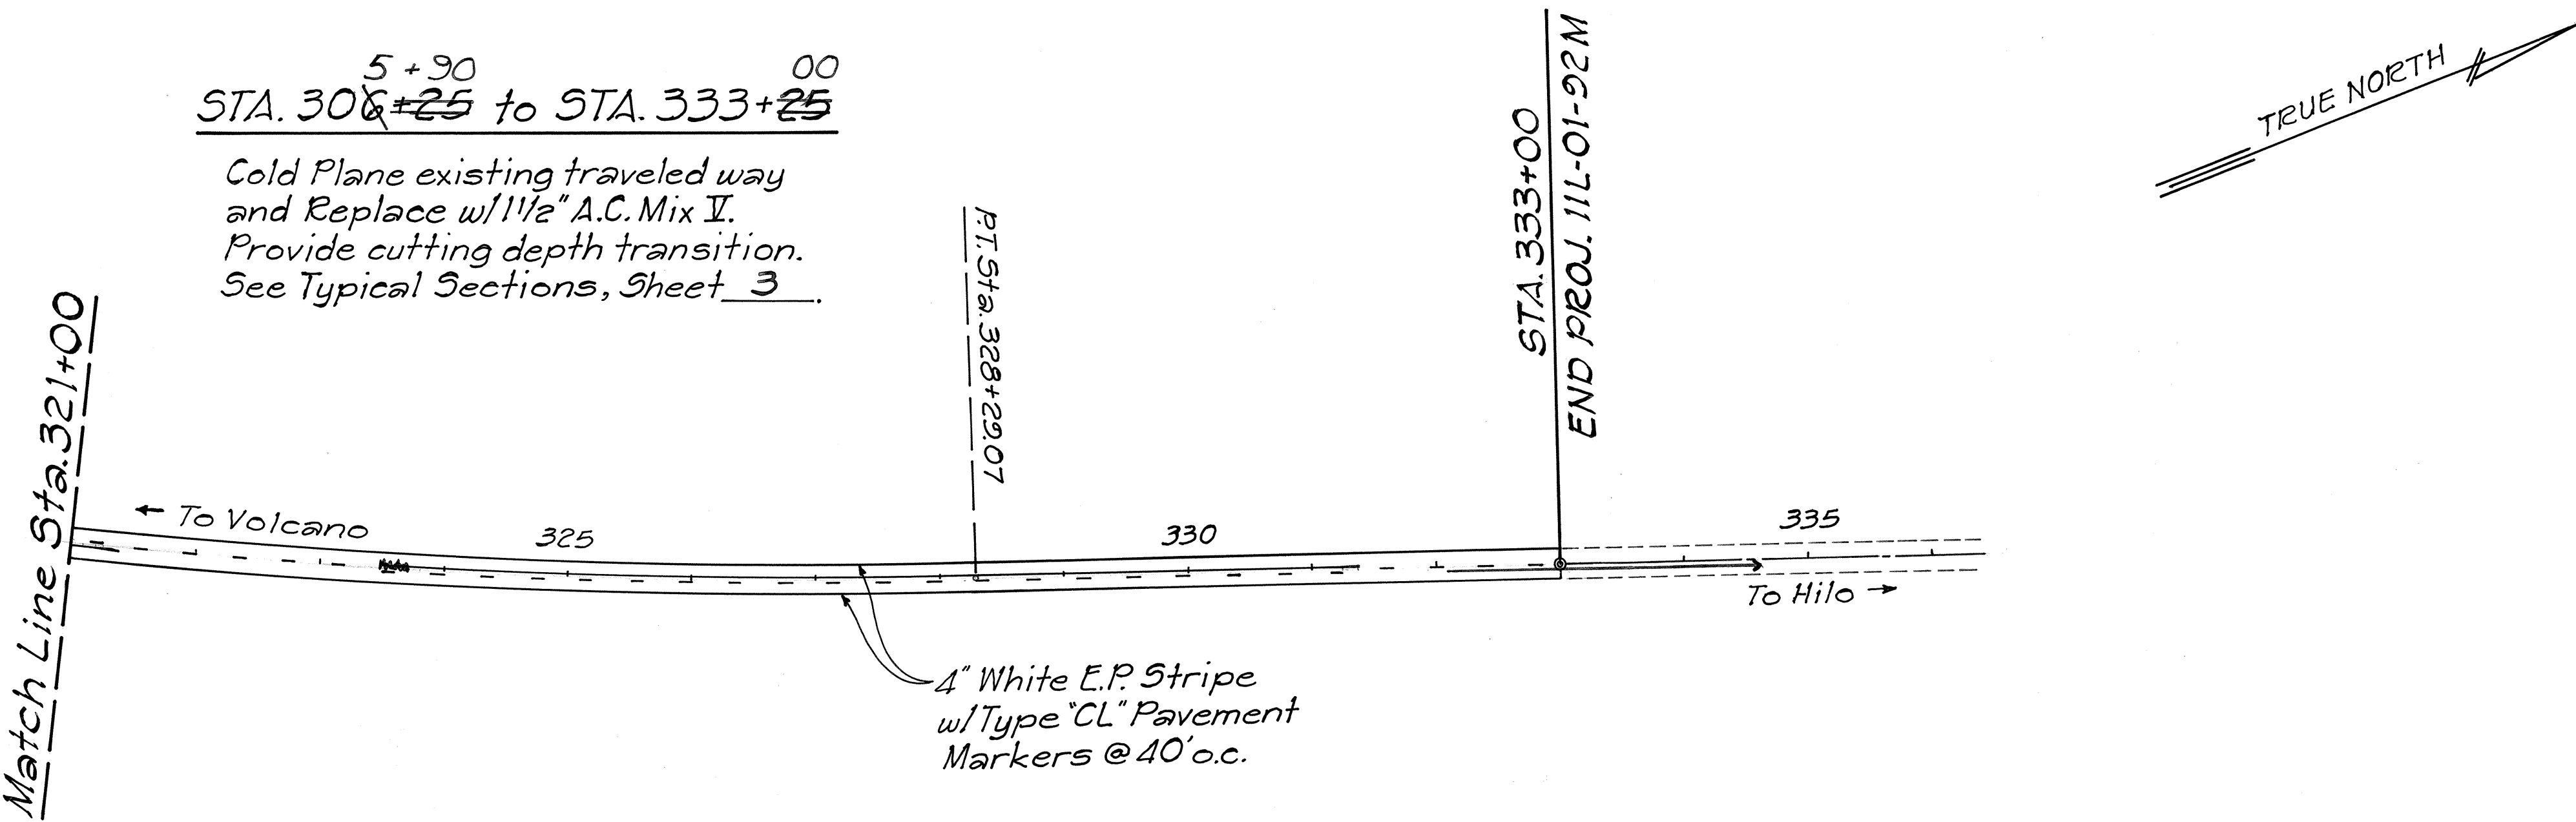

TYPICAL PLAN

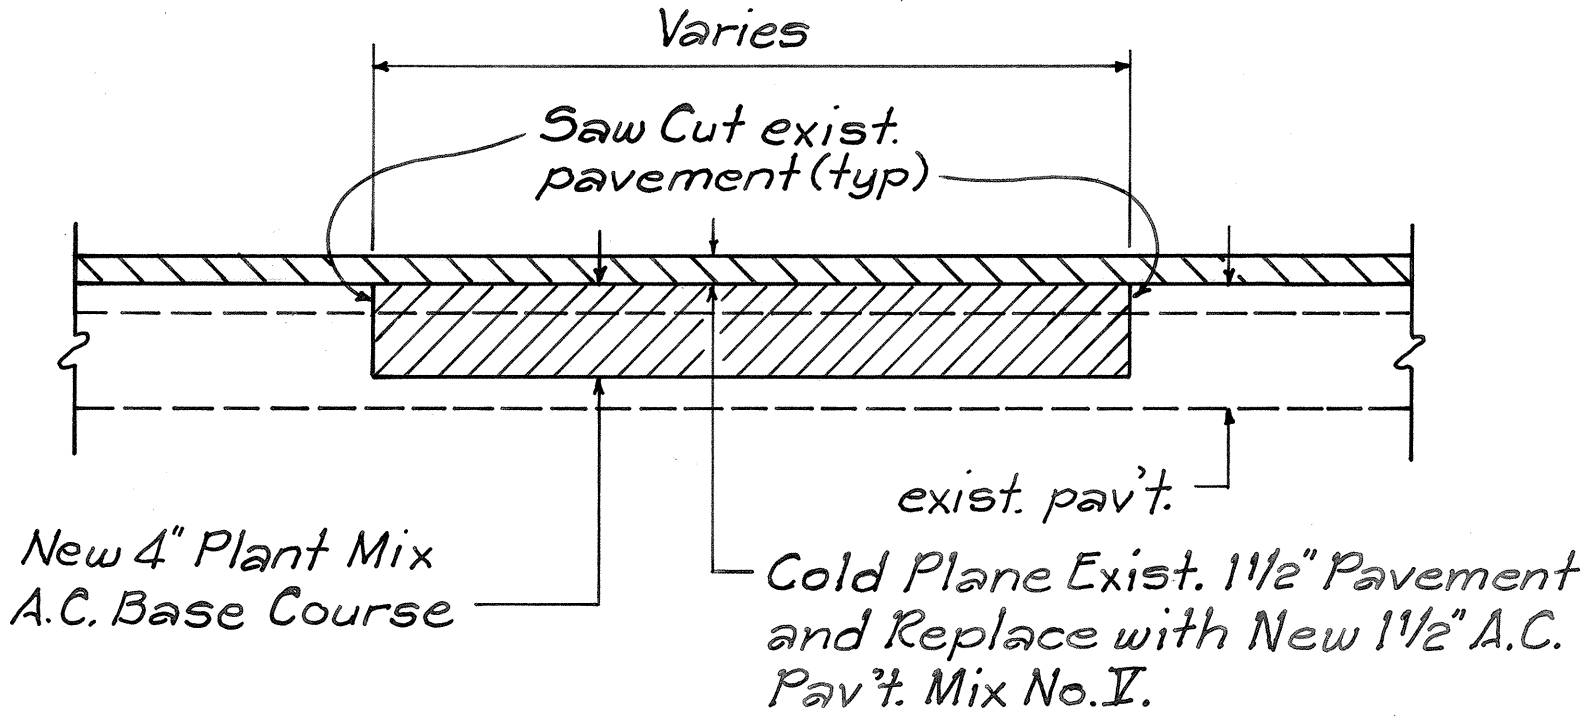

TYPICAL SECTION

PAVEMENT RECONSTRUCTION DETAIL
NOT TO SCALE

RECONSTRUCTION AREA SCHEDULE						
STATION		OFFSET FROM CL (FT.)		LENGTH	WIDTH	APPROX AREA
FROM	TO	LT.	RT.	LIN. FT.	FT.	SQ. FT.
214+40	215+50		6.5	110	11	1,210
214+50	215+25	9.0		75	6	450
266+20	266+85		6.5	65	11	715
266+60	266+90	9.0		30	6	180
267+40	267+60		9.0	20	6	120
268+70	268+90		6.5	20	11	220
TOTAL						2,895

ORIGINAL PLAN	SURVEY PLOTTED BY	DATE
NOTE BOOK	DRAWN BY	
No.	DESIGNED BY	
	CHECKED BY	

STATE OF HAWAII
DEPARTMENT OF TRANSPORTATION
HIGHWAYS DIVISION

ROADWAY & STRIPING PLAN
VOLCANO ROAD RESURFACING
GLENWOOD
PROJECT No. 11L-01-92M
Scale: 1" = 100' Date: Dec. 1991
SHEET NO. 3 OF 3 SHEETS