

STATE OF HAWAII

## DEPARTMENT OF TRANSPORTATION

HIGHWAYS DIVISION HONOLULU, HAWAII

"AS-BUILT"


PLANS FOR

## VOLCANO ROAD RESURFACING

GLENWOOD


PROJECT NO. 11L-01-92M

DISTRICT OF PUNA ISLAND OF HAWAII

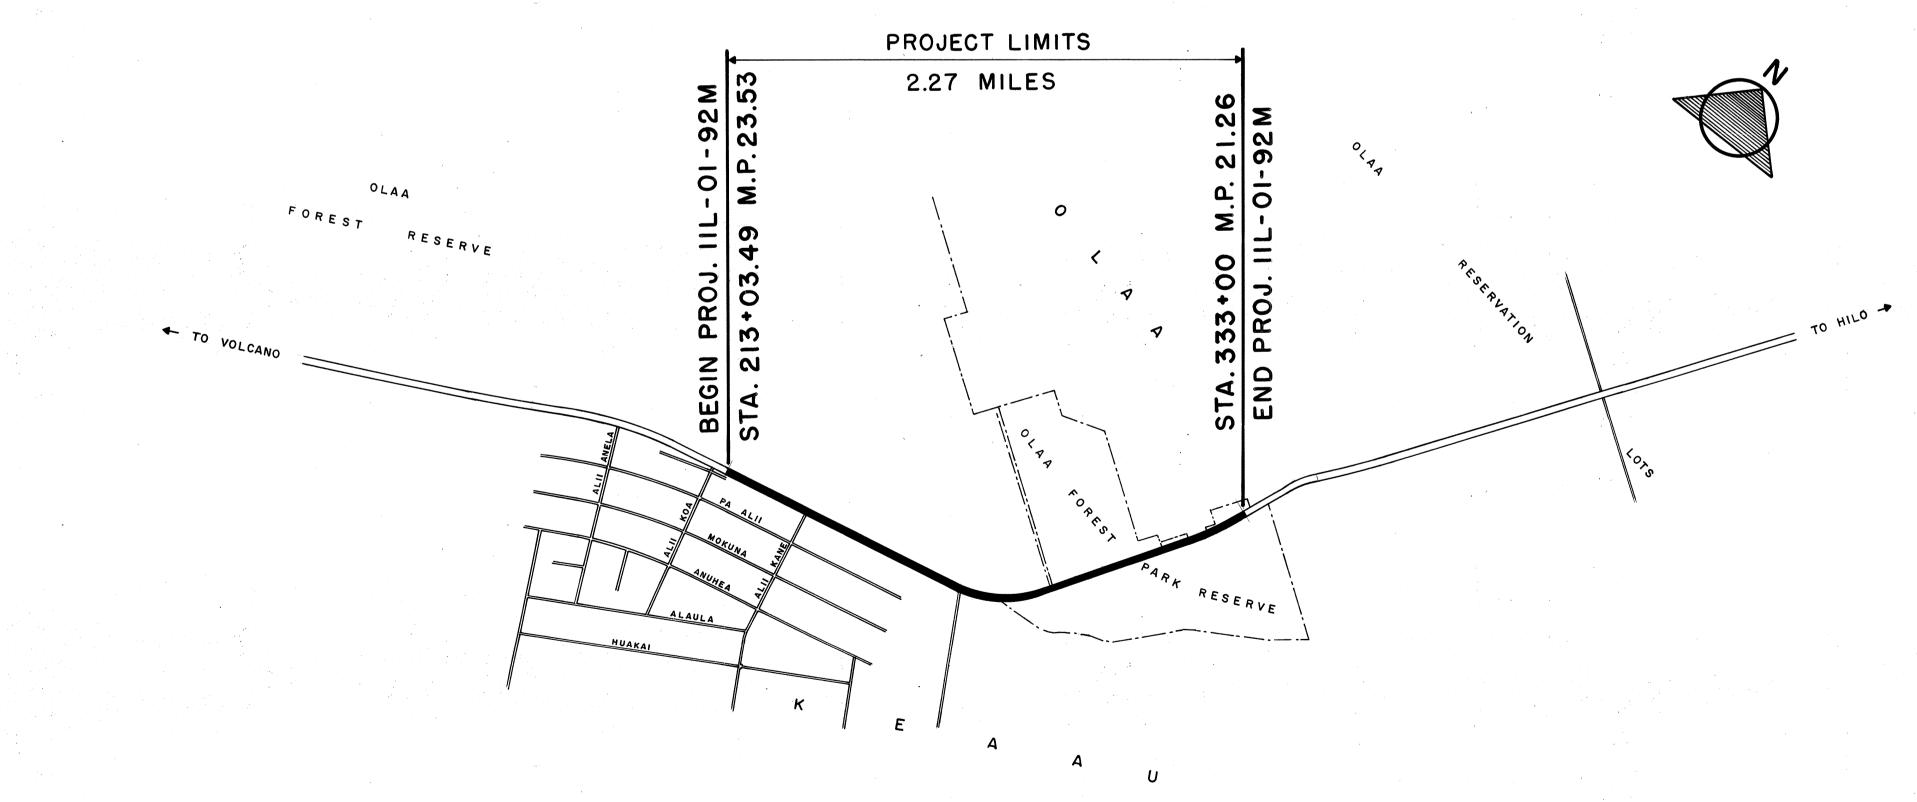

GENERAL LOCATION MAP

SCALE: IN MILES

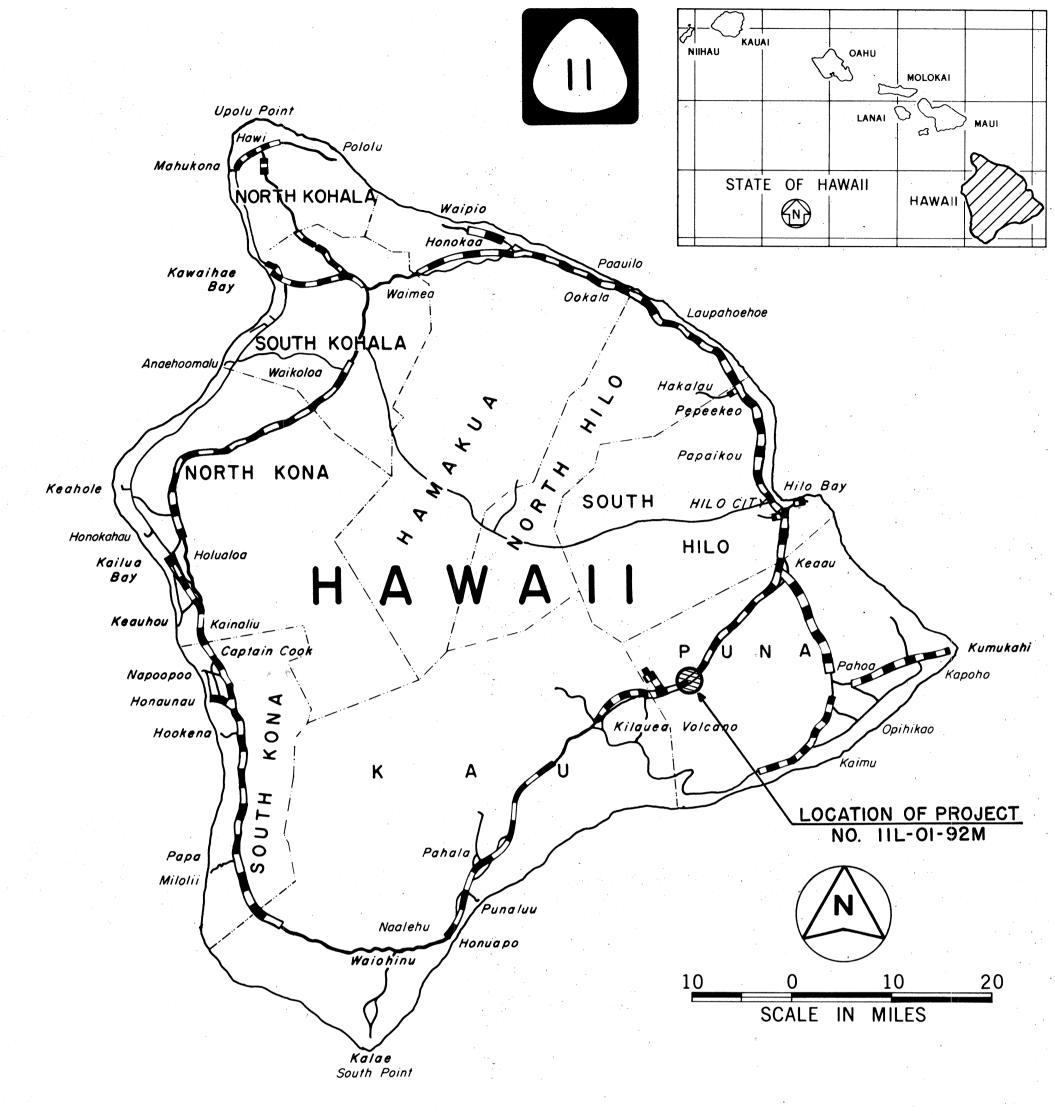

FED. ROAD DIST. NO.

HAW.

FEDERAL AID PROJECTS PREVIOUSLY CONSTRUCTED OR UNDER CONSTRUCTION

MILE POST 21.26 TO MILE POST 23.53

CHANGES MADE DURING CONSTRUCTION HAVE BEEN INCORPORATED ON THESE PLANS EXCEPT CHANGES IN THE ORIGINAL THEORETICAL QUANTITIES.

Resident Engineer

Jan. 27, 1995 DATE

FISCAL YEAR

1992

PROJ. NO.

11L-01-92M

SHEET TOTAL NO. SHEETS

DEPARTMENT OF TRANSPORTATION STATE OF HAWAII

APPROVED:

DIR. OF TRANSPORTATION DATE

HAWAII DISTRICT DESIGNED BY

JAN, 1992 DATE

587-2249 PHONE

TAKAESU P. S. & E. BY

0-7-0