




FED. ROAD DIST. NO.	STATE	FED. AID PROJ. NO.	FISCAL YEAR	SHEET NO.	TOTAL SHEETS
HAWAII	HAW.	STP-011-2(26)	1993	5	15

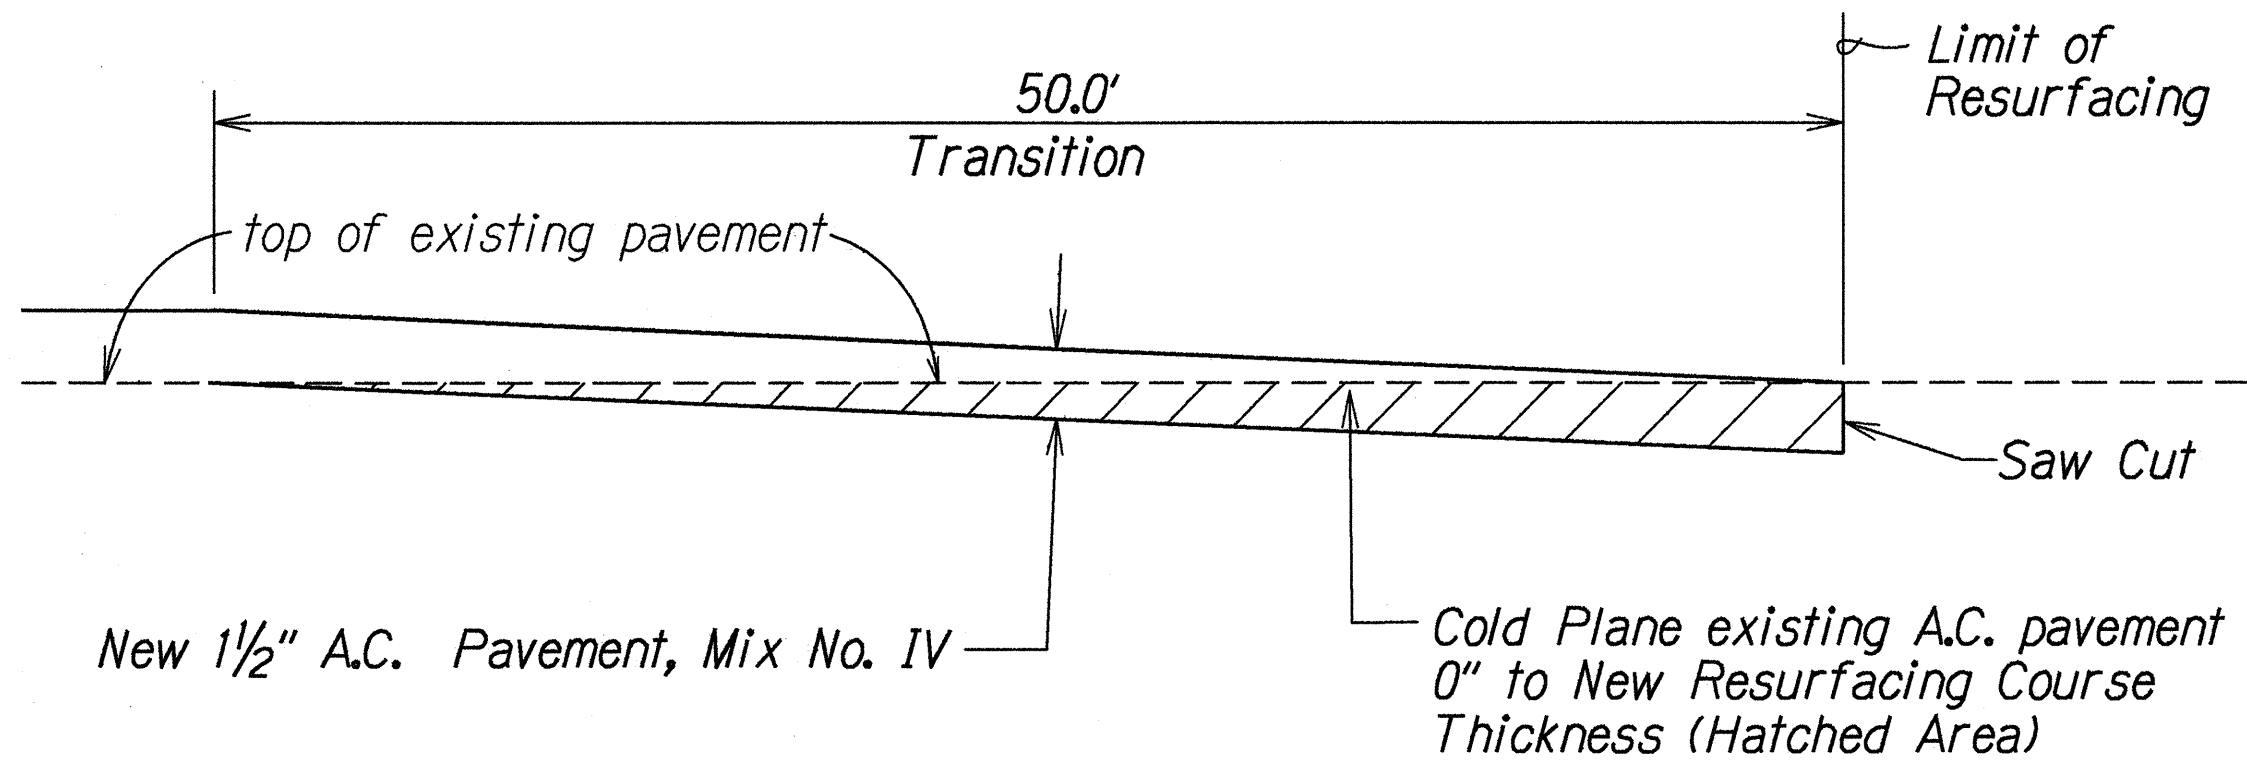


COLD PLANED TRANSITION
TO EXISTING A.C. PAVEMENT
Not To Scale

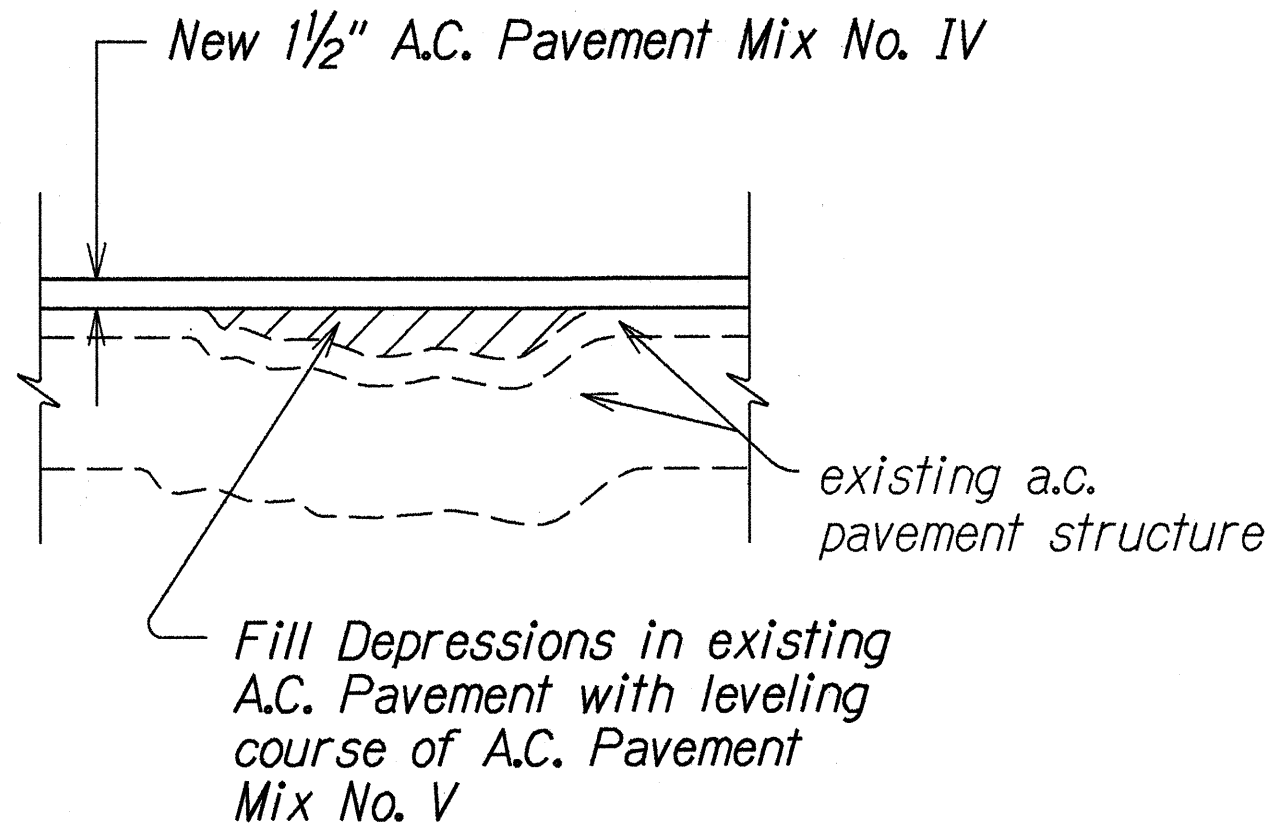


LEVELING COURSE DETAIL
Not To Scale

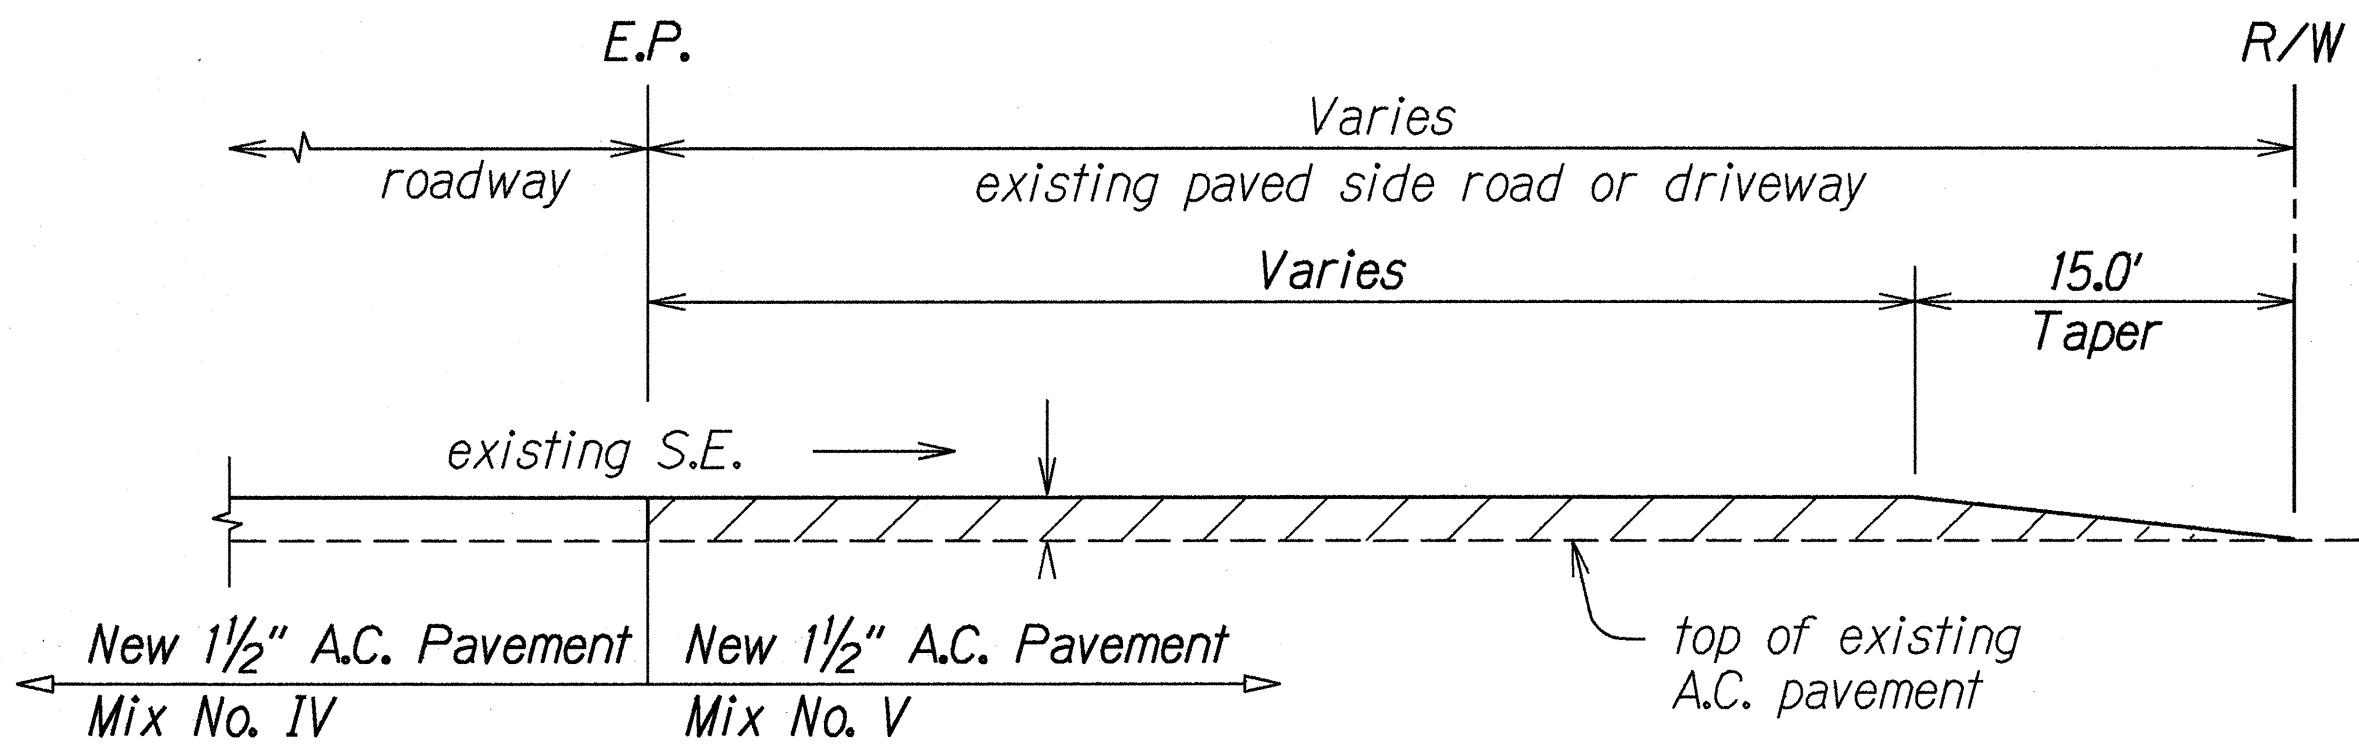

A. C. RESURFACING AT PAVED SIDEROAD
OR PAVED DRIVEWAY DETAIL
Not To Scale

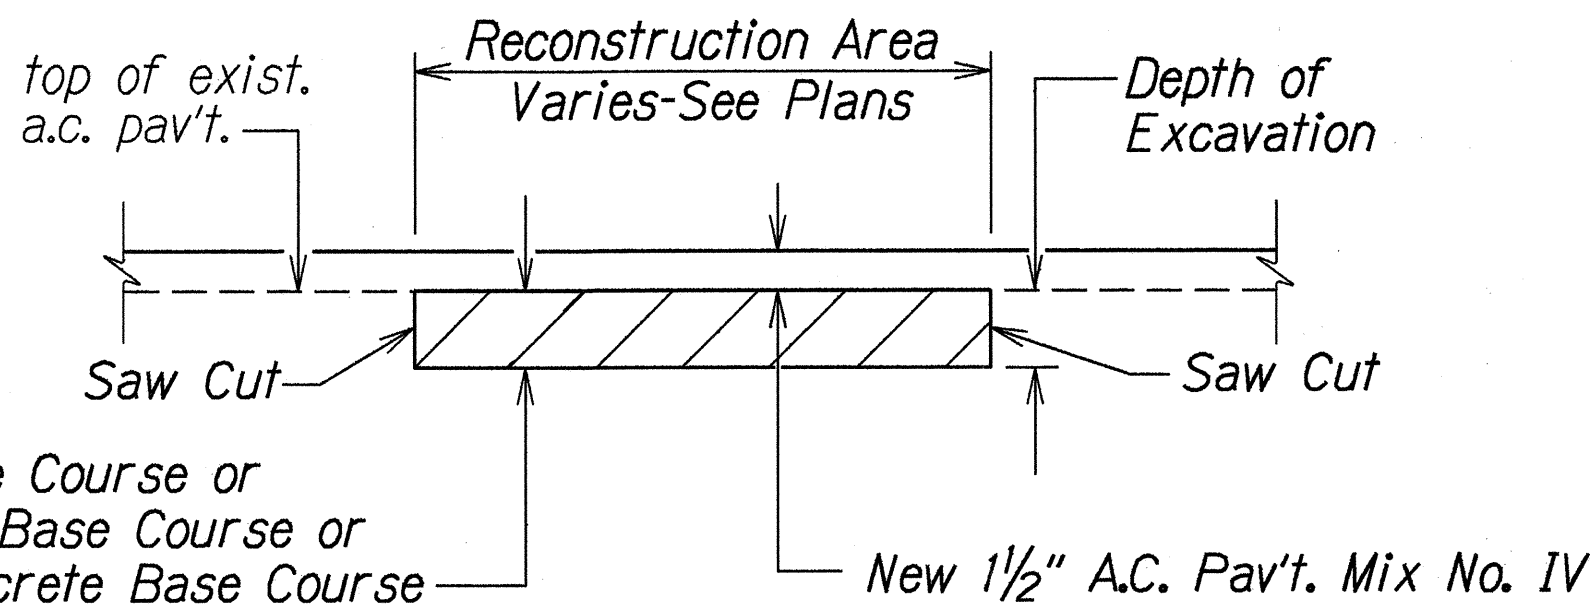

A.C. PAVEMENT RECONSTRUCTION DETAIL
Not To Scale

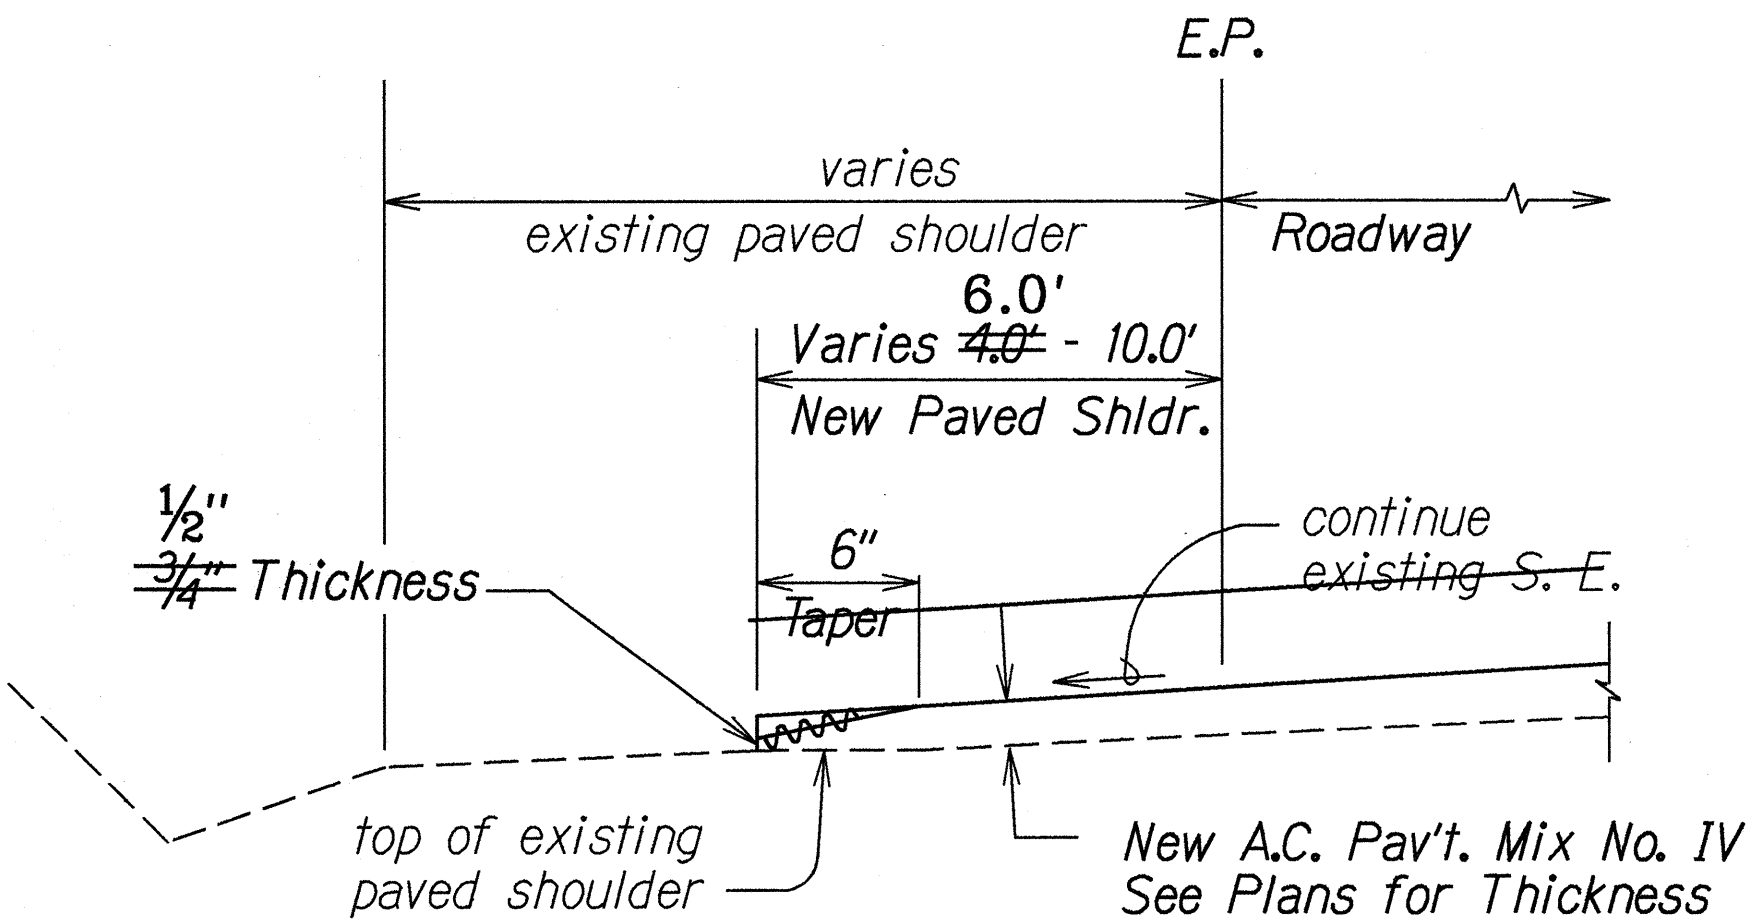

TYPICAL RESURFACING
AT PAVED SHOULDER DETAIL
Not To Scale

LEGEND FOR AS-BUILT POSTINGS	
	Squiggly line for as-built deletion
	Double line for as-built deletion
Roadway	Text for as-built posting

STATE OF HAWAII DEPARTMENT OF TRANSPORTATION HIGHWAYS DIVISION	
TYPICAL DETAILS	
VOLCANO ROAD RESURFACING	
Vicinity of Hawaii Volcano National Park	
F.A. Project No. STP-011-2(26)	
Scale: As Shown	Date: May, 1993
SHEET No. 2 OF 2 SHEETS	