




FED. ROAD DIST. NO.	STATE	FED. AID PROJ. NO.	FISCAL YEAR	SHEET NO.	TOTAL SHEETS
HAWAII	HAW.	STP-011-2(28)	1994	4	10

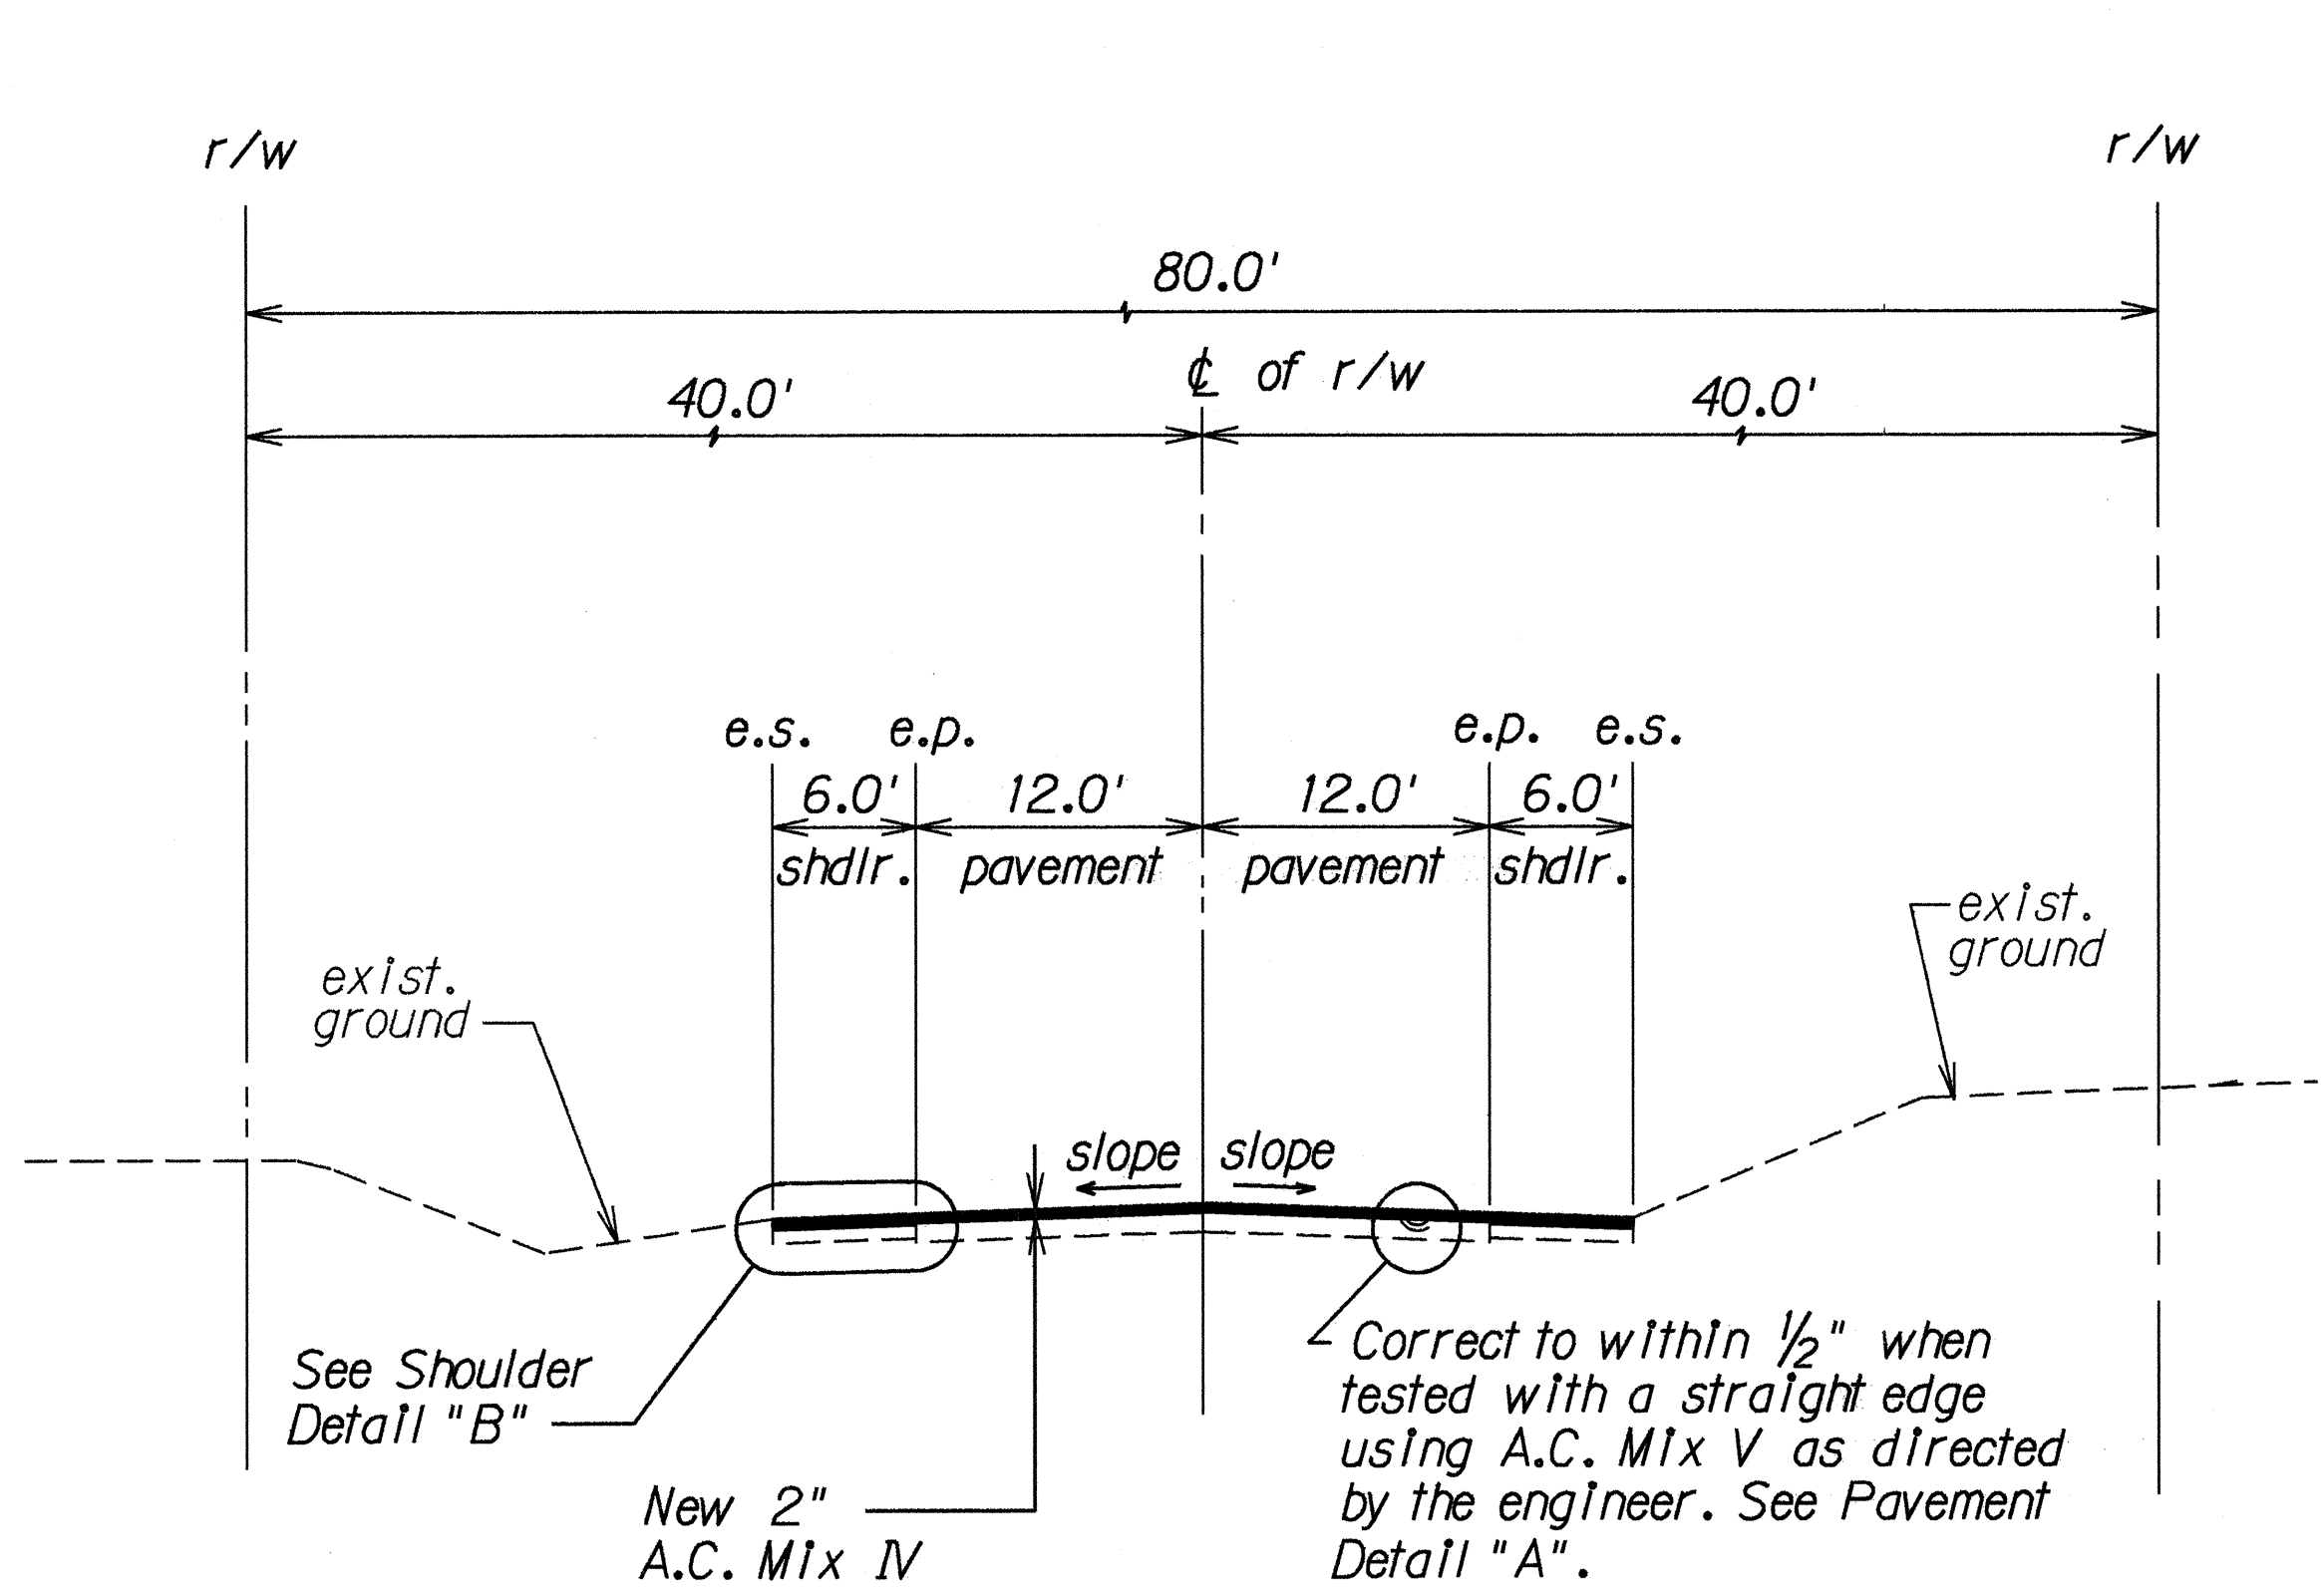


TYPICAL SECTION
Not To Scale

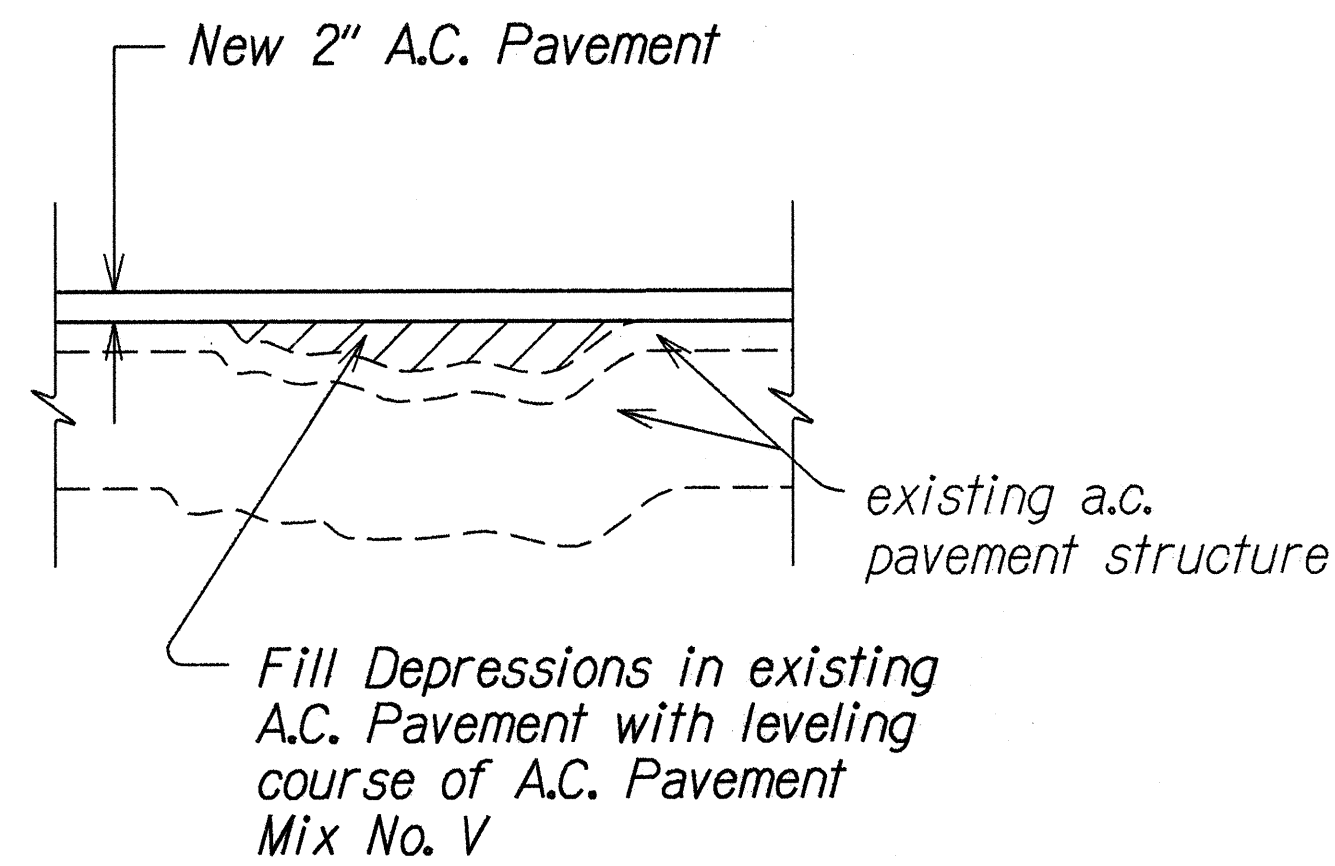


PAVEMENT DETAIL "A"
Not To Scale

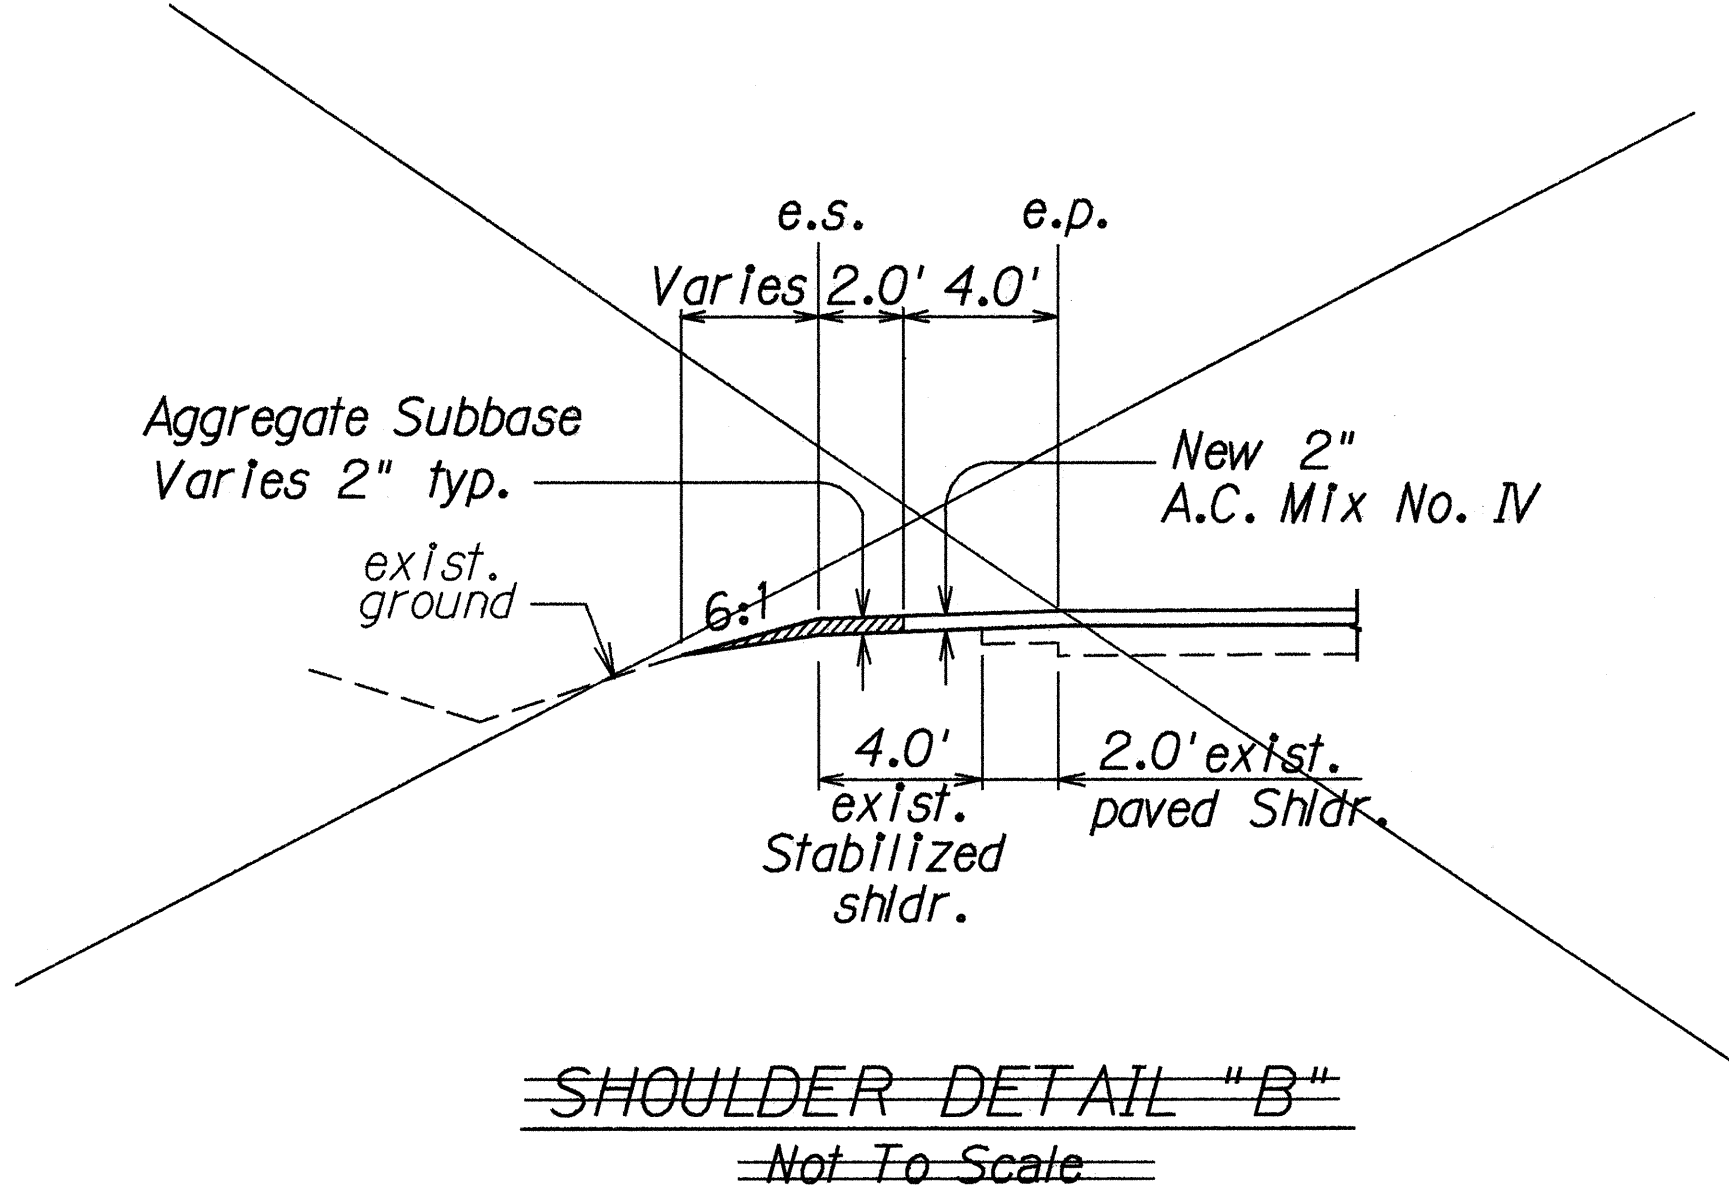


SHOULDER DETAIL "B"
Not To Scale

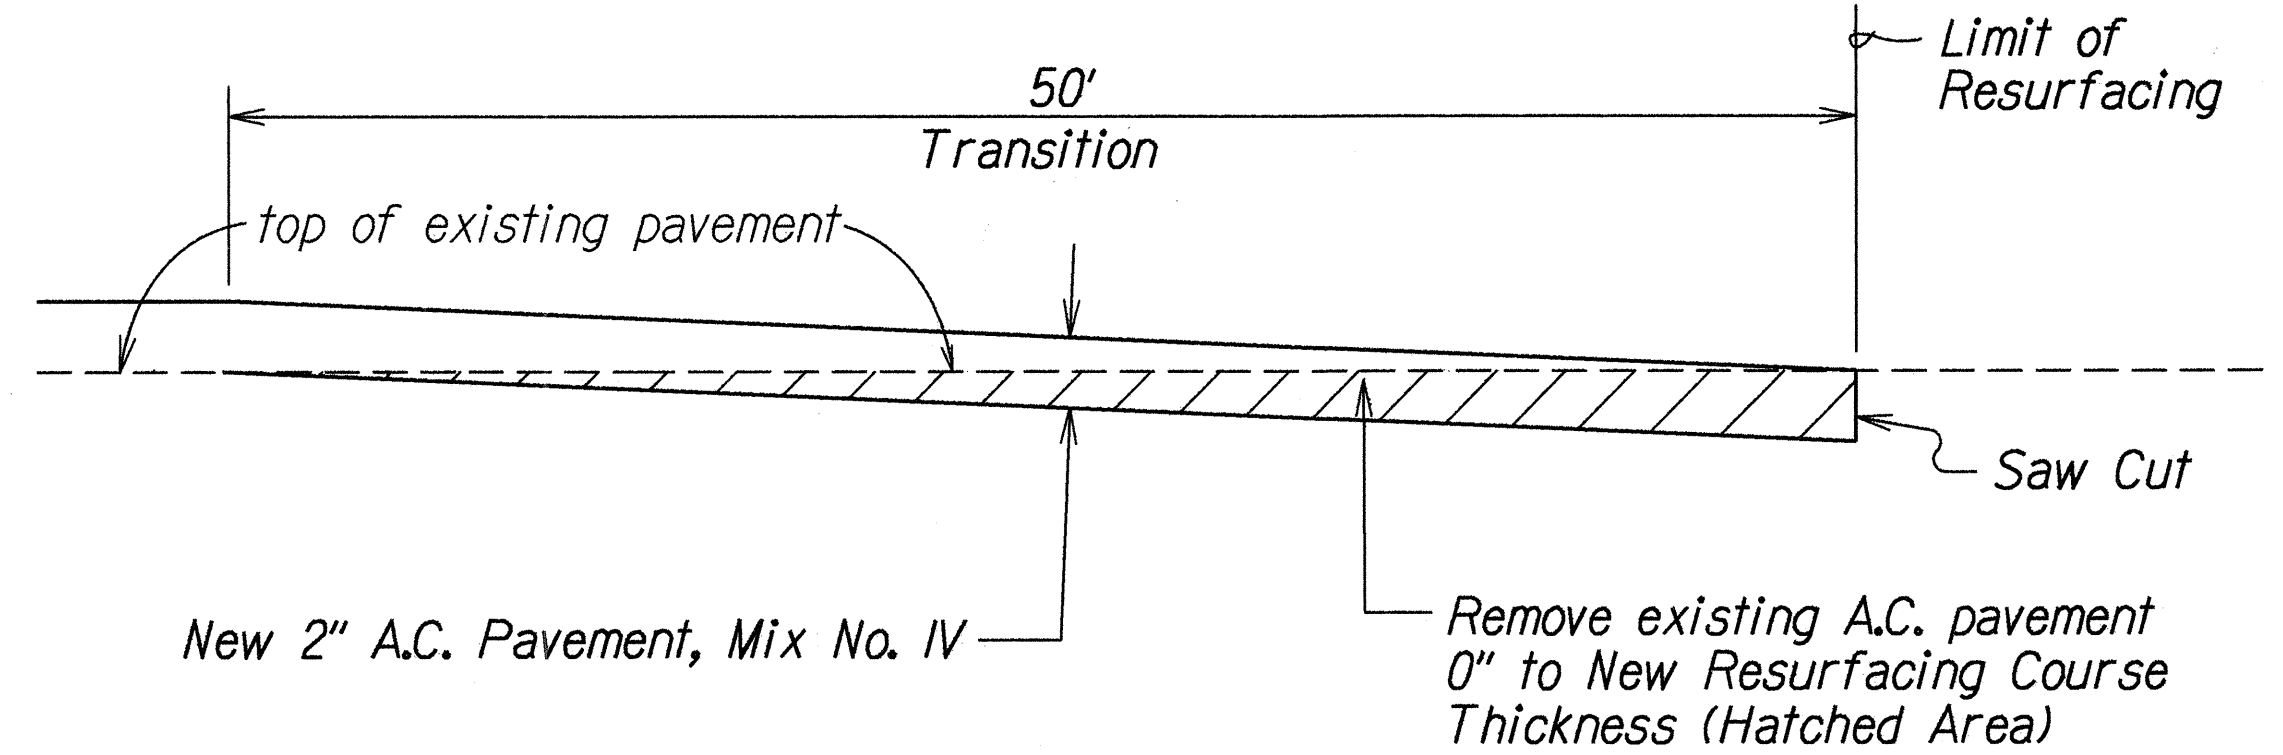

COLD PLANED TRANSITION TO EXISTING A.C.
PAVEMENT @ BOTH ENDS OF PROJECT
Not To Scale

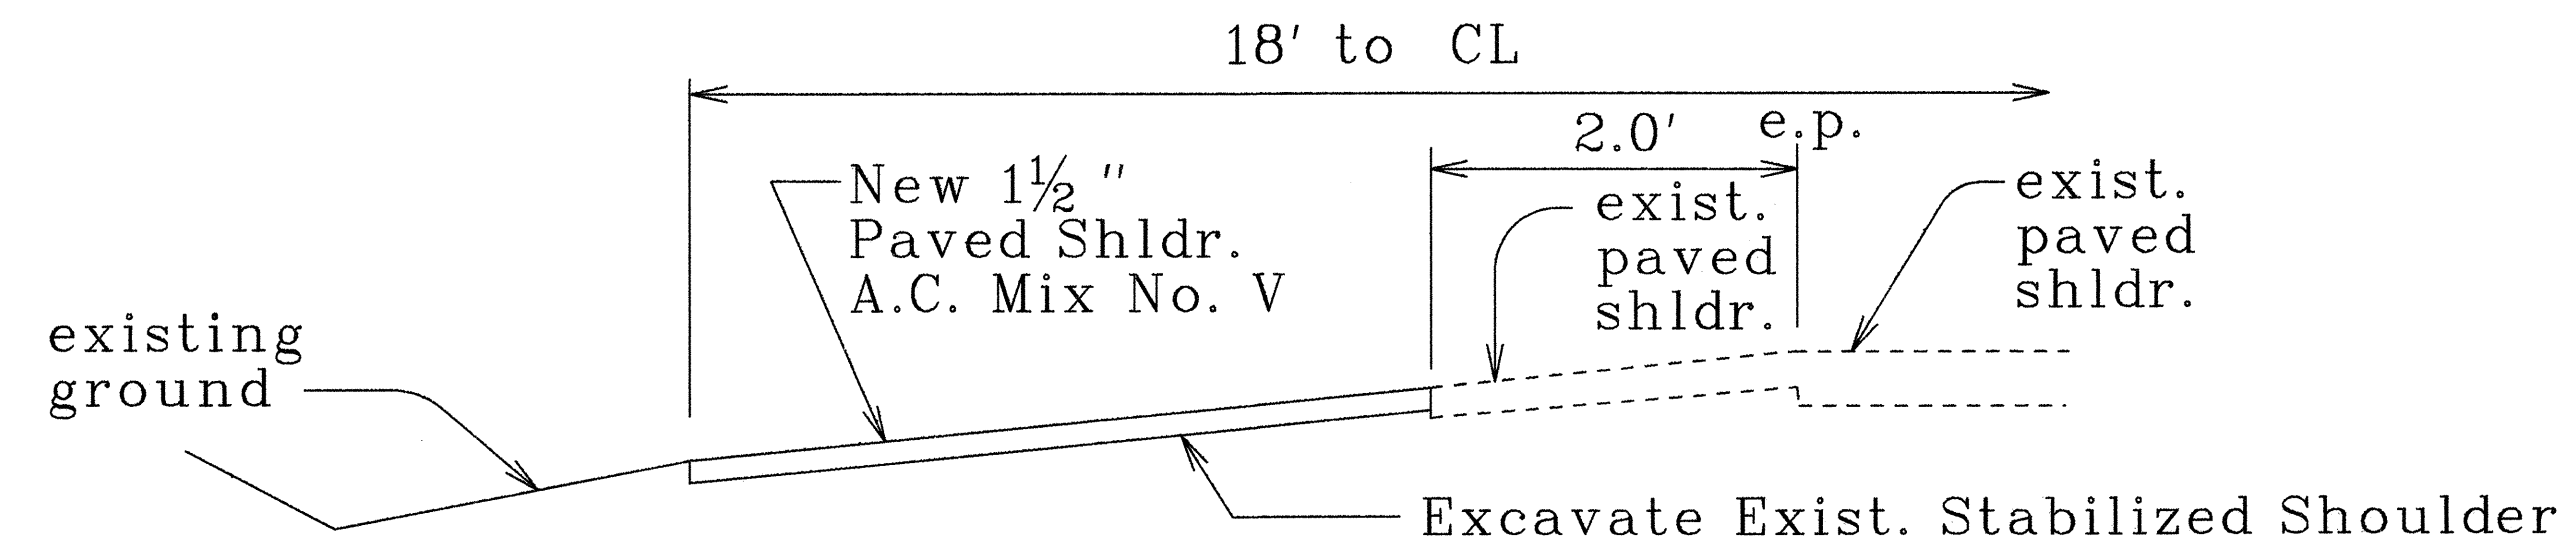

Shoulder Detail for Exceptions
Not to scale

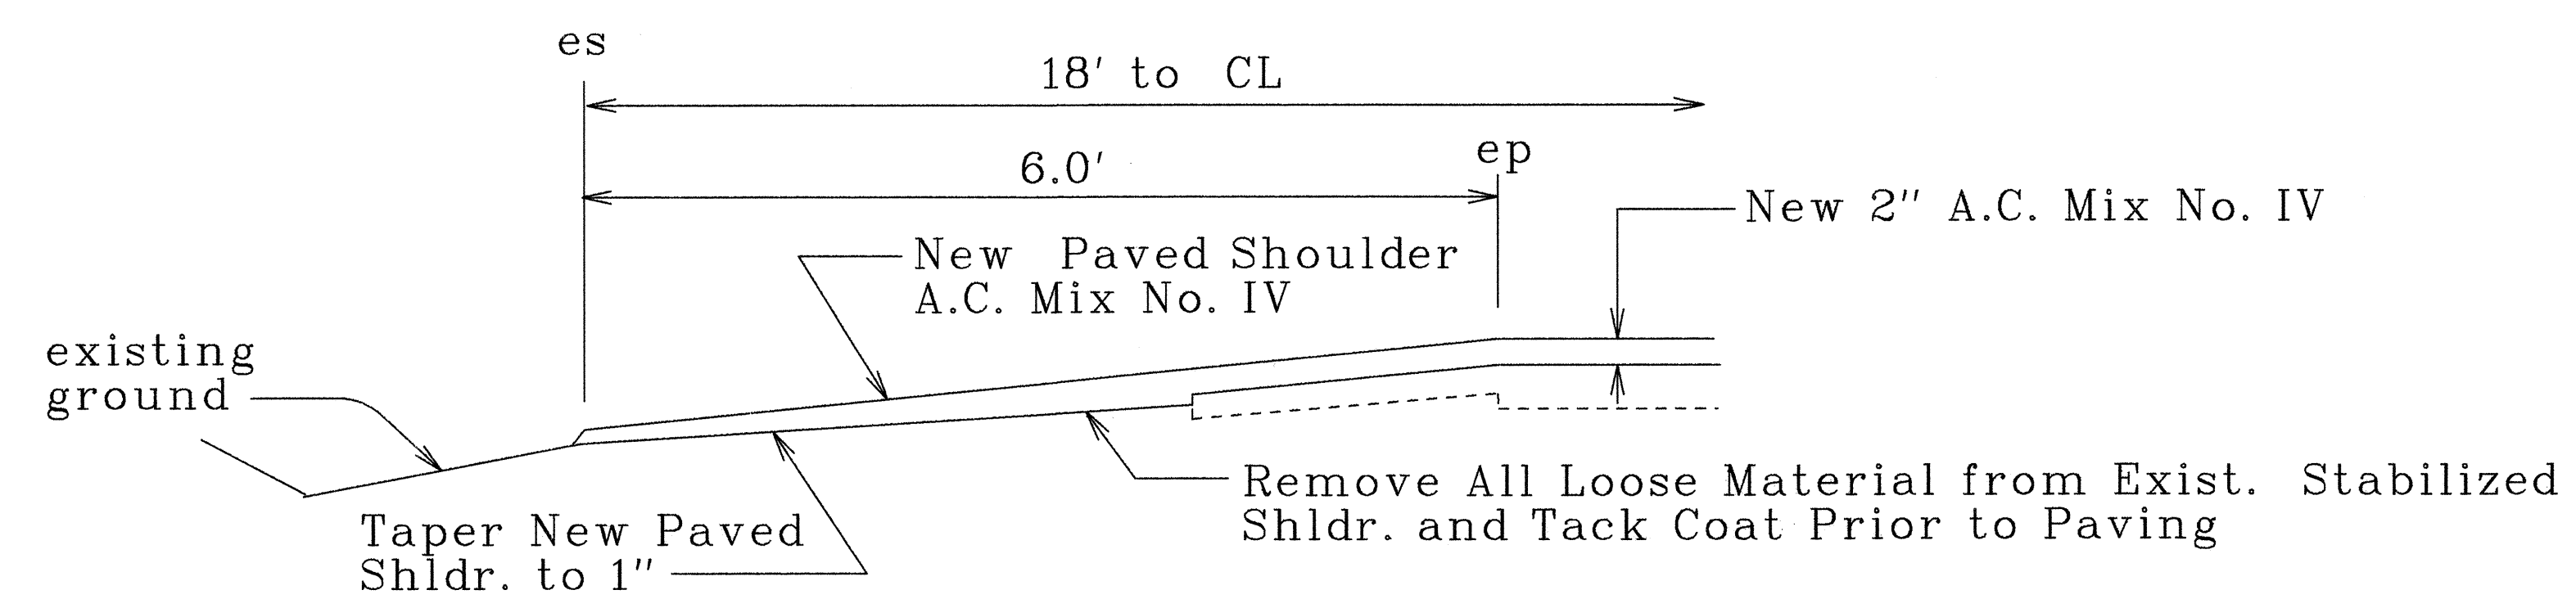

Shoulder Detail for Resurfacing Areas
Not to scale

REVISED SHOULDER DETAIL "B"

LEGEND FOR AS-BUILT POSTINGS	
	Squiggly line for as-built deletion
	Double line for as-built deletion
Roadway	Text for as-built posting

STATE OF HAWAII
DEPARTMENT OF TRANSPORTATION
HIGHWAYS DIVISION

TYPICAL SECTION
MAMALAHOA HIGHWAY RESURFACING
HAWAII VOLCANOES NATIONAL PARK
F.A. PROJECT NO. STP-011-2(28)
Scale: As Shown Date: Sept. 1993
SHEET No. 1 OF 1 SHEETS

SURVEY PLOTTED BY	DATE
DRAWN BY	
DESIGNED BY	
QUANTITIES BY	
CHECKED BY	
ORIGINAL PLAN	
NOTE BOOK	
003/ym	
06/08/93	