

INDEX TO DRAWINGS	
SHEET NO.	DESCRIPTION
1	TITLE SHEET
2	STANDARD PLANS SUMMARY
3-5	TYPICAL SECTION & GENERAL NOTES
6-11	PLAN & PROFILE
12-13	SUPERELEVATION DIAGRAM
14-15	PAVEMENT MARKING LEGEND & SUMMARY
16-22	CROSS SECTIONS

① C.O.IIS-1 AND ② C.O.22S-1 ARE SUPPLEMENT SHEETS TO THE CONTRACT PLANS.
NEW TOTAL = 24 SHEETS

STATE OF HAWAII

DEPARTMENT OF TRANSPORTATION

HIGHWAYS DIVISION

HONOLULU, HAWAII

"AS-BUILT"

PLANS FOR

MAMALAHOA HIGHWAY

HAWAII VOLCANOES NATIONAL PARK






M.P 35.9 TO M.P 37.1

F.A. PROJECT NO. FLH-OII-2(23)

DISTRICT OF KAU

ISLAND OF HAWAII

FED. ROAD DIST. NO.	STATE	FED. AID PROJ. NO.	FISCAL YEAR	SHEET NO.	TOTAL SHEETS
HAWAII	HAW.	FLH-OII-2(23)	1992	1	22

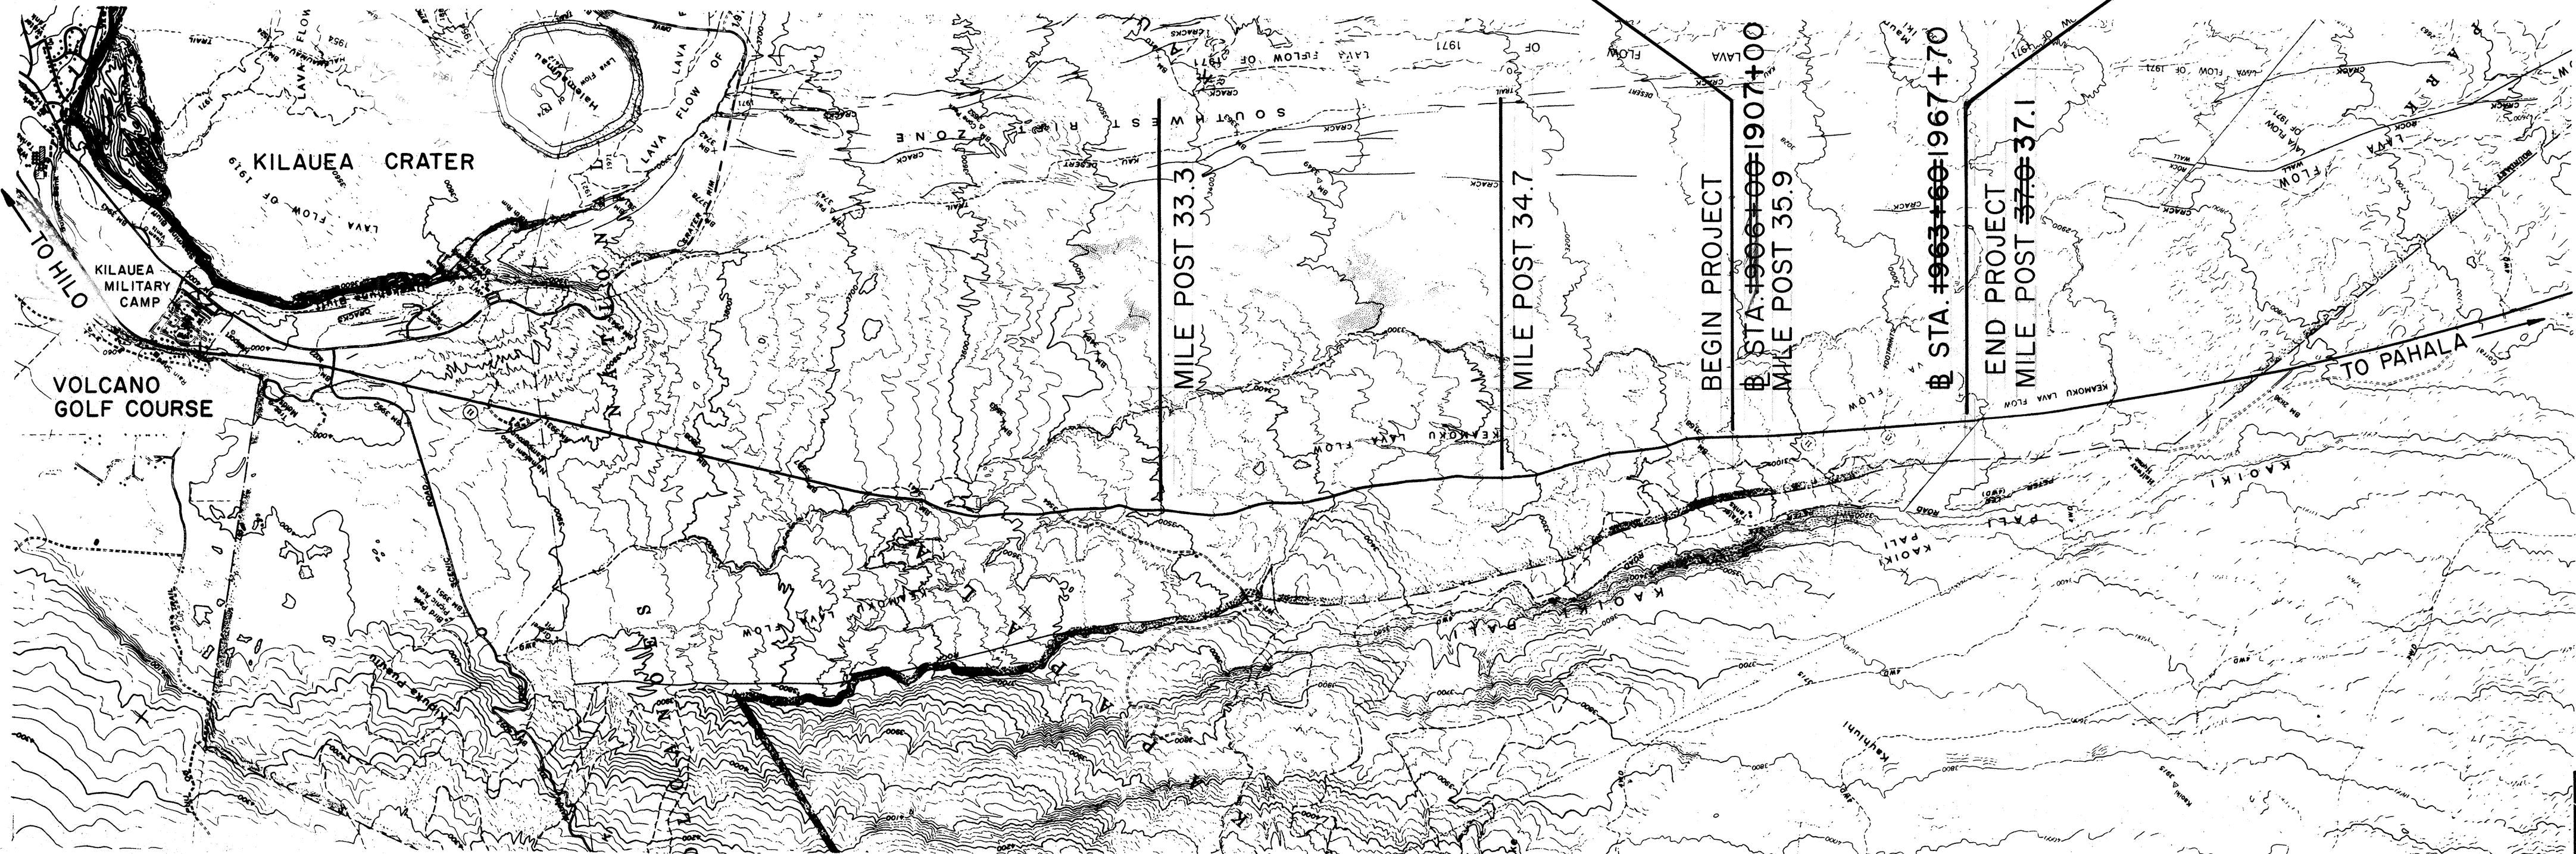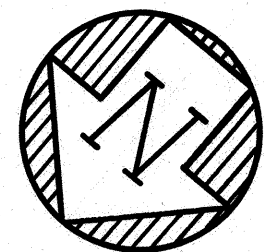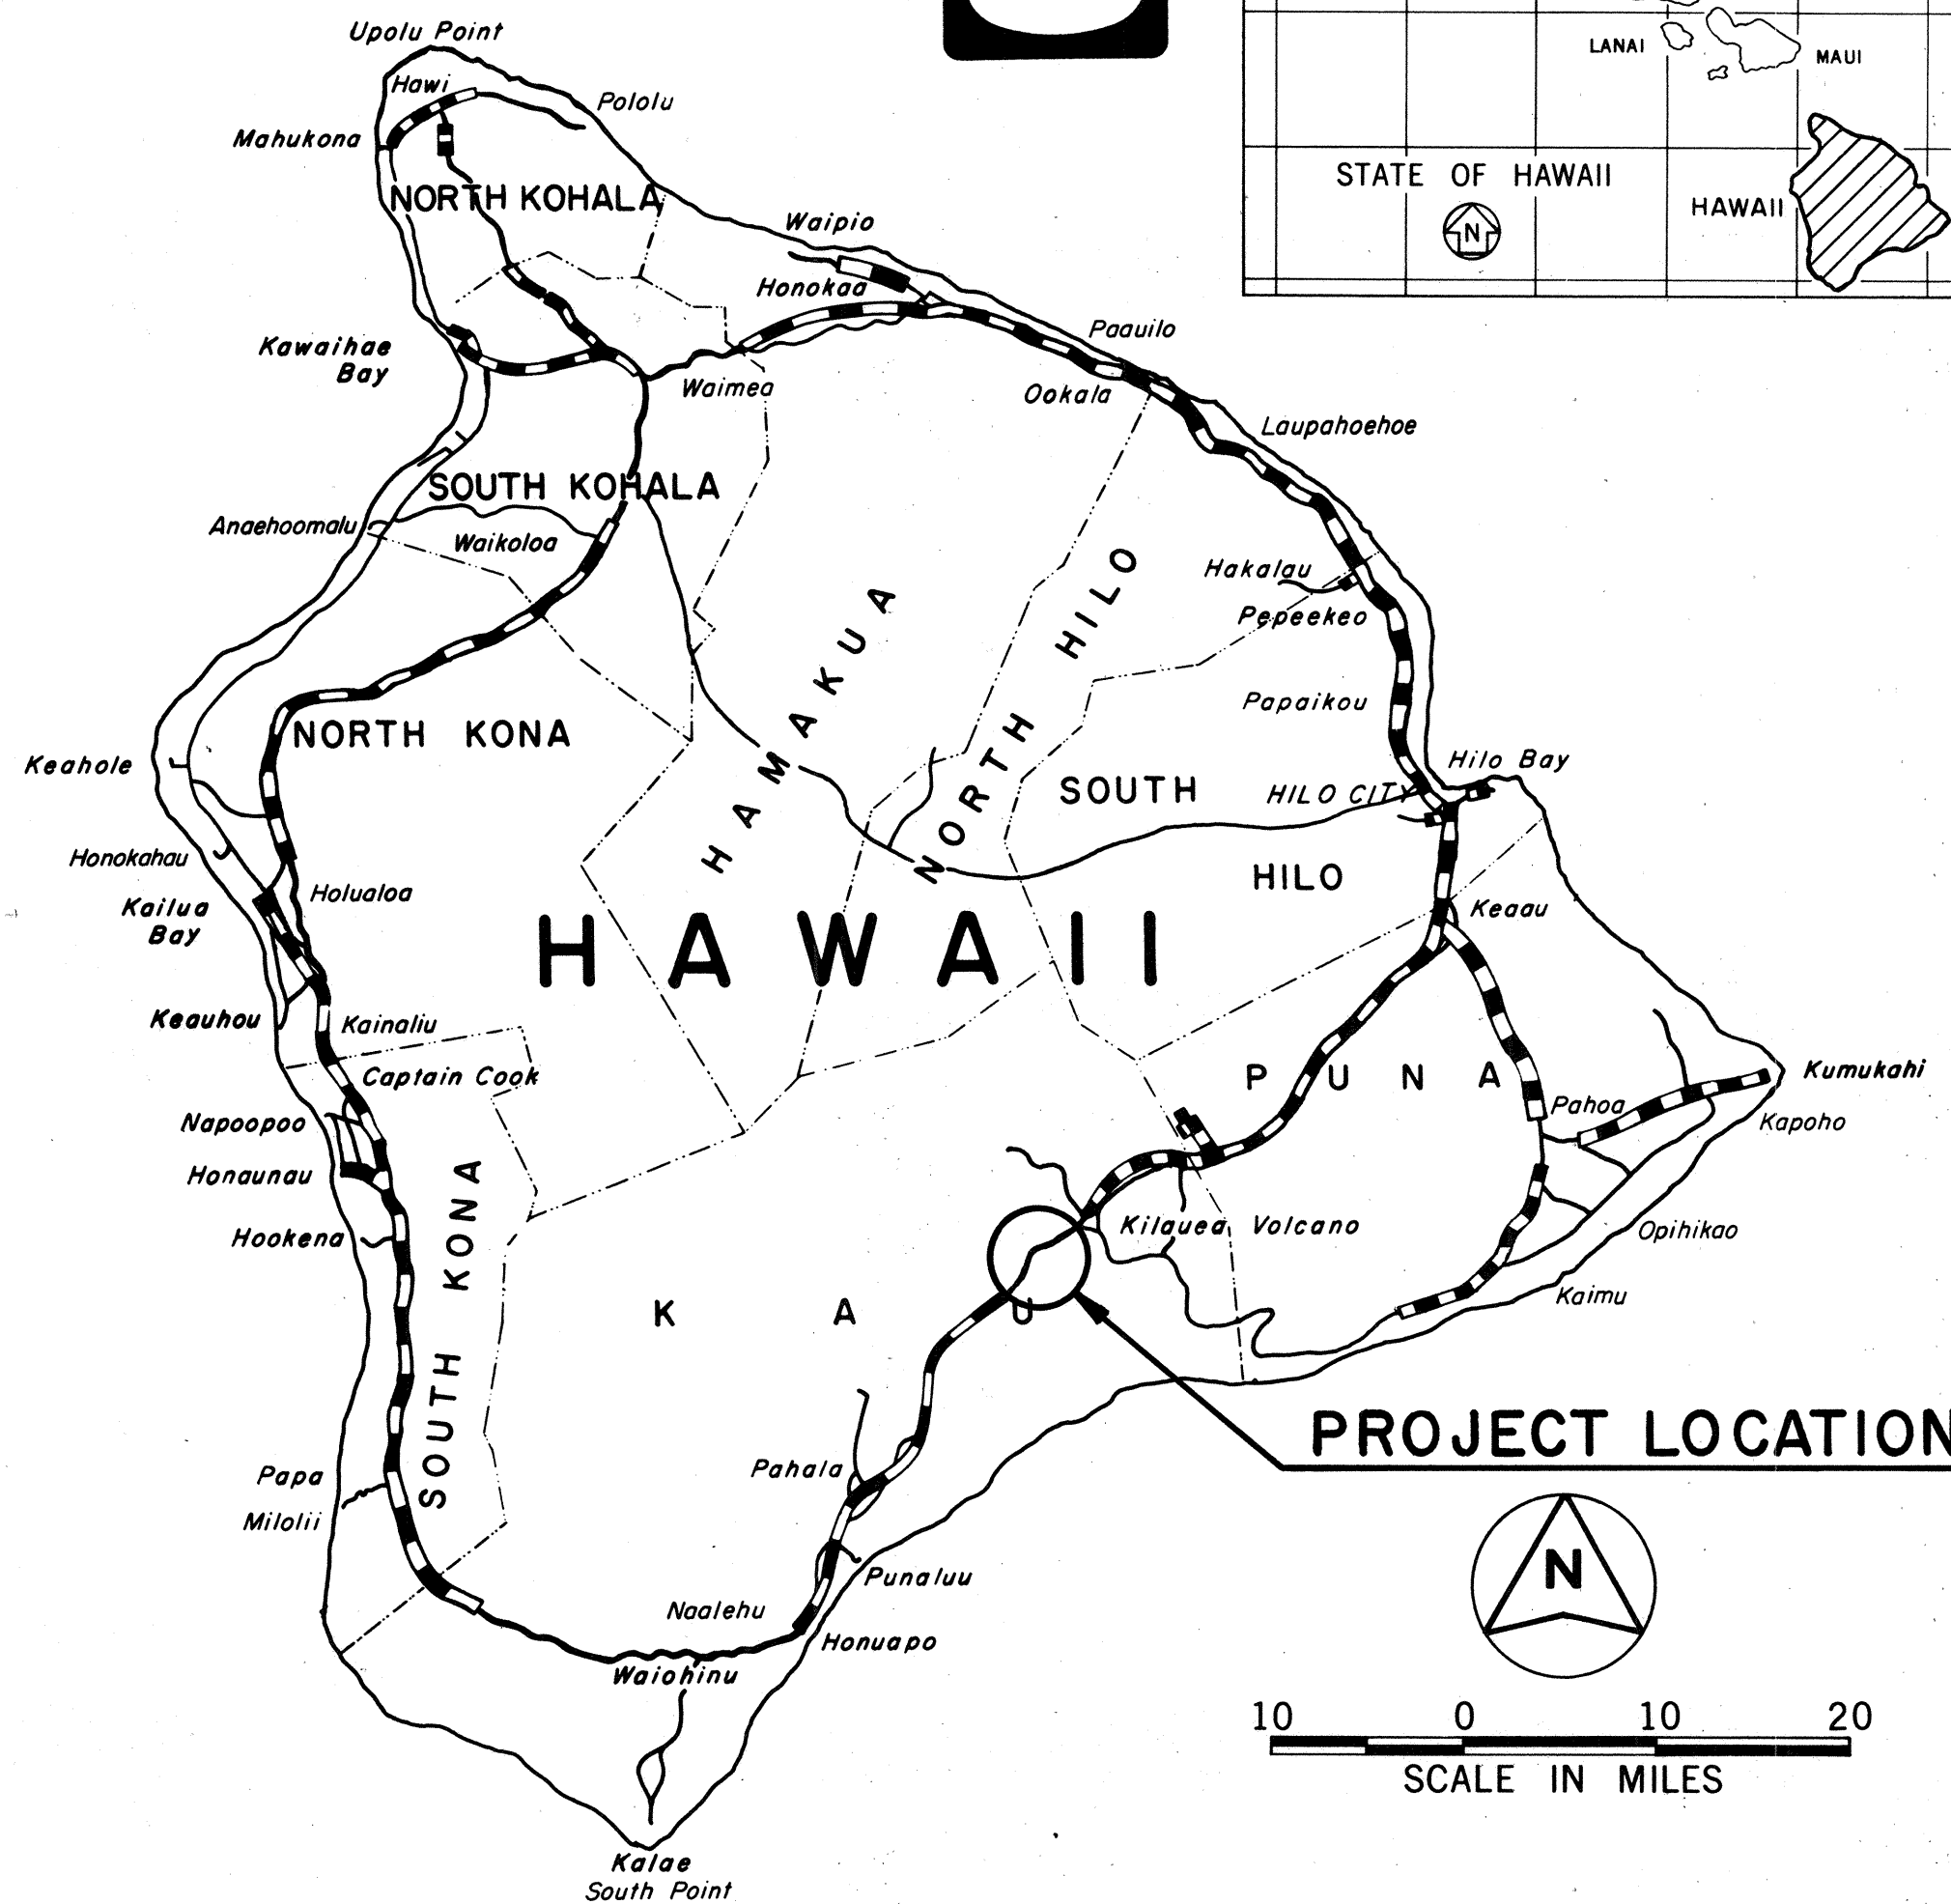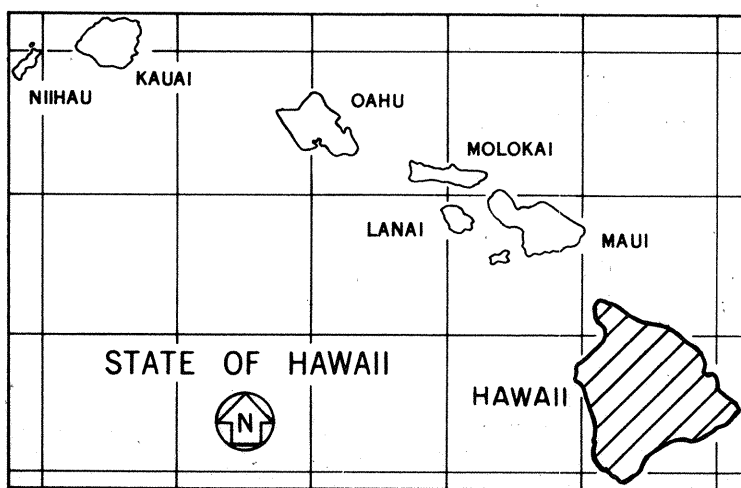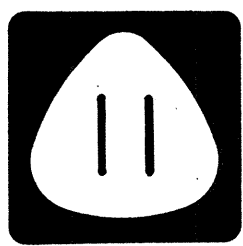

LOCATION PLAN

2.5 0 2.5 5 7.5
SCALE IN THOUSAND FEET

DESIGN CLASSIFICATION

ADT(1991) 1850
ADT(2011) 4100
DHV 400
D60/40
T 8.5%
K 10.0%
V 45 MPH

FEDERAL AID PROJECTS PREVIOUSLY CONSTRUCTED OR UNDER CONSTRUCTION
MILE POST 35.9 TO MILE POST 37.1

CHANGES MADE DURING CONSTRUCTION HAVE BEEN INCORPORATED ON THESE PLANS, EXCEPT CHANGES IN THE ORIGINAL THEORETICAL QUANTITIES. FOR ACTUAL QUANTITIES, REFER TO PROJECT LEDGER AND/OR COMPUTATION BOOK.

Roy Shioji 12/15/95
RESIDENT ENGINEER DATE

DEPARTMENT OF TRANSPORTATION
FEDERAL HIGHWAY ADMINISTRATION
APPROVED:
William Arthur 10/15/91
DIVISION ADMINISTRATOR DATE

DEPARTMENT OF TRANSPORTATION
STATE OF HAWAII
APPROVED:
Edward J. Brown 10/13/91
DIR. OF TRANSPORTATION DATE