


FED. ROAD DIST. NO.	STATE	PROJ. NO.	FISCAL YEAR	SHEET NO.	TOTAL SHEETS
HAWAII	HAW.	11G-01-91M	1991	15	24

ORIGINAL PLAN	SURVEY PLOTTED BY	DATE
NOTED	DRAWN BY	
NOTES	TRACED BY	
QUANTITIES	CHECKED BY	
NO.		

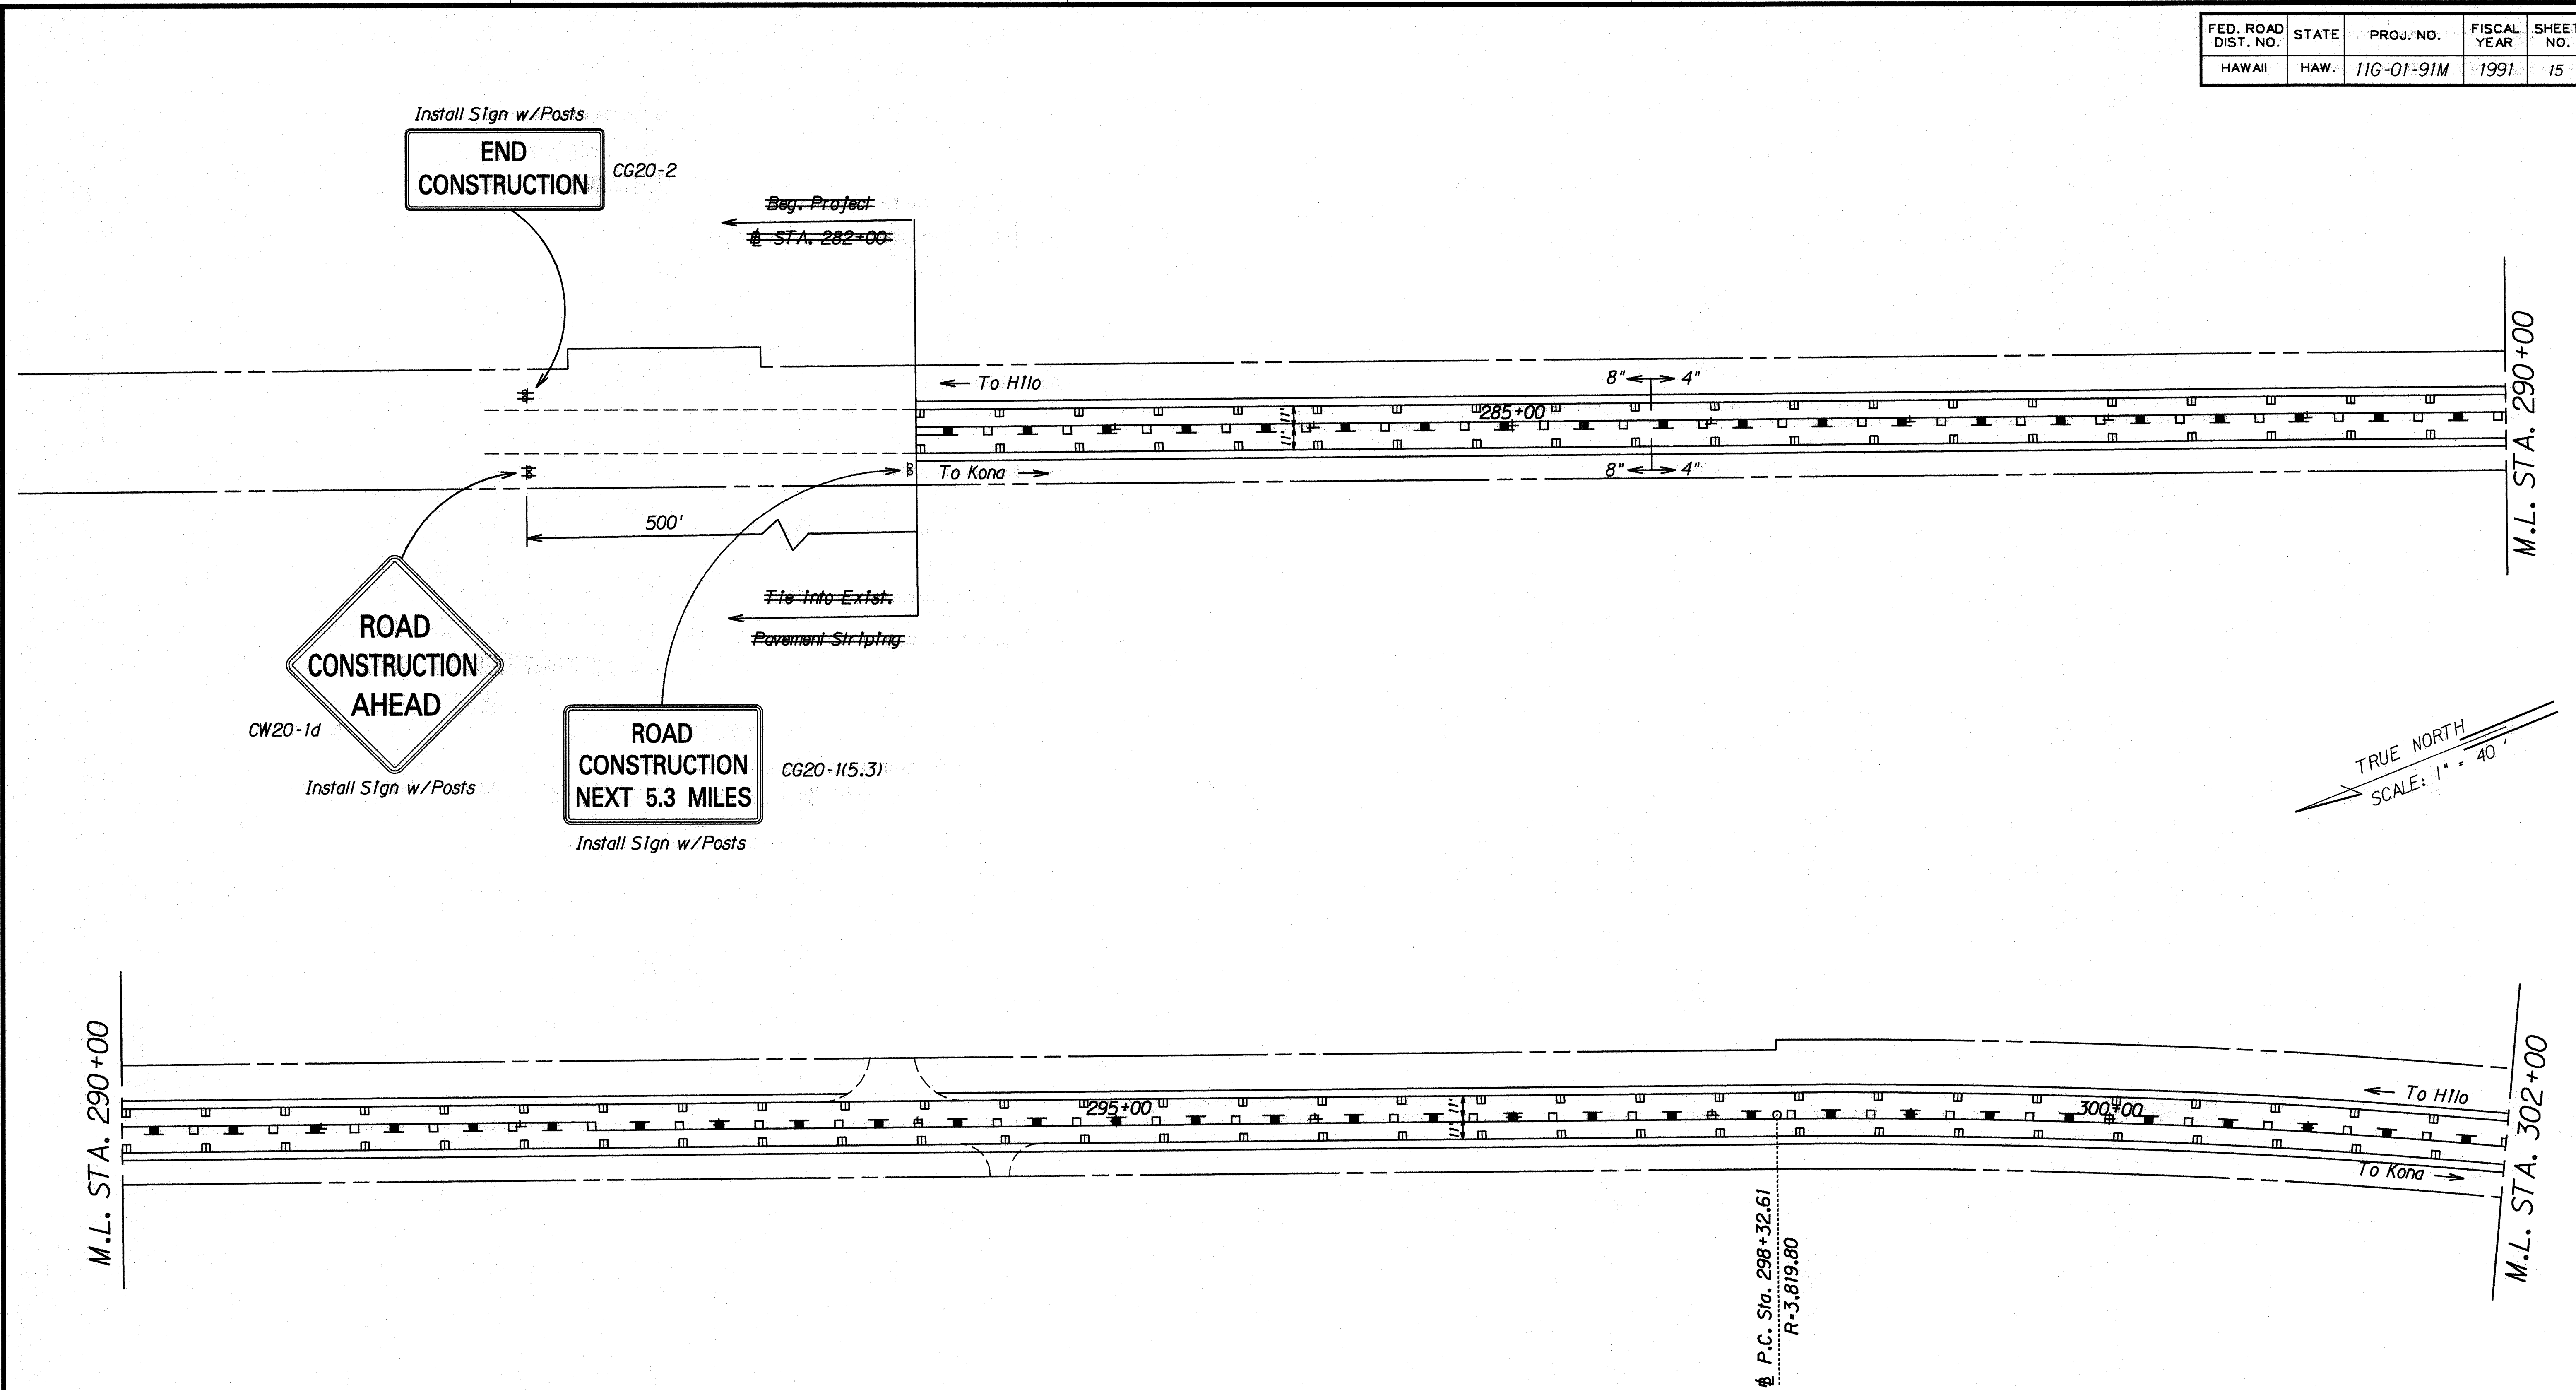


LEGEND FOR AS-BUILT POSTINGS	
	Squiggly line for as-built deletion
	Double line for as-built deletion
Roadway	Text for as-built posting

STATE OF HAWAII  
DEPARTMENT OF TRANSPORTATION  
HIGHWAYS DIVISION

**PAVEMENT MARKING & STRIPING PLAN**  
HAWAII BELT RD. RESURFACING  
Pahala to Nihale  
PROJECT NO. 11G-01-91M

Scale: 1" = 40'  
Date: Jan., 1991  
SHEET No. T2 OF 11 SHEETS

FED. ROAD DIST. NO.	STATE	PROJ. NO.	FISCAL YEAR	SHEET NO.	TOTAL SHEETS
HAWAII	HAW.	11G-01-91M	1991	16	24

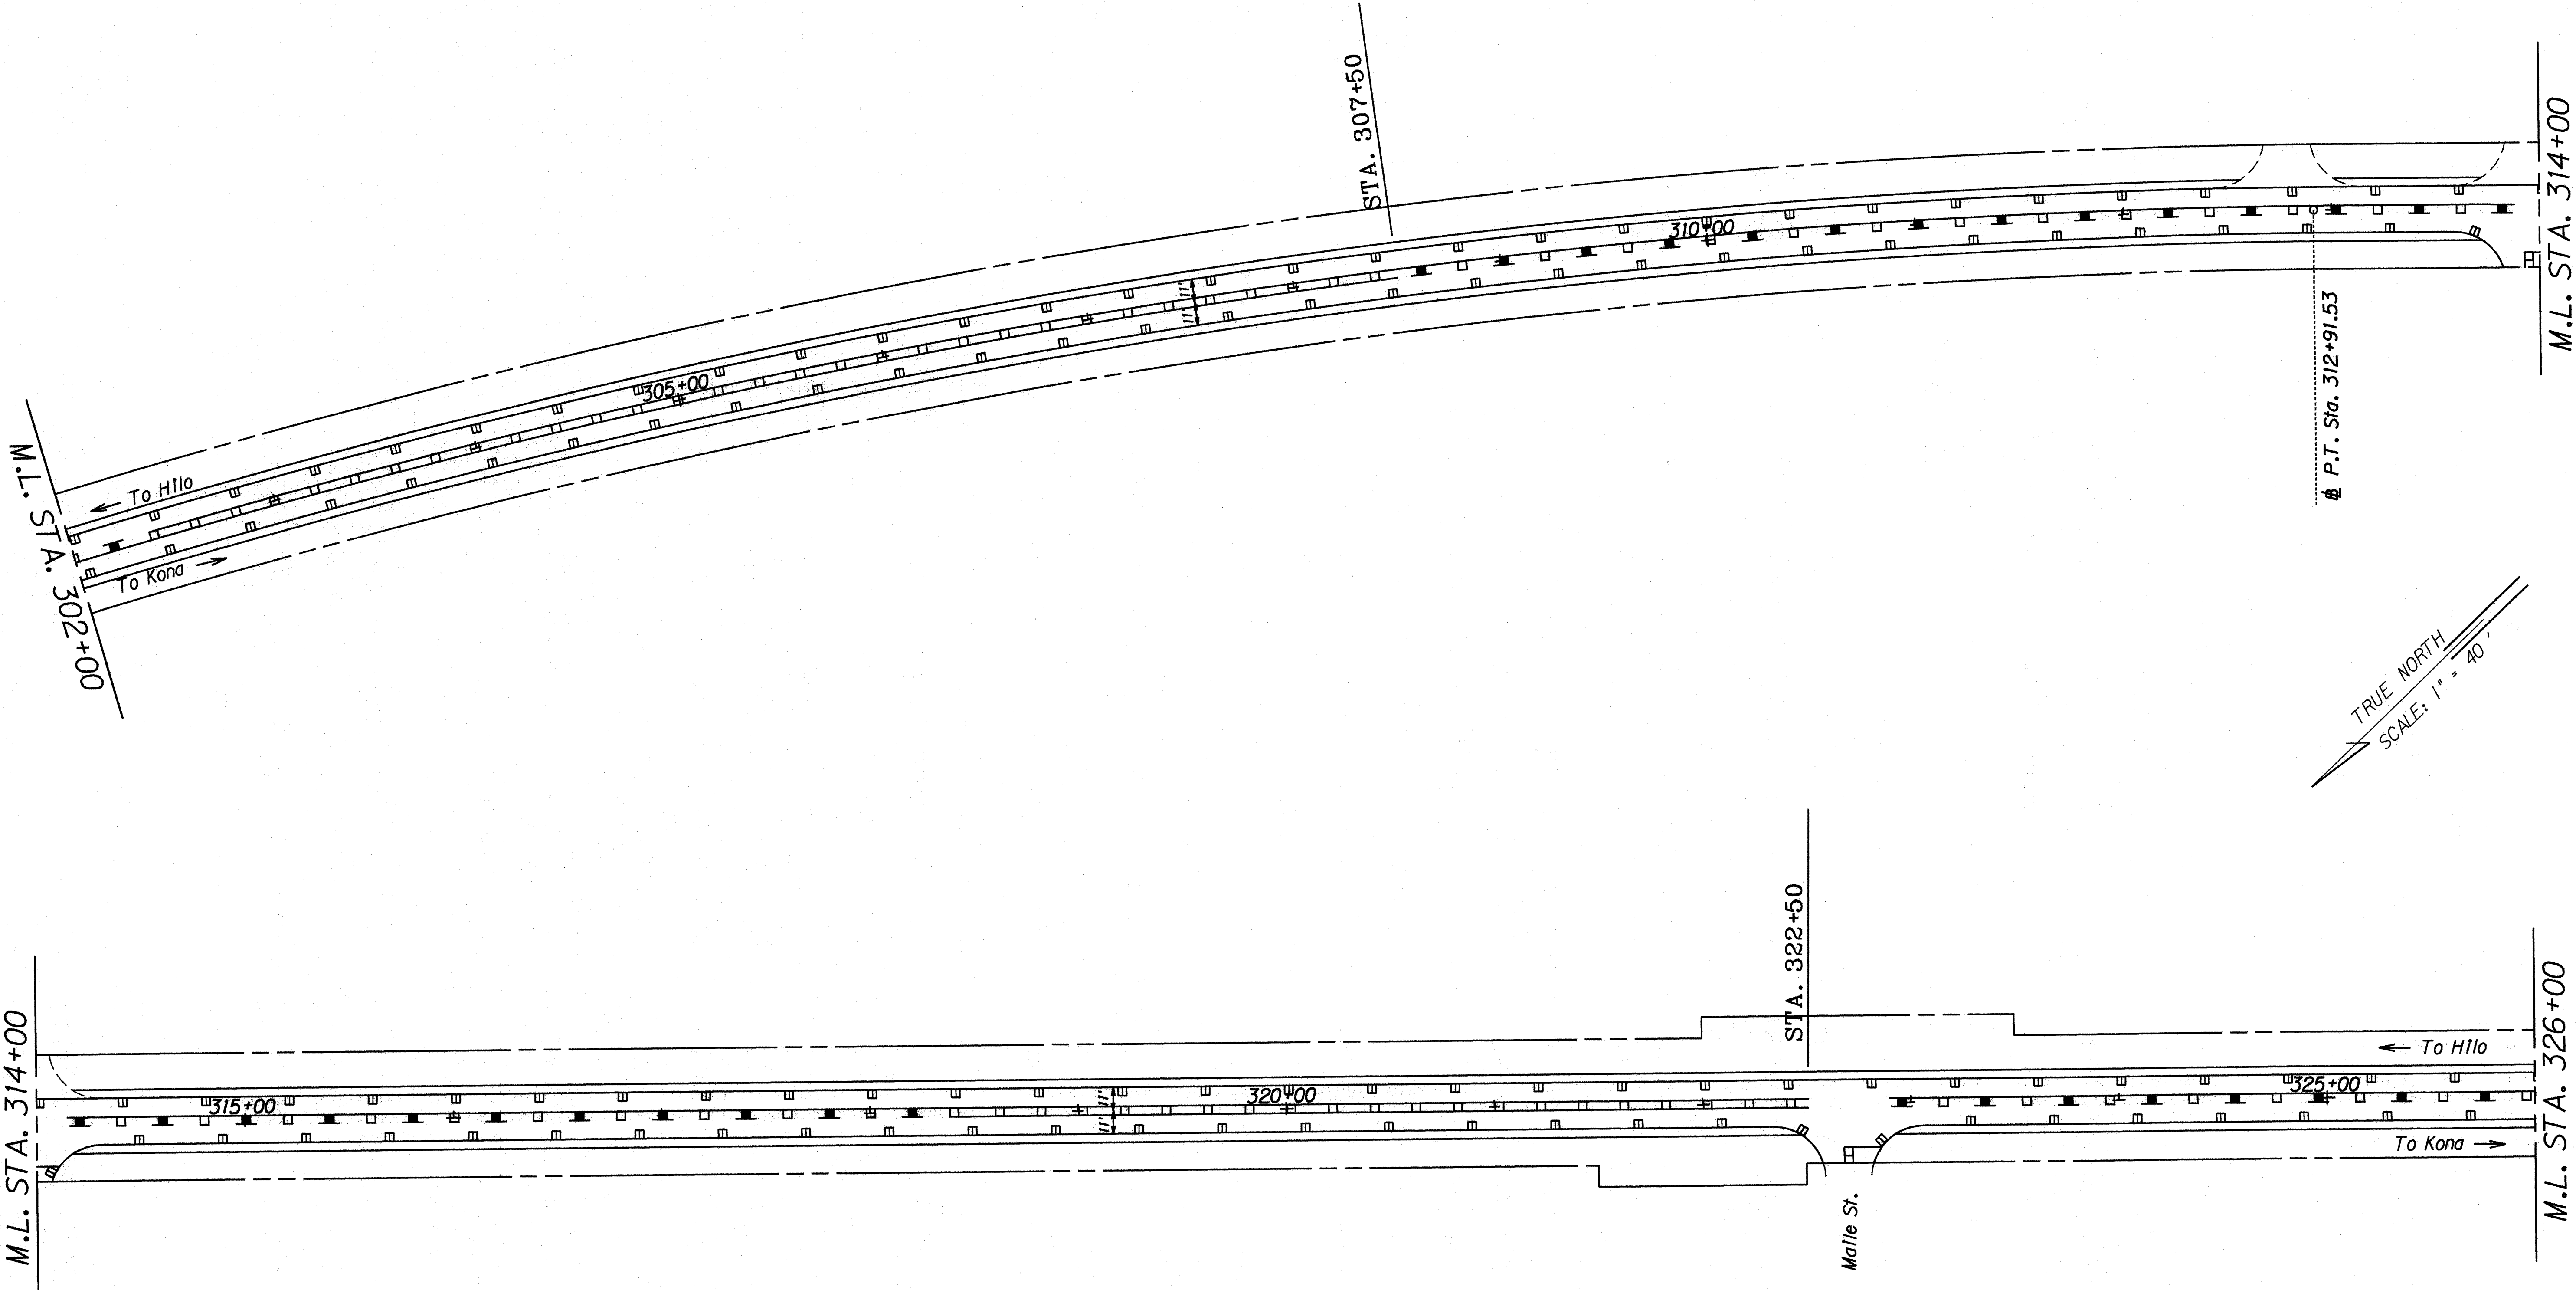

TRUE NORTH  
SCALE: 1" = 40'

ORIGINAL PLAN	SURVEY PLOTTED BY	DATE
NOTE BOOK	DRAWN BY	
	DESIGNED BY	
	QUANTITIES BY	
	CHECKED BY	


LEGEND FOR AS-BUILT POSTINGS	
	Squiggly line for as-built deletion
	Double line for as-built deletion
Roadway	Text for as-built posting

STATE OF HAWAII  
DEPARTMENT OF TRANSPORTATION  
HIGHWAYS DIVISION

PAVEMENT MARKING &  
STRIPING PLAN  
HAWAII BELT RD. RESURFACING  
Pahala to Nihale  
PROJECT NO. 11G-01-91M  
Scale: 1"=40'

Date: Jan., 1991  
SHEET No. T3 OF 11 SHEETS

FED. ROAD DIST. NO.	STATE	PROJ. NO.	FISCAL YEAR	SHEET NO.	TOTAL SHEETS
HAWAII	HAW.	11G-01-91M	1991	17	24

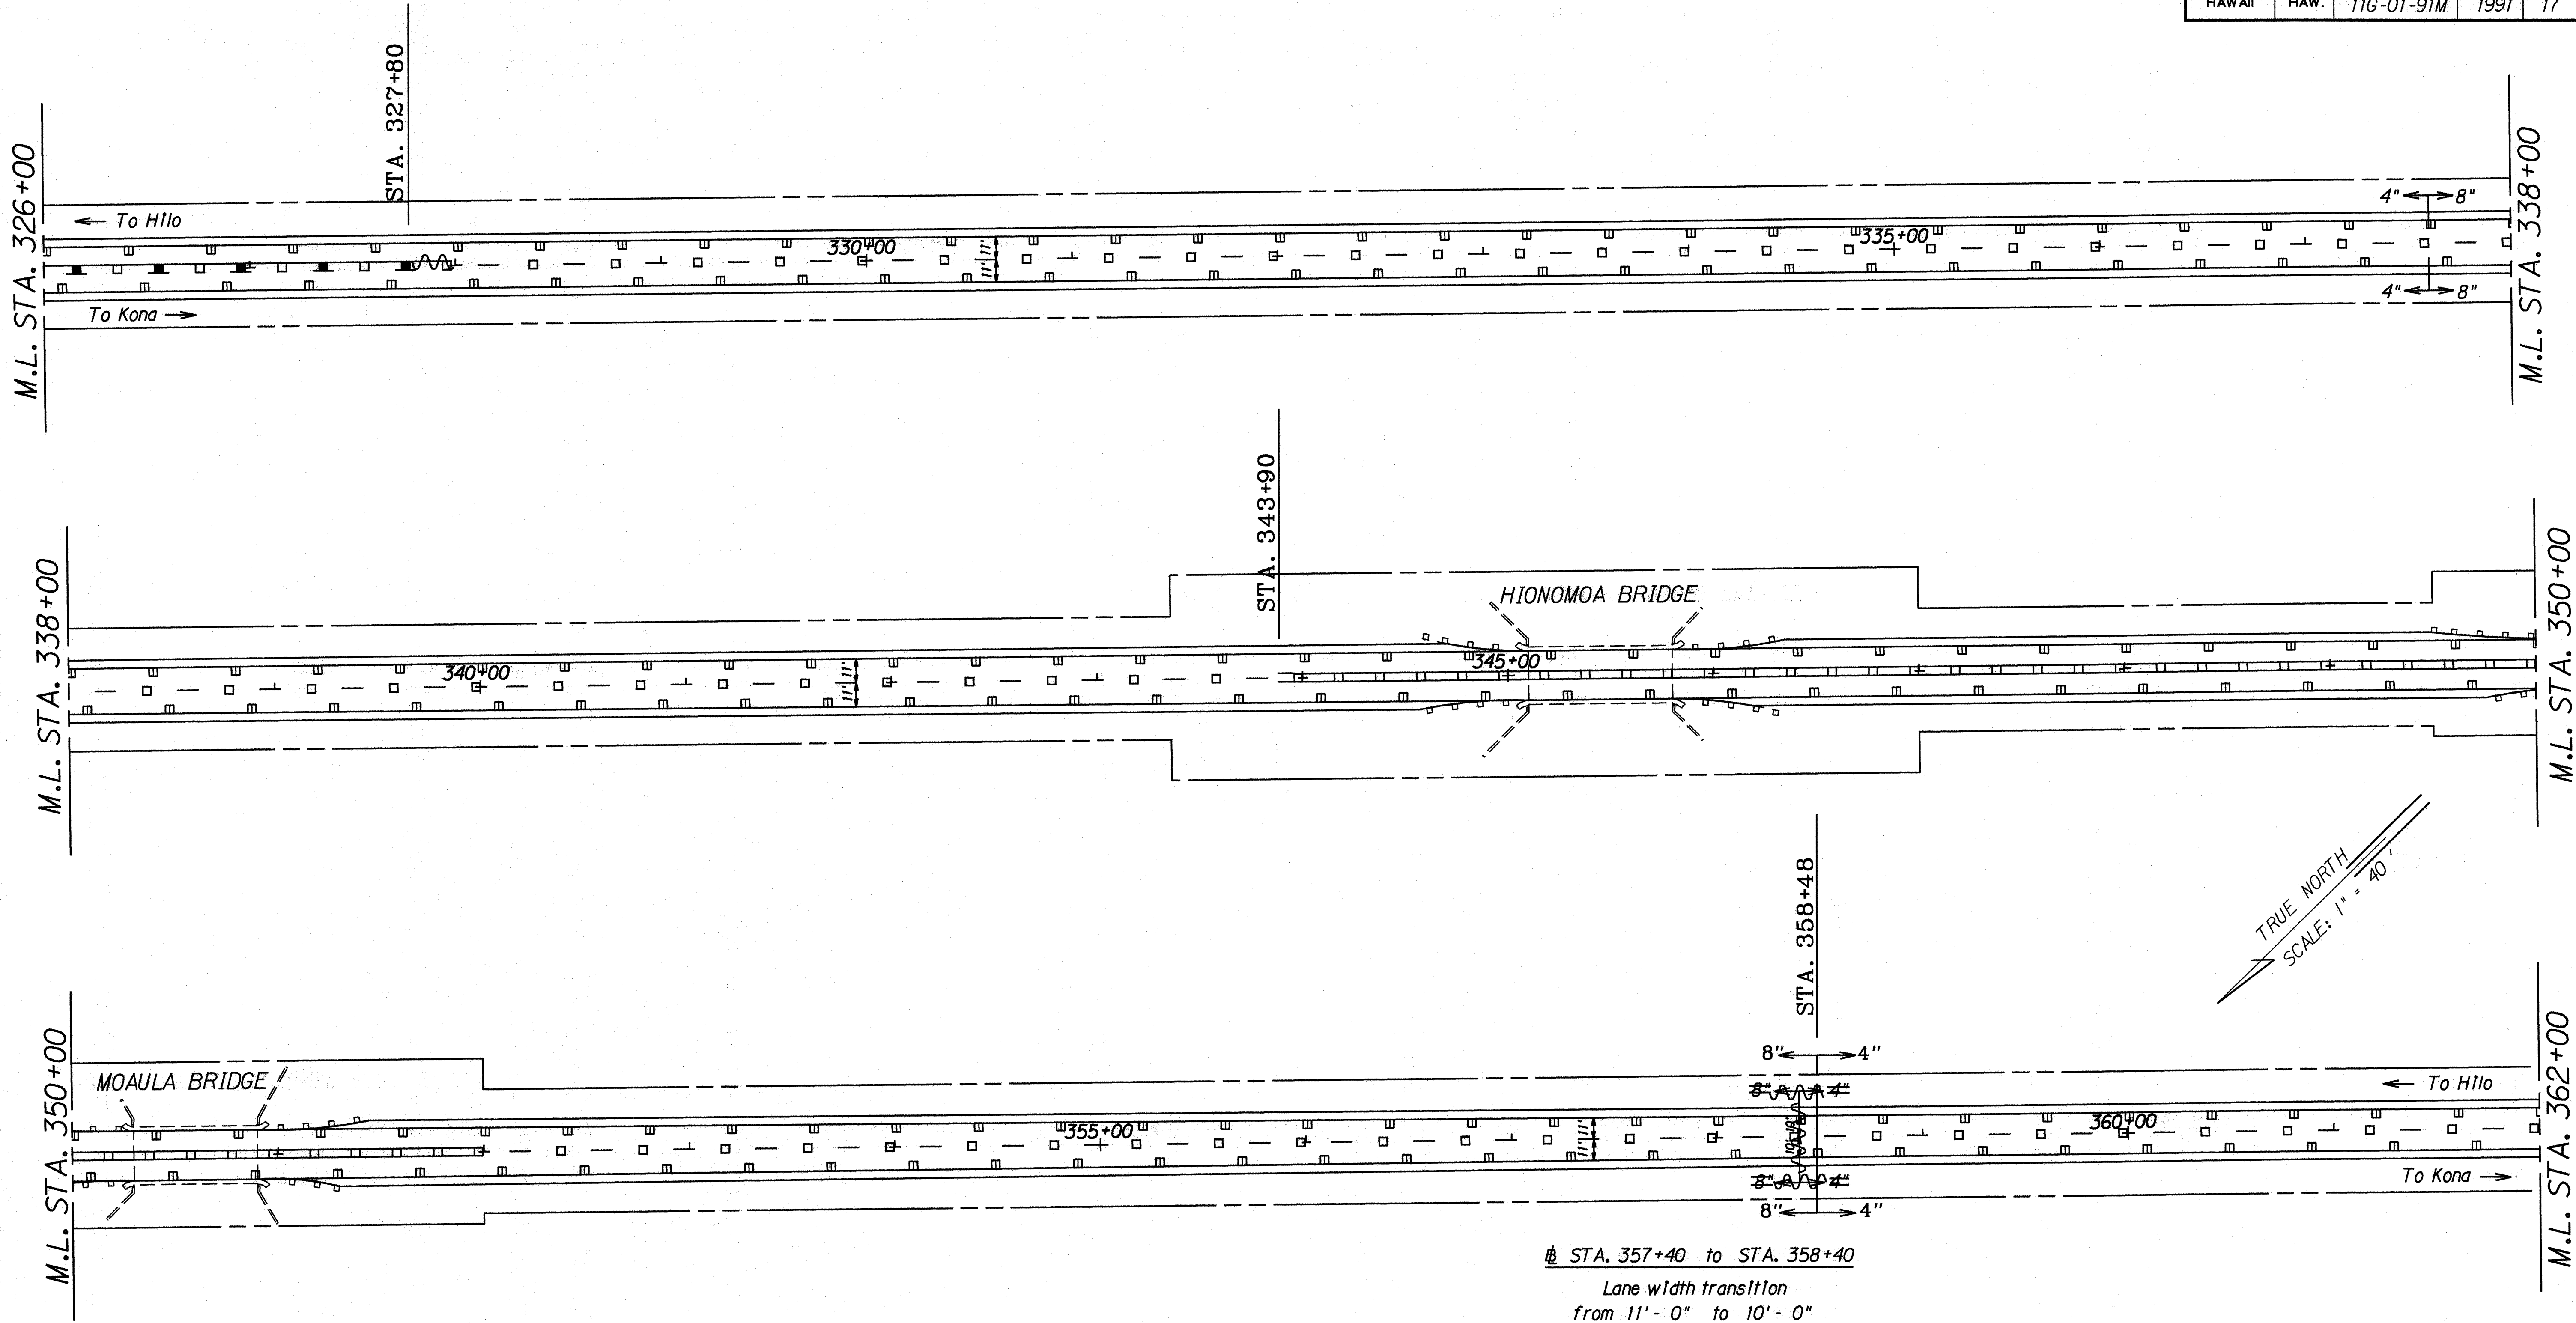

TRUE NORTH  
SCALE: 1" = 40'

SURVEY PLOTTED BY	DATE
DRAWN BY	
DESIGNED BY	
QUANTITIES BY	
CHECKED BY	
ORIGINAL PLAN	
NOTE BOOK	
No.	

LEGEND FOR AS-BUILT POSTINGS	
	Squiggly line for as-built deletion
	Double line for as-built deletion
Roadway	Text for as-built posting

STATE OF HAWAII  
DEPARTMENT OF TRANSPORTATION  
HIGHWAYS DIVISION

**PAVEMENT MARKING & STRIPING PLAN**


HAWAII BELT RD. RESURFACING  
Pahala to Niihale  
PROJECT NO. 11G-01-91M

Scale: 1" = 40' Date: Jan., 1991

SHEET No. 14 OF 11 SHEETS



FED. ROAD DIST. NO.	STATE	PROJ. NO.	FISCAL YEAR	SHEET NO.	TOTAL SHEETS
HAWAII	HAW.	11G-01-91M	1991	18	24

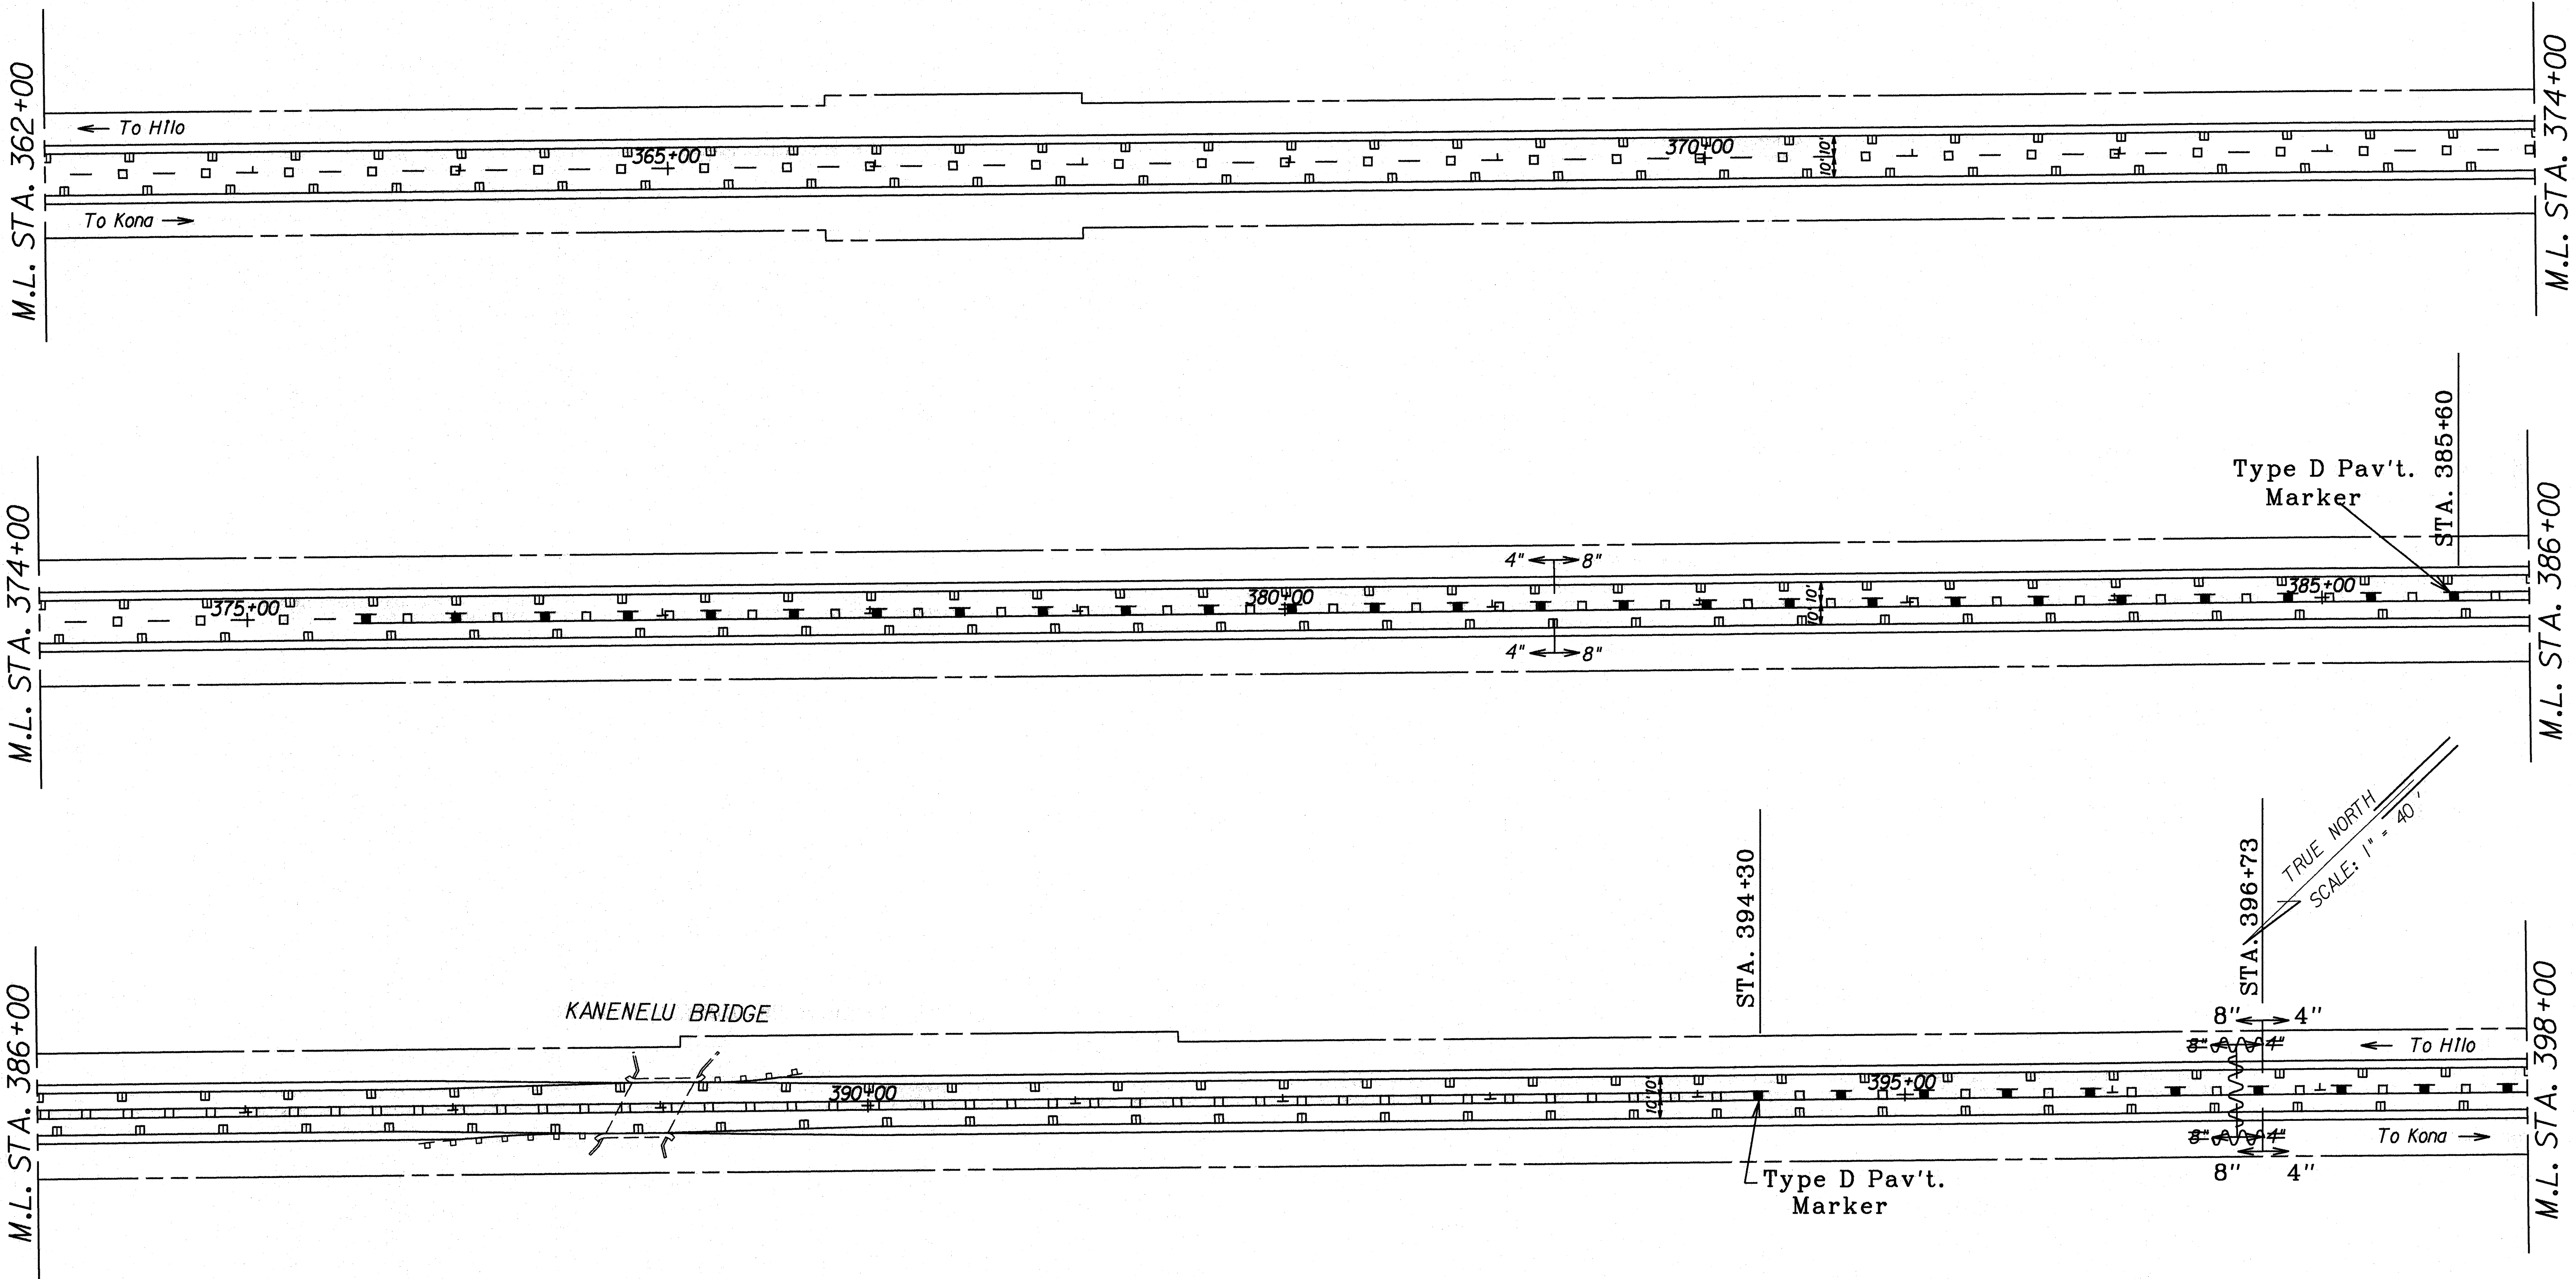

ORIGINAL PLAN	SURVEY PLOTTED BY	DATE
NOTE BOOK	DRAWN BY	
	DESIGNED BY	
	QUANTITIES BY	
	CHECKED BY	

LEGEND FOR AS-BUILT POSTINGS	
	Squiggly line for as-built deletion
	Double line for as-built deletion
Roadway	Text for as-built posting

STATE OF HAWAII  
DEPARTMENT OF TRANSPORTATION  
HIGHWAYS DIVISION

**PAVEMENT MARKING & STRIPING PLAN**


HAWAII BELT RD. RESURFACING  
Pahala to Ninole  
PROJECT NO. 11G-01-91M

Scale: 1"=40'      Date: Jan., 1991

SHEET No. T5 OF 11 SHEETS

ORIGINAL PLAN	SURVEY PLOTTED BY	DATE
NOTE BOOK	DRAWN BY	
QUANTITIES BY	DESIGNED BY	
CHECKED BY		

FED. ROAD DIST. NO.	STATE	PROJ. NO.	FISCAL YEAR	SHEET NO.	TOTAL SHEETS
HAWAII	HAW.	11G-01-91M	1991	19	24

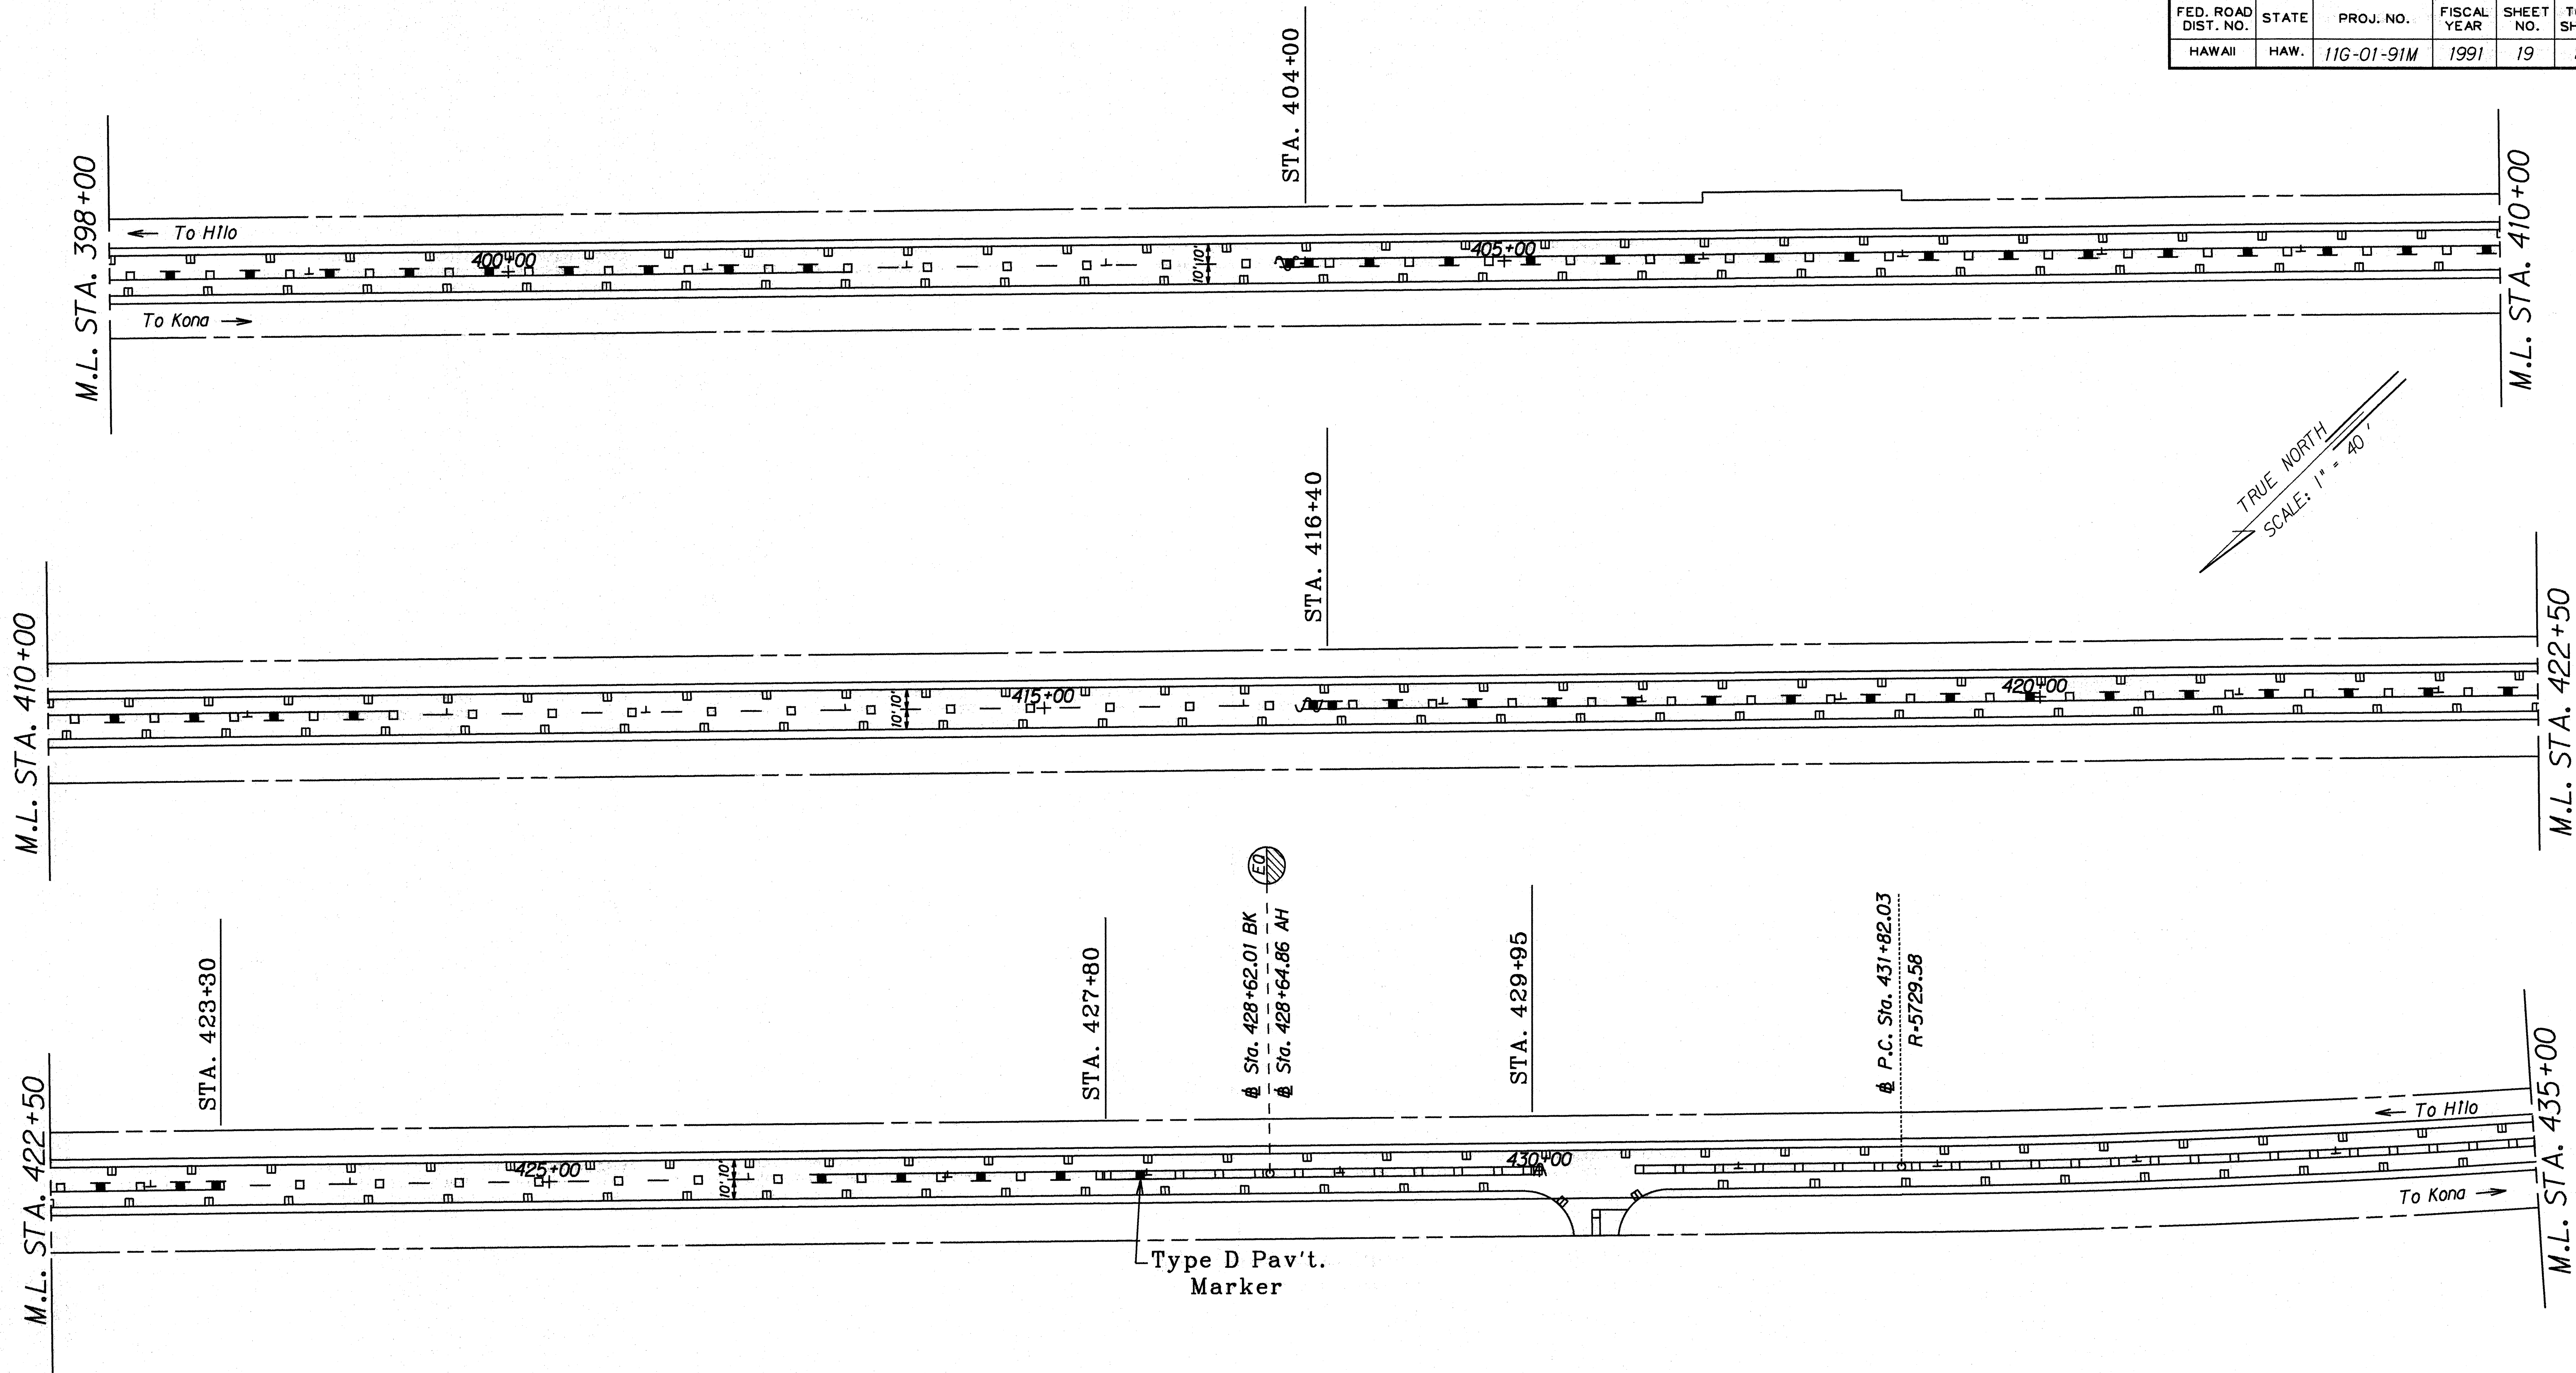

TRUE NORTH  
SCALE: 1" = 40'

LEGEND FOR AS-BUILT POSTINGS	
	Squiggly line for as-built deletion
	Double line for as-built deletion
Roadway	Text for as-built posting

STATE OF HAWAII  
DEPARTMENT OF TRANSPORTATION  
HIGHWAYS DIVISION

**PAVEMENT MARKING &  
STRIPING PLAN**


HAWAII BELT RD. RESURFACING  
Pahala to Nihole  
PROJECT NO. 11G-01-91M

Scale: 1" = 40' Date: Jan., 1991

SHEET No. T6 OF 11 SHEETS



FED. ROAD DIST. NO.	STATE	PROJ. NO.	FISCAL YEAR	SHEET NO.	TOTAL SHEETS
HAWAII	HAW.	11G-01-91M	1991	20	24

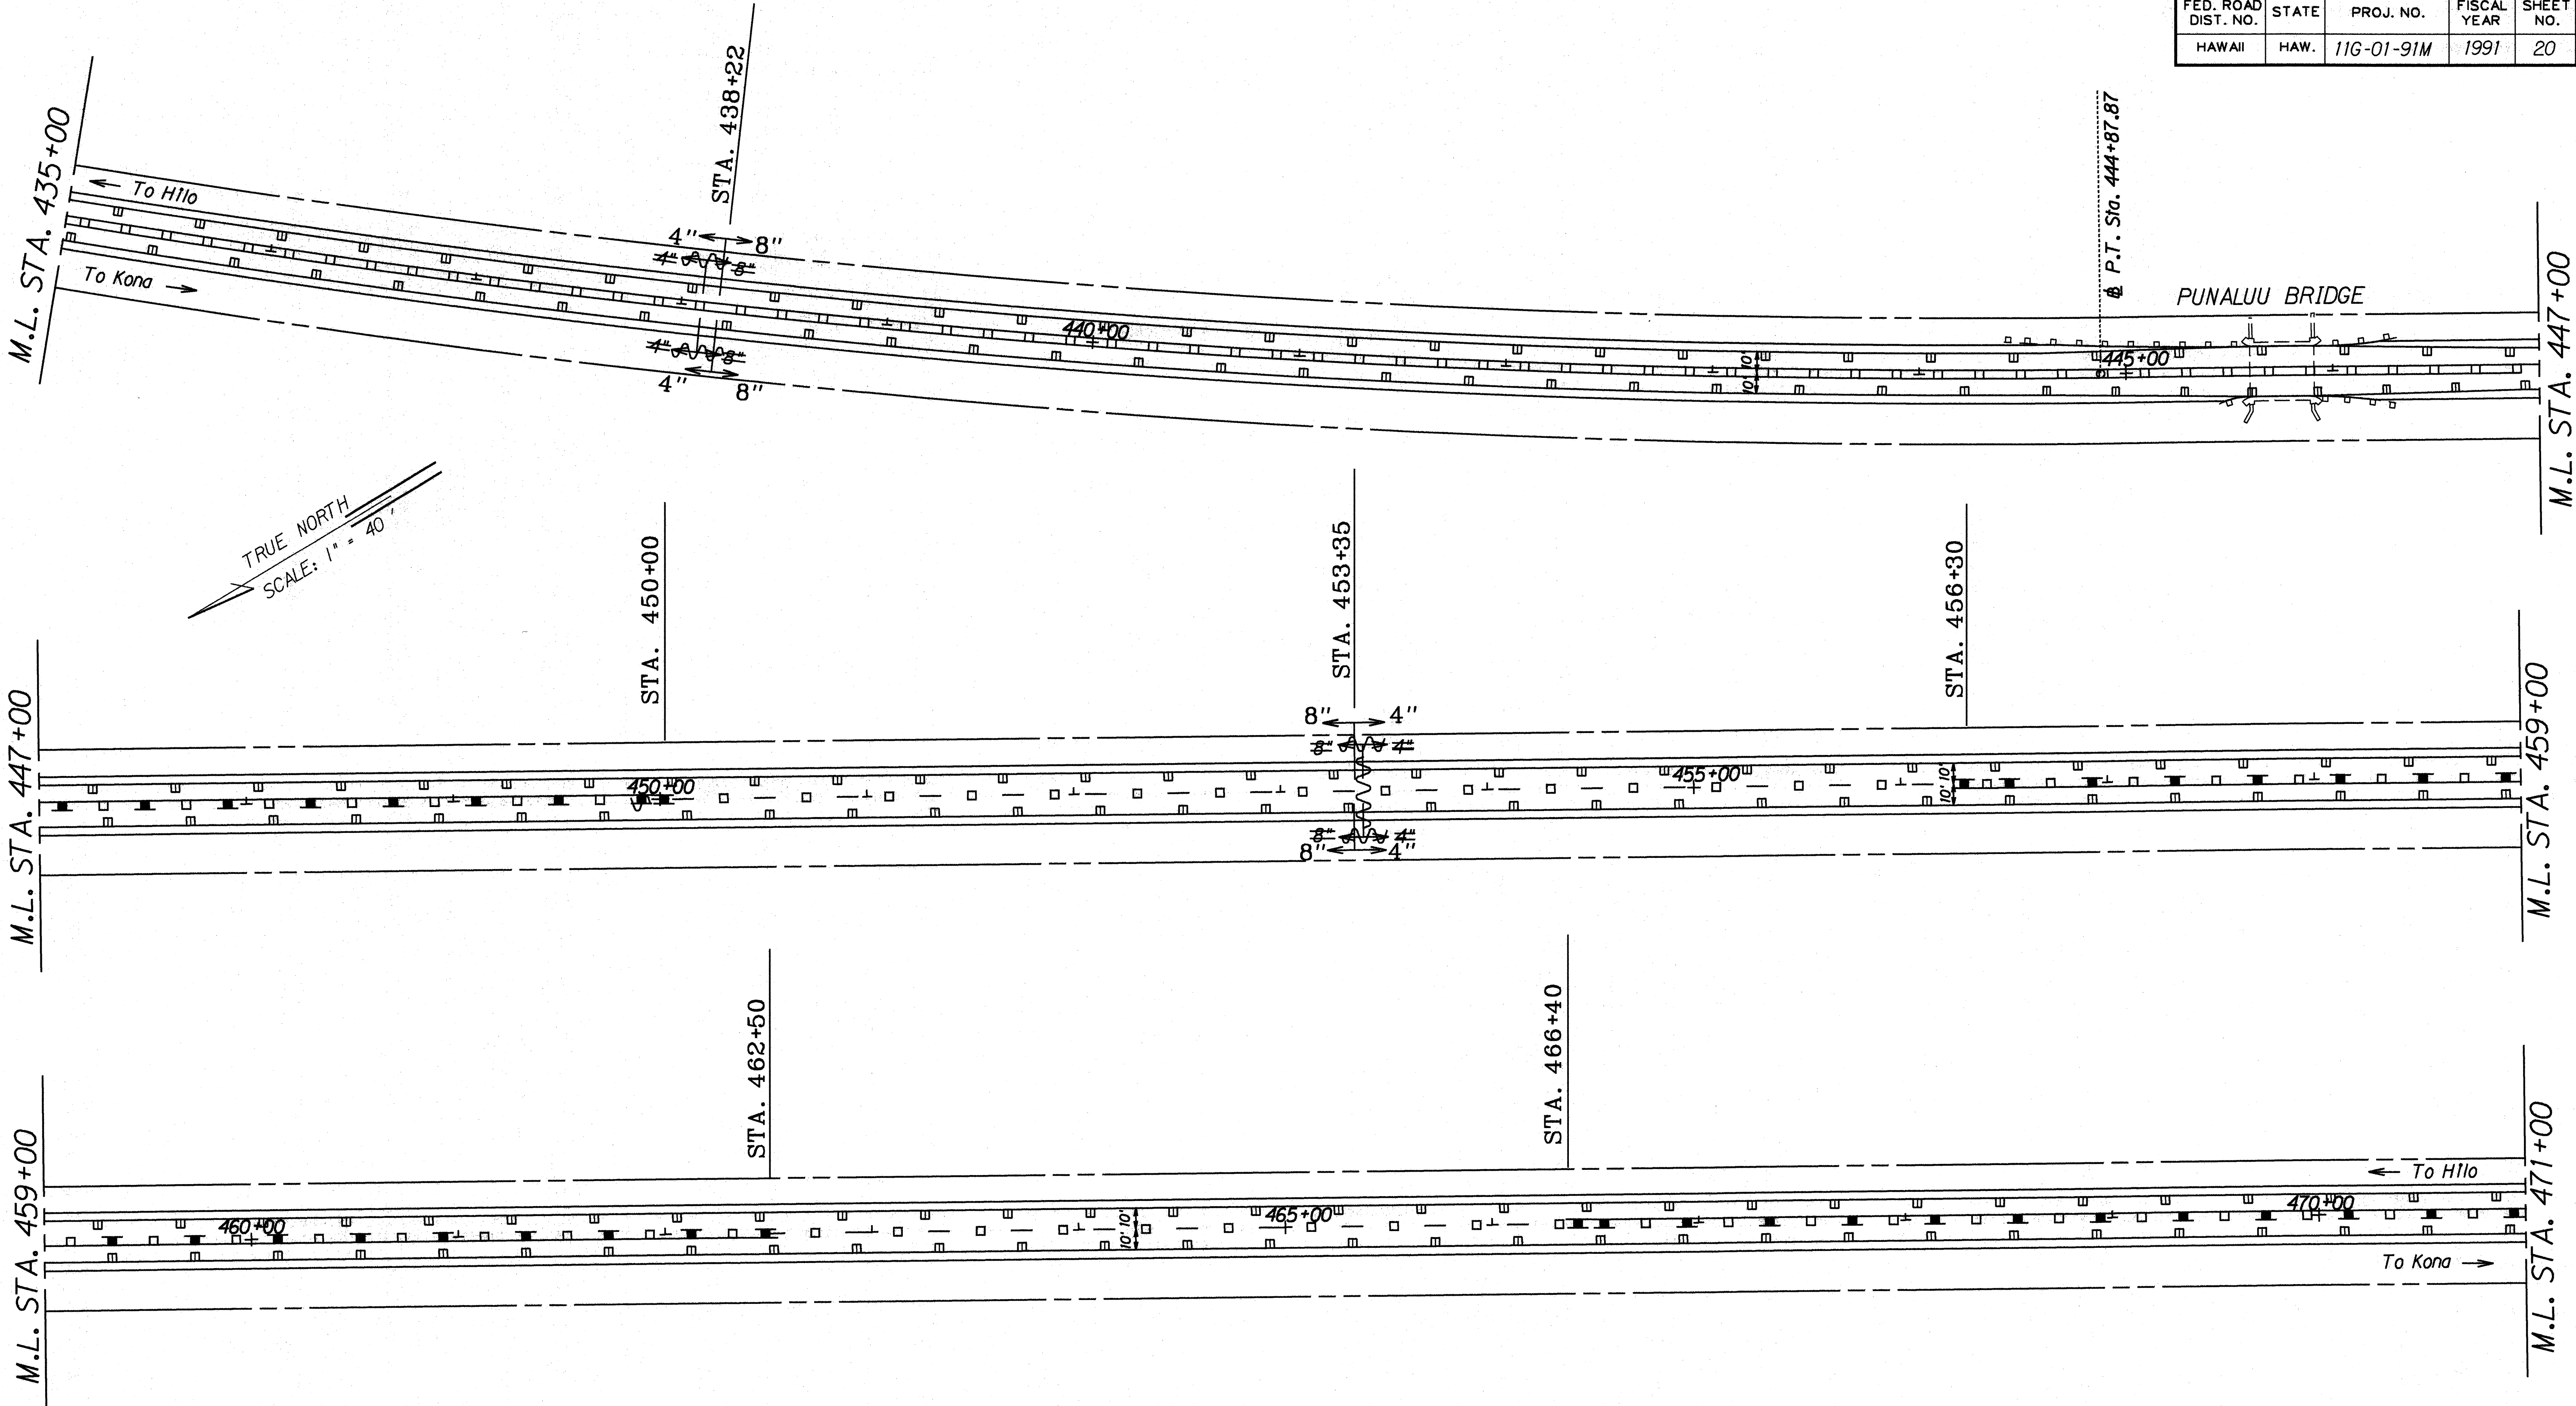


ORIGINAL PLAN	SURVEY PLOTTED BY	DATE
NOTE BOOK	DRAWN BY	
	DESIGNED BY	
	QUANTITIES BY	
	CHECKED BY	

LEGEND FOR AS-BUILT POSTINGS	
	Squiggly line for as-built deletion
	Double line for as-built deletion
Roadway	Text for as-built posting

STATE OF HAWAII  
DEPARTMENT OF TRANSPORTATION  
HIGHWAYS DIVISION  
**PAVEMENT MARKING & STRIPING PLAN**  
HAWAII BELT RD. RESURFACING  
Pahala to Ninole  
PROJECT NO. 11G-01-91M  
Scale: 1" = 40' Date: Jan., 1991  
SHEET No. T7 OF 11 SHEETS

FED. ROAD DIST. NO.	STATE	PROJ. NO.	FISCAL YEAR	SHEET NO.	TOTAL SHEETS
HAWAII	HAW.	11G-01-91M	1991	21	24

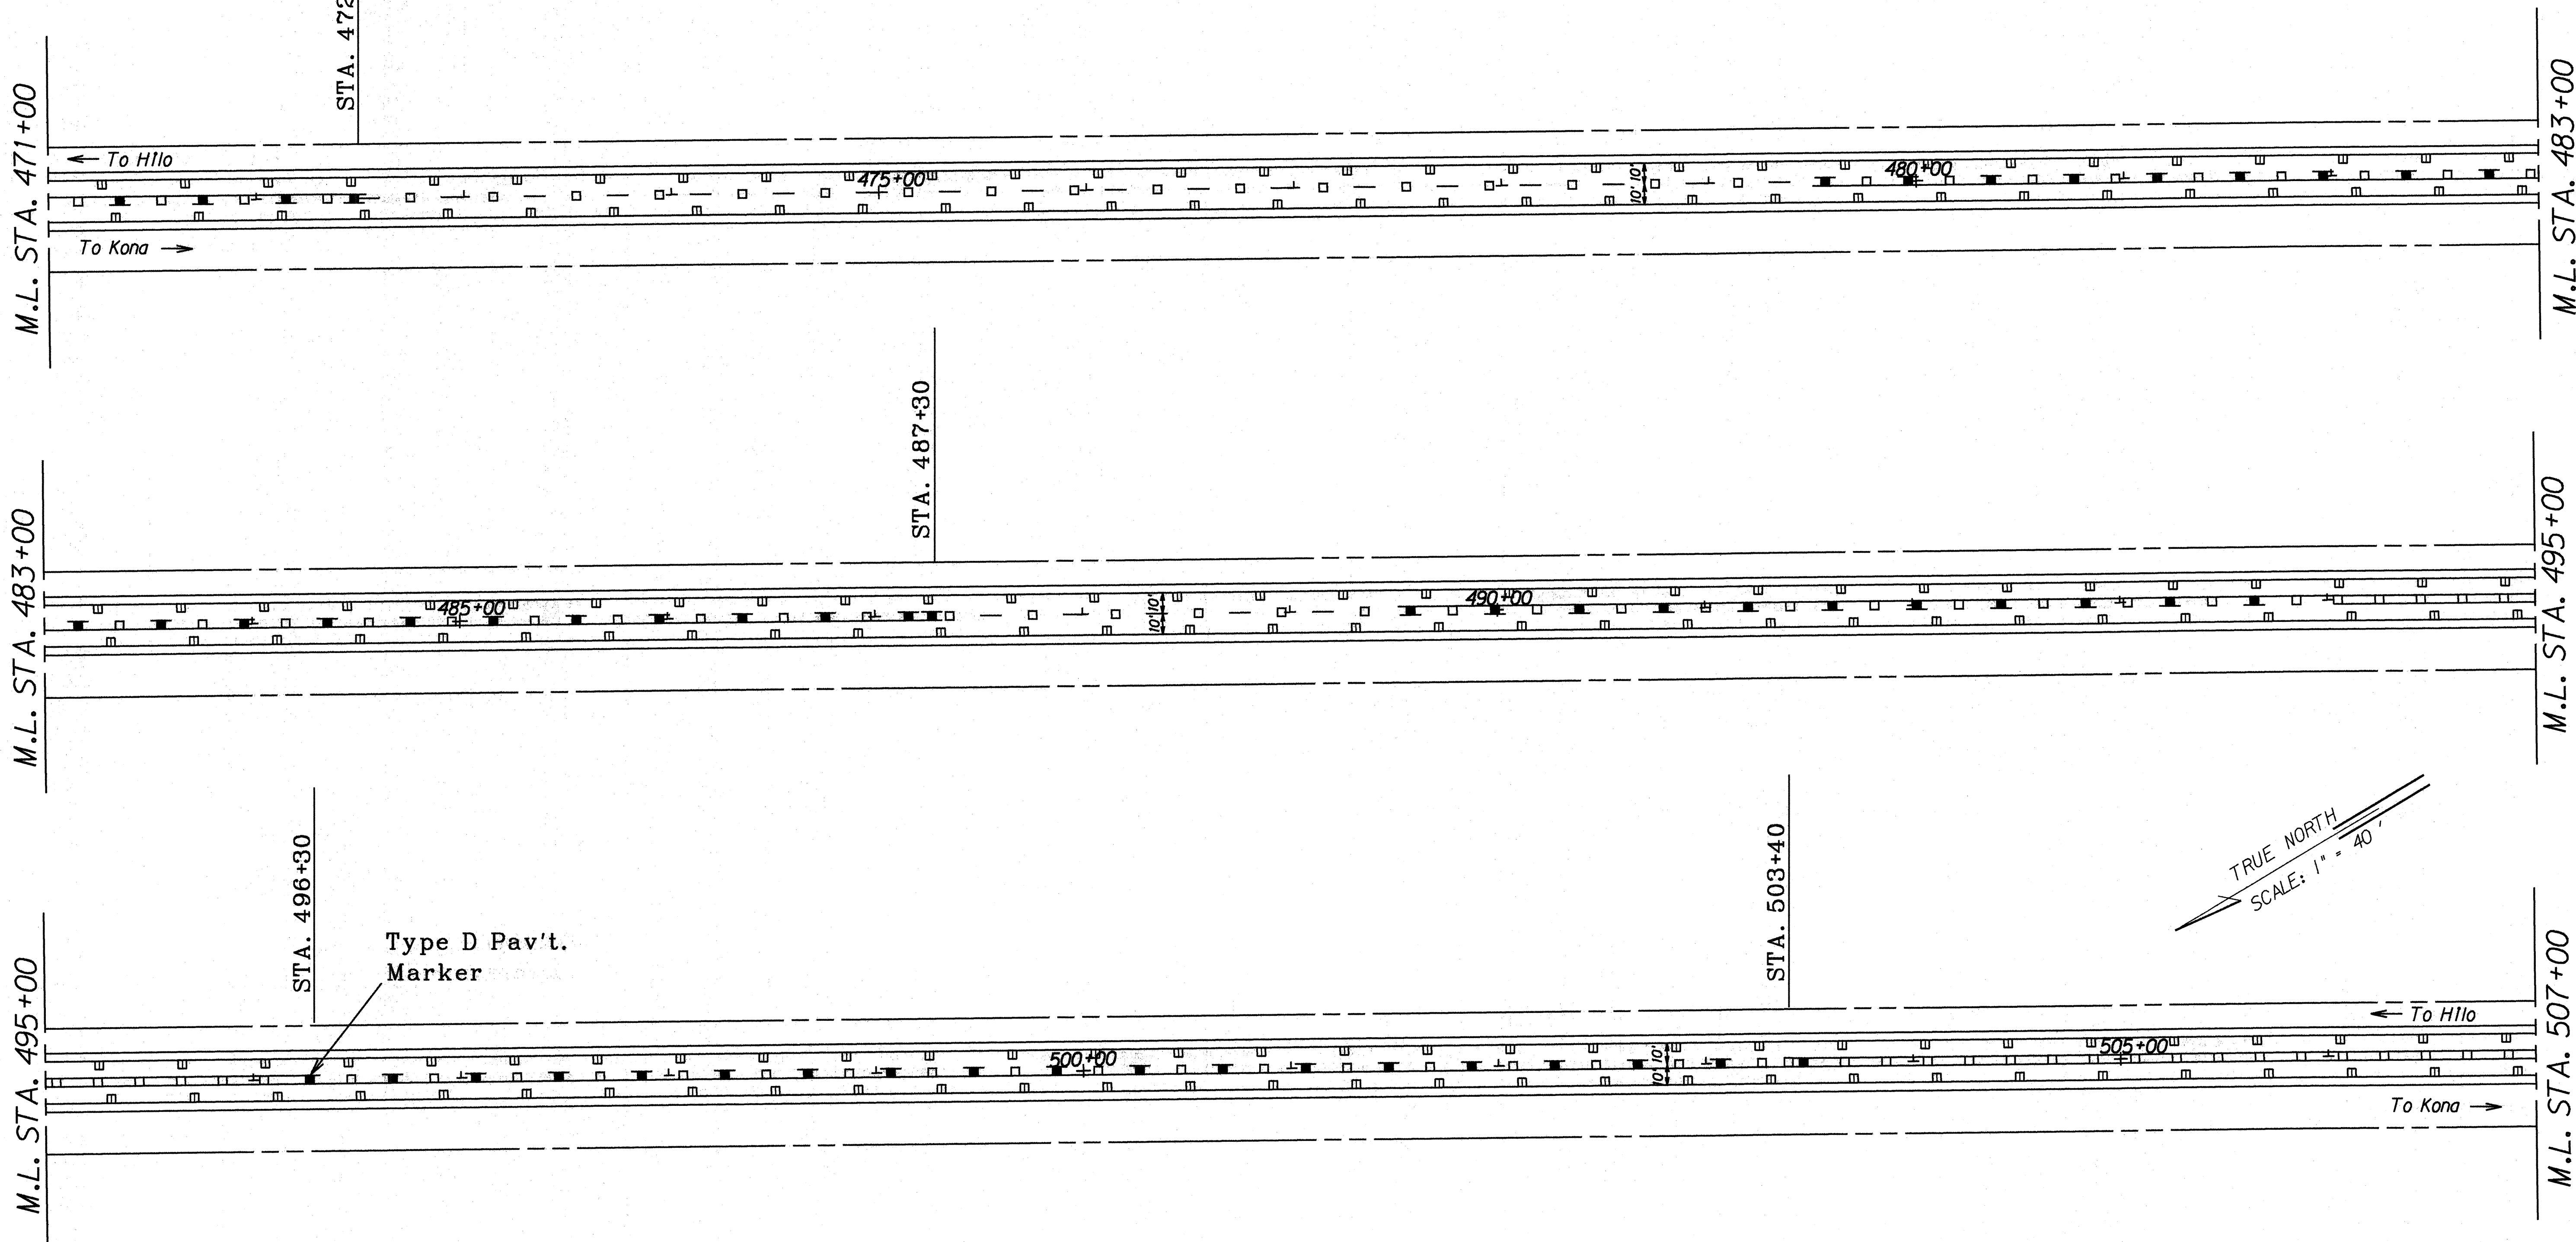

TRUE NORTH  
SCALE: 1" = 40'

ORIGINAL PLAN	SURVEY PLOTTED BY	DATE
NOTE BOOK	DRAWN BY	
No.	DESIGNED BY	
	QUANTITIES BY	
	CHECKED BY	

**LEGEND FOR  
AS-BUILT POSTINGS**

~~~~~ Squiggly line for as-built deletion

~~400.00~~ Double line for as-built deletion

Roadway Text for as-built posting

STATE OF HAWAII  
DEPARTMENT OF TRANSPORTATION  
HIGHWAYS DIVISION

**PAVEMENT MARKING &  
STRIPING PLAN**


**HAWAII BELT RD. RESURFACING**  
*Pahala to Nihole*  
PROJECT NO. 11G-01-91M

Scale: 1"=40' Date: Jan., 1991

SHEET No. 18 OF 11 SHEETS



|                     |       |            |             |           |              |
|---------------------|-------|------------|-------------|-----------|--------------|
| FED. ROAD DIST. NO. | STATE | PROJ. NO.  | FISCAL YEAR | SHEET NO. | TOTAL SHEETS |
| HAWAII              | HAW.  | 11G-01-91M | 1991        | 22        | 24           |

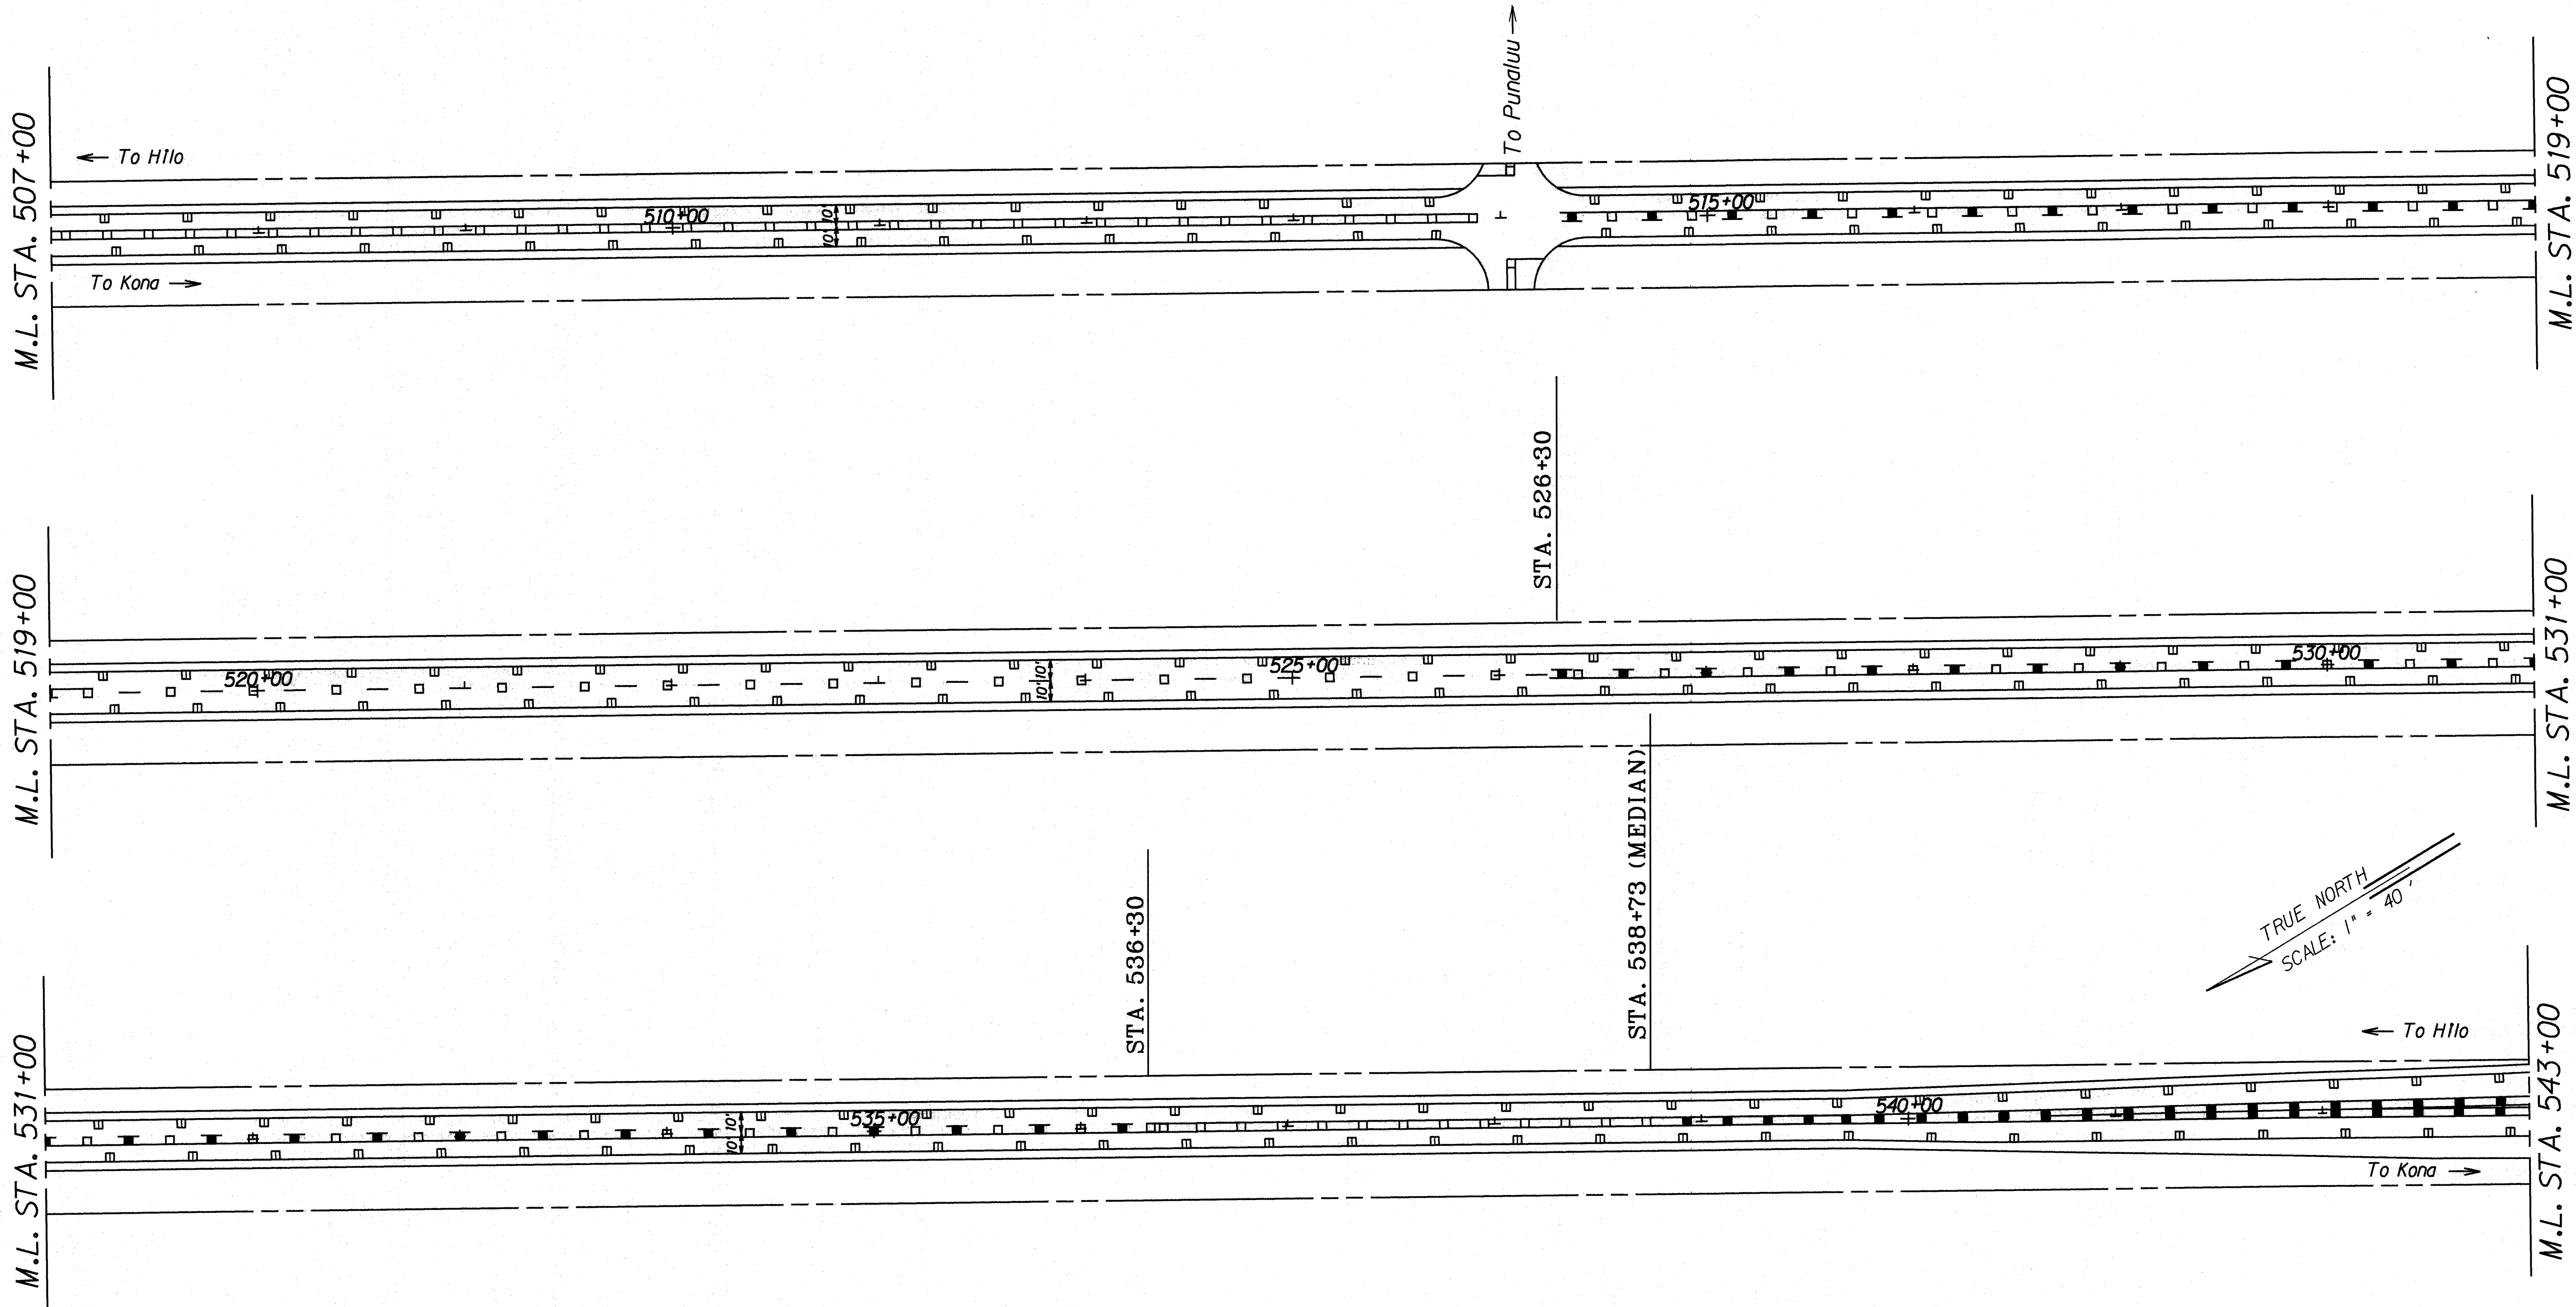

|               |                   |      |
|---------------|-------------------|------|
| ORIGINAL PLAN | SURVEY PLOTTED BY | DATE |
| NOTE BOOK     | DRAWN BY          |      |
| QUANTITIES BY | DESIGNED BY       |      |
| CHECKED BY    |                   |      |

**LEGEND FOR  
AS-BUILT POSTINGS**

Squiggly line for as-built deletion

Double line for as-built deletion

Roadway Text for as-built posting

STATE OF HAWAII  
DEPARTMENT OF TRANSPORTATION  
HIGHWAYS DIVISION

**PAVEMENT MARKING &  
STRIPING PLAN**


HAWAII BELT RD. RESURFACING  
Pahala to Niihale  
PROJECT NO. 11G-01-91M

Scale: 1" = 40' Date: Jan., 1991

SHEET No. T9 OF 11 SHEETS



| FED. ROAD DIST. NO. | STATE | PROJ. NO.  | FISCAL YEAR | SHEET NO. | TOTAL SHEETS |
|---------------------|-------|------------|-------------|-----------|--------------|
| HAWAII              | HAW.  | 11G-01-91M | 1991        | 23        | 24           |

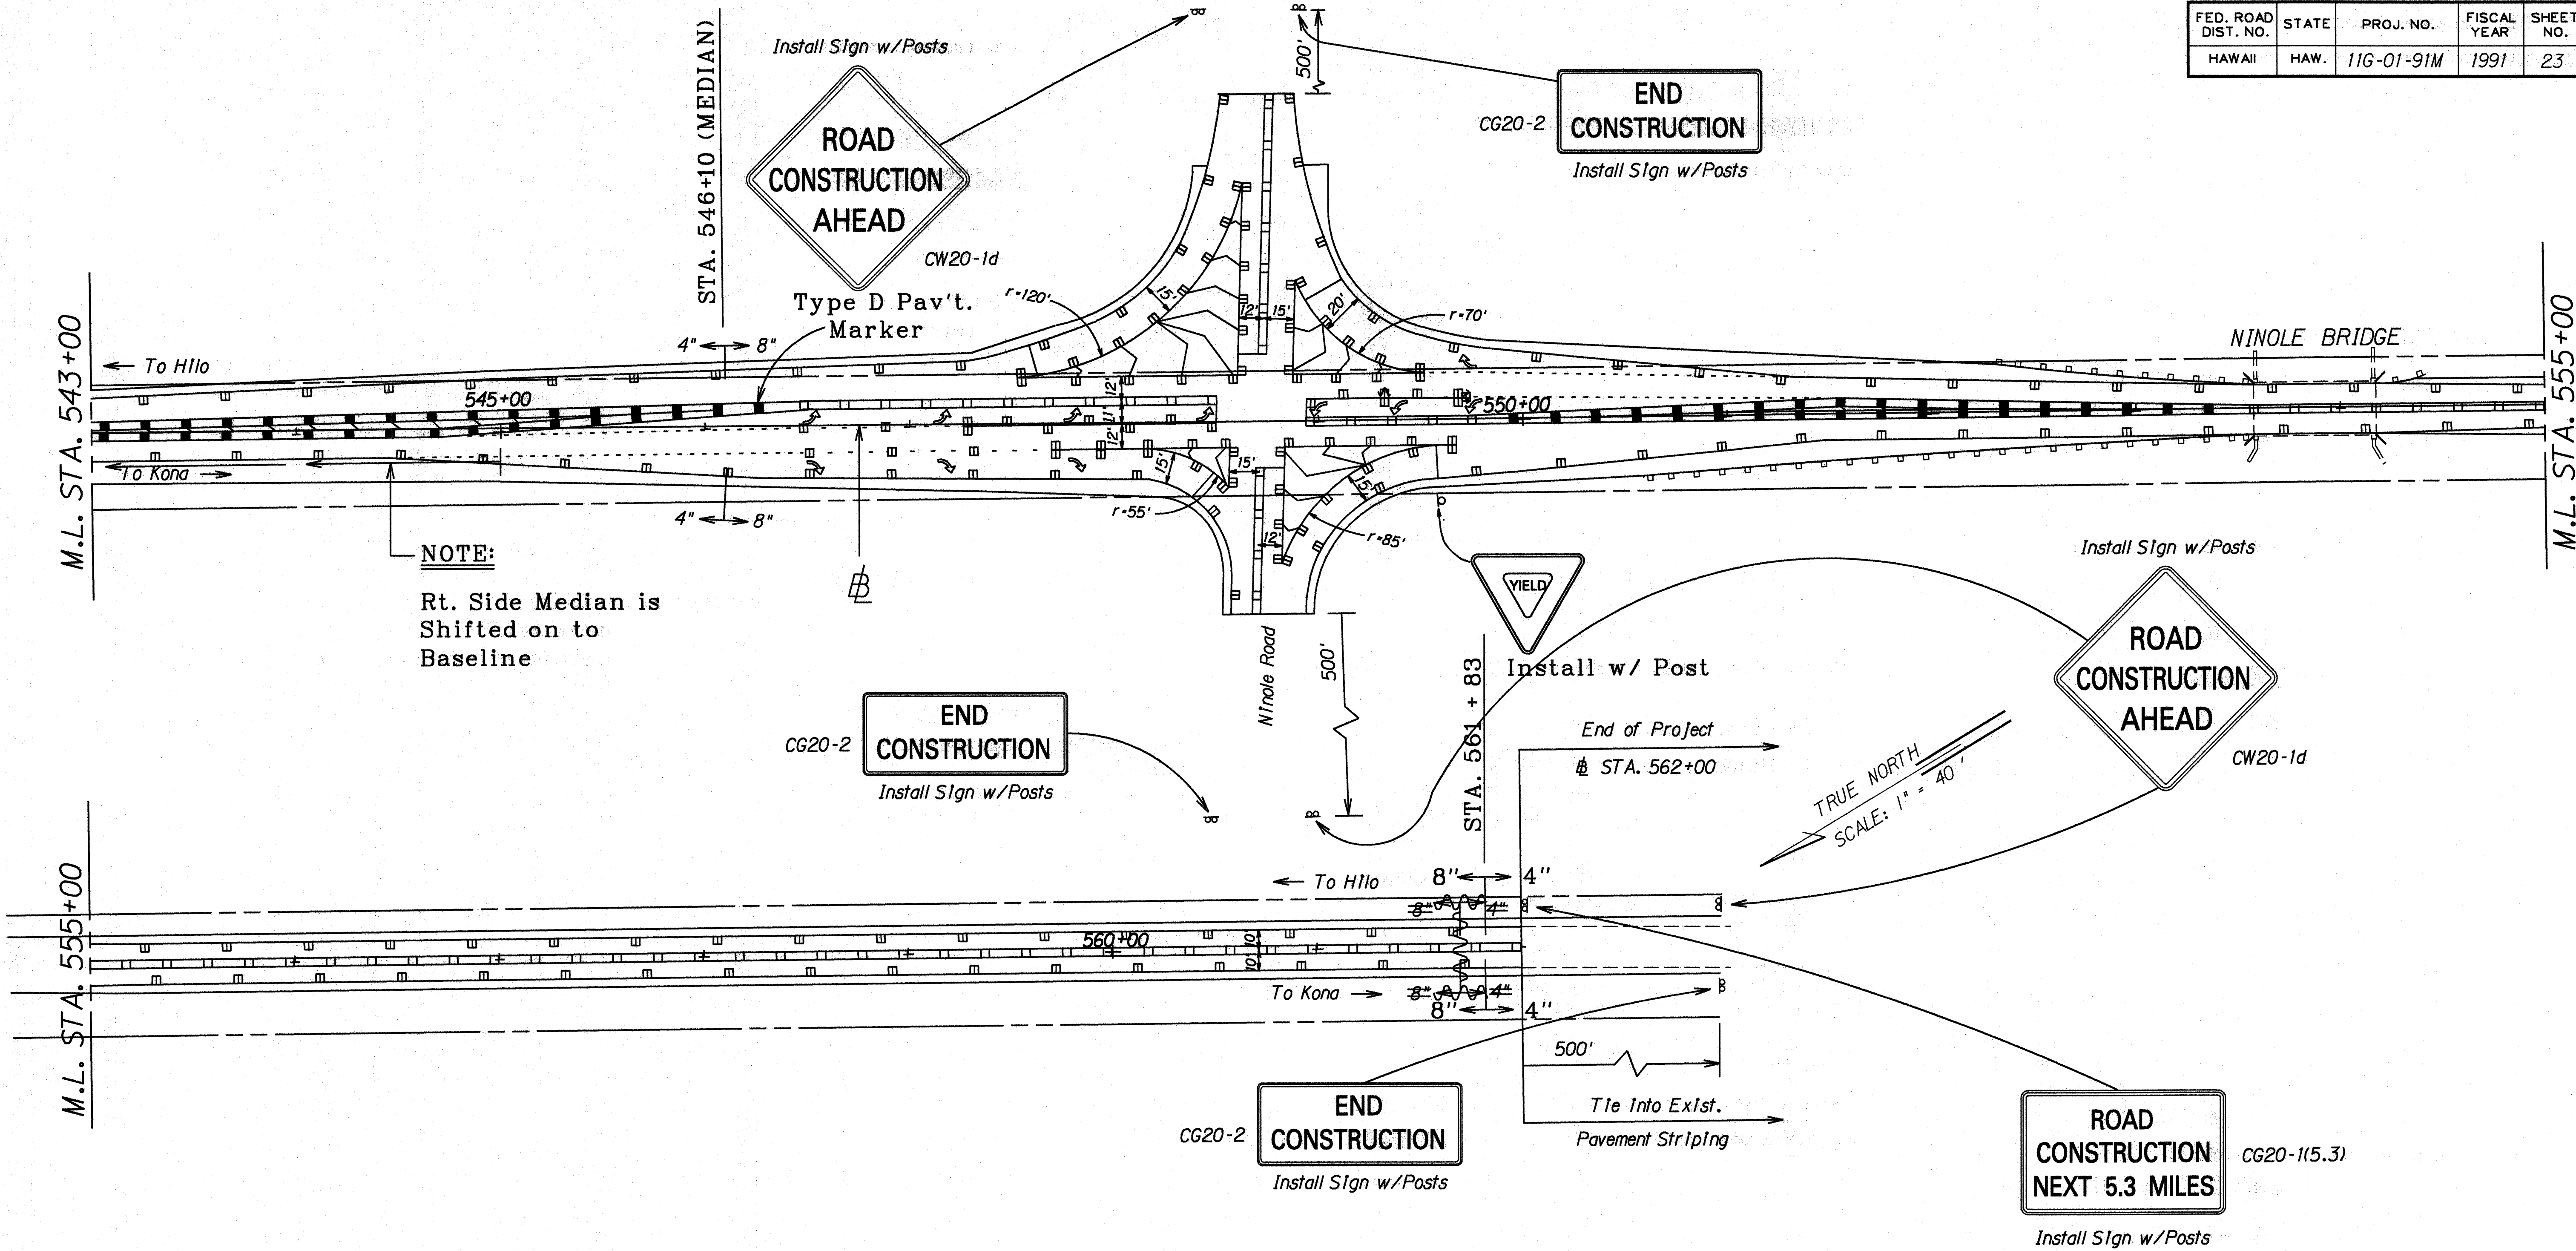

|                   |      |
|-------------------|------|
| SURVEY PLOTTED BY | DATE |
| DRAWN BY          |      |
| DESIGNED BY       |      |
| QUANTITIES BY     |      |
| CHECKED BY        |      |
| ORIGINAL PLAN     |      |
| NOTE BOOK         |      |
| N.                |      |

| LEGEND FOR AS-BUILT POSTINGS |                                     |
|------------------------------|-------------------------------------|
|                              | Squiggly line for as-built deletion |
|                              | Double line for as-built deletion   |
| Roadway                      | Text for as-built posting           |

STATE OF HAWAII  
DEPARTMENT OF TRANSPORTATION  
HIGHWAYS DIVISION

PAVEMENT MARKING &  
STRIPING PLAN

HAWAII BELT RD. RESURFACING  
Pahala to Ninole  
PROJECT NO. 11G-01-91M

Scale: 1" = 40'  
Date: Jan., 1991

SHEET No. 110 OF 11 SHEETS