	INDEX TO DRAWINGS
SHEET NO.	DESCRIPTION
	TITLE SHEET
2	STANDARD PLANS SUMMARY
3	GENERAL NOTES & LEGEND
4	TYPICAL SECTIONS, DETAILS
	& SCHEDULES
5-13	ROADWAY PLANS
14	PAVEMENT MARKING LEGEND,
	DETAILS & NOTES
15-23	PAVEMENT MARKING &
	STRIPING PLAN
24	TRAFFIC SUMMARIES

Plan Sht. No. CCO 4S-1 is a supplementary sheet to this project.

TOTAL SHEET COUNT after "AS BUILT" postings.

25 Sheets.

STATE OF HAWAII


DEPARTMENT OF TRANSPORTATION


HIGHWAYS DIVISION
HONOLULU, HAWAII
"AS-BUILT"
PLANS FOR

HAWAII BELT ROAD RESURFACING

PAHALA TO NINOLE
PROJECT NO. IIG-01-91M

DISTRICT OF KAU
ISLAND OF HAWAII

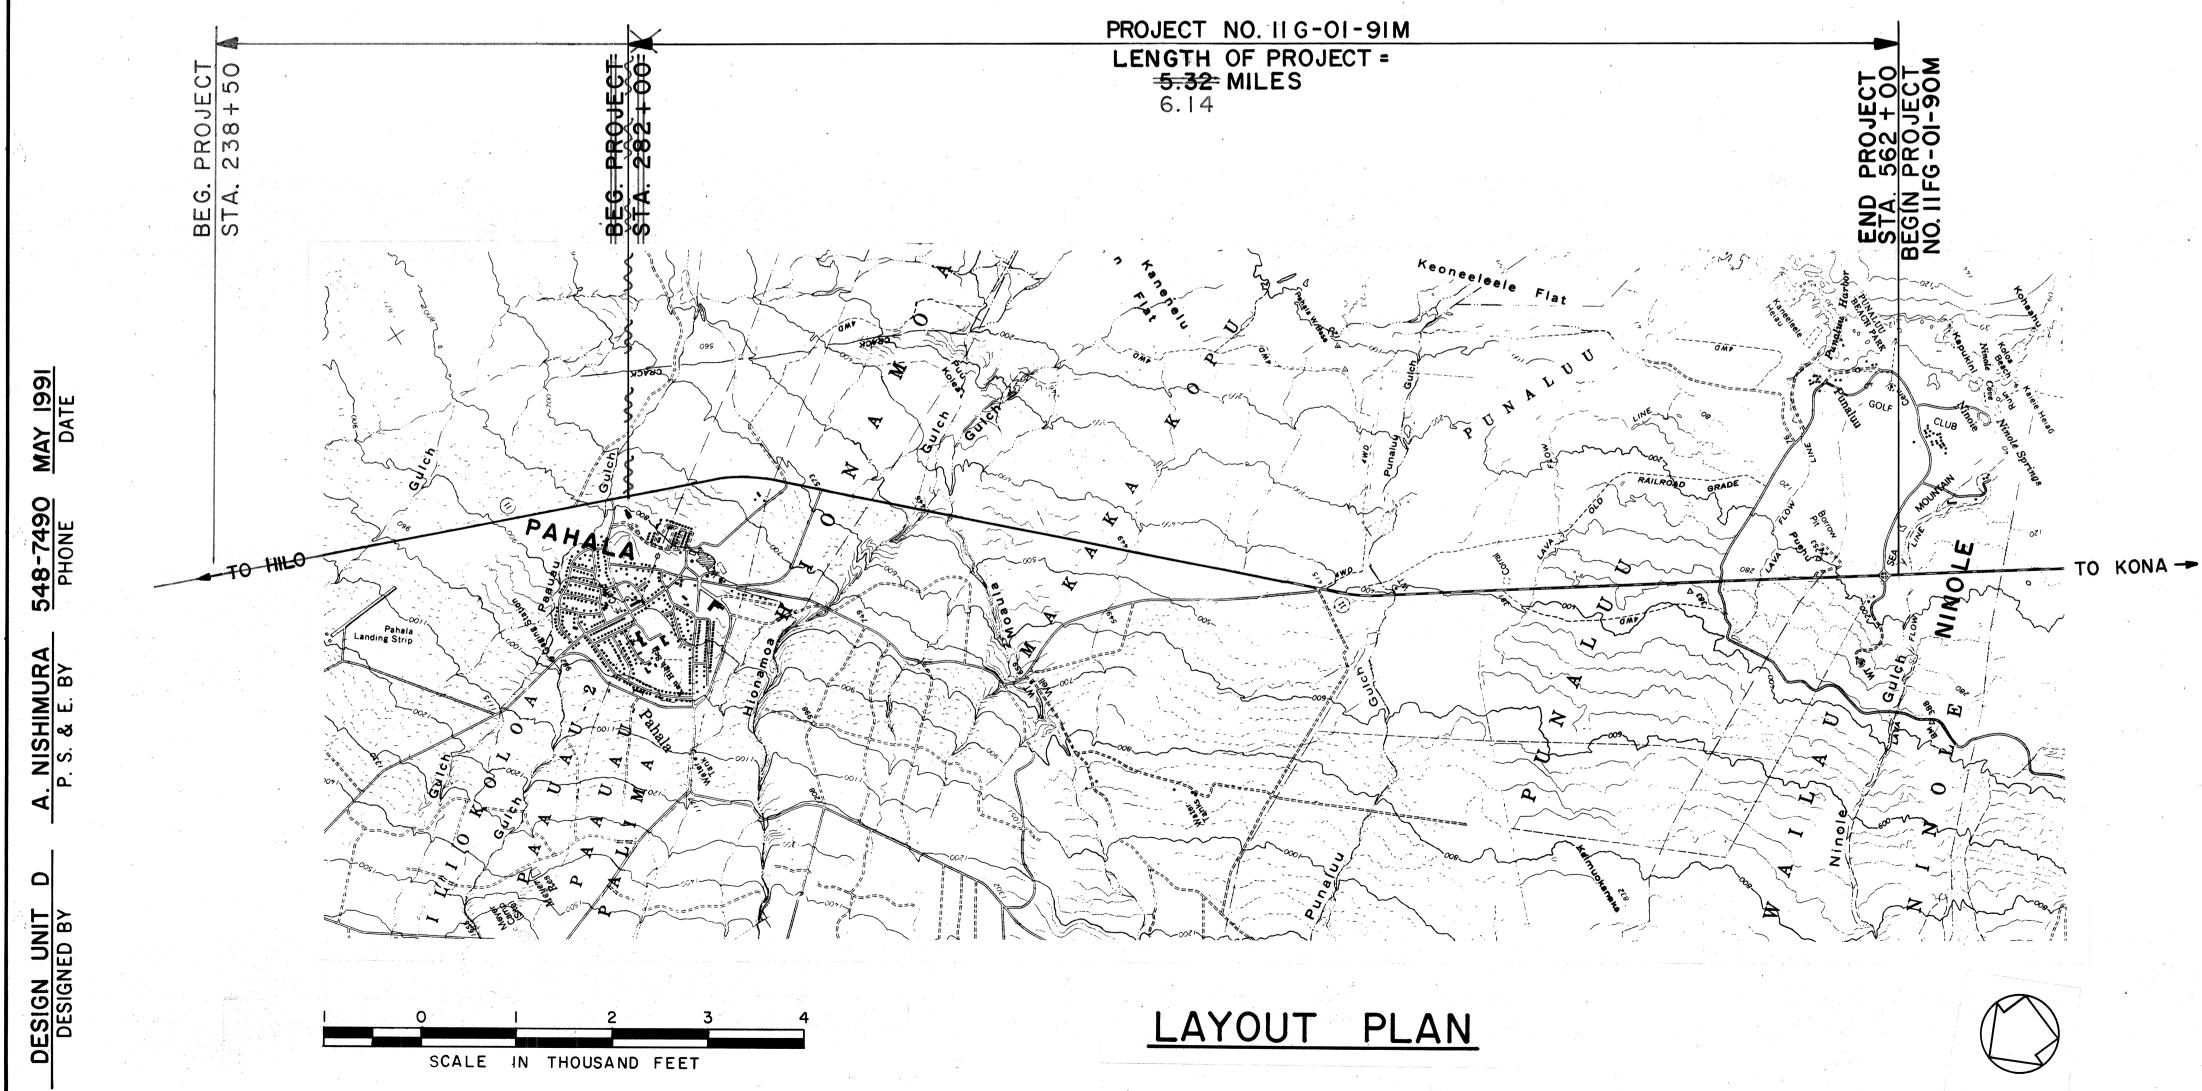

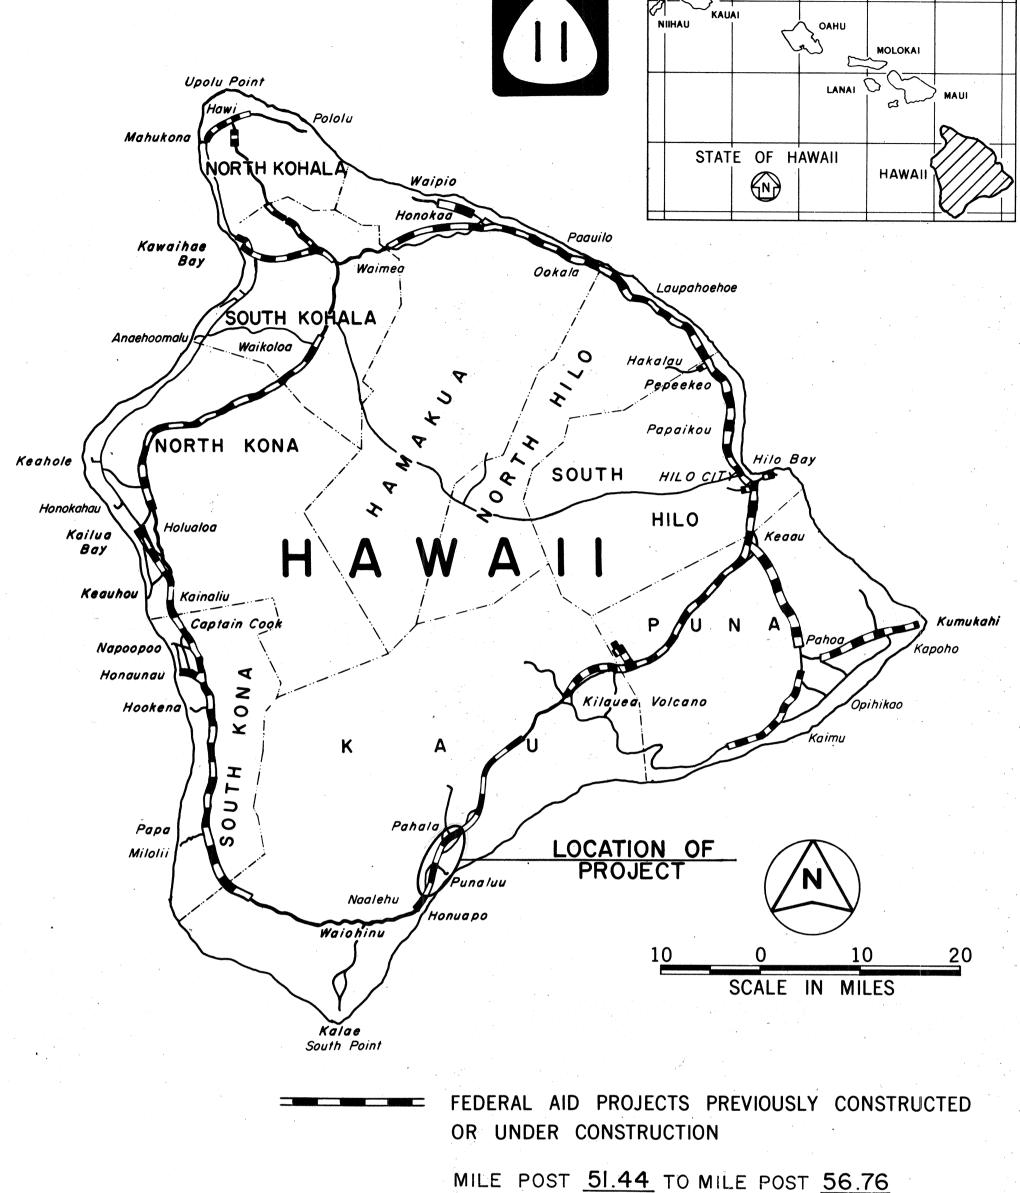

FED. ROAD DIST. NO.

STATE

PROJ. NO.

11G-01-91M

FISCAL SHEET TOTAL YEAR NO. SHEETS

CHANGES MADE DURING CONSTRUCTION HAVE BEEN INCORPORATED ON THESE PLANS EXCEPT CHANGES IN THE ORIGINAL THEORETICAL QUANTITIES.

RESIDENT ENGINEER DATE

DEPARTMENT OF TRANSPORTATION
STATE OF HAWAII

APPROVED:

LL

DIR. OF TRANSPORTATION

DATE