

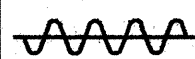
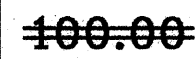
FED. ROAD DIST. NO.	STATE	PROJ. NO.	FISCAL YEAR	SHEET NO.	TOTAL SHEETS
HAWAII	HAW.	11G-01-91M	1991	24	24

PAVEMENT MARKING SUMMARY	
DESCRIPTION	QUANTITY
PAVEMENT MARKERS	
TYPE CL _____	1,481 EACH
TYPE DL _____	865 EACH
TYPE HL _____	404 EACH
TYPE J _____	1,800 EACH
TAPE - TYPE I OR THERMOPLASTIC EXTRUSION	
4-INCH PAVEMENT STRIPE (WHITE) _____	240 L. F.
4-INCH PAVEMENT STRIPE (YELLOW) _____	11,950 L. F.
8-INCH PAVEMENT STRIPE (WHITE) _____	215 L. F.
DOUBLE 4-INCH PAVEMENT STRIPE (YELLOW) _____	7,490 L. F.
PAVEMENT ARROW _____	11 EACH
TAPE - TYPE II OR THERMOPLASTIC EXTRUSION	
4-INCH PAVEMENT STRIPE (WHITE) _____	43,675 L. F.
8-INCH PAVEMENT STRIPE (WHITE) _____	13,375 L. F.
12-INCH PAVEMENT STRIPE (WHITE) _____	450 L. F.
12-INCH PAVEMENT STRIPE (YELLOW) _____	75 L. F.
DOUBLE 4-INCH PAVEMENT STRIPE (YELLOW) _____	2,015 L. F.
THERMOPLASTIC EXTRUSION	
4-INCH PAVEMENT STRIPE (WHITE) _____	715 L. F.
12-INCH PAVEMENT STRIPE (WHITE) _____	225 L. F.

CONSTRUCTION SIGN SUMMARY			
SIGN NO.	MESSAGE	W/POST	W/O POST
CW20-1d	ROAD CONSTRUCTION AHEAD	# 5	
CG20-2	END CONSTRUCTION	4	
CG20-1(5.3)	ROAD CONSTRUCTION NEXT 5.3 MILES	2	
	TOTAL	# 11	0

ORIGINAL PLAN	SURVEY PLOTTED BY _____	DATE _____
	DRAWN BY _____	
	DESIGNED BY _____	
	CHECKED BY _____	
NOTE BOOK	QUANTITIES BY _____	
	NO. _____	

LEGEND FOR
AS-BUILT POSTINGS

-  Squiggly line for as-built deletion
-  Double line for as-built deletion
- Roadway Text for as-built posting

STATE OF HAWAII
DEPARTMENT OF TRANSPORTATION
HIGHWAYS DIVISION

TRAFFIC SUMMARIES

HAWAII BELT ROAD RESURFACING

Pahala to Ninole

Proj. No. 11G-01-91M

Date: Jan., 1991

SHEET No. 11 OF 11 SHEETS