


TYPICAL PLAN

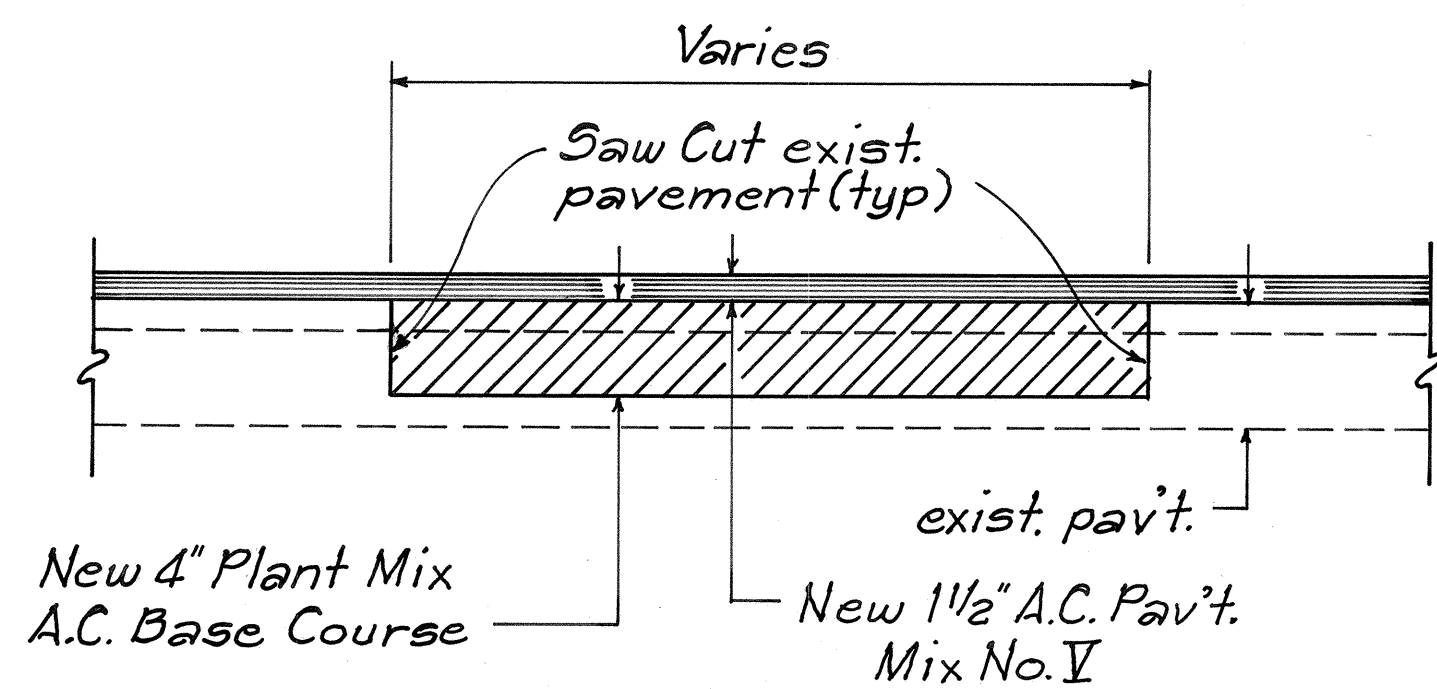

TYPICAL SECTION

PAVEMENT RECONSTRUCTION DETAIL
Not To Scale

RECONSTRUCTION AREA SCHEDULE						
STATION		OFFSET FROM & (Ft.)		LENGTH (Lin. Ft.)	WIDTH (Ft.)	APPROX. AREA (Sq. Ft.)
FROM	TO	LEFT	RIGHT			
961+80	962+20	7		40	4	160
969+70	971+70	7.5		200	5	1,000
1029+20	1030+50	7		130	6	780
1031+80	1033+30	7		150	6	900
1037+65	1040+00	7.5		235	5	1,175
1039+10	1040+40		8	130	4	520
1040+85	1041+00	8		15	4	60
1041+80	1044+00		8	220	4	880
1042+00	1044+00	8		200	4	800
1048+00	1048+95	8		95	4	380
1055+00	1057+60		7.5	260	5	1,300
1055+57	1056+25	7		68	6	408
1058+00	1058+80		7.5	80	5	400
1058+45	1058+80	7.5		35	5	175
1068+90	1069+65		7.5	75	5	375
1070+86	1075+00		8	414	4	1,656
1073+15	1074+63	8		148	4	592
1077+16	1079+30	8		214	4	856
1080+20	1081+70	7.5		150	5	750
1080+20	1081+70		7.5	150	5	750
1110+95	1115+28	7		233	6	1,398
1123+40	1125+55	7.5		215	5	1,075
1125+80	1128+64	8		* 283	4	1,132
1134+70	1136+85		8	* 214	4	856
TOTAL						18,378

* Length affected by equation station.

SURVEY PLOTTED BY	DATE
DRAWN BY	
DESIGNED BY	
CHECKED BY	
NO.	

FED. ROAD DIST. NO.	STATE	PROJ. NO.	FISCAL YEAR	SHEET NO.	TOTAL SHEETS
HAWAII	HAW.	11C-01-92M	1992	85-1	12

RECONSTRUCTION AREA SCHEDULE						
STATION		OFFSET FROM CENTERLINE		LENGTH (Lin. Ft.)	WIDTH (FT.)	APPROX. AREA (SQ. FT.)
FROM	TO	LEFT	RIGHT			
961 + 60	962 + 25	4.5		65	6	390
969 + 57	970 + 0	5		43	6	258
970 + 0	970 + 50	4		50	6	300
970 + 50	971 + 0	5		50	6	300
971 + 0	971 + 95	6.5		95	6	570
978 + 57	980 + 35	5.5		178	6	1,068
1005 + 25	1007 + 74		6	249	6	1,494
1007 + 90	1008 + 47	4		57	6	342
1029 + 20	1030 + 0	1		80	6	720
1030 + 12	1031 + 0		4	88	6	528
1030 + 0	1030 + 64	4		64	6	384
1030 + 80	1033 + 30	4		250	6	1,500
1037 + 65	1040 + 0	7		235	6	1,410
1040 + 85	1041 + 48	5.5		63	6	378
1041 +80	1045 + 60		5	380	6	2,280
1041 + 88	1044 + 93	5		305	6	1,830
1055 + 0	1057 + 60		5	260	6	1,560
1057 + 95	1058 + 57		6	62	6	372
1068 + 85	1069 + 65		4	80	6	480
1070 + 0	1075 + 70		5.5	570	6	3,420
1073 + 15	1074 + 63	5		148	6	888
1077 + 16	1079 + 30			214	6	1,284
1079 + 77	1081 + 70		5	193	6	1,158
1080 + 30	1081 + 75	5		145	6	870
1110 + 89	1113 + 28	5		239	6	1,434
1125 + 70	1128 + 64	5		294	6	1,764
1128 + 0	1128 + 64		6	64	6	384
1134 + 70	1136 + 85		5	215	6	1,290
TOTAL						28,656

THIS DWG IS PREPARED FOR
AS-BUILT POSTING

STATE OF HAWAII
DEPARTMENT OF TRANSPORTATION
HIGHWAYS DIVISION

PAVEMENT RECONSTRUCTION

DETAIL AND SCHEDULE

HAWAII BELT ROAD RESURFACING
KAAPUNA TO MILOLII

PROJ. No. 11C-01-92M

Scale: NTS Date: MARCH, 1999

ORIGINAL
PLAN

NOTED
BY
Nthrmnsdgn

SURVEY PLOTTED BY

DRAWN BY

DESIGNED BY

CHECKED BY

DATE

3/27/92

0101051010

thrt