



FED. ROAD DIST. NO.	STATE	FED. AID PROJ. NO.	FISCAL YEAR	SHEET NO.	TOTAL SHEETS
HAWAII	HAW.	11C-01-92M	1992	4	12

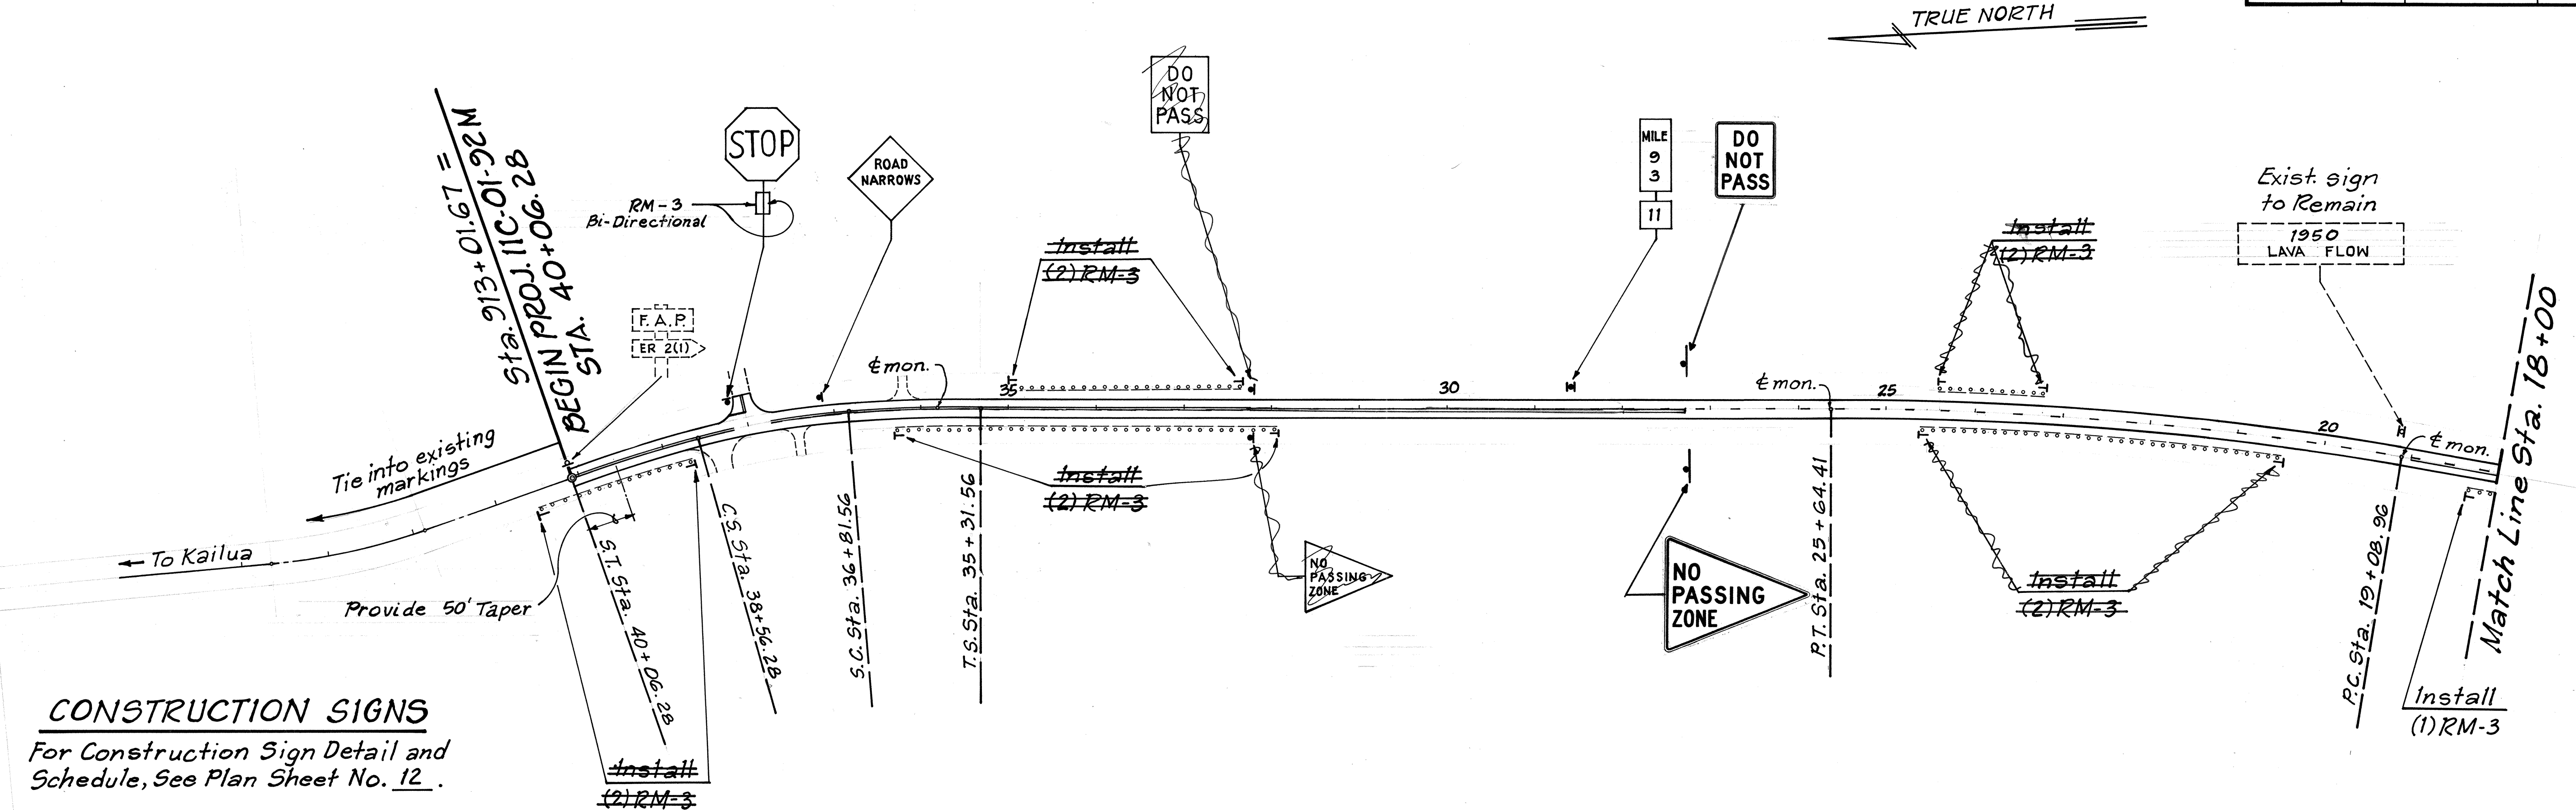

**CONSTRUCTION SIGNS**  
For Construction Sign Detail and Schedule, See Plan Sheet No. 12.

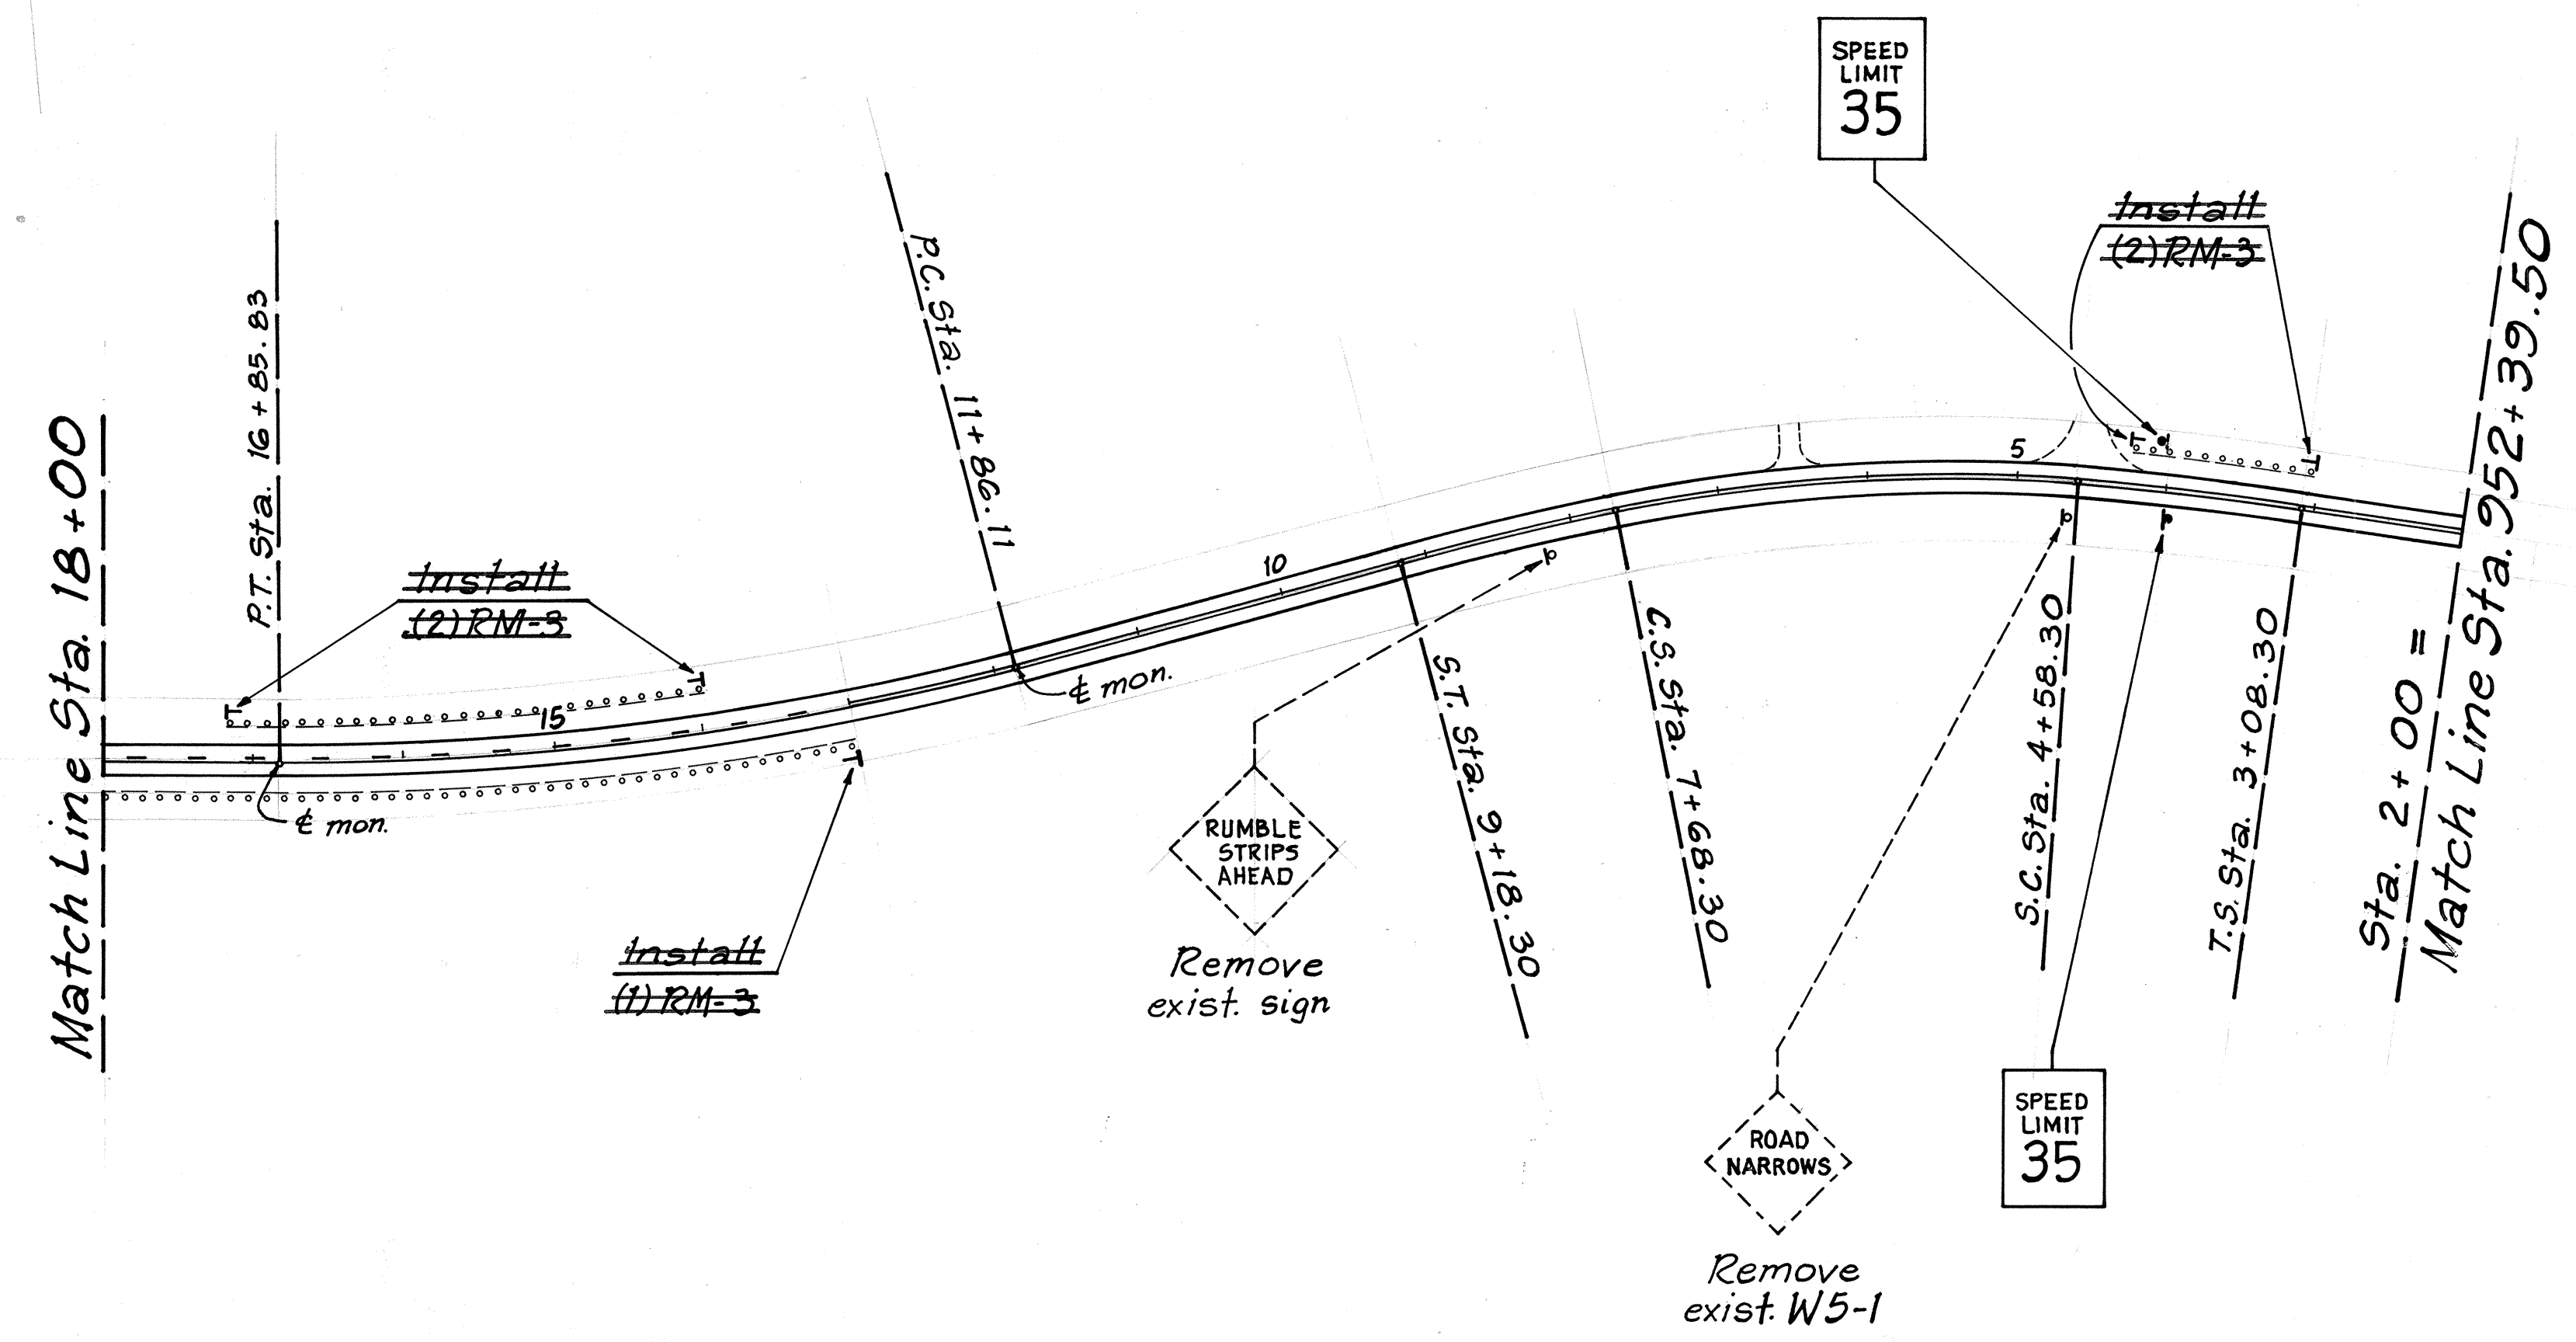

**NOTE :**  
For Miscellaneous Schedules  
See Sheet No. 11.  
For RM-2 Installed  
See Sheet No. 10.

STATE OF HAWAII  
DEPARTMENT OF TRANSPORTATION  
HIGHWAYS DIVISION

**PLAN**  
**ROADWAY, STRIPING & SIGNS**  
HAWAII BELT ROAD RESURFACING  
KAAPUNA TO MILOLII  
PROJ. No. 11C-01-92M


Scale: 1"=100' Date: Jan., 1992

SHEET No. 1 OF 4 SHEETS

ORIGINAL PLAN	DATE
DESIGNED BY	
TRACED BY	
NOTED BY	
CHECKED BY	

FED. ROAD DIST. NO.	STATE	PROJ. NO.	FISCAL YEAR	SHEET NO.	TOTAL SHEETS
HAWAII	HAW.	11C-01-92M	1992	5	12

SURVEY PLOTTED BY	DATE
DRAWN BY	
TRACED BY	
QUANTITIES BY	
CHECKED BY	
ORIGINAL PLAN	
NOTE BOOK	
NO.	

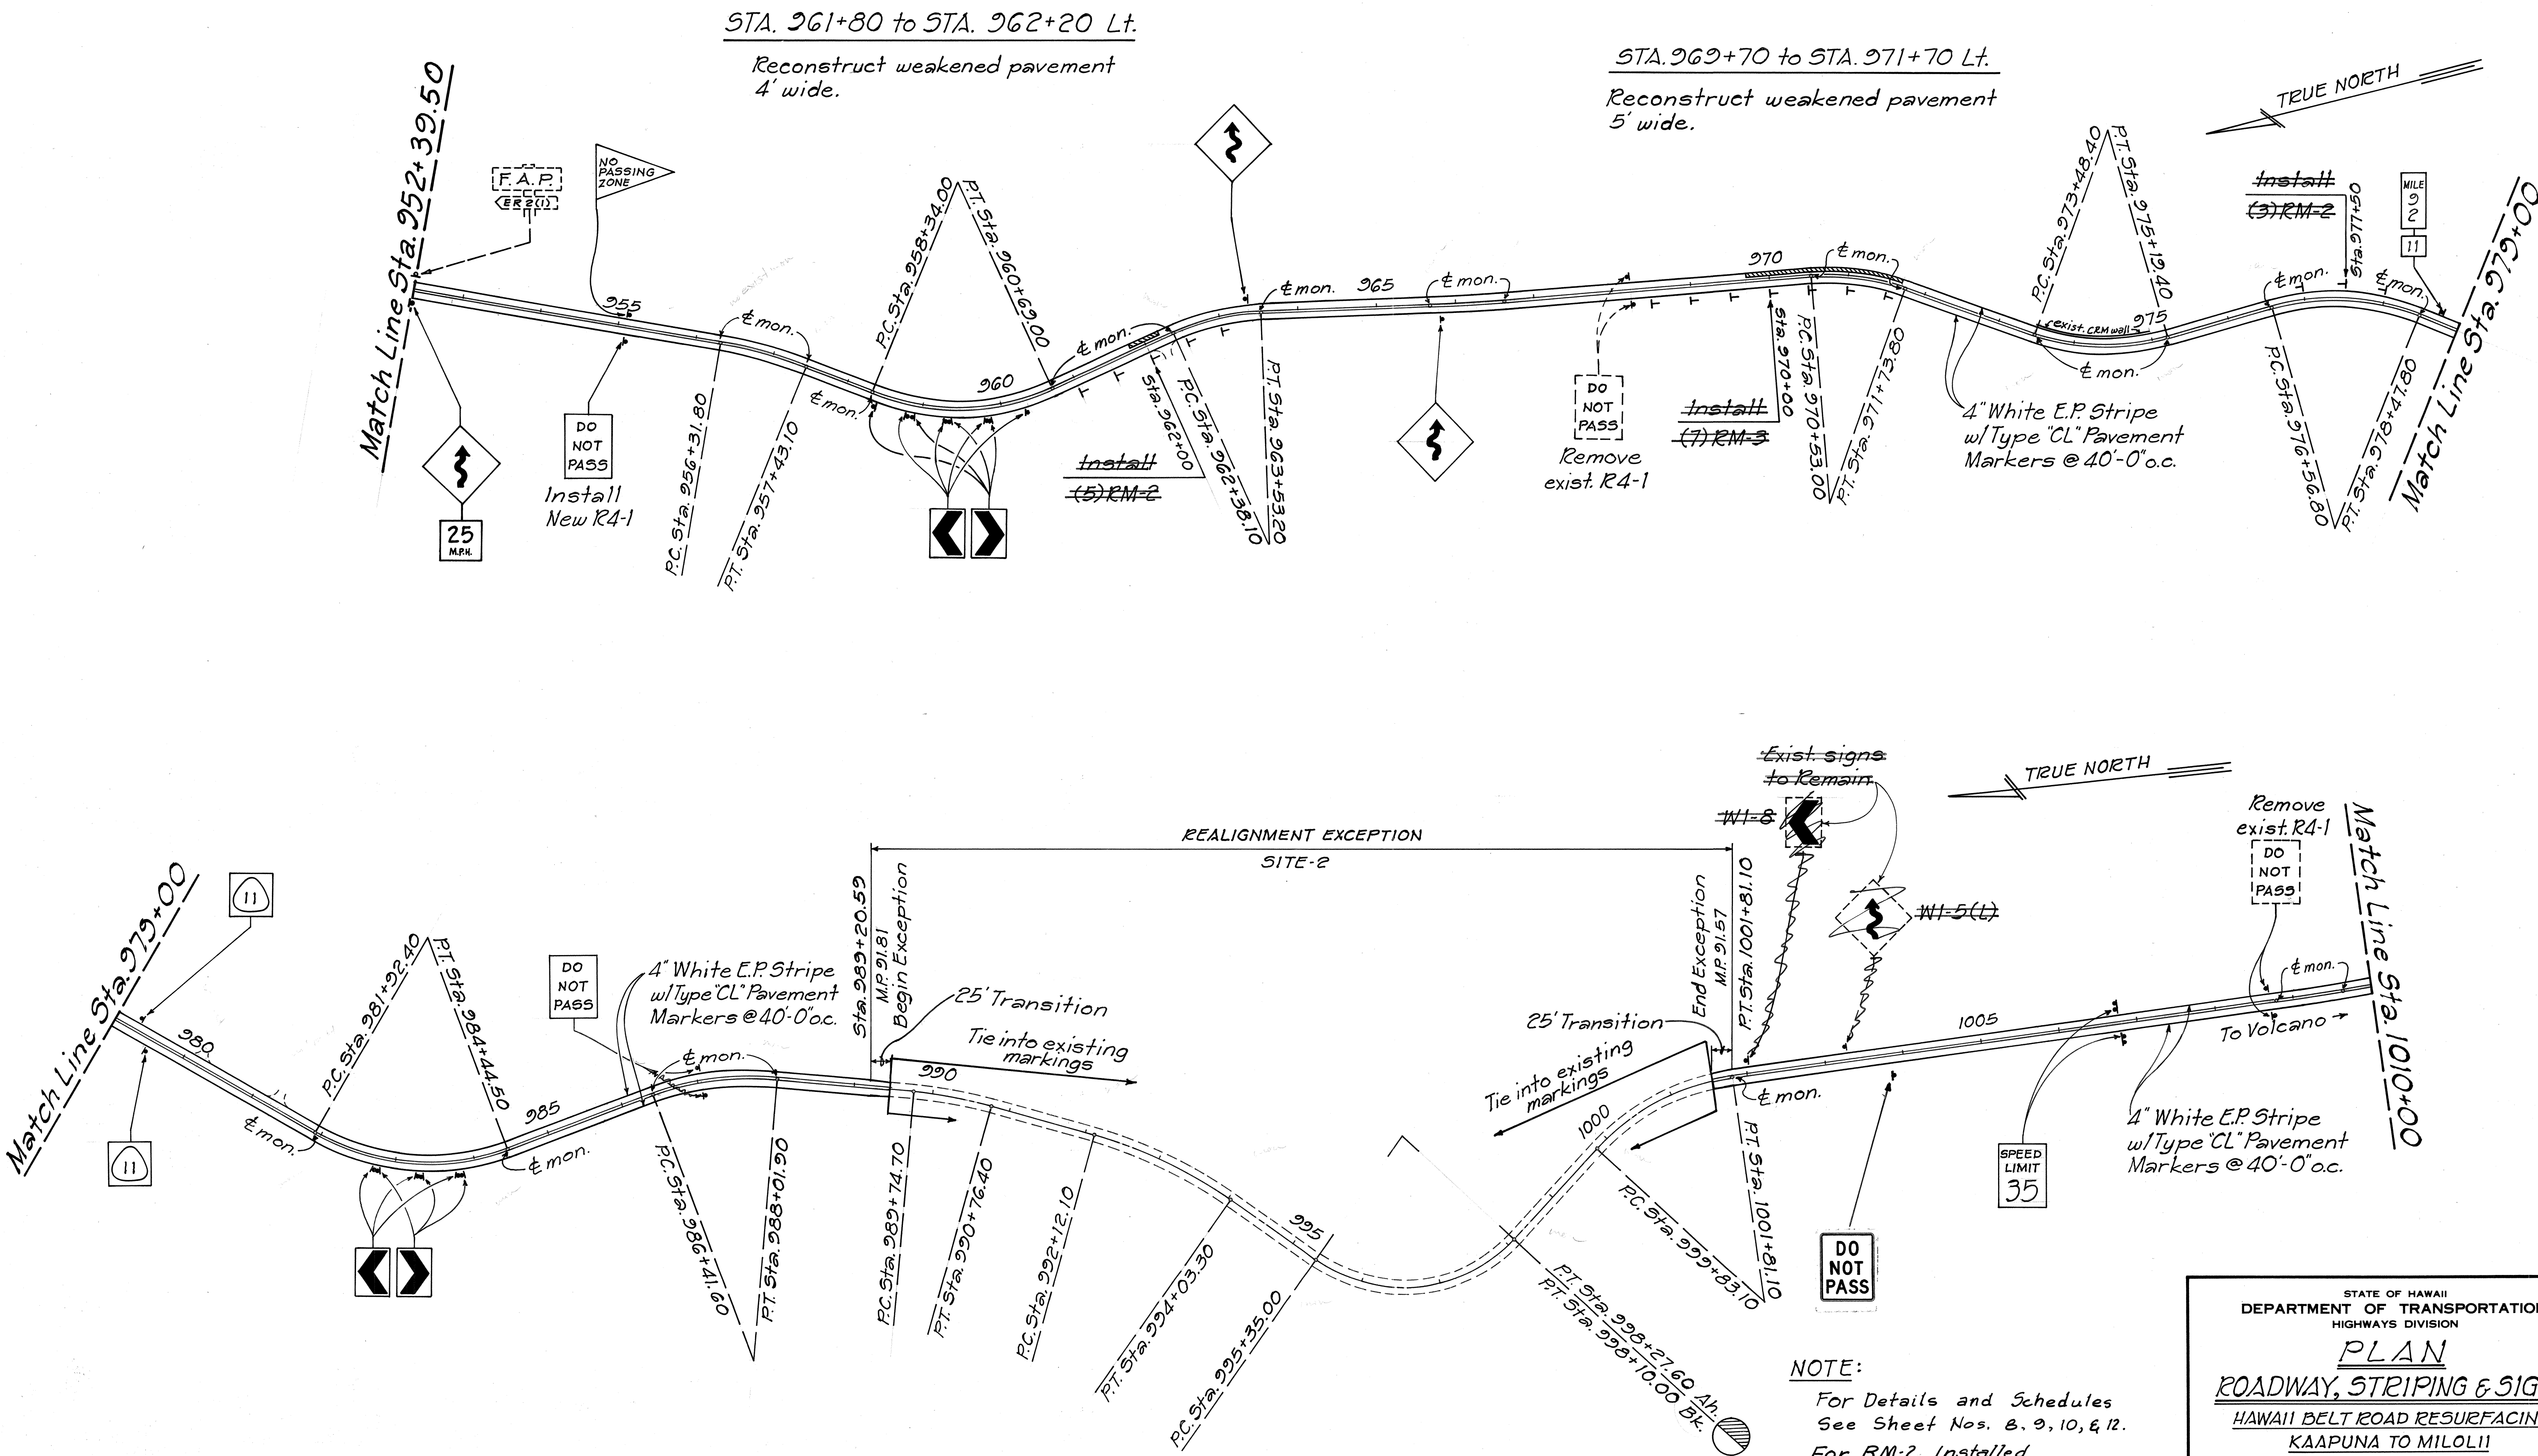

NOTE:  
 For Details and Schedules  
 See Sheet Nos. 8, 9, 10, & 12.  
 For RM-2 Installed  
 See Sheet No. 10.


STATE OF HAWAII  
 DEPARTMENT OF TRANSPORTATION  
 HIGHWAYS DIVISION

PLAN  
 ROADWAY, STRIPING & SIGNS  
 HAWAII BELT ROAD RESURFACING  
 KAAPUNA TO MILOLI  
 PROJ. No. 11C-01-92M  
 Scale: 1"=100'  
 Date: Jan., 1992

SHEET No. 2 OF 4 SHEETS




FED. ROAD DIST. NO.	STATE	PROJ. NO.	FISCAL YEAR	SHEET NO.	TOTAL SHEETS
HAWAII	HAW.	11C-01-92M	1992	6	12

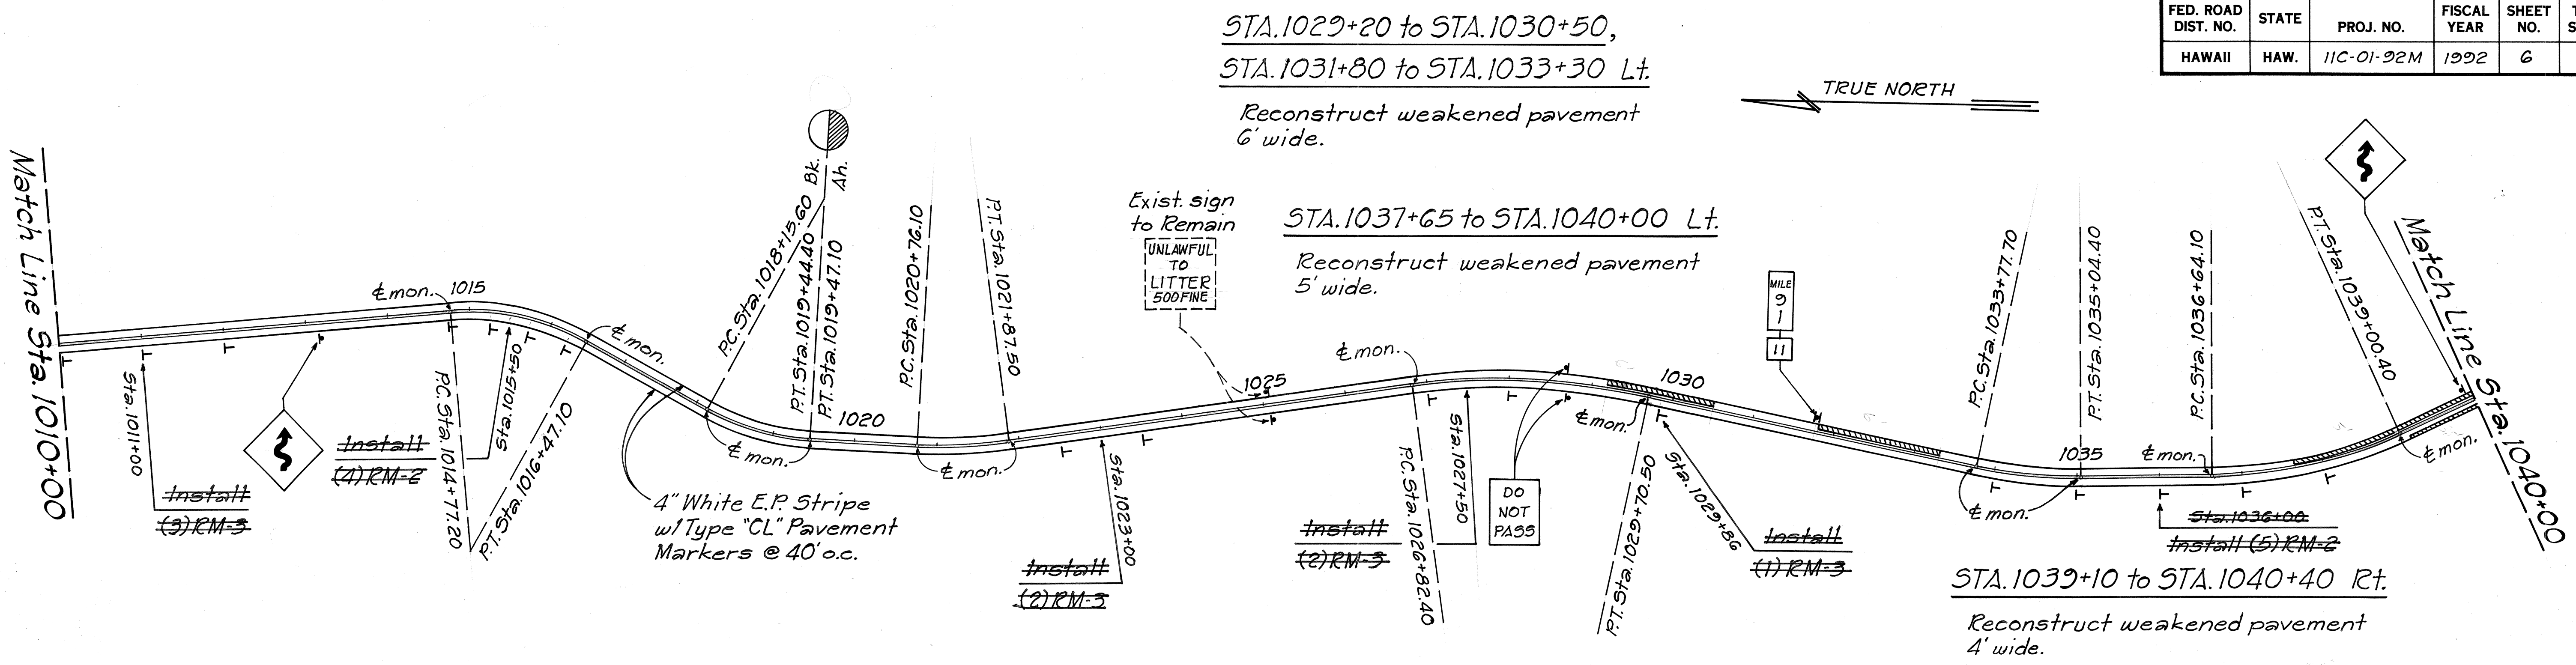

STA. 1040+85 to STA. 1041+00,  
 STA. 1042+00 to STA. 1044+00,  
 STA. 1048+00 to STA. 1048+25 Lt.  
 Reconstruct weakened pavement  
 4' wide.

STA. 1055+57 to STA. 1056+25 Lt.  
 Reconstruct weakened pavement  
 6' wide.

STA. 1058+45 to STA. 1058+80 Lt.  
 Reconstruct weakened pavement  
 5' wide.

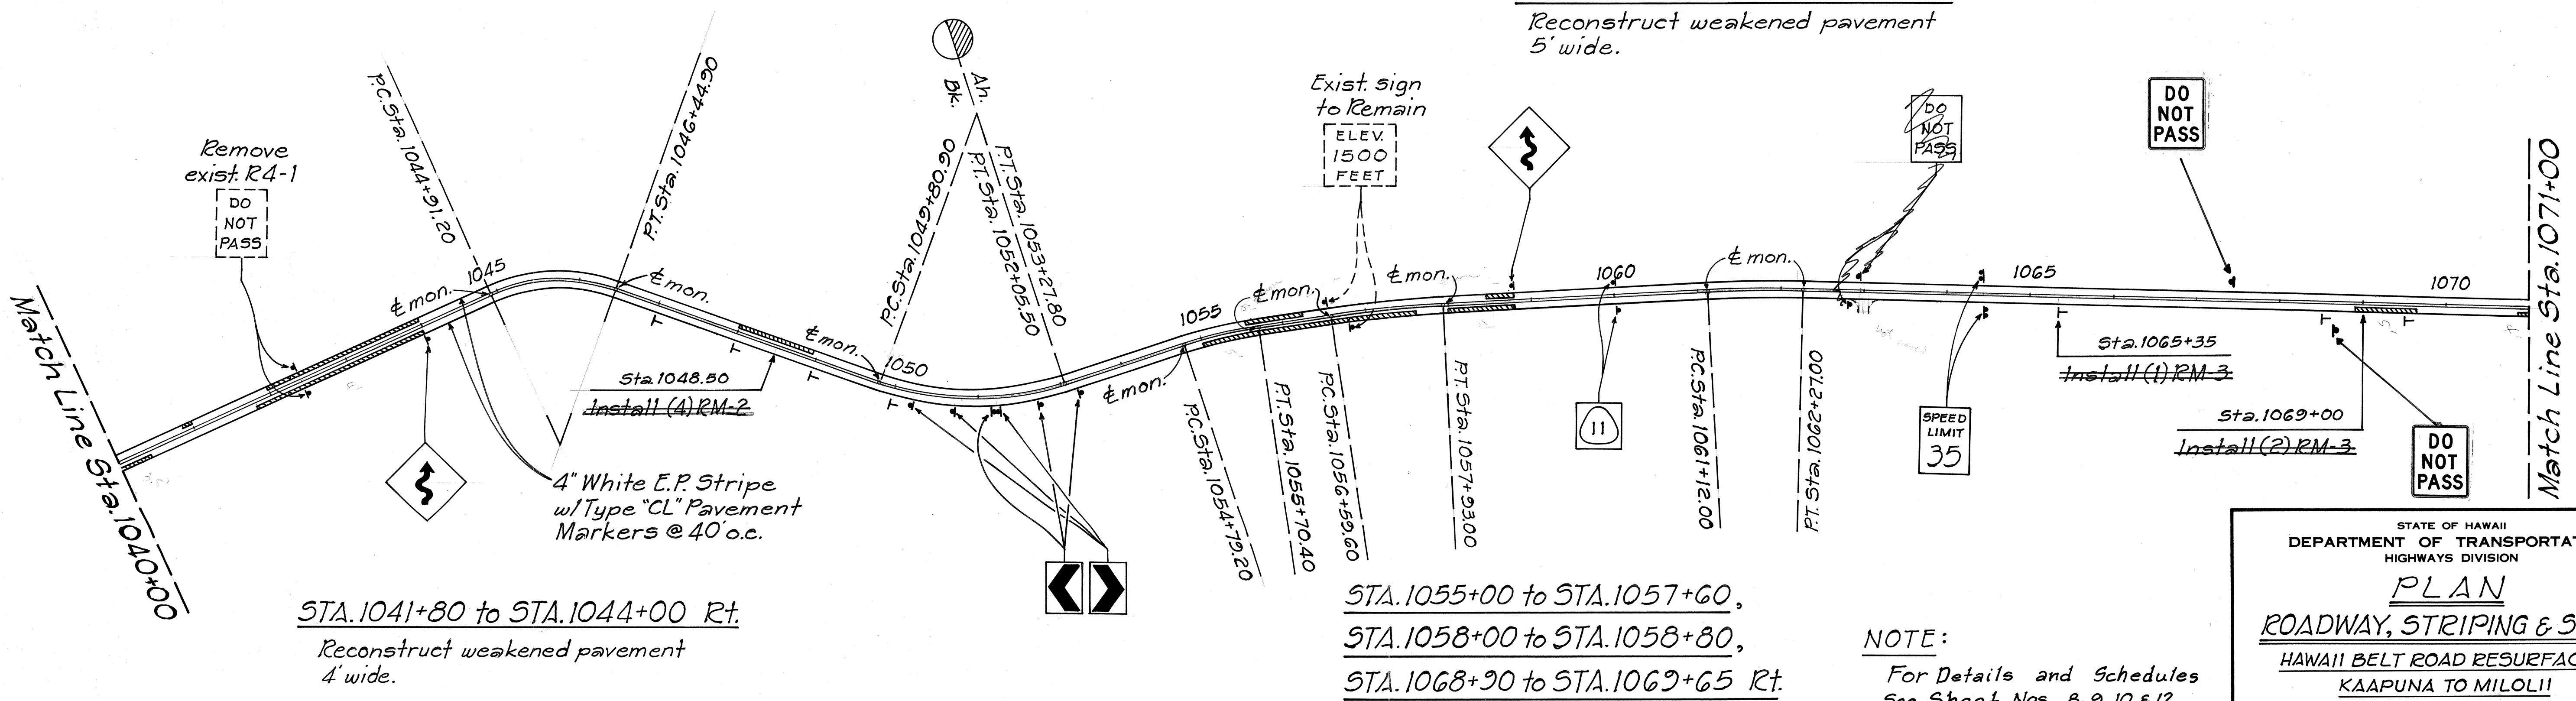

STA. 1041+80 to STA. 1044+00 Rt.  
 Reconstruct weakened pavement  
 4' wide.

STA. 1055+00 to STA. 1057+60,  
 STA. 1058+00 to STA. 1058+80,  
 STA. 1068+90 to STA. 1069+65 Rt.  
 Reconstruct weakened pavement  
 5' wide.

NOTE:  
 For Details and Schedules  
 See Sheet Nos. 8, 9, 10 & 12.  
 For RM-2 Installed  
 See Sheet No. 10.

STATE OF HAWAII  
DEPARTMENT OF TRANSPORTATION  
HIGHWAYS DIVISION

### PLAN

## ROADWAY, STRIPING & SIGNS

HAWAII BELT ROAD RESURFACING  
 KAAPUNA TO MILOLII  
 PROJ. No. 11C-01-92M  
 Scale: 1"=100'      Date: Jan., 1992

SHEET No. 3 OF 4 SHEETS

SURVEY PLOTTED BY	DATE
DRAWN BY	
DESIGNED BY	
CHECKED BY	
ORIGINAL PLAN	
NOTE BOOK	
NO.	

ORIGINAL PLAN	SURVEY PLOTTED BY _____	DATE _____
NOTE BOOK	DRAWN BY _____	_____
	TRACED BY _____	_____
	DESIGNED BY _____	_____
	QUANTITIES BY _____	_____
No. <u>1373</u>	CHECKED BY _____	_____

