



FED. ROAD DIST. NO.	STATE	PROJ. NO.	FISCAL YEAR	SHEET NO.	TOTAL SHEETS
HAWAII	HAW.	11BC-01-91	1991	17	25

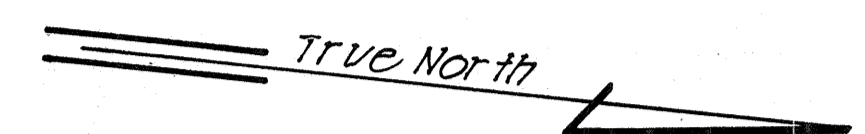


NOTE:
All Signs Removed shall be Returned to State Highways Division

PAVEMENT MARKING SUMMARY	
DESCRIPTION	QUANTITY
RAISED PAVEMENT MARKERS	
TYPE DL	55 EACH
TYPE DL	55 EACH
4" DOUBLE YELLOW PAVEMENT STRIPING	1,100 L.F.
4" WHITE EDGE STRIPING	8,000 L.F.

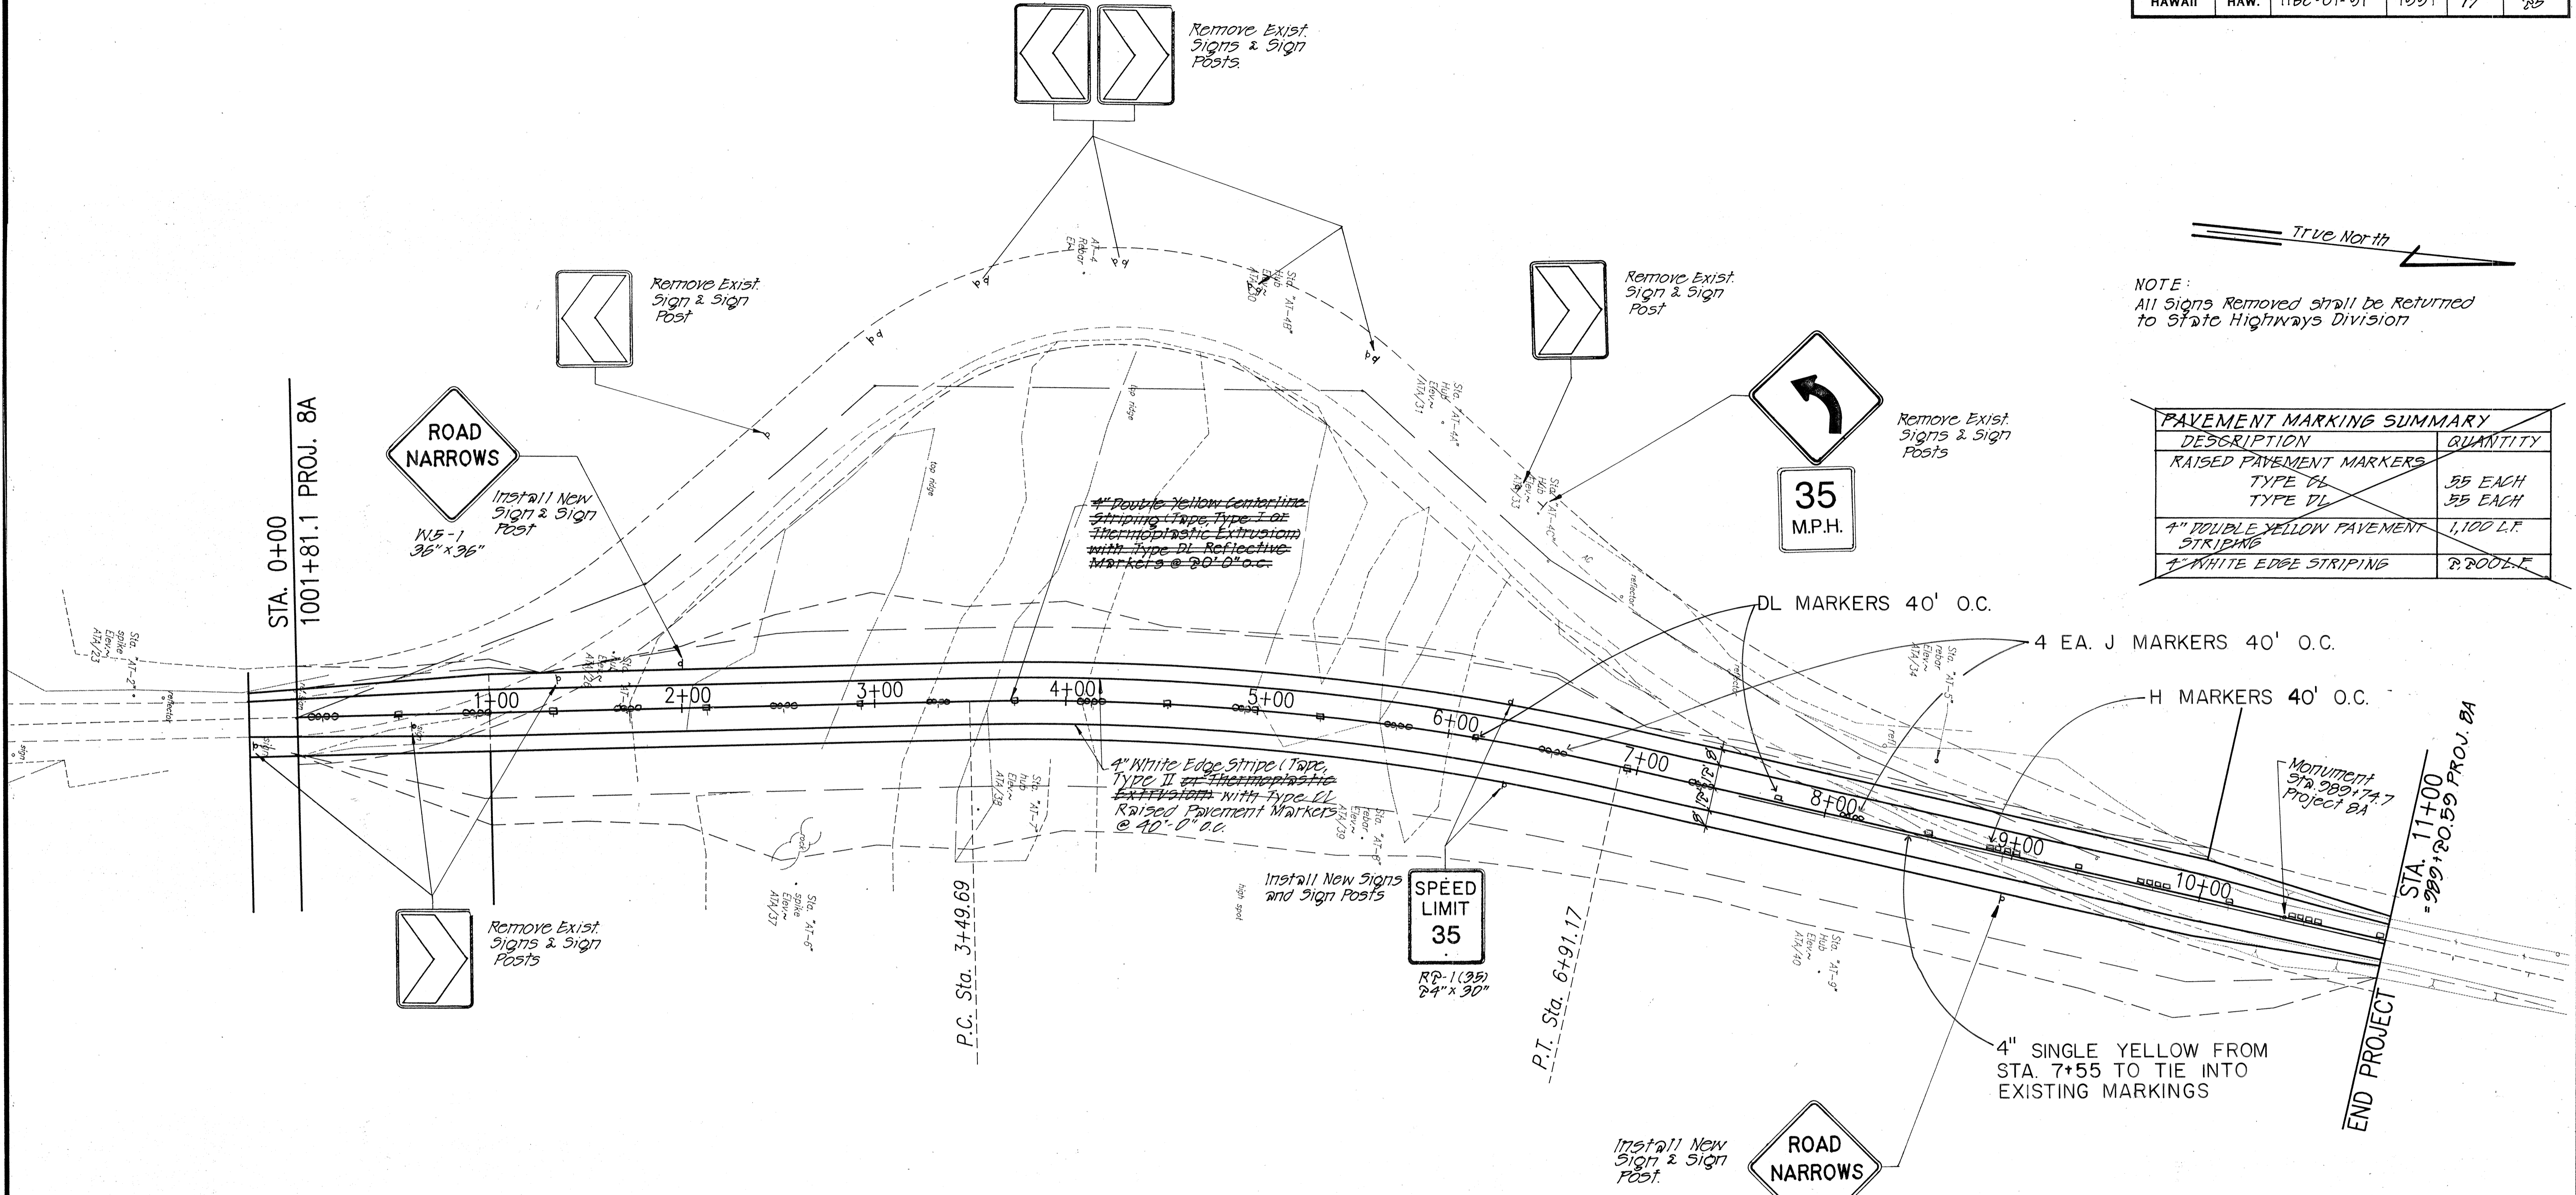

SIGNING AND STRIPING PLAN - SITE 2
Scale: 1" = 40'

ORIGINAL PLAN	DATE
DRAWN BY	
TRACED BY	
DESIGNED BY	
CHECKED BY	
CREATED BY	

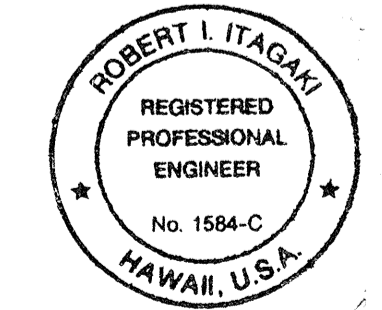

THIS WORK WAS PREPARED BY ME OR UNDER MY SUPERVISION.

STATE OF HAWAII
DEPARTMENT OF TRANSPORTATION
HIGHWAYS DIVISION

SIGNING & STRIPING PLAN
SITE 2

HAWAII BELT ROAD IMPROVEMENTS
PAPA TO HONAUNAU - UNIT 2
PROJECT NO. 11BC-01-91