



FED. ROAD DIST. NO.	STATE	PROJ. NO.	FISCAL YEAR	SHEET NO.	TOTAL SHEETS
HAWAII	HAW.	11BC-01-91	1991	22	25

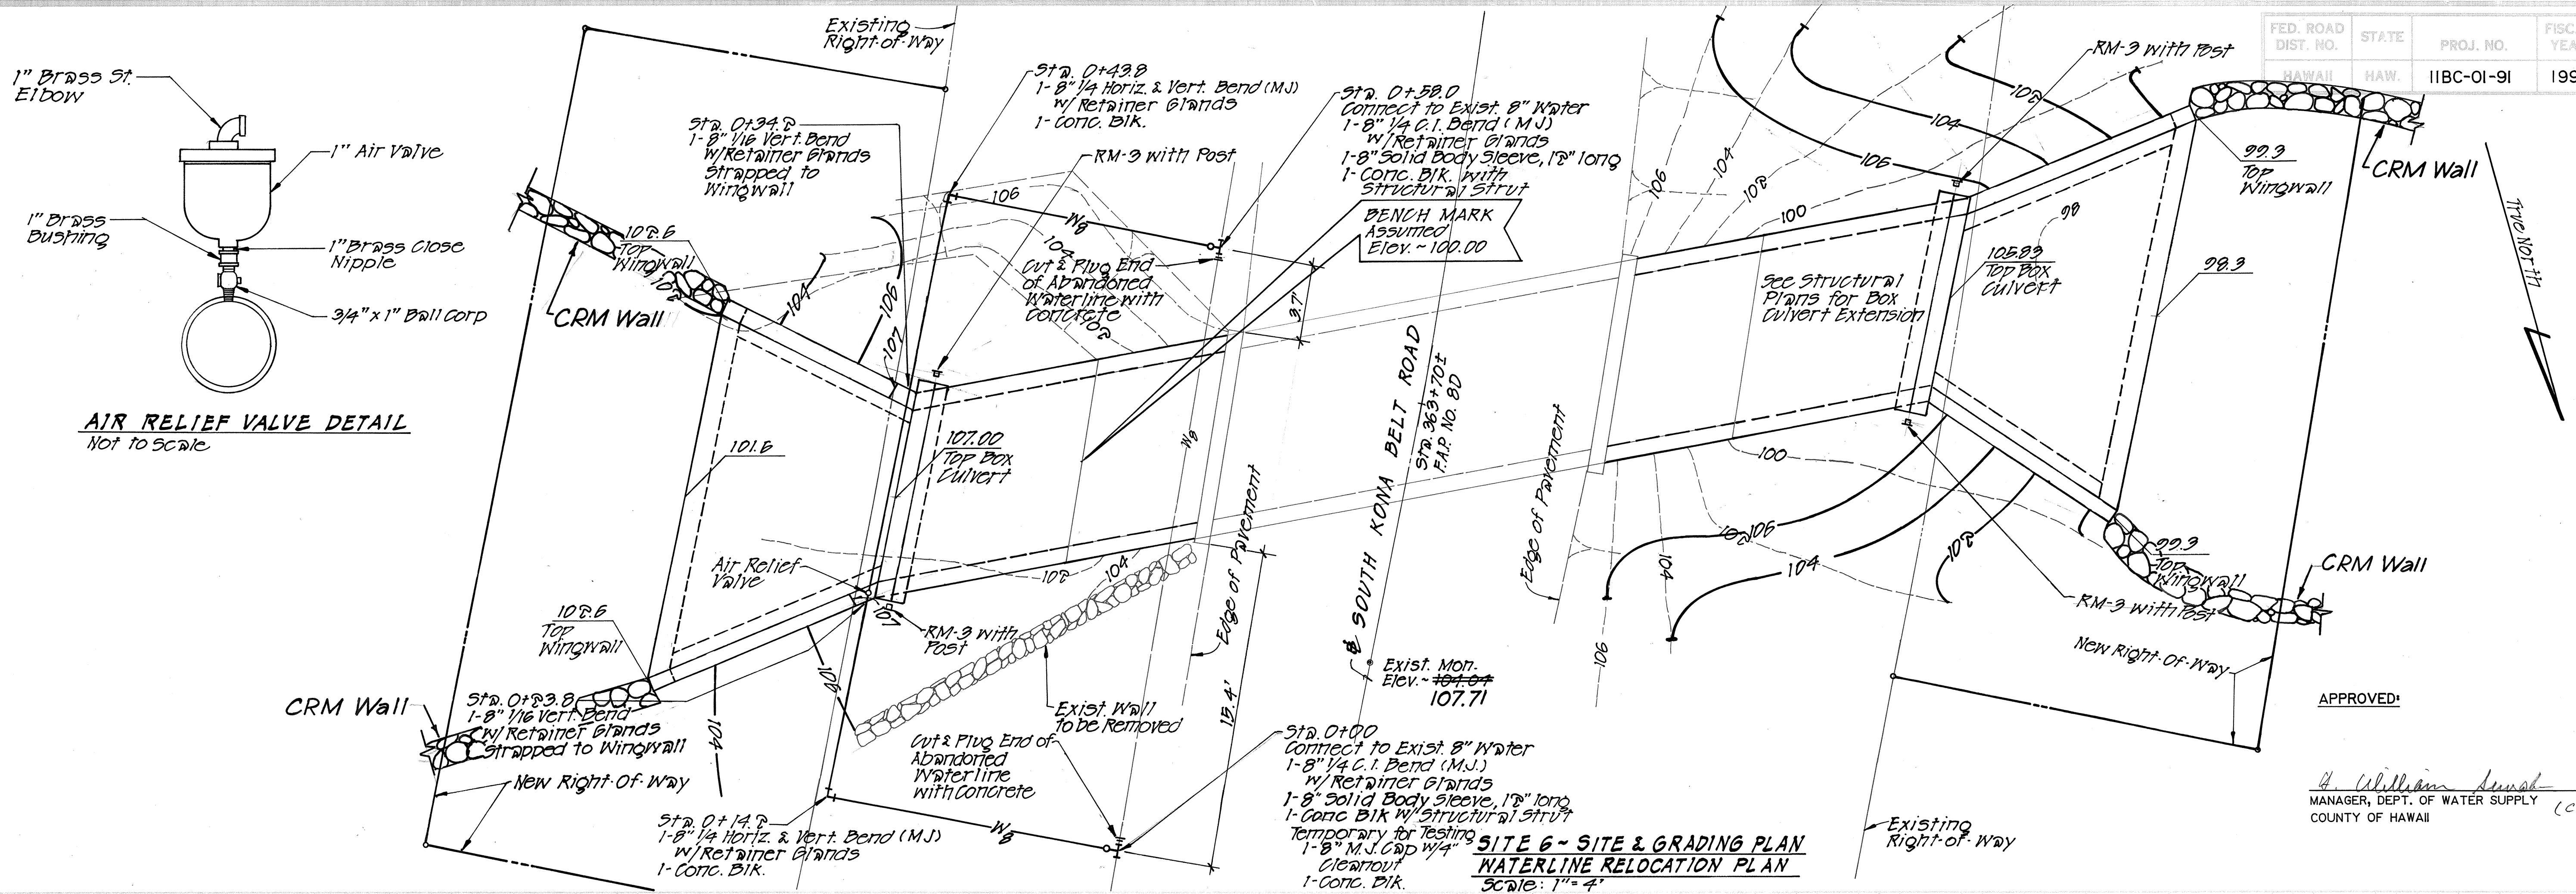

APPROVED:
H. Williams
 MANAGER, DEPT. OF WATER SUPPLY (C.S.) DATE 4/2/91
 COUNTY OF HAWAII

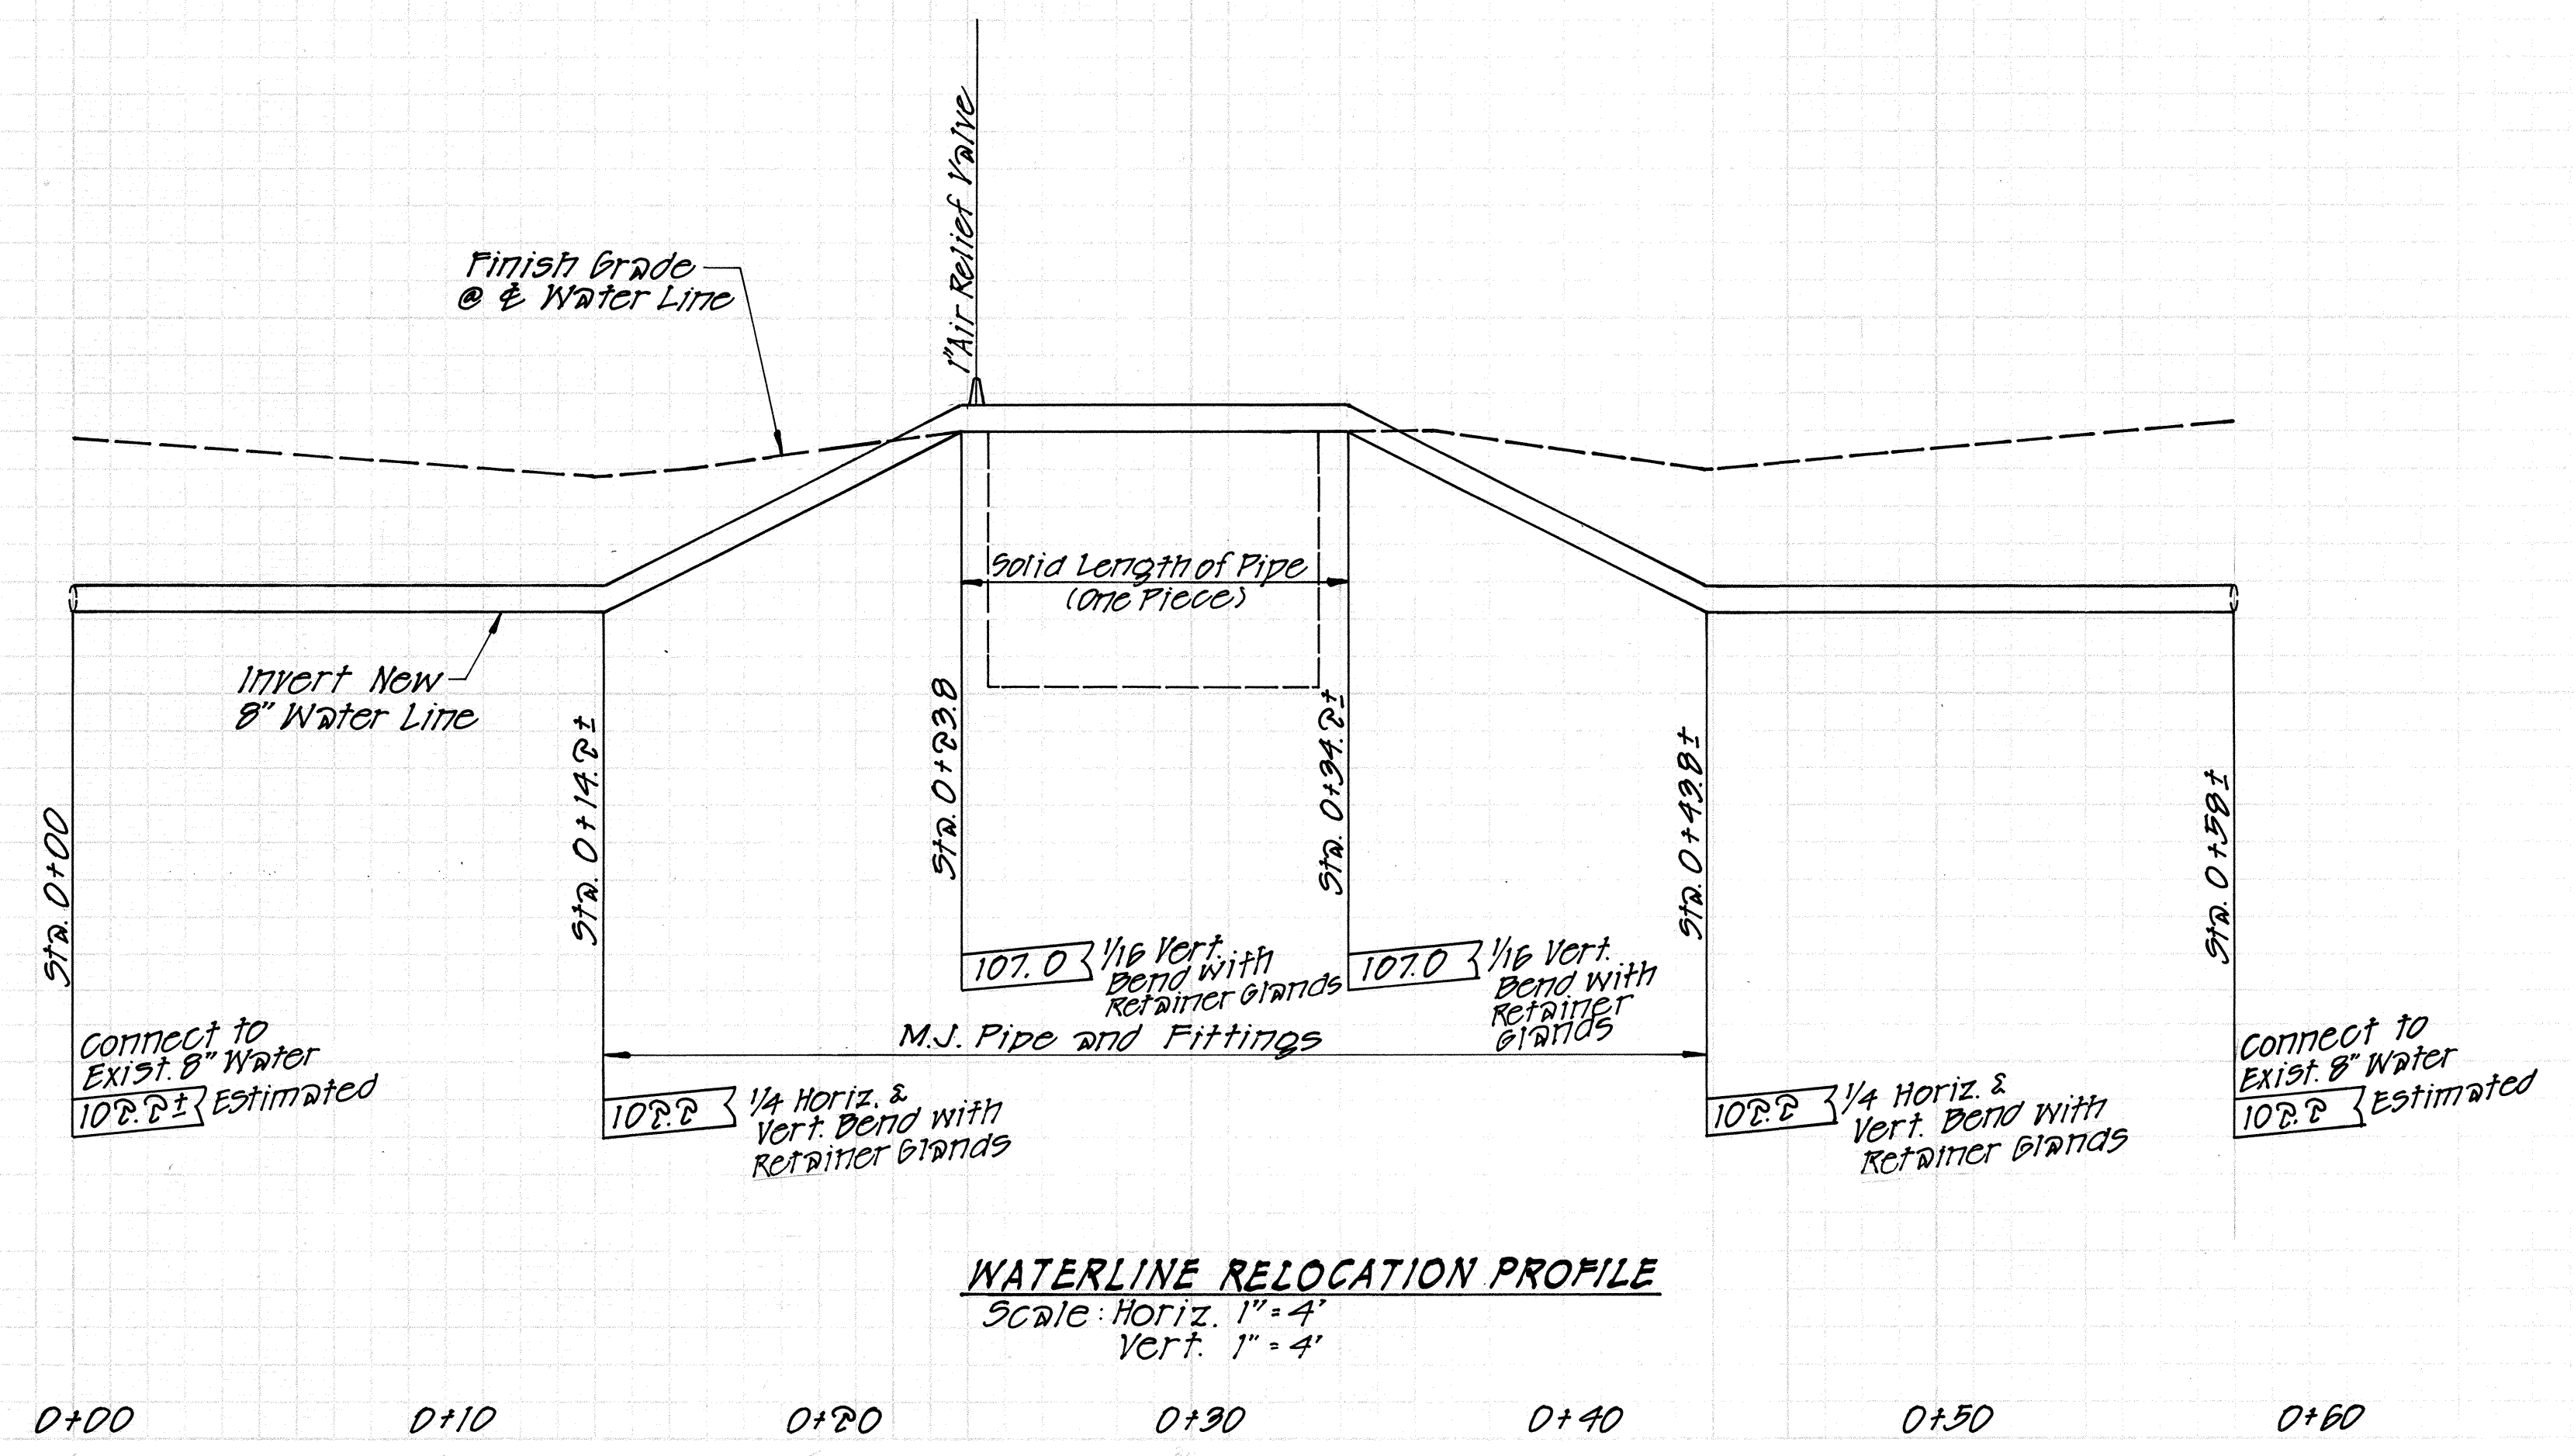

WATERLINE RELOCATION PROFILE
 Scale: Horiz. 1"=4'
 Vert. 1"=4'

ROBERT L. ITAGAKI
 REGISTERED PROFESSIONAL ENGINEER
 No. 1584-C
 HAWAII, U.S.A.
 THIS WORK WAS PREPARED BY ME OR UNDER MY SUPERVISION.