

INDEX TO DRAWINGS	
SHEET NO.	DESCRIPTION
1	TITLE SHEET
2	STANDARD PLAN SUMMARY
3	NOTES
4-5	SITE LOCATION PLAN
6	TYPICAL SECTION
7	SITE 1 PLAN & PROFILE
8	SITE 1 SUPERELEVATION DIAGRAM
① 9	SITE 1 GRADING PLAN
10	SITE 1 SIGNING & STRIPING PLAN
11-14	SITE 1 CROSS SECTIONS
15	SITE 2 PLAN & PROFILE
② 16	SITE 2 GRADING PLAN
17	SITE 2 SIGNING & STRIPING PLAN
18-21	SITE 2 CROSS SECTIONS
22	SITE 6 SITE & GRADING PLAN
	WATERLINE RELOCATION PLAN & PROFILE
23-24	SITE 6 BOX CULVERT EXTENSION
25	TRAFFIC CONTROL PLAN

Plan Sht. Nos. ①9 & ②C.O.16 are supplementary sheets to this project.
TOTAL SHEET COUNT after "AS-BUILT" postings.
27 Sheets.

STATE OF HAWAII
DEPARTMENT OF TRANSPORTATION
HIGHWAYS DIVISION
HONOLULU, HAWAII



"AS-BUILT"

CONSTRUCTION PLANS FOR

HAWAII BELT ROAD

IMPROVEMENTS

FROM PAPA TO HONAUNAU
UNIT 2
PROJECT NO. 11BC - 01 - 91
AT SOUTH KONA, ISLAND OF HAWAII

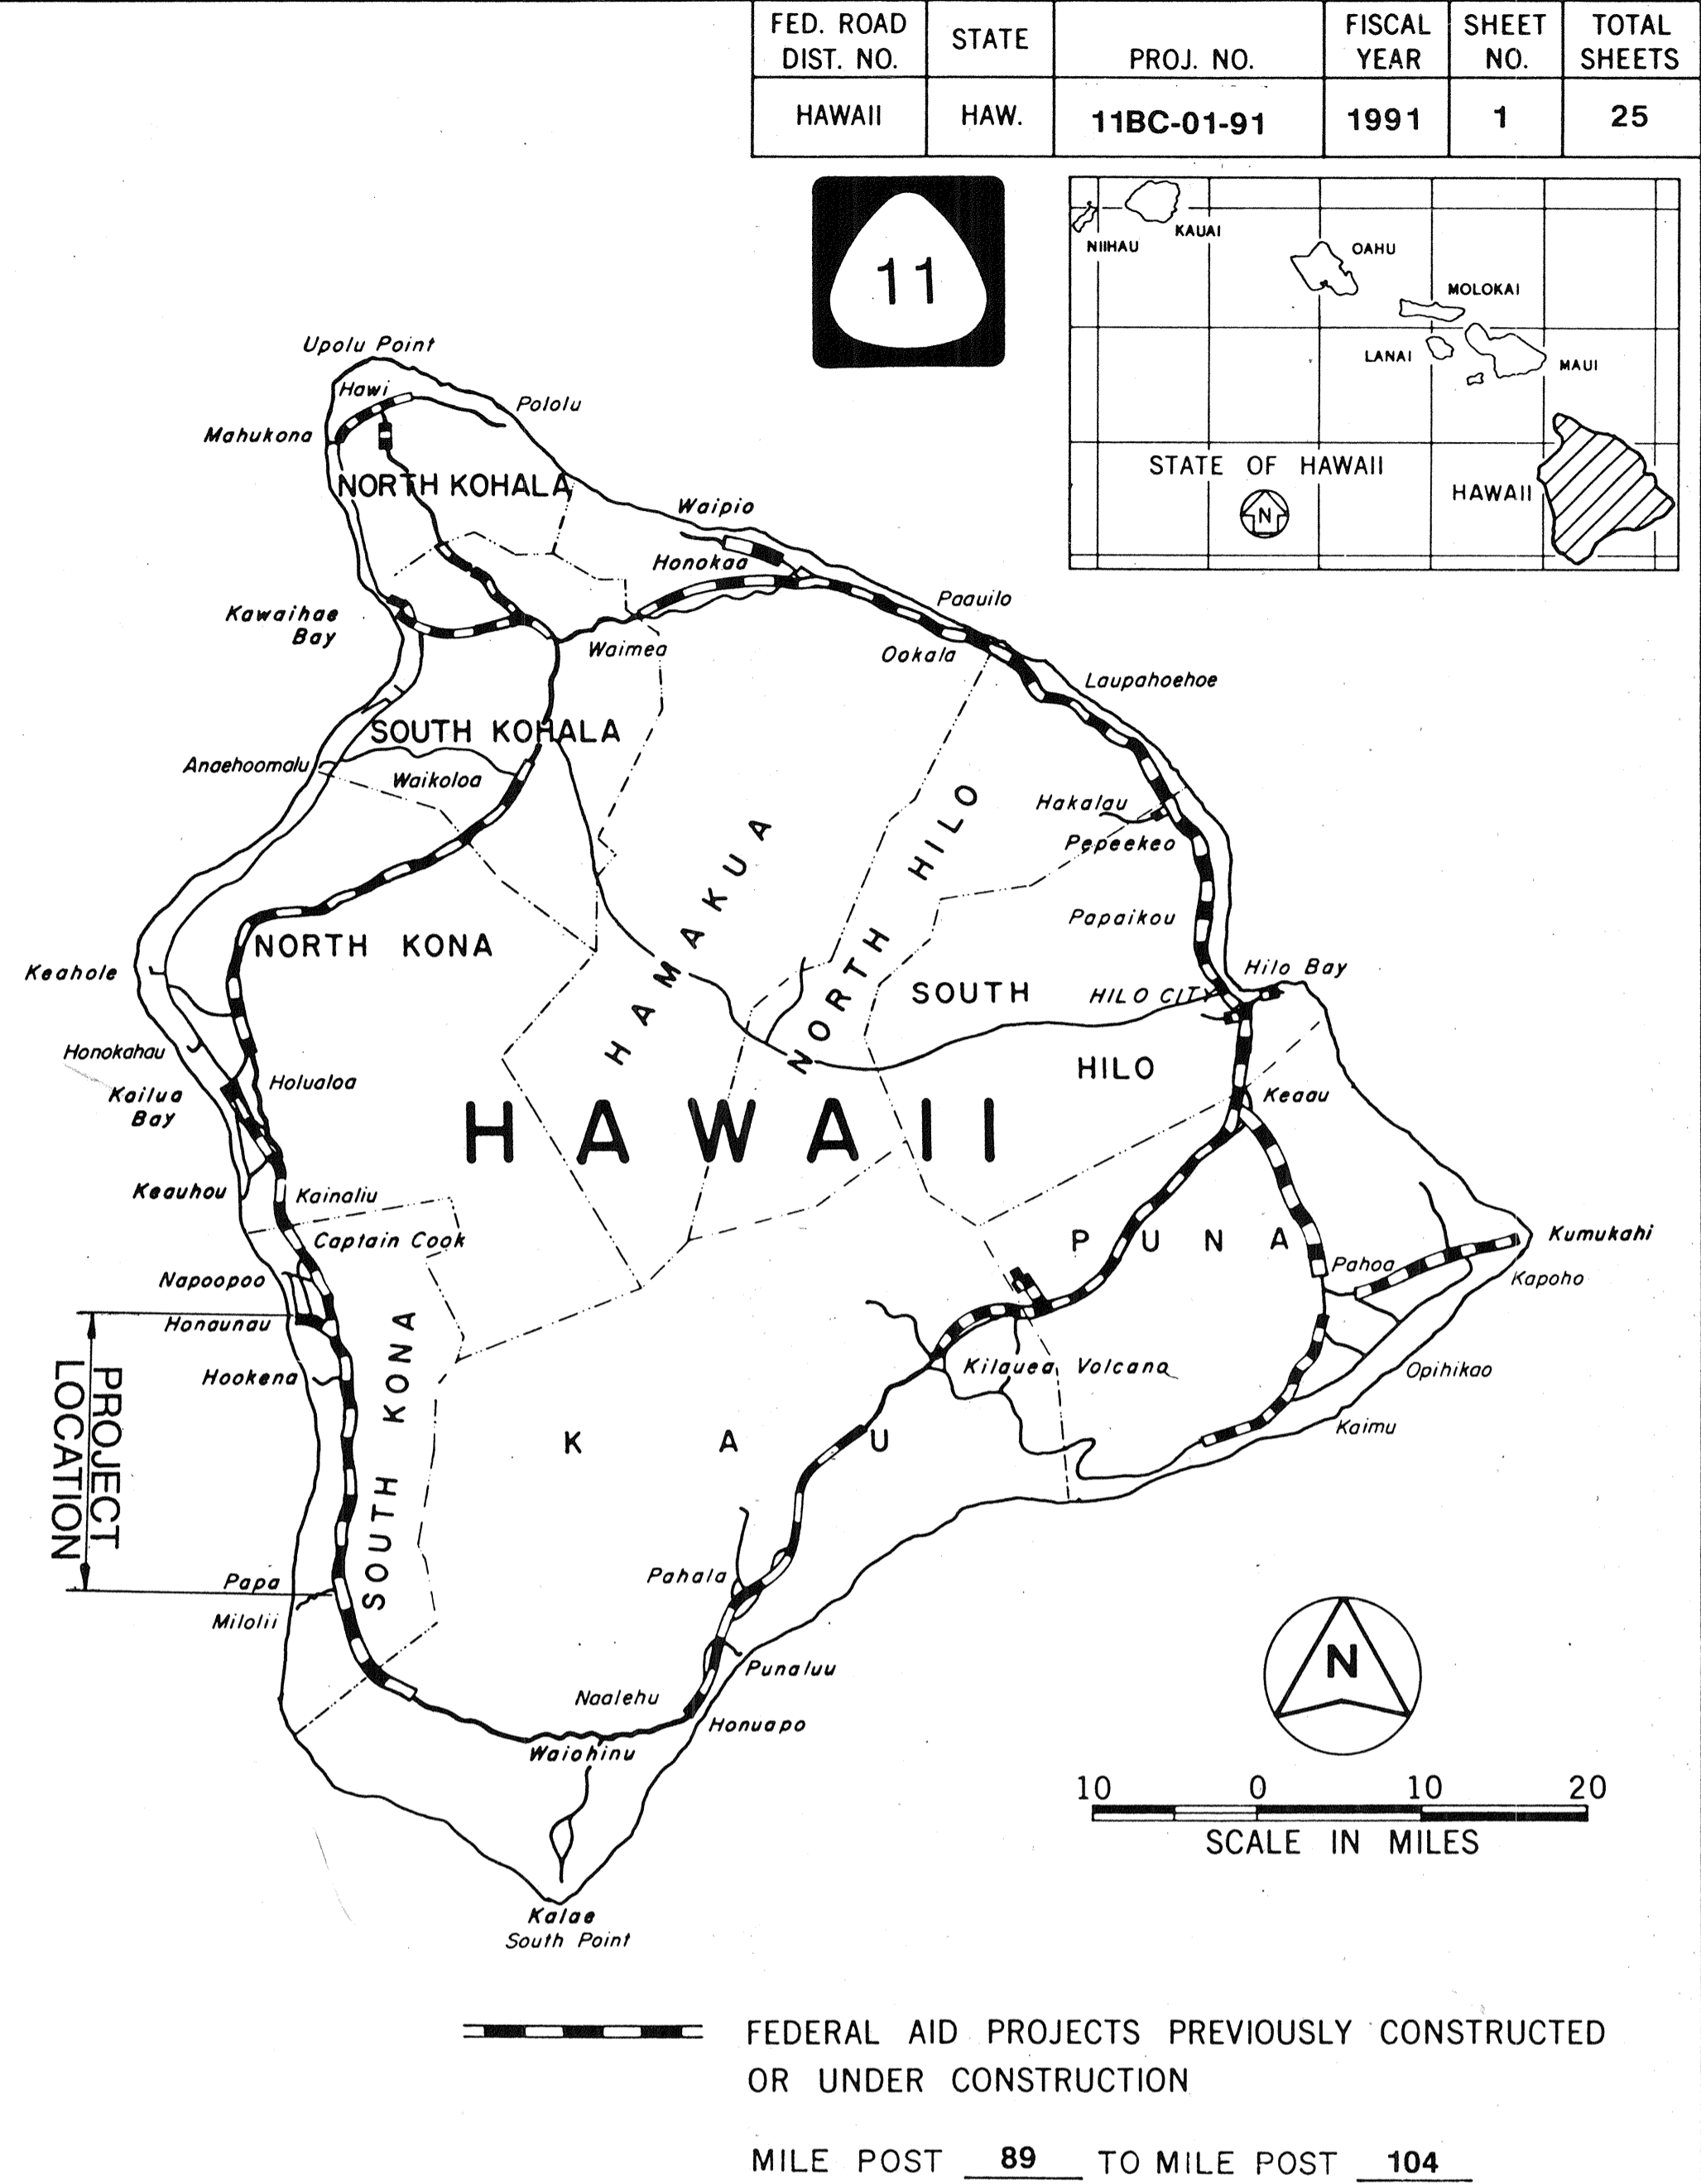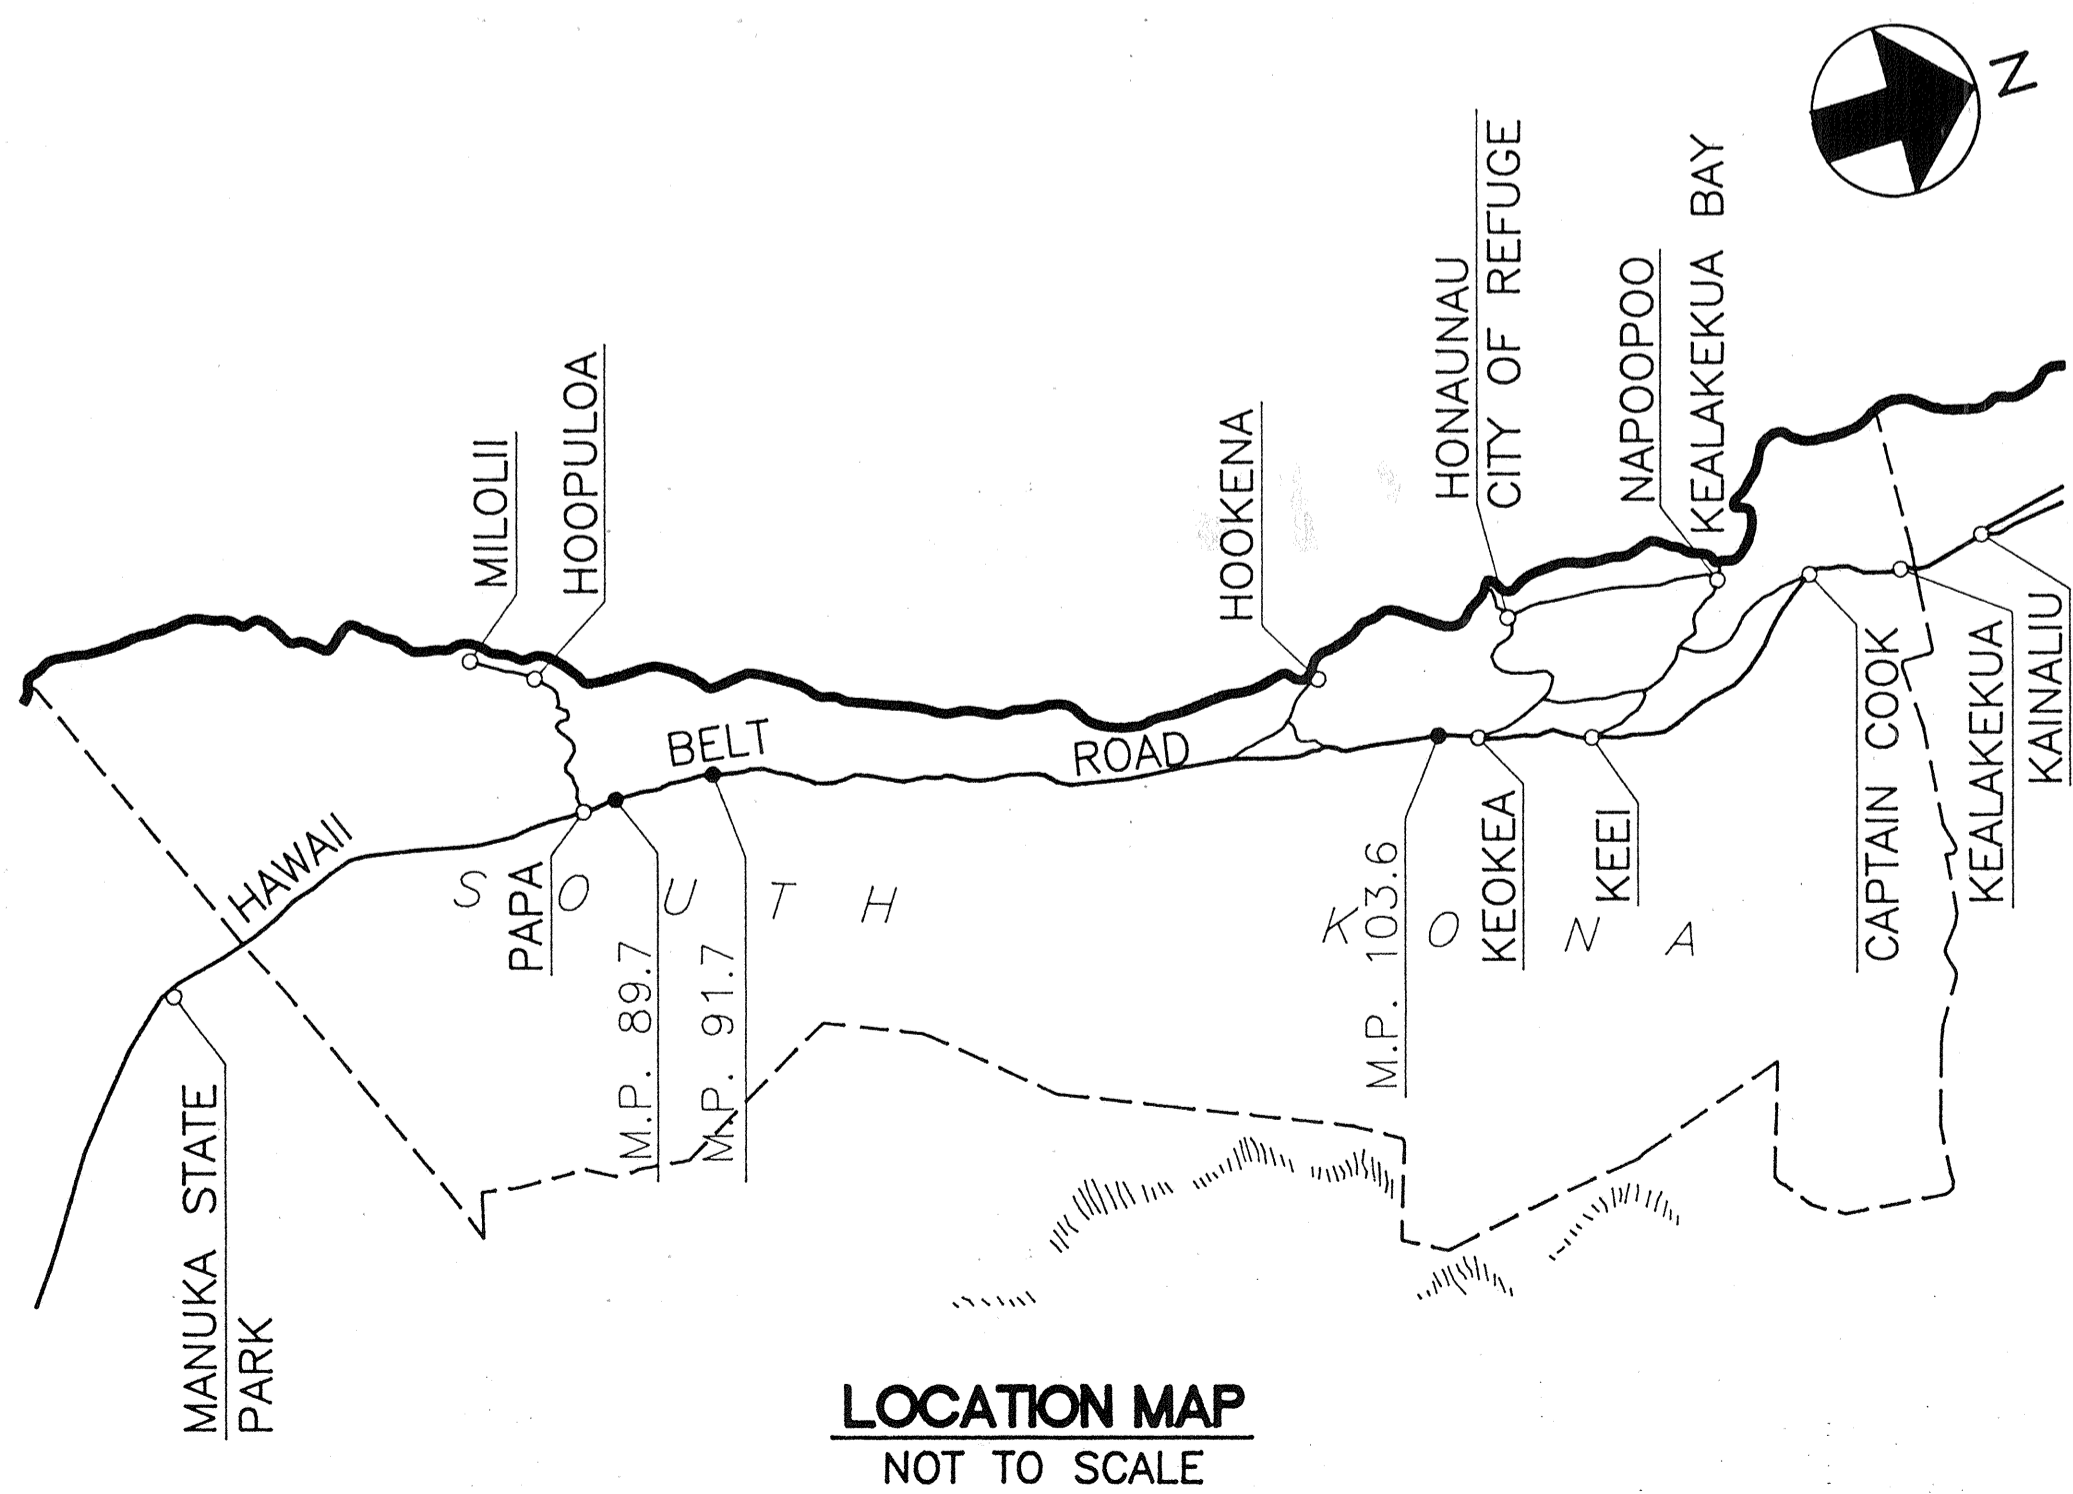

ALL CHANGES MADE DURING CONSTRUCTION HAVE BEEN NOTED IN RED ON THESE TRACINGS AND CHECKED BY

Harold Kagan 10-28-96
RESIDENT ENGINEER DATE

DEPARTMENT OF TRANSPORTATION
STATE OF HAWAII

APPROVED:

Edward J. [Signature] 8/28/91
DIR. OF TRANSPORTATION DATE

Engineers Surveyors Hawaii, Inc. Lincoln Char P. S. & E. BY
DESIGNED BY
548-7532 PHONE
8/28/91 DATE

A-4-2