

FED. ROAD DIST. NO.	STATE	PROJ. NO.	FISCAL YEAR	SHEET NO.	TOTAL SHEETS
HAWAII	HAW.	11N-01-91M	1991	5	23

CENTER LINE & REFERENCE SURVEY MONUMENT
& STREET SURVEY MONUMENT SCHEDULE

STATION	TYPE	Ø OFFSET (Ft.)	EXIST. DEPTH (Ft.)	REMARKS
P.O.T.1124+00.00	Ø Mon.	0	0.26	Reconstruct
P.C.1145+38.34	Ø Mon.	0.20 Rt.	0.10	Ad just
P.T.1148+15.51	Ø Mon.	0	0.10	Ad just
P.C.1170+16.13	Ø Mon.	0.22 Rt.	0.13	Ad just
P.T.1174+22.80	Ø Mon.	0.15 Lt.	0.12	Ad just
Ø Int. 1177+98.00	St. Surv. Mon.	0.7 Rt.	0	Reconstruct
P.O.T.1180+00.00	Ø Mon.	0	0.13	Ad just
P.O.T.1201+00.00	Ø Mon.	0	0.12	Ad just
Ø Int. 1224+81.00	St. Surv. Mon.	1.7 Lt.	0	Reconstruct
P.O.T.1228+00.00	Ø Mon.	0	0.12	Ad just
P.C.1243+38.90	Ø Mon.	0	0.12	Ad just
P.C.C.1251+00.00	Ø Mon.	0.3 Rt.	0.10	Ad just
P.C.C.1256+00.69= P.C.C.1256+00.00	Ø Mon.	0	0.10	Ad just
P.T.1271+45.33= P.T.1271+41.99	Ø Mon.	0	0.10	Ad just

WATER VALVE BOX
SCHEDULE

STATION	OFFSET	TYPE
1274+62 1213+95	15.5 21.0 Lt	wv
1224+91	17.2 Lt	wv
1224+94	15.4 Lt	wv
1224+94	20.2 Lt	wv
1224+97	17.2 Lt	wv
1236+28	18.0 Lt	wv
1236+22	18.0 Lt	wv
1254+77	19.8 Rt	wv
1254+80	16.4 Rt	wv
1254+86	41.2 Rt	wv
1254+90	19.4 Rt	wv
1218+55.5	20.0 Lt	mh
1218+60	20.0 Lt	w v

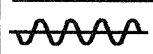
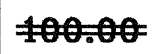
SURVEY PLOTTED BY	DATE
DESIGNED BY	
TRACED BY	
DESIGNED BY	
QUANTITIES BY	
CHECKED BY	

ORIGINAL PLAN

NOTE BOOK

N.

LEGEND FOR
AS-BUILT POSTINGS

	Squiggly line for as-built deletion
	Double line for as-built deletion
Roadway	Text for as-built posting

STATE OF HAWAII
DEPARTMENT OF TRANSPORTATION
HIGHWAYS DIVISION

MISCELLANEOUS SCHEDULES

VOLCANO RD. RESURFACING-OUTBOUND LANES
Slaughterhouse Road to Panaewa Bridge
Proj. No. 11N-01-91M

Scale: As Shown Date: Oct., 1990

SHEET No. 1 OF 1 SHEETS