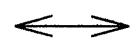


TRAFFIC SIGN SUMMARY					
SIGN NO.	MESSAGE	QUANTITY			
		10 SQ. FT. OR LESS		GREATER THAN 10 SQ. FT.	
		W/POST	W/O POST	W/POST	W/O POST
R1-1-A 36"x36"	STOP	19	1		
R1-2-A 48"x48"x48"	YEILD	2			
R2-1(55) 36"x48"	SPEED LIMIT 55			10	
R3-3 36"x36"	NO TURNS		1		
R3-40			1		
R4-3 36"x48"	SLOWER TRAFFIC KEEP RIGHT			3	
R4-7-A 36"x48"	KEEP RIGHT			2	
R5-1 36"x36"	DO NOT ENTER	7			
R6-1(L)	ONE WAY	7			
R6-1(R)	ONE WAY	6			
R7-1-A 24"x36"	NO PARKING ANY TIME 	26	6		
W2-1 36"x36"		5 10			
W2-2 36"x36"		3 4			
W4-1(R) 36"x36"	MERGE	2			
W4-2 36"x36"		1			
	TOTAL	78 89	9	15	

CONSTRUCTION SIGN SUMMARY				
SIGN NO.	LOCATION	MESSAGE	W/POSTS	W/O POST
CG20-2	Sta 1109+00 Lt. & Rt.	END CONSTRUCTION	2	
CW20-1d	Sta 1282+75 Lt. & Rt. 1254+00 Rt.	ROAD CONSTRUCTION AHEAD	2	
3 00 TOTAL			4	

ROUTE MARKER SUMMARY			
SIGN ASSEMBLY	LOCATION	QUANTITY	
		W/POST	W/O POST
M1-6(11)	Sta 1188+90 Lt.	1	
M1-6(11)	Sta 1264+90 Lt.	1	
TOTAL		2	

<u>LEGEND FOR</u>	
<u>AS-BUILT POSTINGS</u>	
	Squiggly line for as-built deletion
	Double line for as-built deletion
Roadway	Text for as-built posting

ORIGINAL PLAN	SURVEY PLOTTED BY _____ DATE _____	
	DRAWN BY <u>χ</u>	_____
NOTE BOOK	TRACED BY _____	_____
	DESIGNED BY <u>χ</u>	_____
	QUANTITIES BY _____	_____
	CHECKED BY _____	_____
Vrsumdgn		Nr. _____