	INDEX TO DRAWINGS
SHEET NO.	DESCRIPTION
	TITLE SHEET
2	STANDARD PLAN SUMMARY SHEET
3	GENERAL NOTES AND LEGEND
4	TYPICAL SECTIONS AND DETAILS
5	MISCELLANEOUS SCHEDULES
6 - 13	ROADWAY PLANS
14	PAVEMENT MARKING LEGEND,
	DETAILS & NOTES
15-22	SIGNING AND PAVEMENT MARKING
	PLANS
23	MISCELLANEOUS SUMMARIES

STATE OF HAWAII


DEPARTMENT OF TRANSPORTATION


HIGHWAYS DIVISION
HONOLULU, HAWAII
"AS-BUILT"
PLANS FOR

VOLCANO ROAD RESURFACING

OUTBOUND LANES
SLAUGHTER HOUSE ROAD TO PANAEWA BRIDGE
PROJECT NO. IIN-01-91M

DISTRICTS OF PUNA & SOUTH HILO ISLAND OF HAWAII

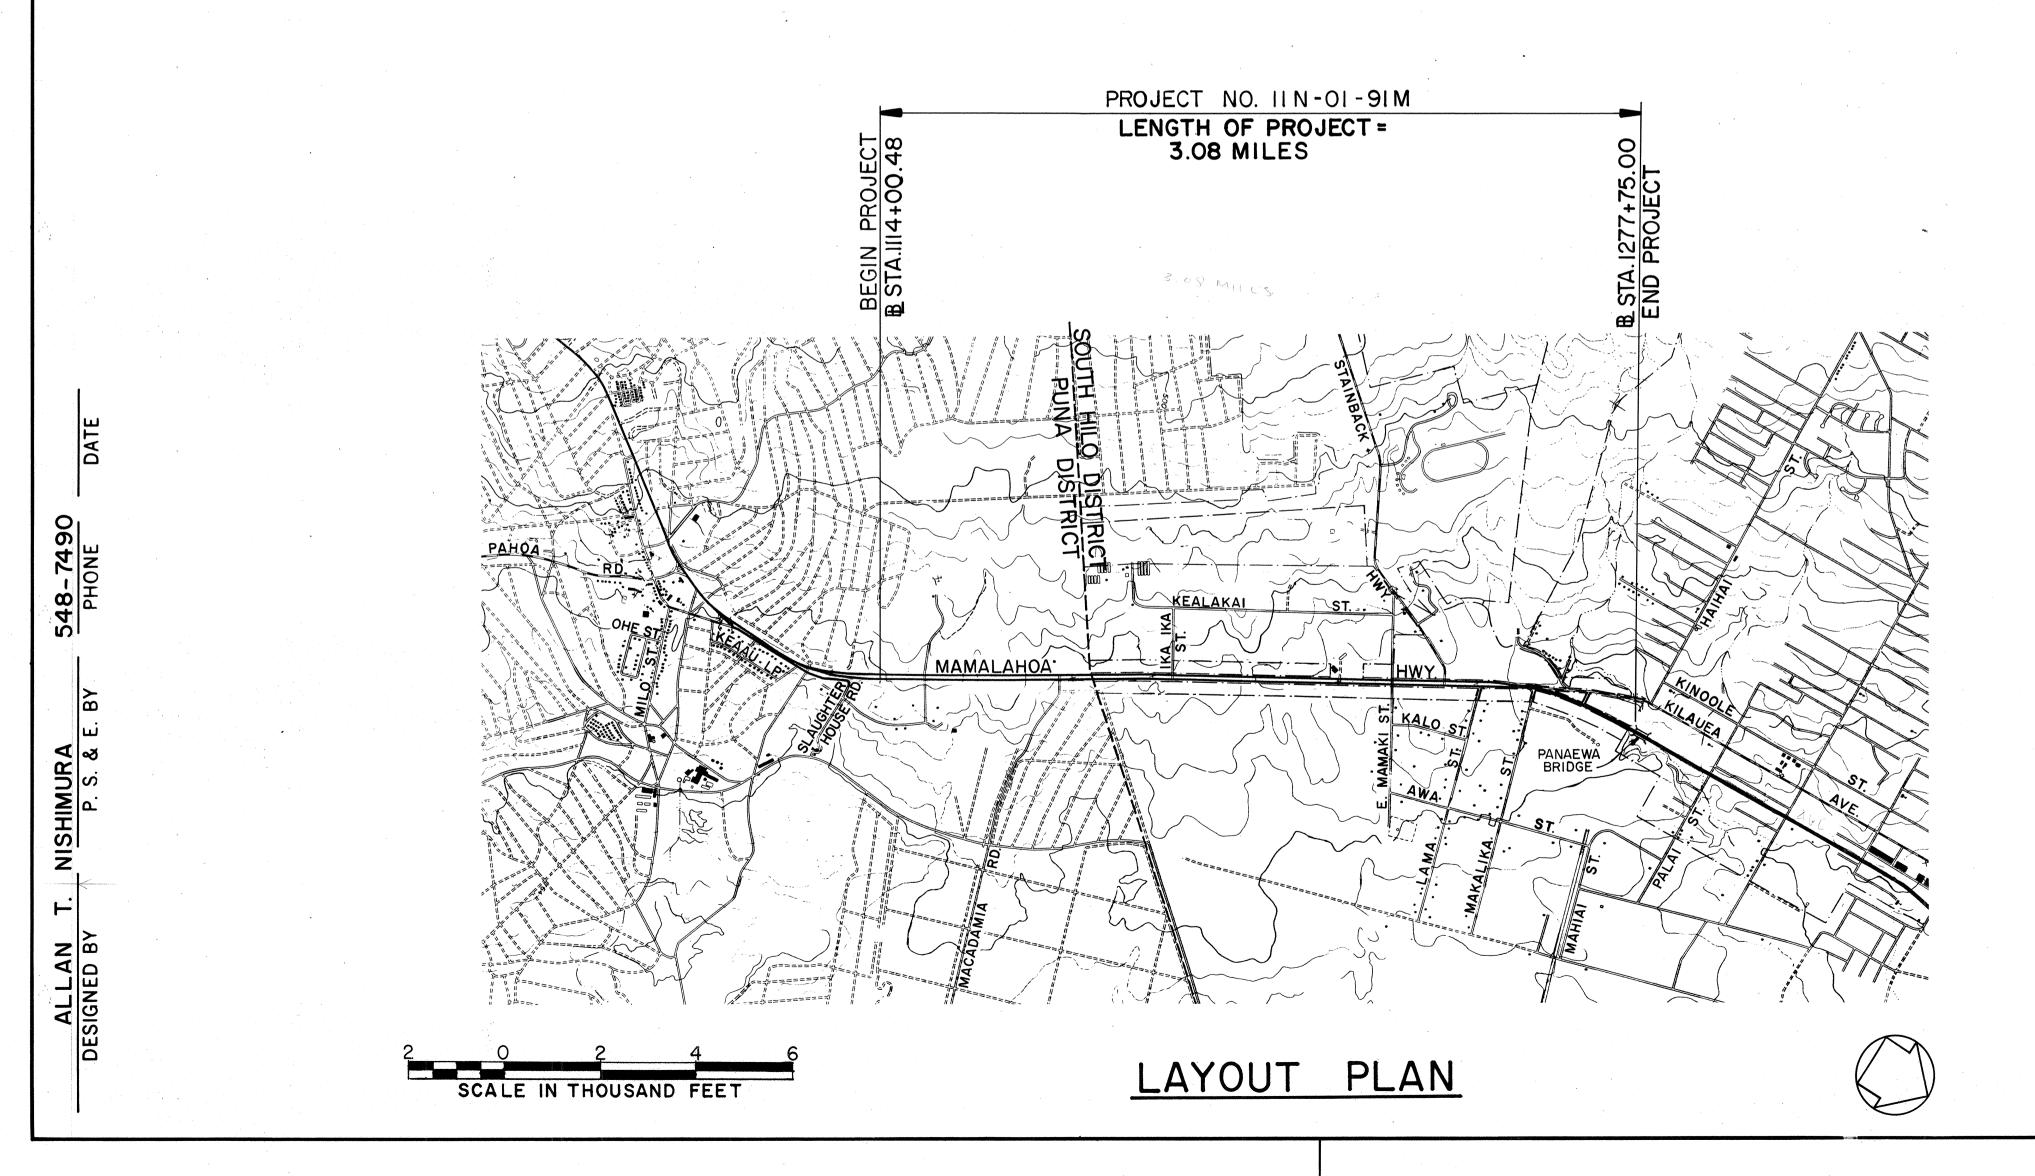

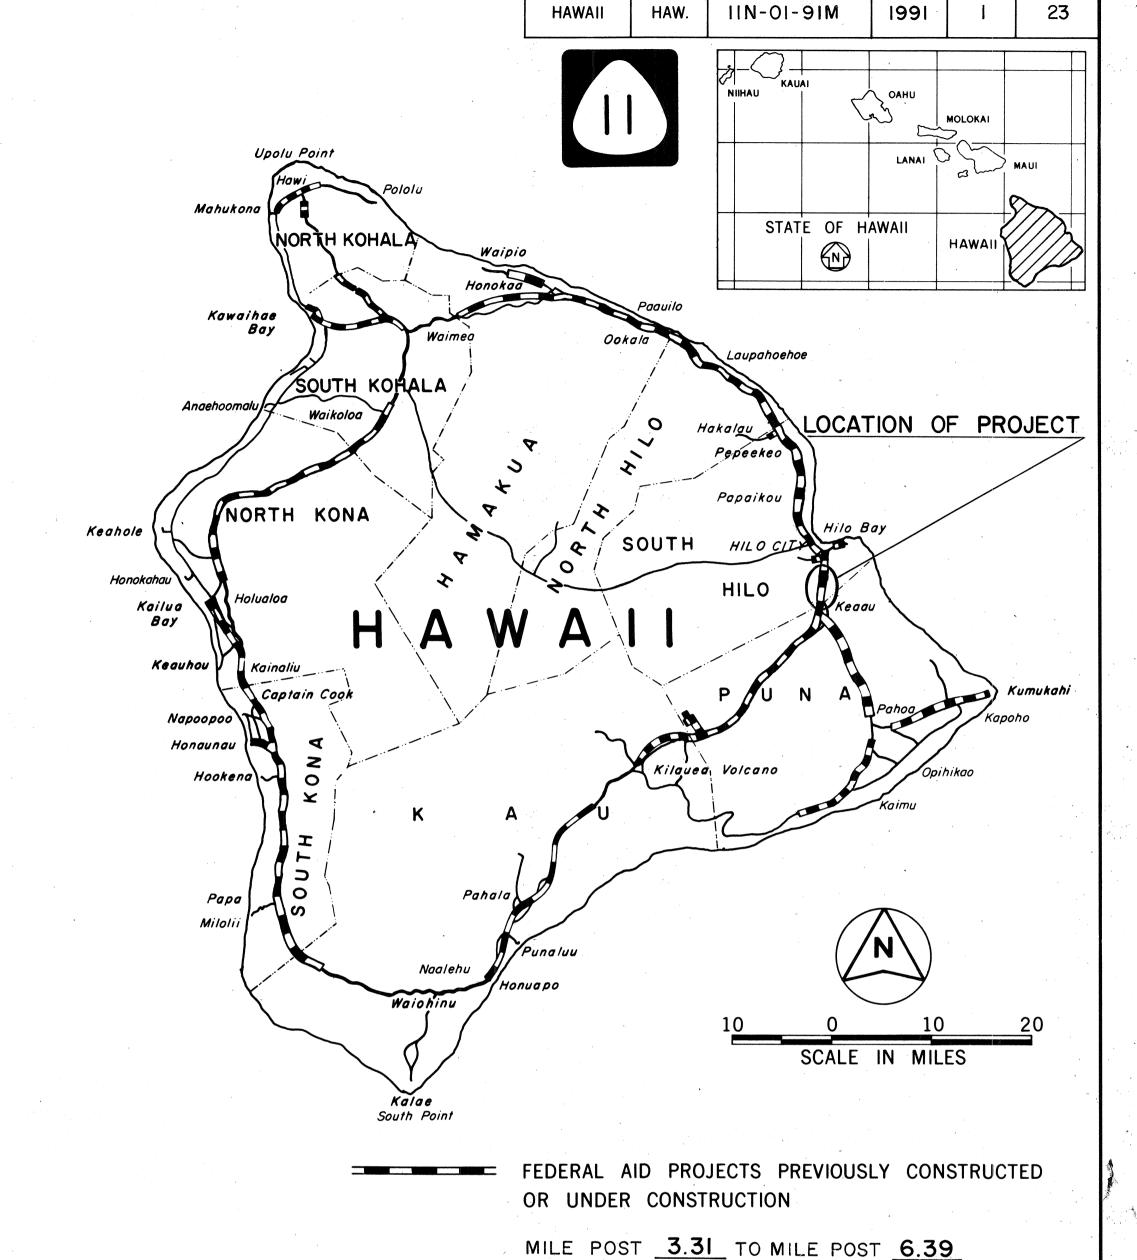

FED. ROAD DIST. NO.

STATE

PROJ. NO.

CHANGES MADE DURING CONSTRUCTION HAVE BEEN INCORPORATED ON THESE PLANS EXCEPT CHANGES IN THE ORIGINAL THEORETICAL QUANTITIES. FOR ACTUAL QUANTITIES, REFER TO PROJECT LEDGER AND/OR COMPUTATION BOOK.

RESIDENT ENGINEER DATE

DEPARTMENT OF TRANSPORTATION
STATE OF HAWAII

APPROVED:

Slog
DIR. OF TRANSPORTATION
DATE

FISCAL SHEET TOTAL YEAR NO. SHEETS