

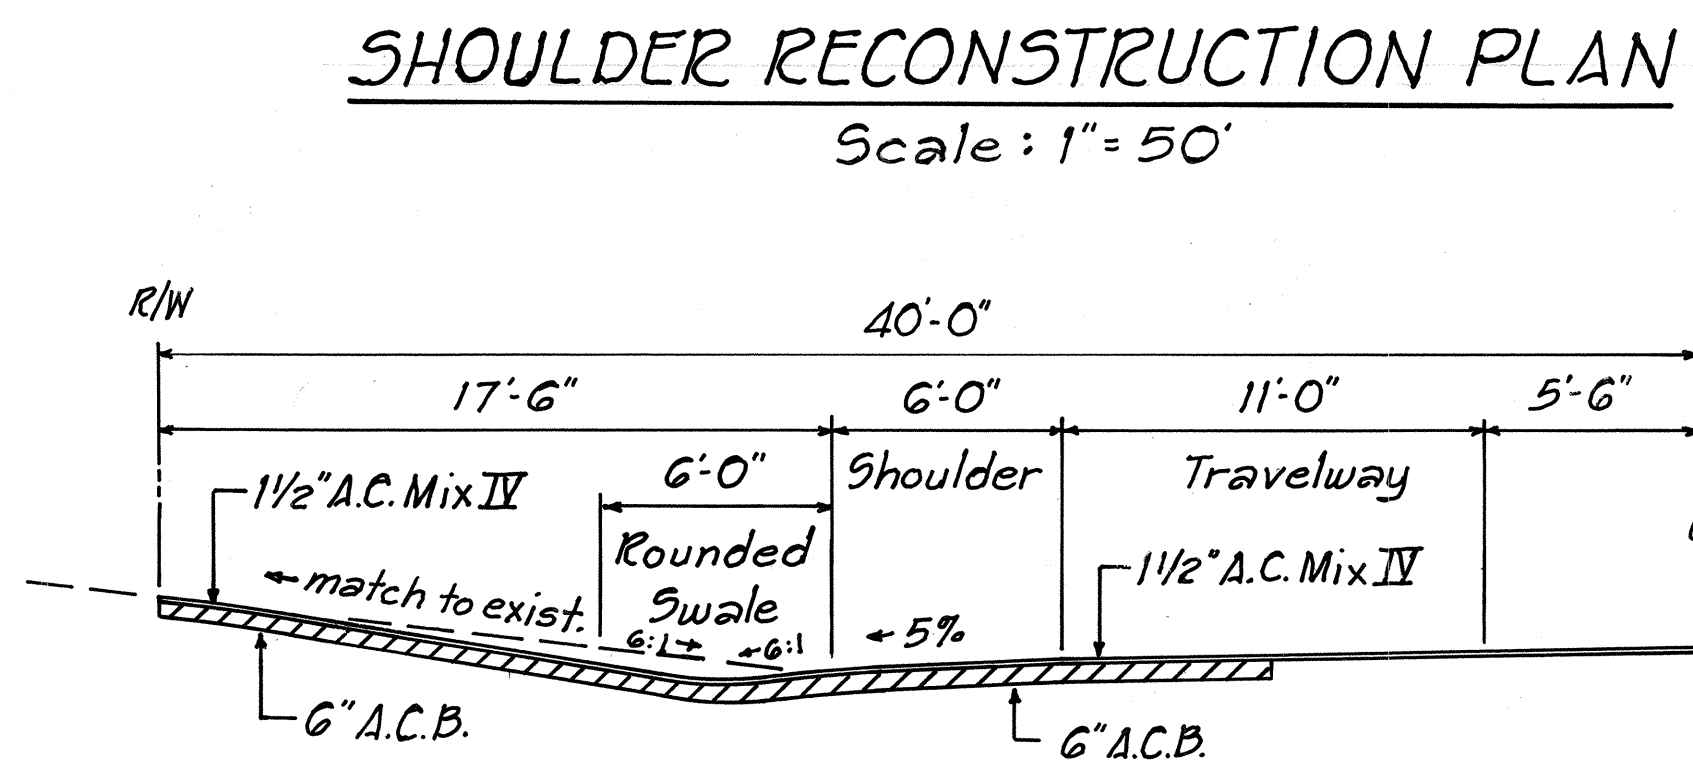
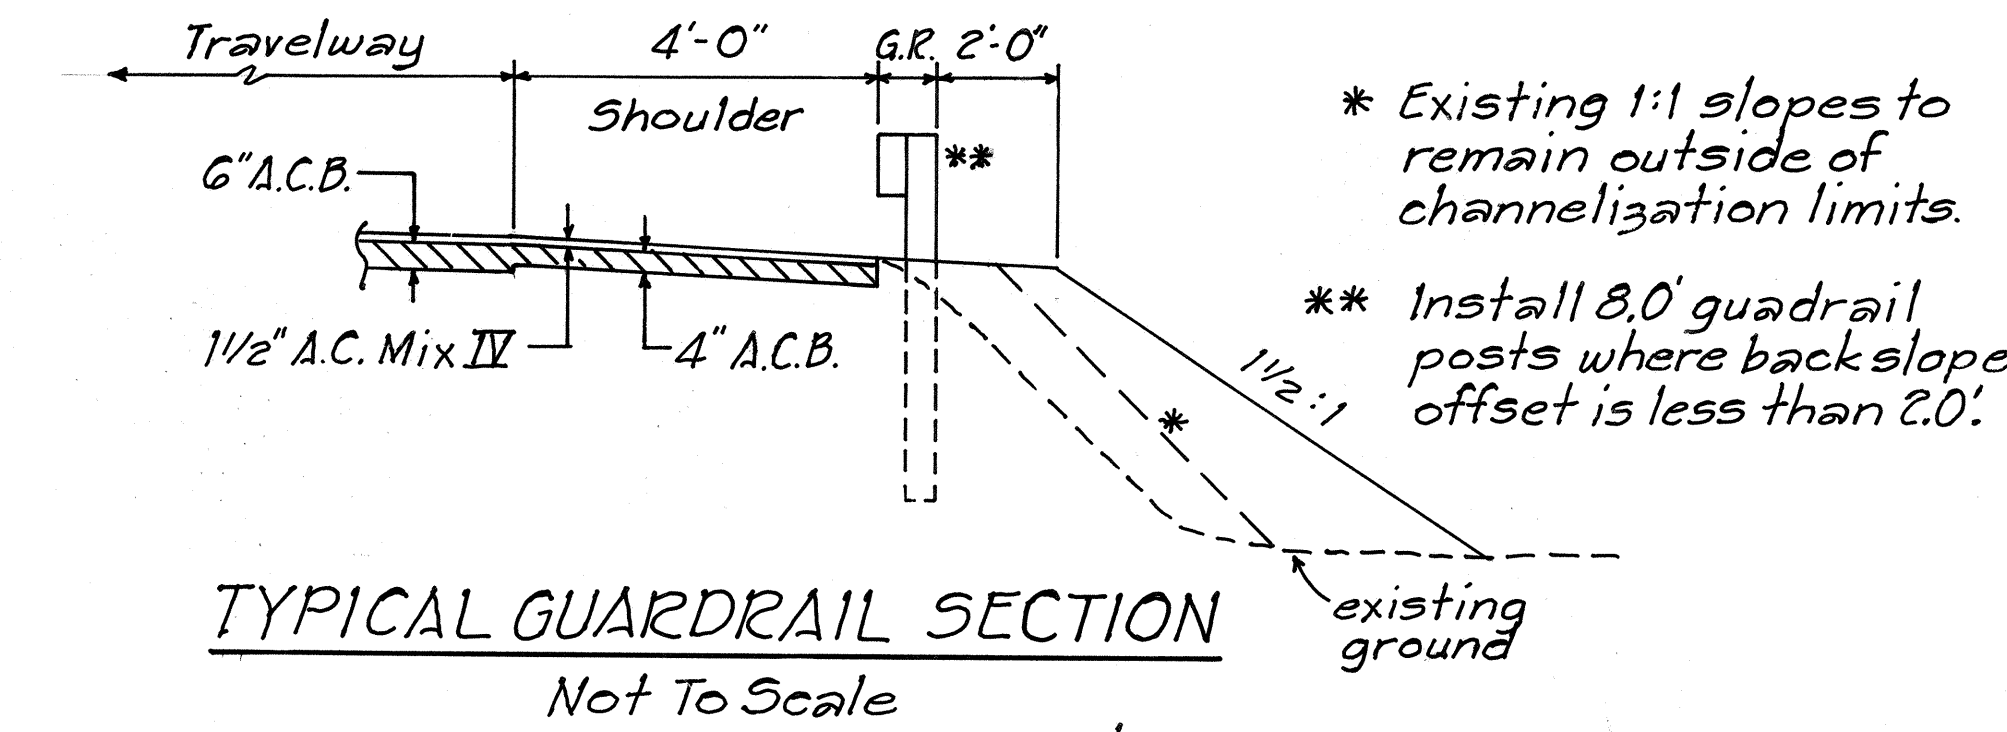
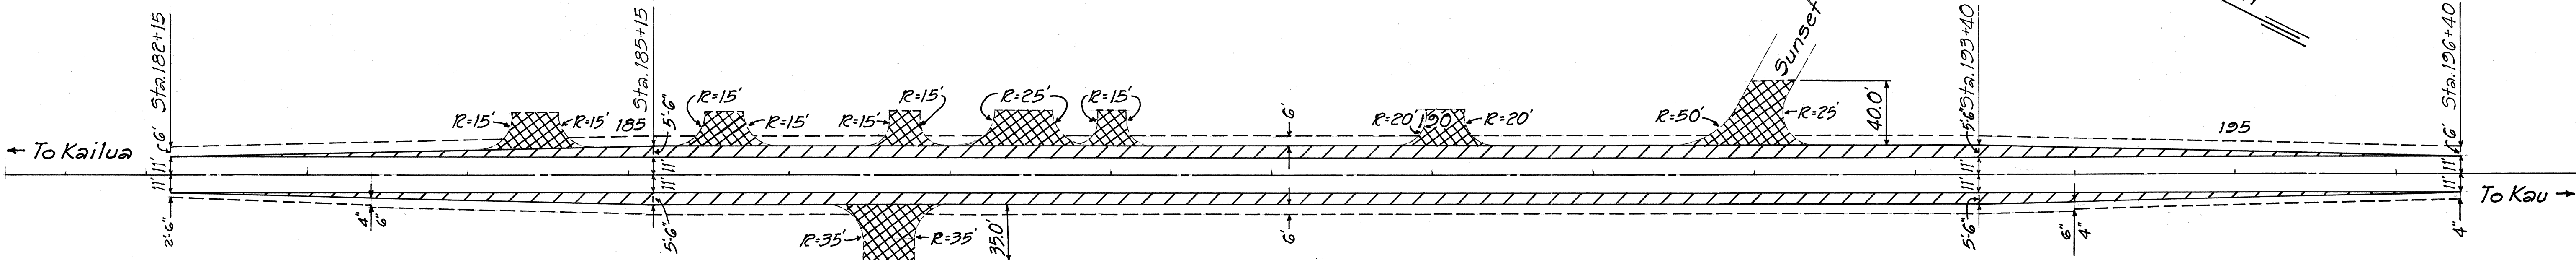
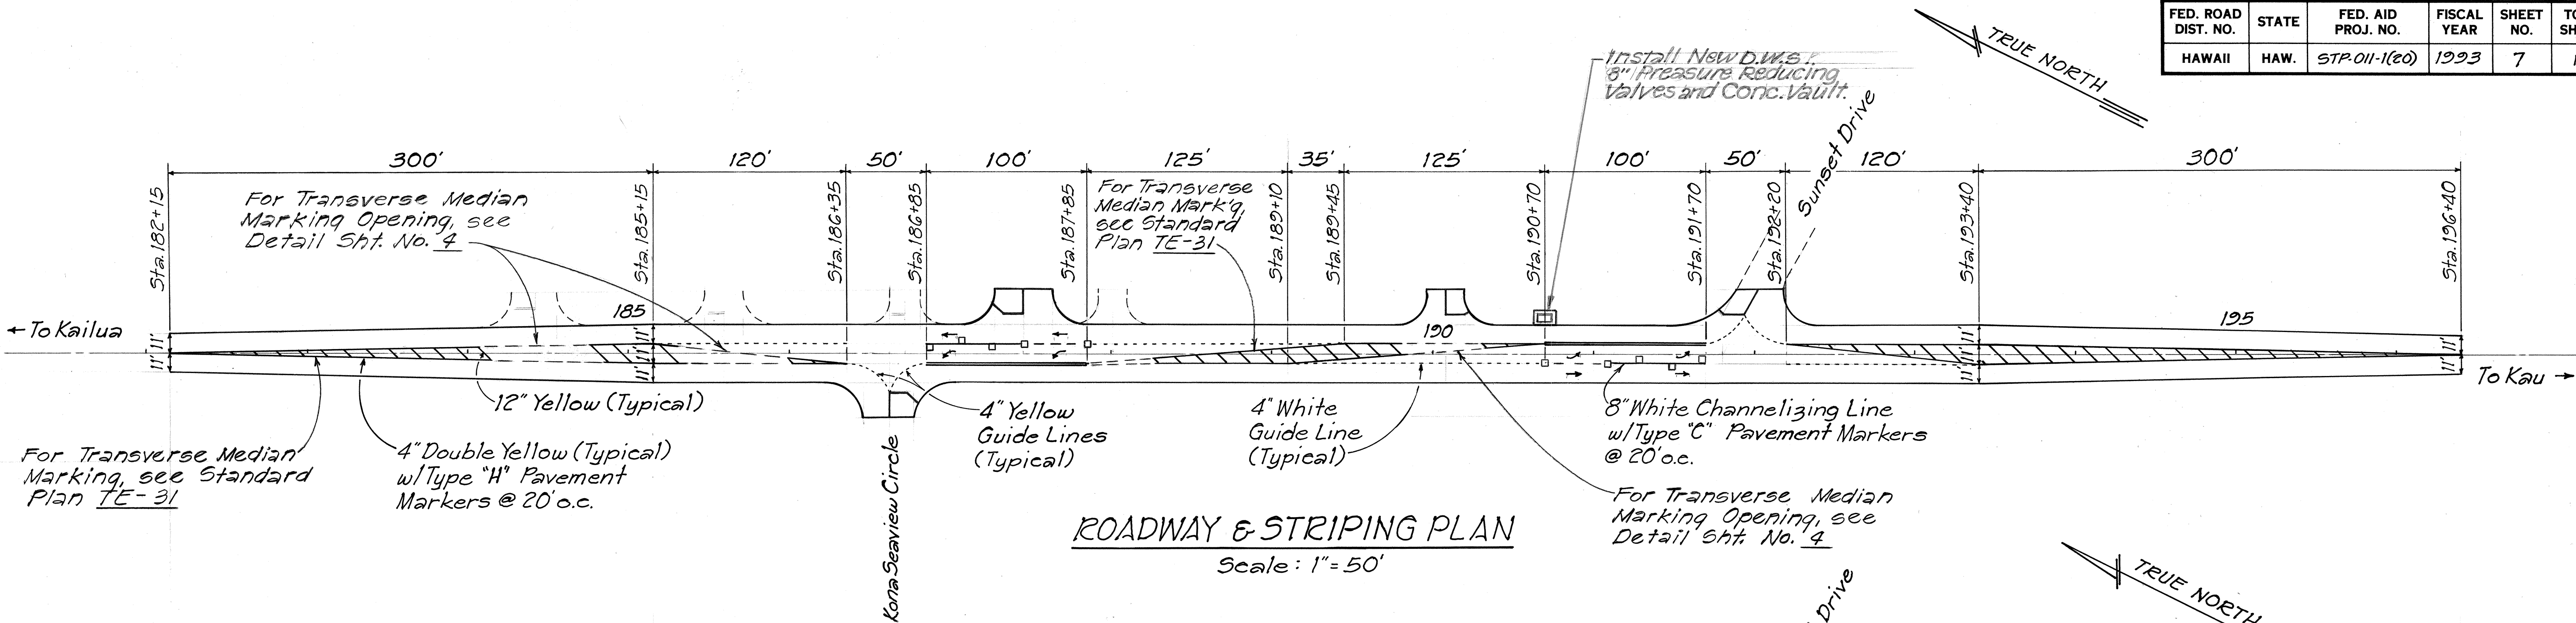


FED. ROAD DIST. NO.	STATE	FED. AID PROJ. NO.	FISCAL YEAR	SHEET NO.	TOTAL SHEETS
HAWAII	HAW.	STP-011-1(20)	1993	7	12

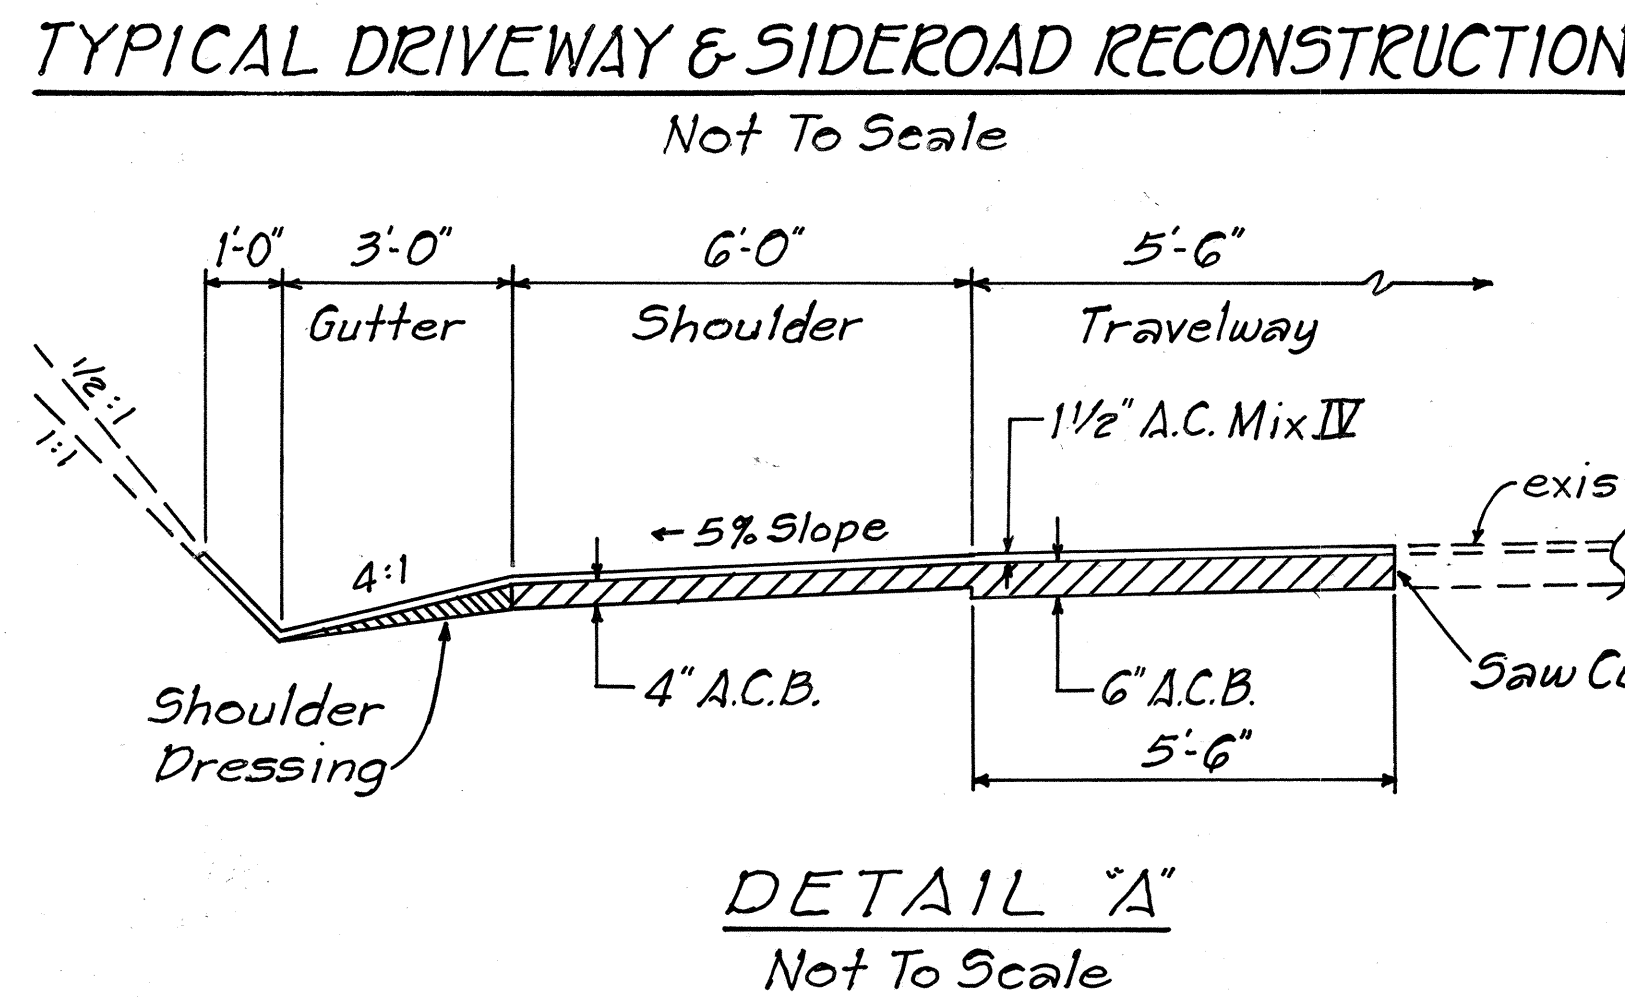

ITEM No.	ITEM	QUANTITIES
203.0100	Roadway Excavation	1,330 C.Y.
203.0210	Imported Borrow	230 C.Y.
301.0100	Plant Mix A.C.B.	1,290 Tons
401.0400	A.C. Mix No. IV	730 Tons
606.3110	Guardrail, Type 3-Single w/Steel Post	625 L.F.
606.9000	Relocate/Adjust Guardrail, Type 3-Single w/Steel Post.	125 L.F.
606.7000	Terminal Section, Type BCT	2 Each
619.9000	Transplanting Trees, Cocos Nucifera (Coconut)	1 Each

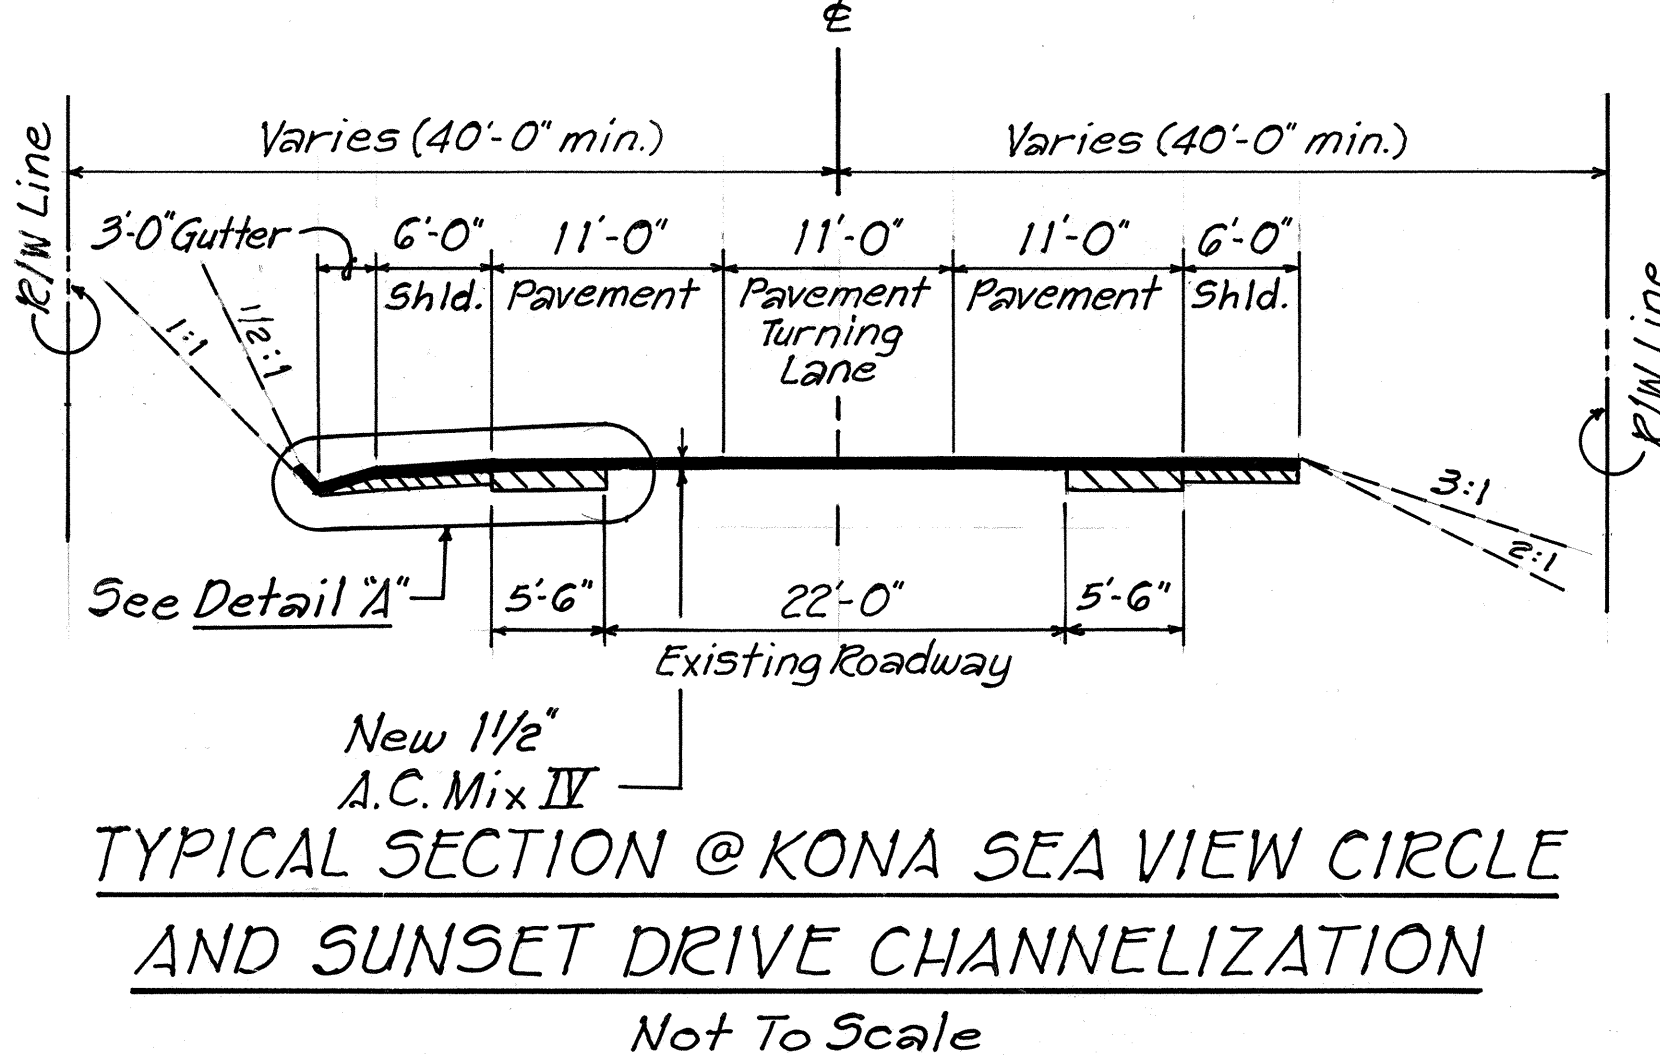

LEGEND:

Reconstructed Travelway

New Edge of Pavement Shoulder.

Reconstructed Driveway/Side Rd.

Note:

Refer to Sheet No. 12 for Channelization Notes.

STATE OF HAWAII
DEPARTMENT OF TRANSPORTATION
HIGHWAYS DIVISION

CHANNELIZING DETAIL
KONA SEAVIEW CIRCLE & SUNSET DR.
STA. 182+15 to STA. 196+40
KUAKINI HWY. RESURF. & IMPROVEMENTS
PROJECT NO. STP-011-1(20)
Scale: As Noted Date: Sept. 1992
SHEET No. 1 OF 1 SHEETS

DATE	DESIGNED BY	CHECKED BY
PLANNED BY	DRAWN BY	NOTED BY
ORIGINAL PLAN	NOTE BOOK	NO.

"AS-BUILT"