


FED. ROAD DIST. NO.	STATE	FED. AID PROJ. NO.	FISCAL YEAR	SHEET NO.	TOTAL SHEETS
HAWAII	HAW.	STP-011-1(20)	1993	4	12

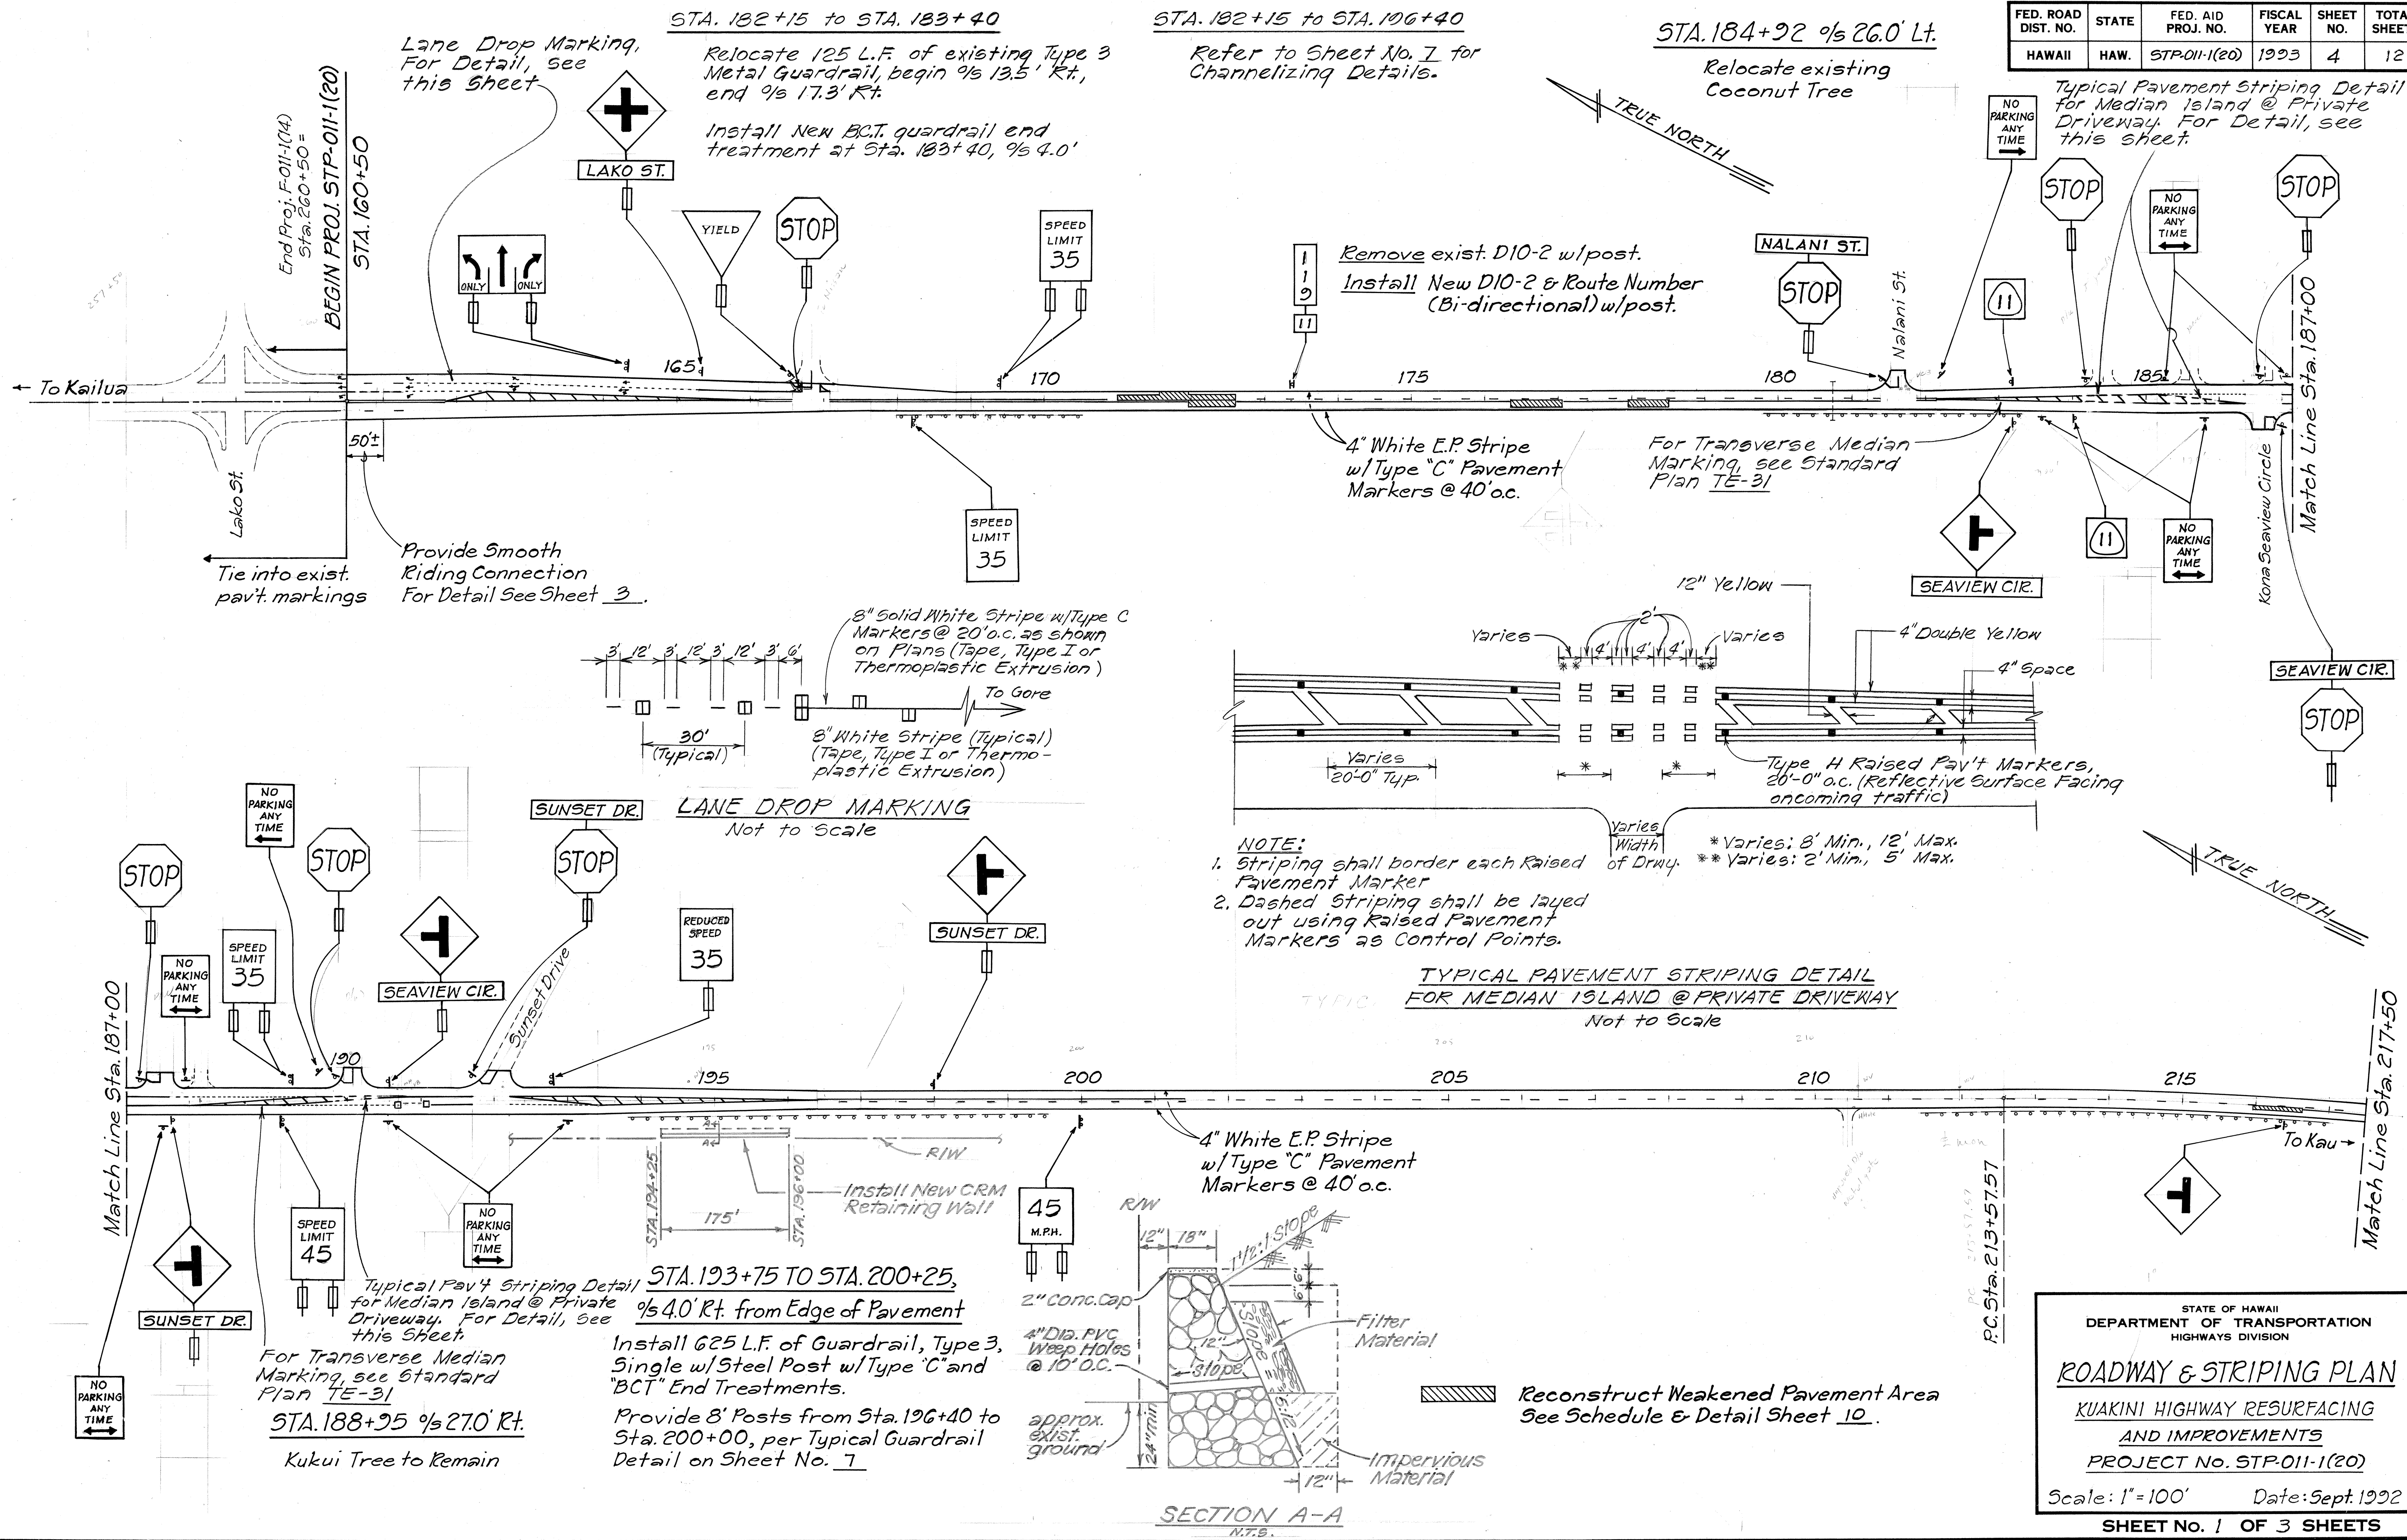

SURVEY PLOTTED BY	DATE
DESIGNED BY	
CHECKED BY	
ORIGINAL PLAN	
NOTE BOOK	

STATE OF HAWAII
 DEPARTMENT OF TRANSPORTATION
 HIGHWAYS DIVISION

ROADWAY & STRIPING PLAN

KUAKINI HIGHWAY RESURFACING
 AND IMPROVEMENTS


PROJECT No. STP-011-1(20)

Scale: 1"=100' Date: Sept. 1992

SHEET No. 1 OF 3 SHEETS

"AS-BUILT"

FED. ROAD DIST. NO.	STATE	FED. AID PROJ. NO.	FISCAL YEAR	SHEET NO.	TOTAL SHEETS
HAWAII	HAW.	STP-011-1(20)	1993	5	12

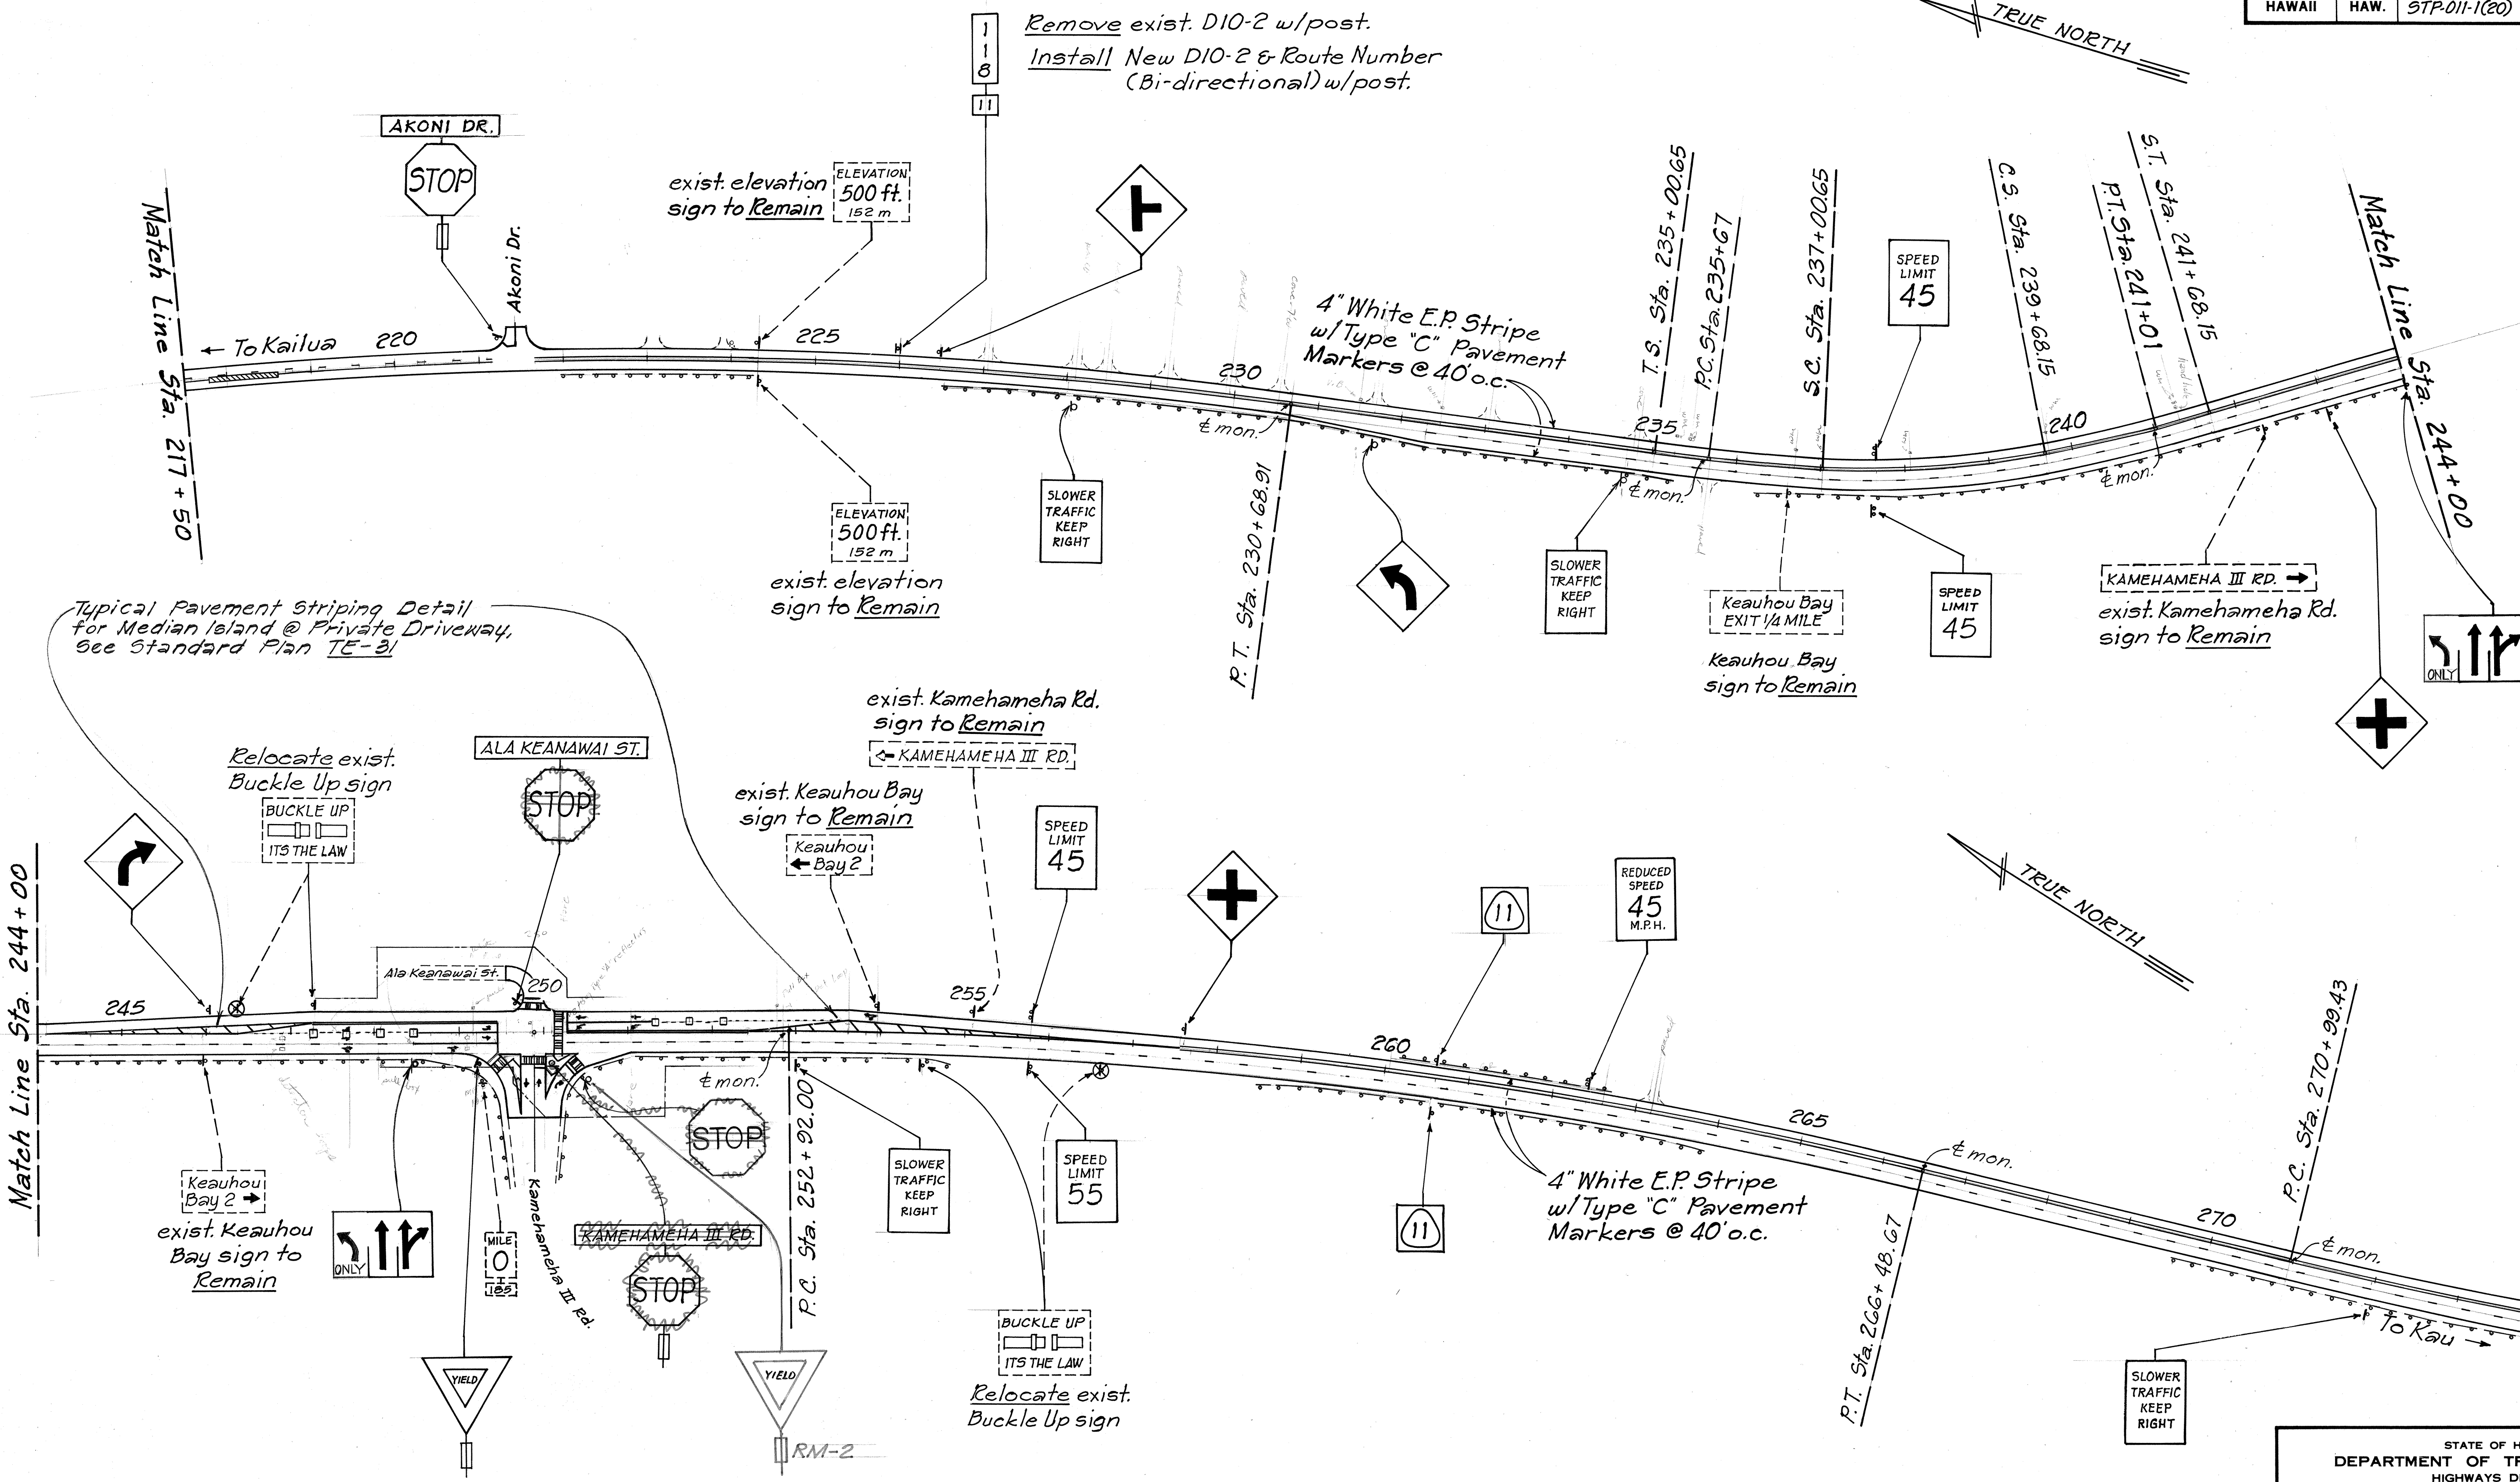

Typical Pavement Striping Detail for Median Island @ Private Driveway, See Standard Plan TE-31

exist. Kamehameha Rd. sign to Remain

exist. Keauhou Bay sign to Remain

Relocate exist. Buckle Up sign

STA. 257+60 to STA. 322+00

Hydroplaning Mitigation: Roadway to be leveled between truck climbing lane and adjacent through lane using a 15-Foot straight edge and as directed by the Engineer. See Typical Section, Truck Climbing Lane and Pavement Detail "A" Sheet No. 3.

Estimated Quantity A.C. Mix No. IV: 500 Tons

Reconstruct Weakened Pavement Area See Schedule & Detail Sheet 10.

STATE OF HAWAII
DEPARTMENT OF TRANSPORTATION
HIGHWAYS DIVISION

ROADWAY & STRIPING PLAN
KUAKINI HIGHWAY RESURFACING
AND IMPROVEMENTS
PROJECT No. STP-011-1(20)
Scale: 1"=100' Date: Sept. 1992
SHEET NO. 2 OF 3 SHEETS


SURVEY PLOTTED BY	DATE
DRAWN BY	
TRACED BY	
CHECKED BY	
NOTE BOOK	
No.	

FED. ROAD DIST. NO.	STATE	FED. AID PROJ. NO.	FISCAL YEAR	SHEET NO.	TOTAL SHEETS
HAWAII	HAW.	STP-011-1(20)	1993	6	12

STA. 287+00 to STA. 288+00

Hydroplaning Mitigation: Lateral depression across roadway to be filled at the direction of the Engineer.


Estimated Quantity A.C. Mix No. IV : 45 Tons

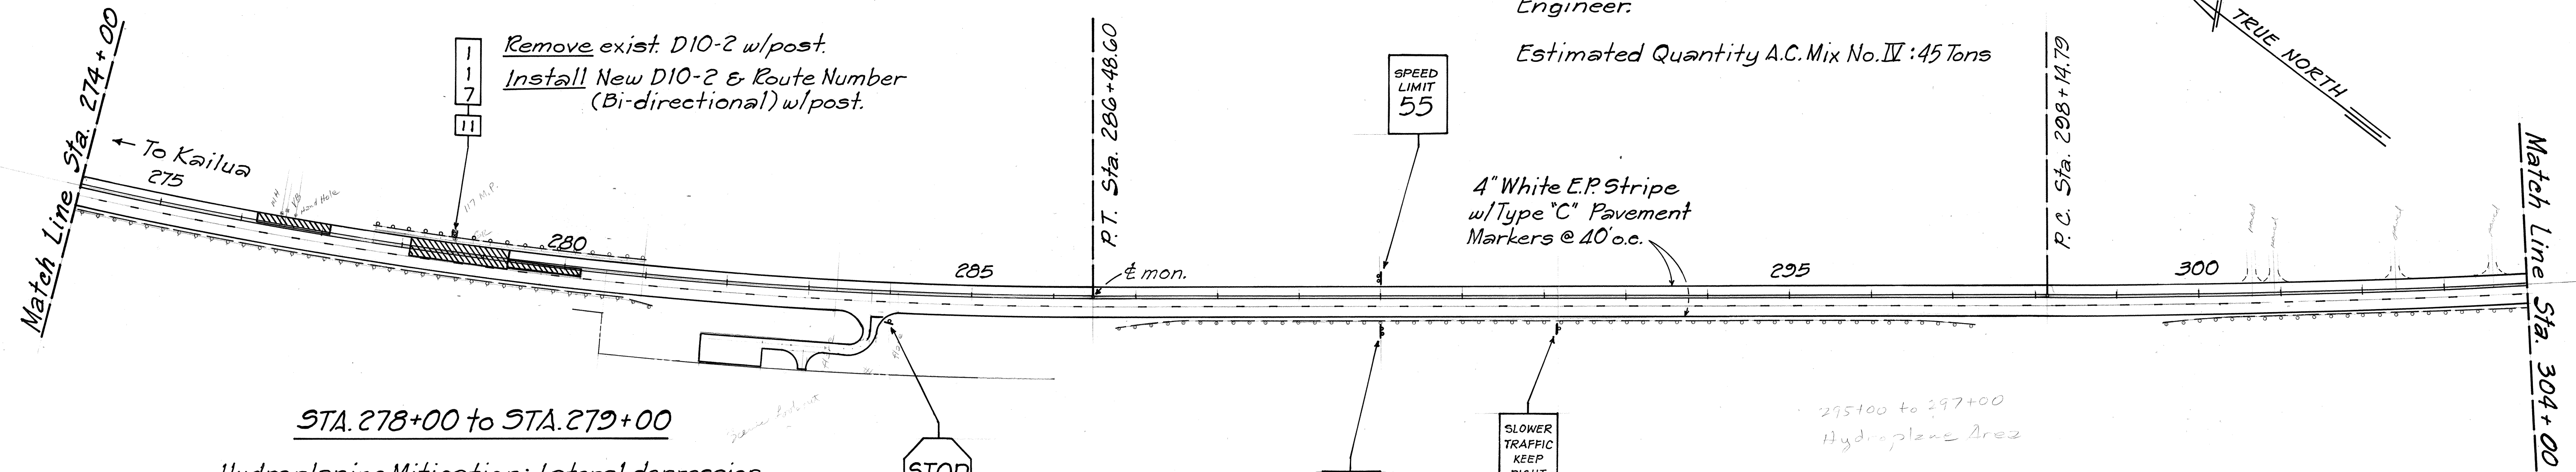

STA. 278+00 to STA. 279+00

Hydroplaning Mitigation: Lateral depression across roadway to be filled at the direction of the Engineer.

Estimated Quantity A.C. Mix No. IV: 45 Tons

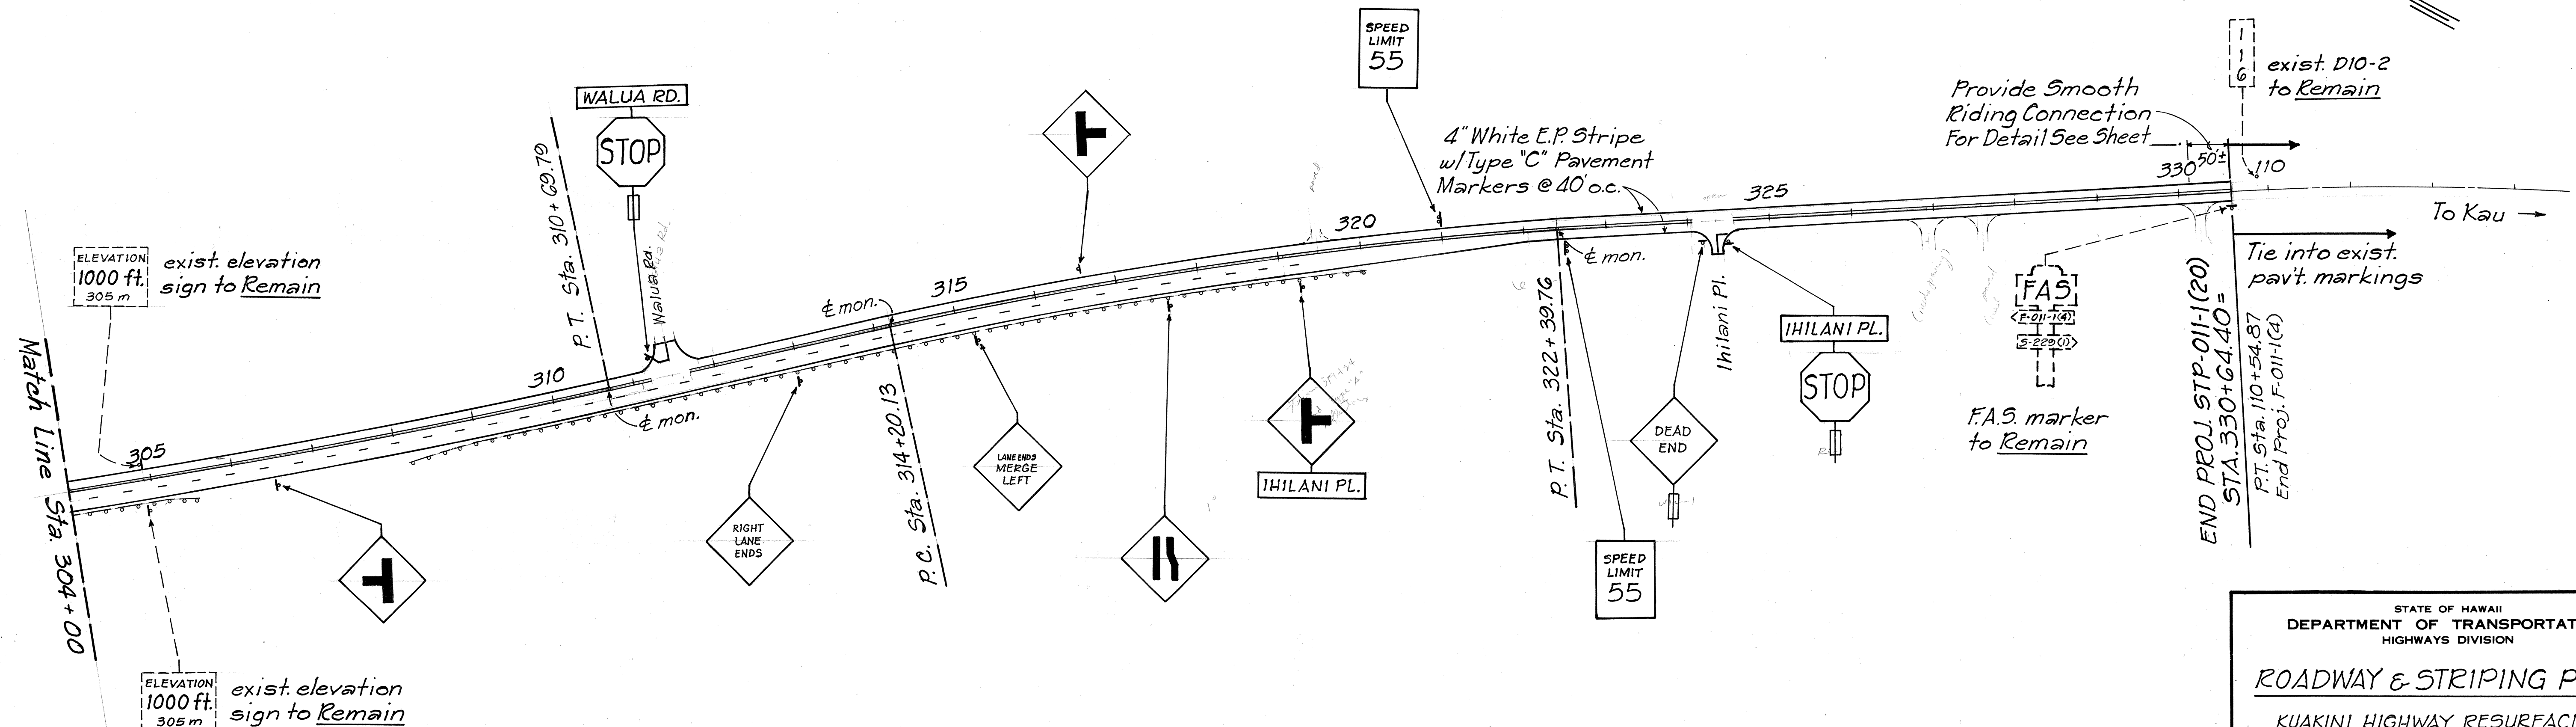

Provide Smooth
Riding Connection -
For Detail See Sheet

1
6
T

exist. D10-2
to Remain

Tie into exist.
pav't. markings

END PROJ. STP-011-1(20)
STA. 330+64.40=

STA. 330+64.40
P.T. Sta. 110+54.87
E. 1/2 Sec. 5-011-1(4)

F.A.S. marker
to Remain

STATE OF HAWAII
DEPARTMENT OF TRANSPORTATION
HIGHWAYS DIVISION

ROADWAY & STRIPING PLAN

KUAKINI HIGHWAY RESURFACING
AND IMPROVEMENTS
PROJECT No. STP-011-1(20)

Scale: 1" = 100' Date: Sept. 1992

SHEET No. 3 OF 3 SHEETS

ORIGINAL PLAN	SURVEY PLOTTED BY _____ DATE _____
NOTE BOOK	DRAWN BY _____ *
	TRACED BY _____ *
	DESIGNED BY _____ *
	QUANTITIES BY _____ *
No. _____	CHECKED BY _____