

INDEX TO DRAWINGS	
SHEET NO.	DESCRIPTION
1	TITLE SHEET
2	STANDARD PLANS SUMMARY
3	TYPICAL SECTIONS, DETAIL AND GENERAL NOTES
4-6	ROADWAY AND STRIPING PLAN
7	CHANNELIZING DETAIL
8	SIGN SCHEDULE
9	REFLECTOR AND OBJECT MARKER SCHEDULE
10	MISC. SCHEDULES AND DETAILS
11	PAVEMENT MARKER SCHEDULE, DETAIL AND NOTES
12	CONSTRUCTION SIGN SCHEDULE DETAIL & QUANTITIES

STATE OF HAWAII

DEPARTMENT OF TRANSPORTATION

HIGHWAYS DIVISION

HONOLULU, HAWAII

'AS-BUILT' PLANS FOR

KUAKINI HIGHWAY RESURFACING


AND IMPROVEMENTS

LAKO STREET TO KEAUHOU

FED. AID PROJ. NO. STP-011-1(20)

DISTRICT OF NORTH KONA



ISLAND OF HAWAII

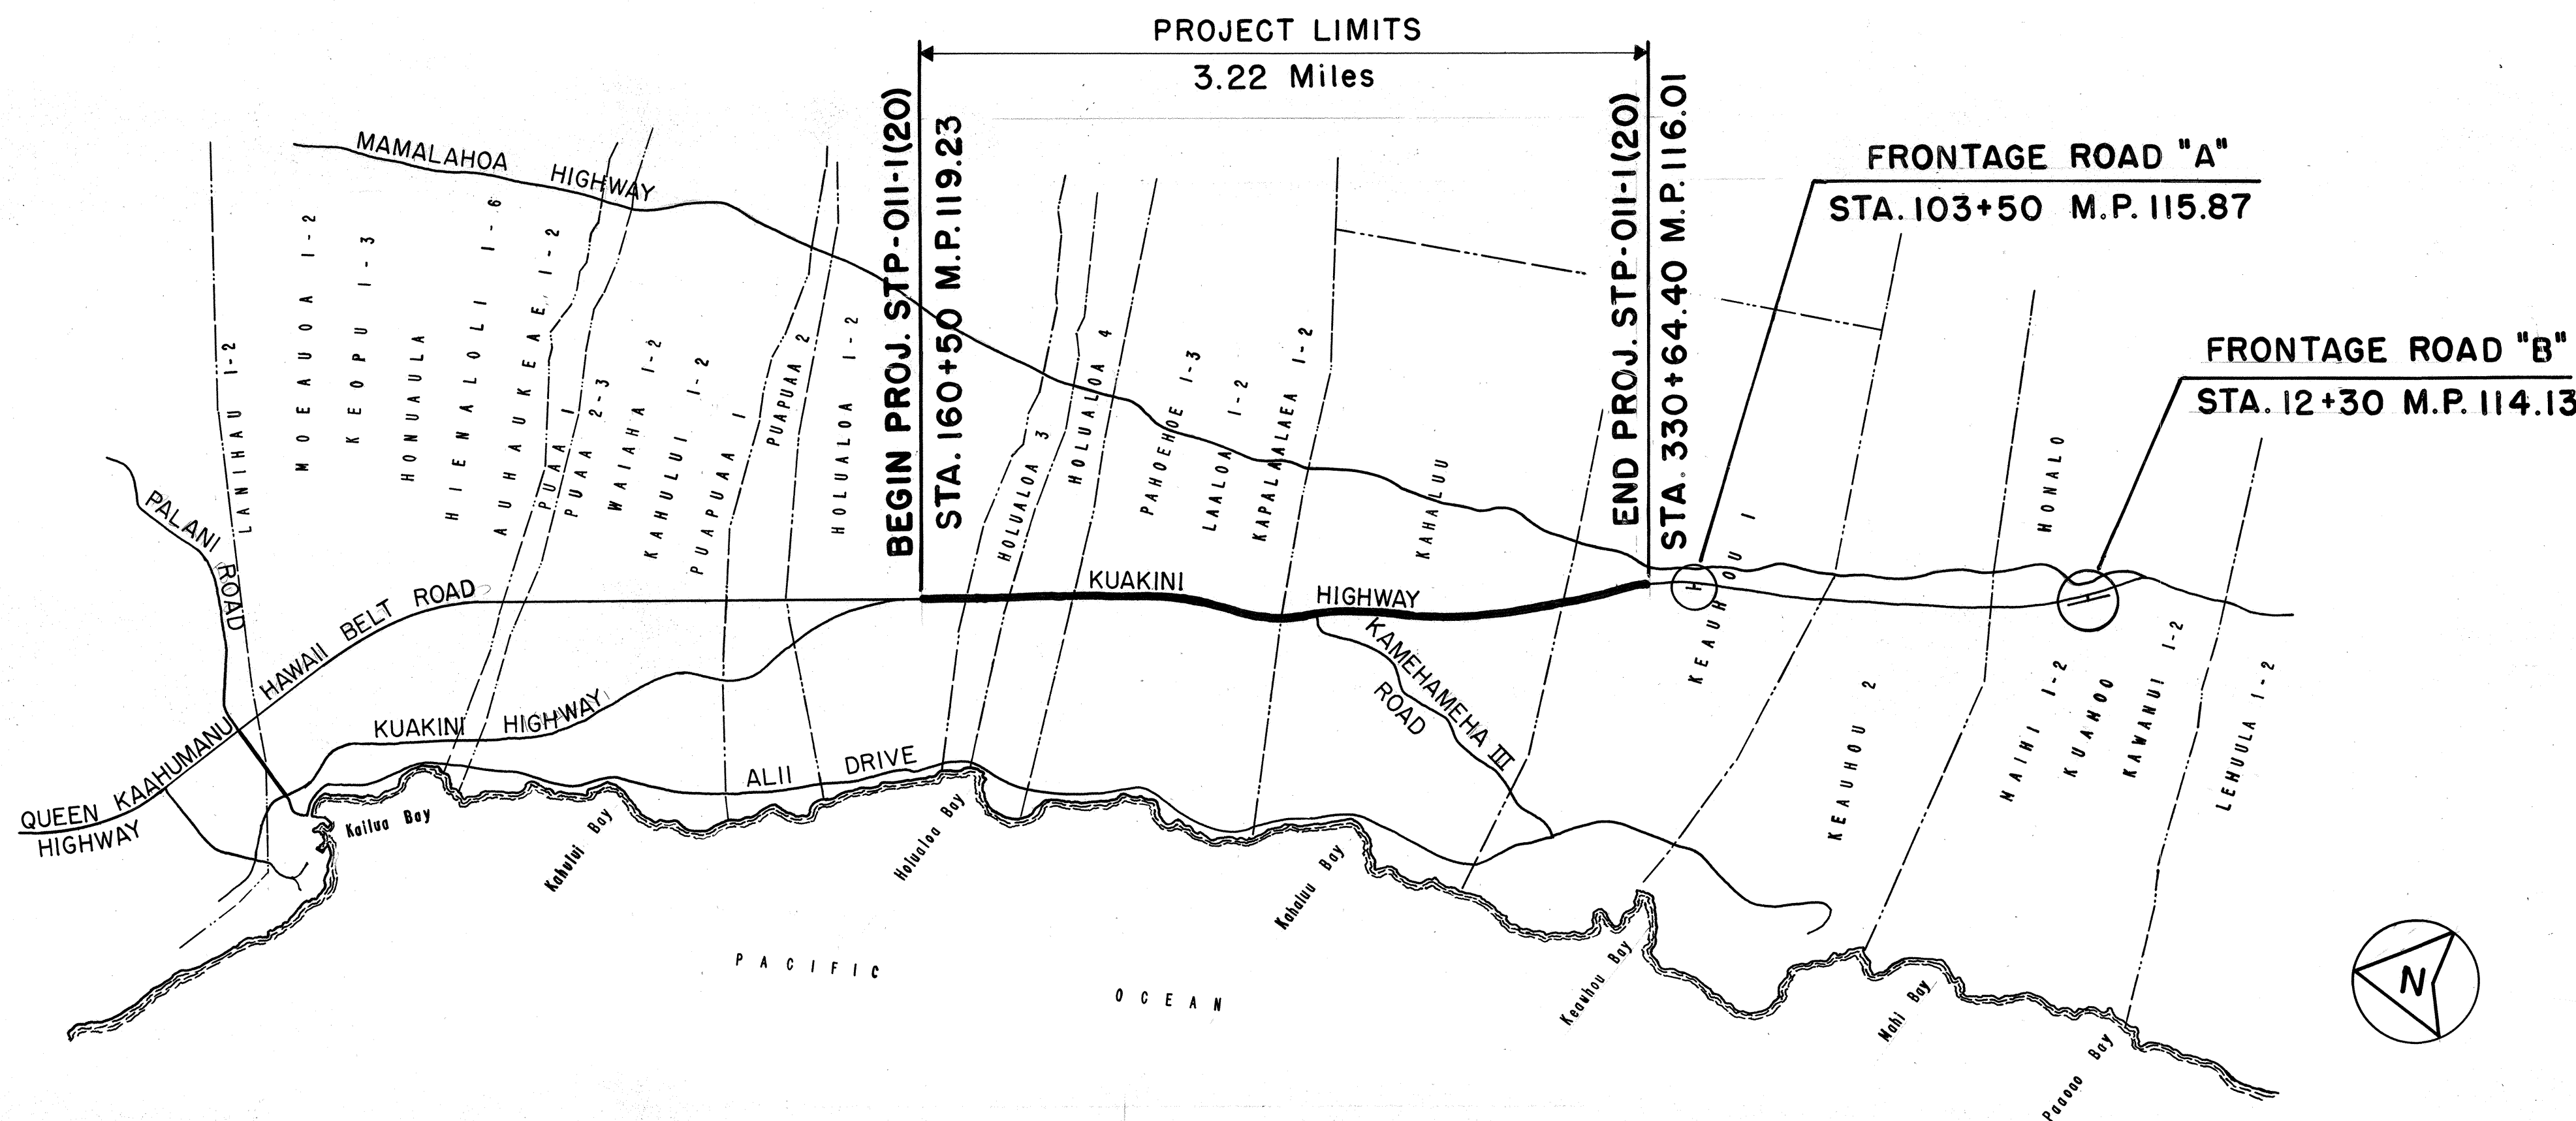

GENERAL LOCATION MAP



LOCATION OF PROJECT
No. STP-011-1(20)

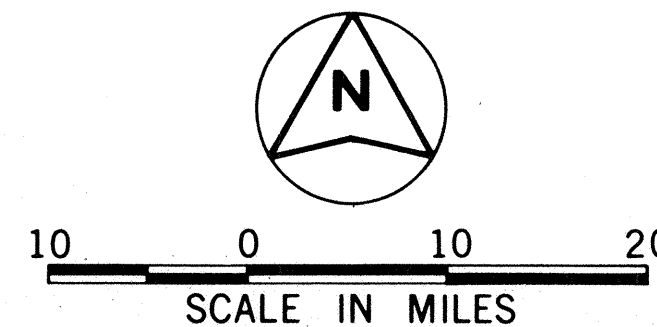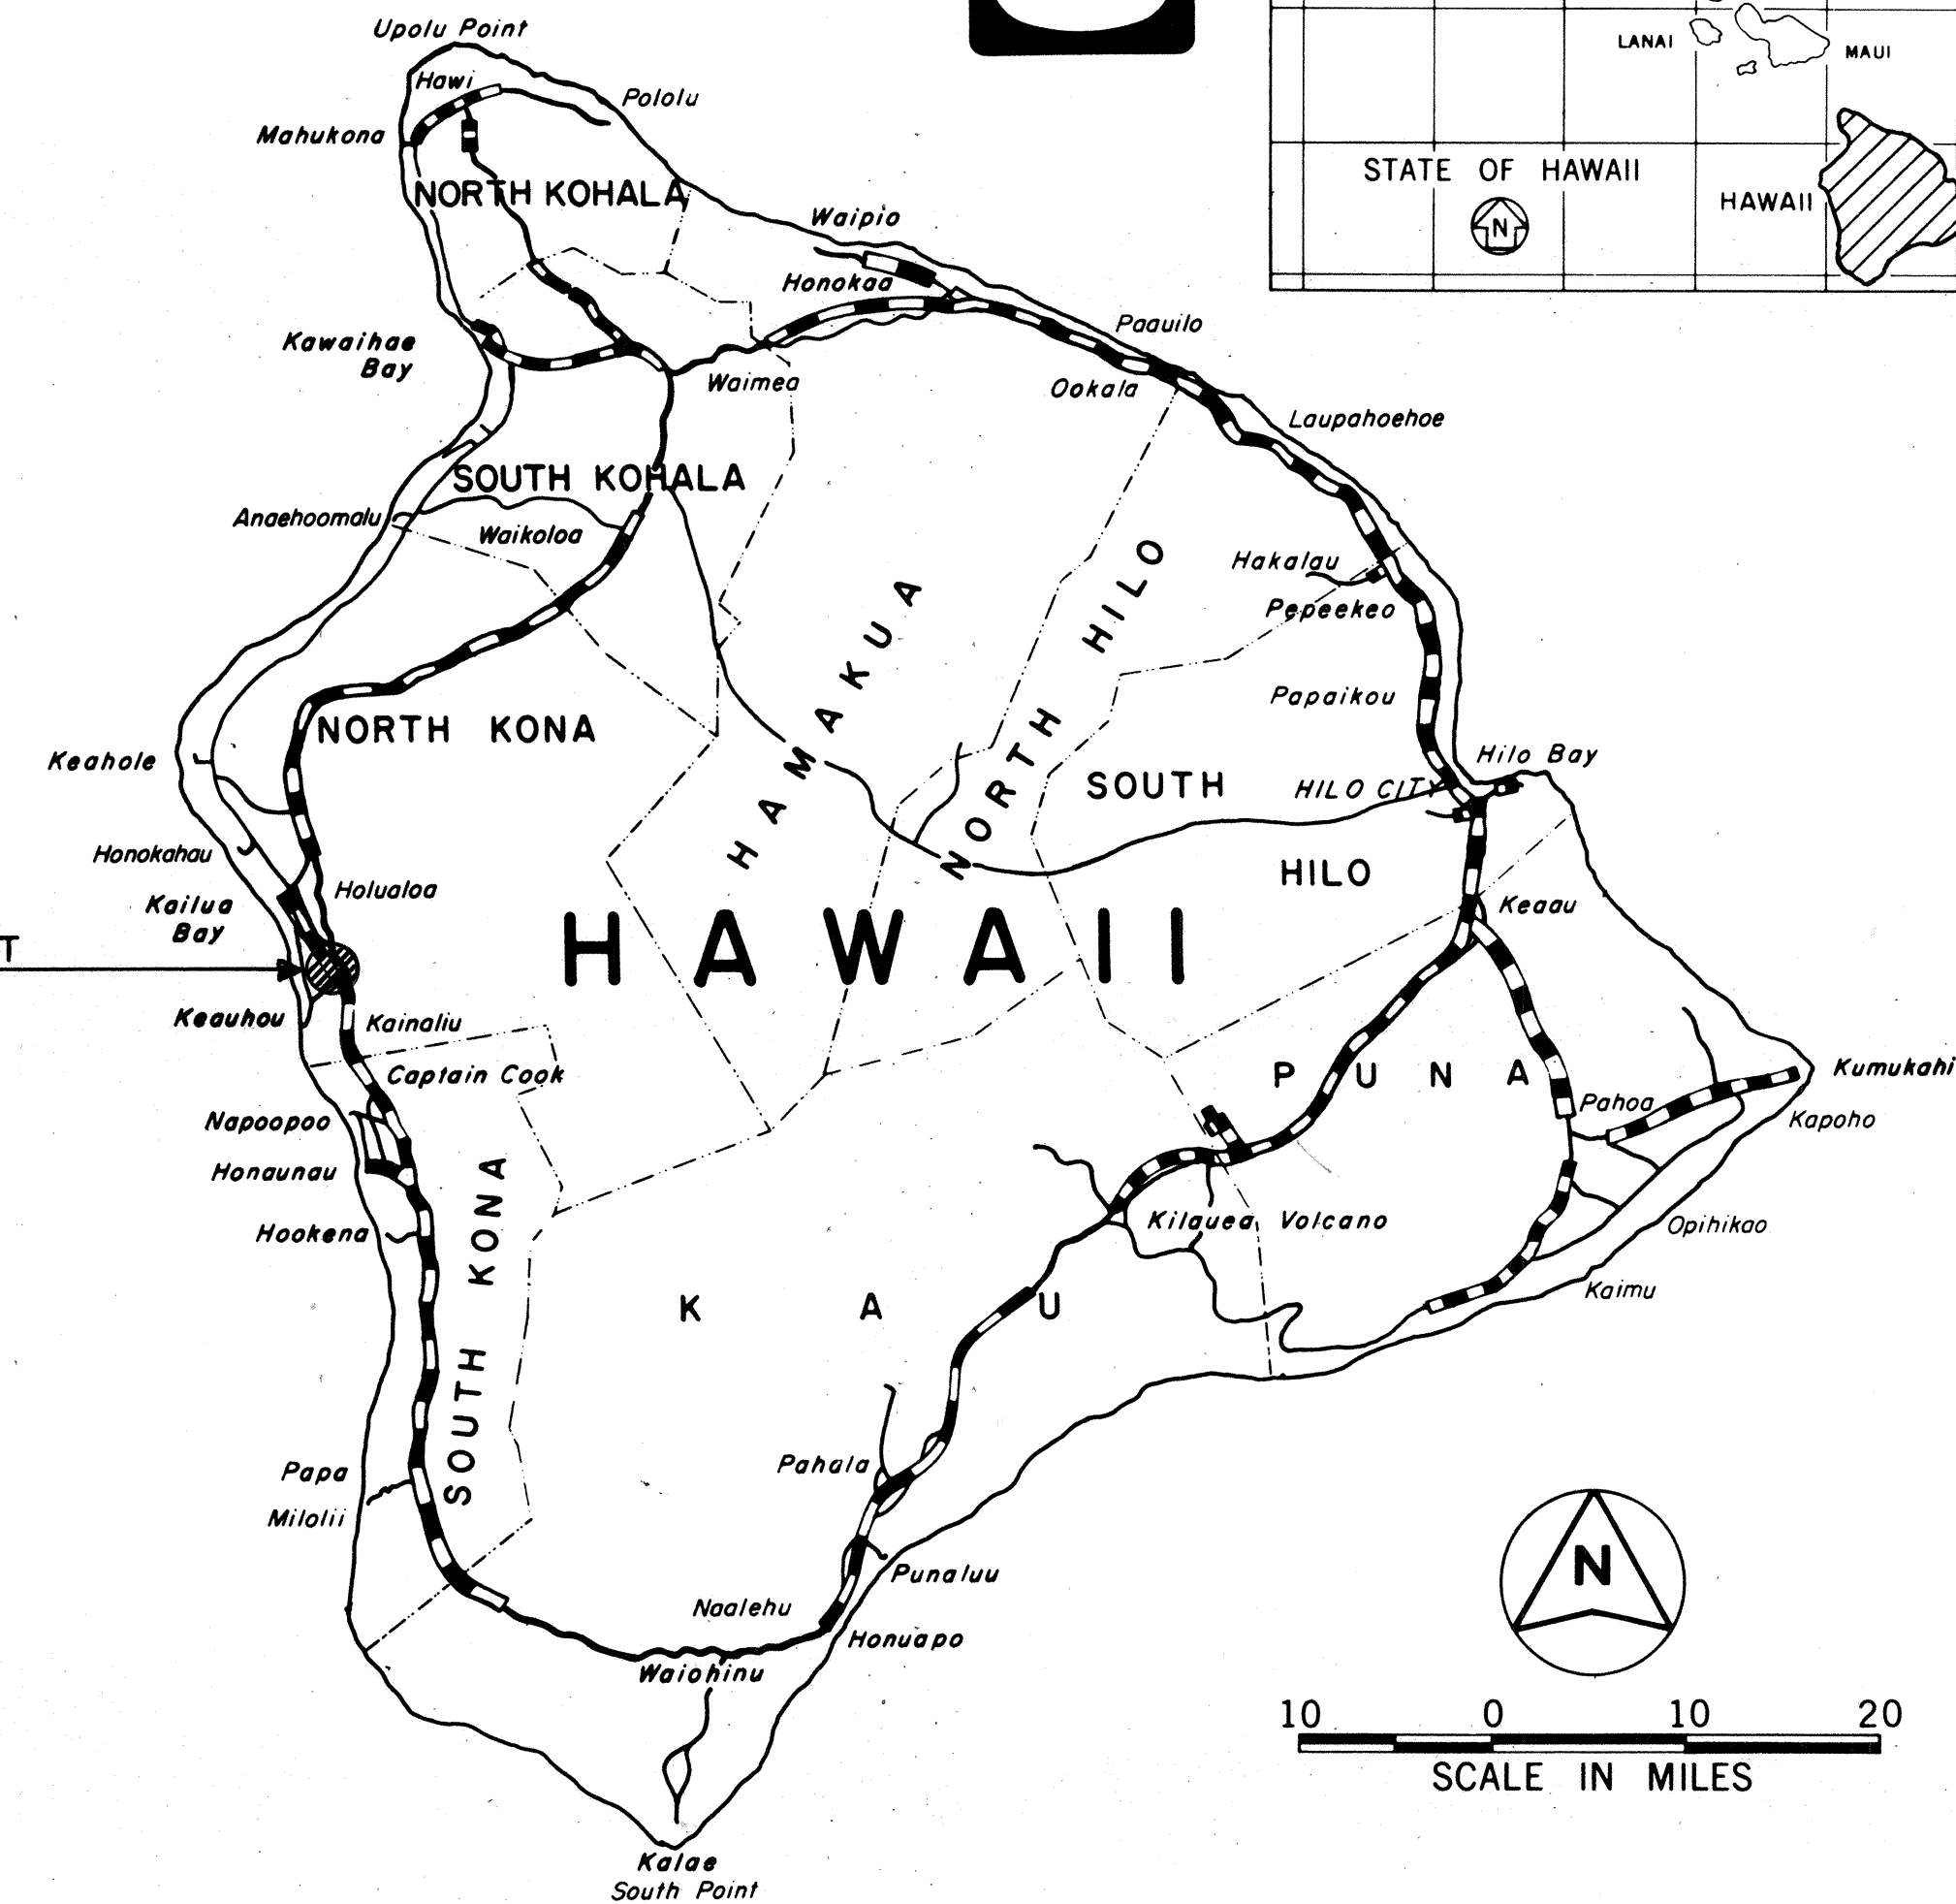

FEDERAL AID PROJECTS PREVIOUSLY CONSTRUCTED
OR UNDER CONSTRUCTION

MILE POST 116.01 TO MILE POST 119.23

DESIGN CLASSIFICATION

ADT (1992)	18,600
ADT (2002)	22,700
DHV	2,050
D	55/45
T	3.0%
V	.60 MPH

CHANGES MADE DURING CONSTRUCTION HAVE BEEN
INCORPORATED ON THESE PLANS EXCEPT CHANGES
IN THE ORIGINAL THEORETICAL QUANTITIES. FOR
ACTUAL QUANTITIES, REFER TO PROJECT LEDGER
AND TO CONSTRUCTION.

h. h. h. 3/28/02
RESIDENT ENGINEER DATE

DEPARTMENT OF TRANSPORTATION
FEDERAL HIGHWAY ADMINISTRATION

APPROVED:

Abraham Wong 2/16/93
DIVISION ADMINISTRATOR DATE

DEPARTMENT OF TRANSPORTATION
STATE OF HAWAII

APPROVED:

T. Hara 12/14/92
DIR. OF TRANSPORTATION DATE

HAWAII DISTRICT R. TAKAESU 587-2249 OCT. 1992
DESIGNED BY P. S. & E. BY PHONE DATE