


FED. ROAD DIST. NO.	STATE	FED. AID PROJ. NO.	FISCAL YEAR	SHEET NO.	TOTAL SHEETS
HAWAII	HAW.	STP-011-2(25)	1995	39	39

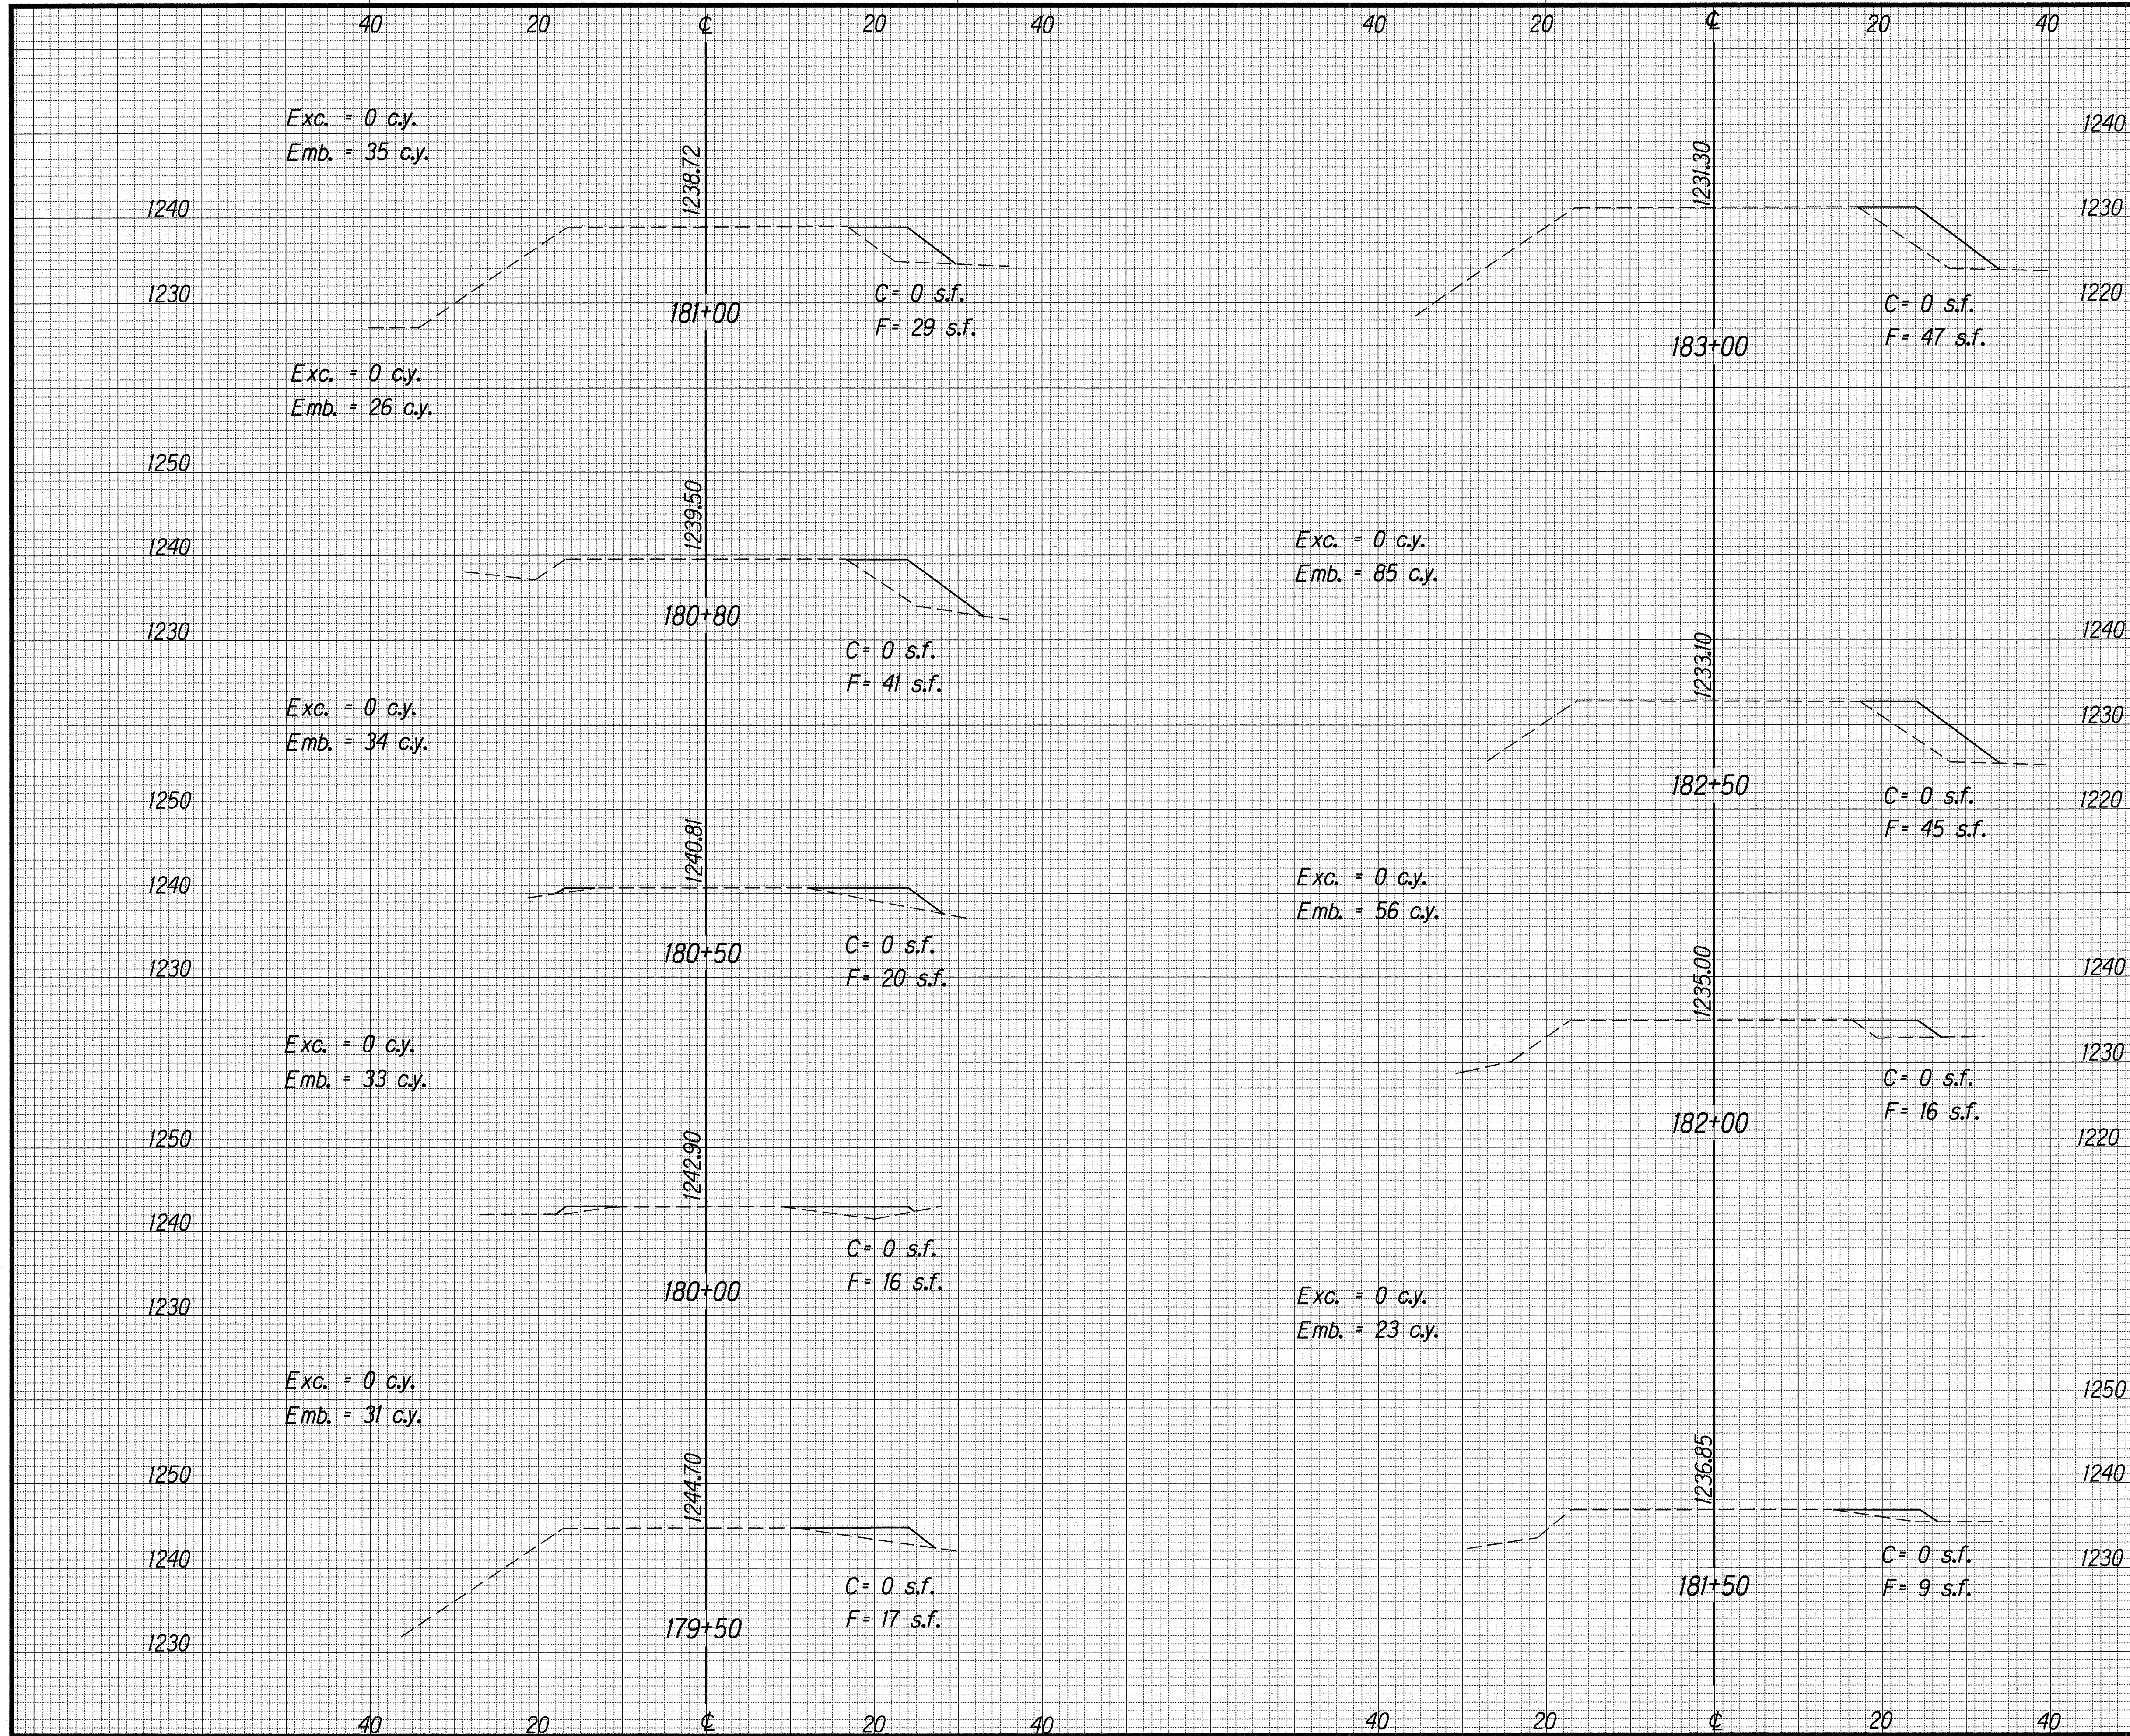

ORIGINAL PLAN	DATE
DESIGNED BY	12-10-94
TRACED BY	
CHECKED BY	
APPROVED BY	

STATE OF HAWAII
DEPARTMENT OF TRANSPORTATION
HIGHWAYS DIVISION

CROSS-SECTIONS
MAMALAHOA HIGHWAY
Drainage Improvements at
Piikea Stream Bridge
Fed. Aid Proj No. STP-011-2(25)

Scale: Vert. 1"=10'
Horiz. 1"=10'

Date: Dec., 1991

SHEET No. 1 OF 1 SHEETS