




FED. ROAD DIST. NO.	STATE	PROJ. NO.	FISCAL YEAR	SHEET NO.	TOTAL SHEETS
HAWAII	HAW.	11B-01-96M	1996	4	32

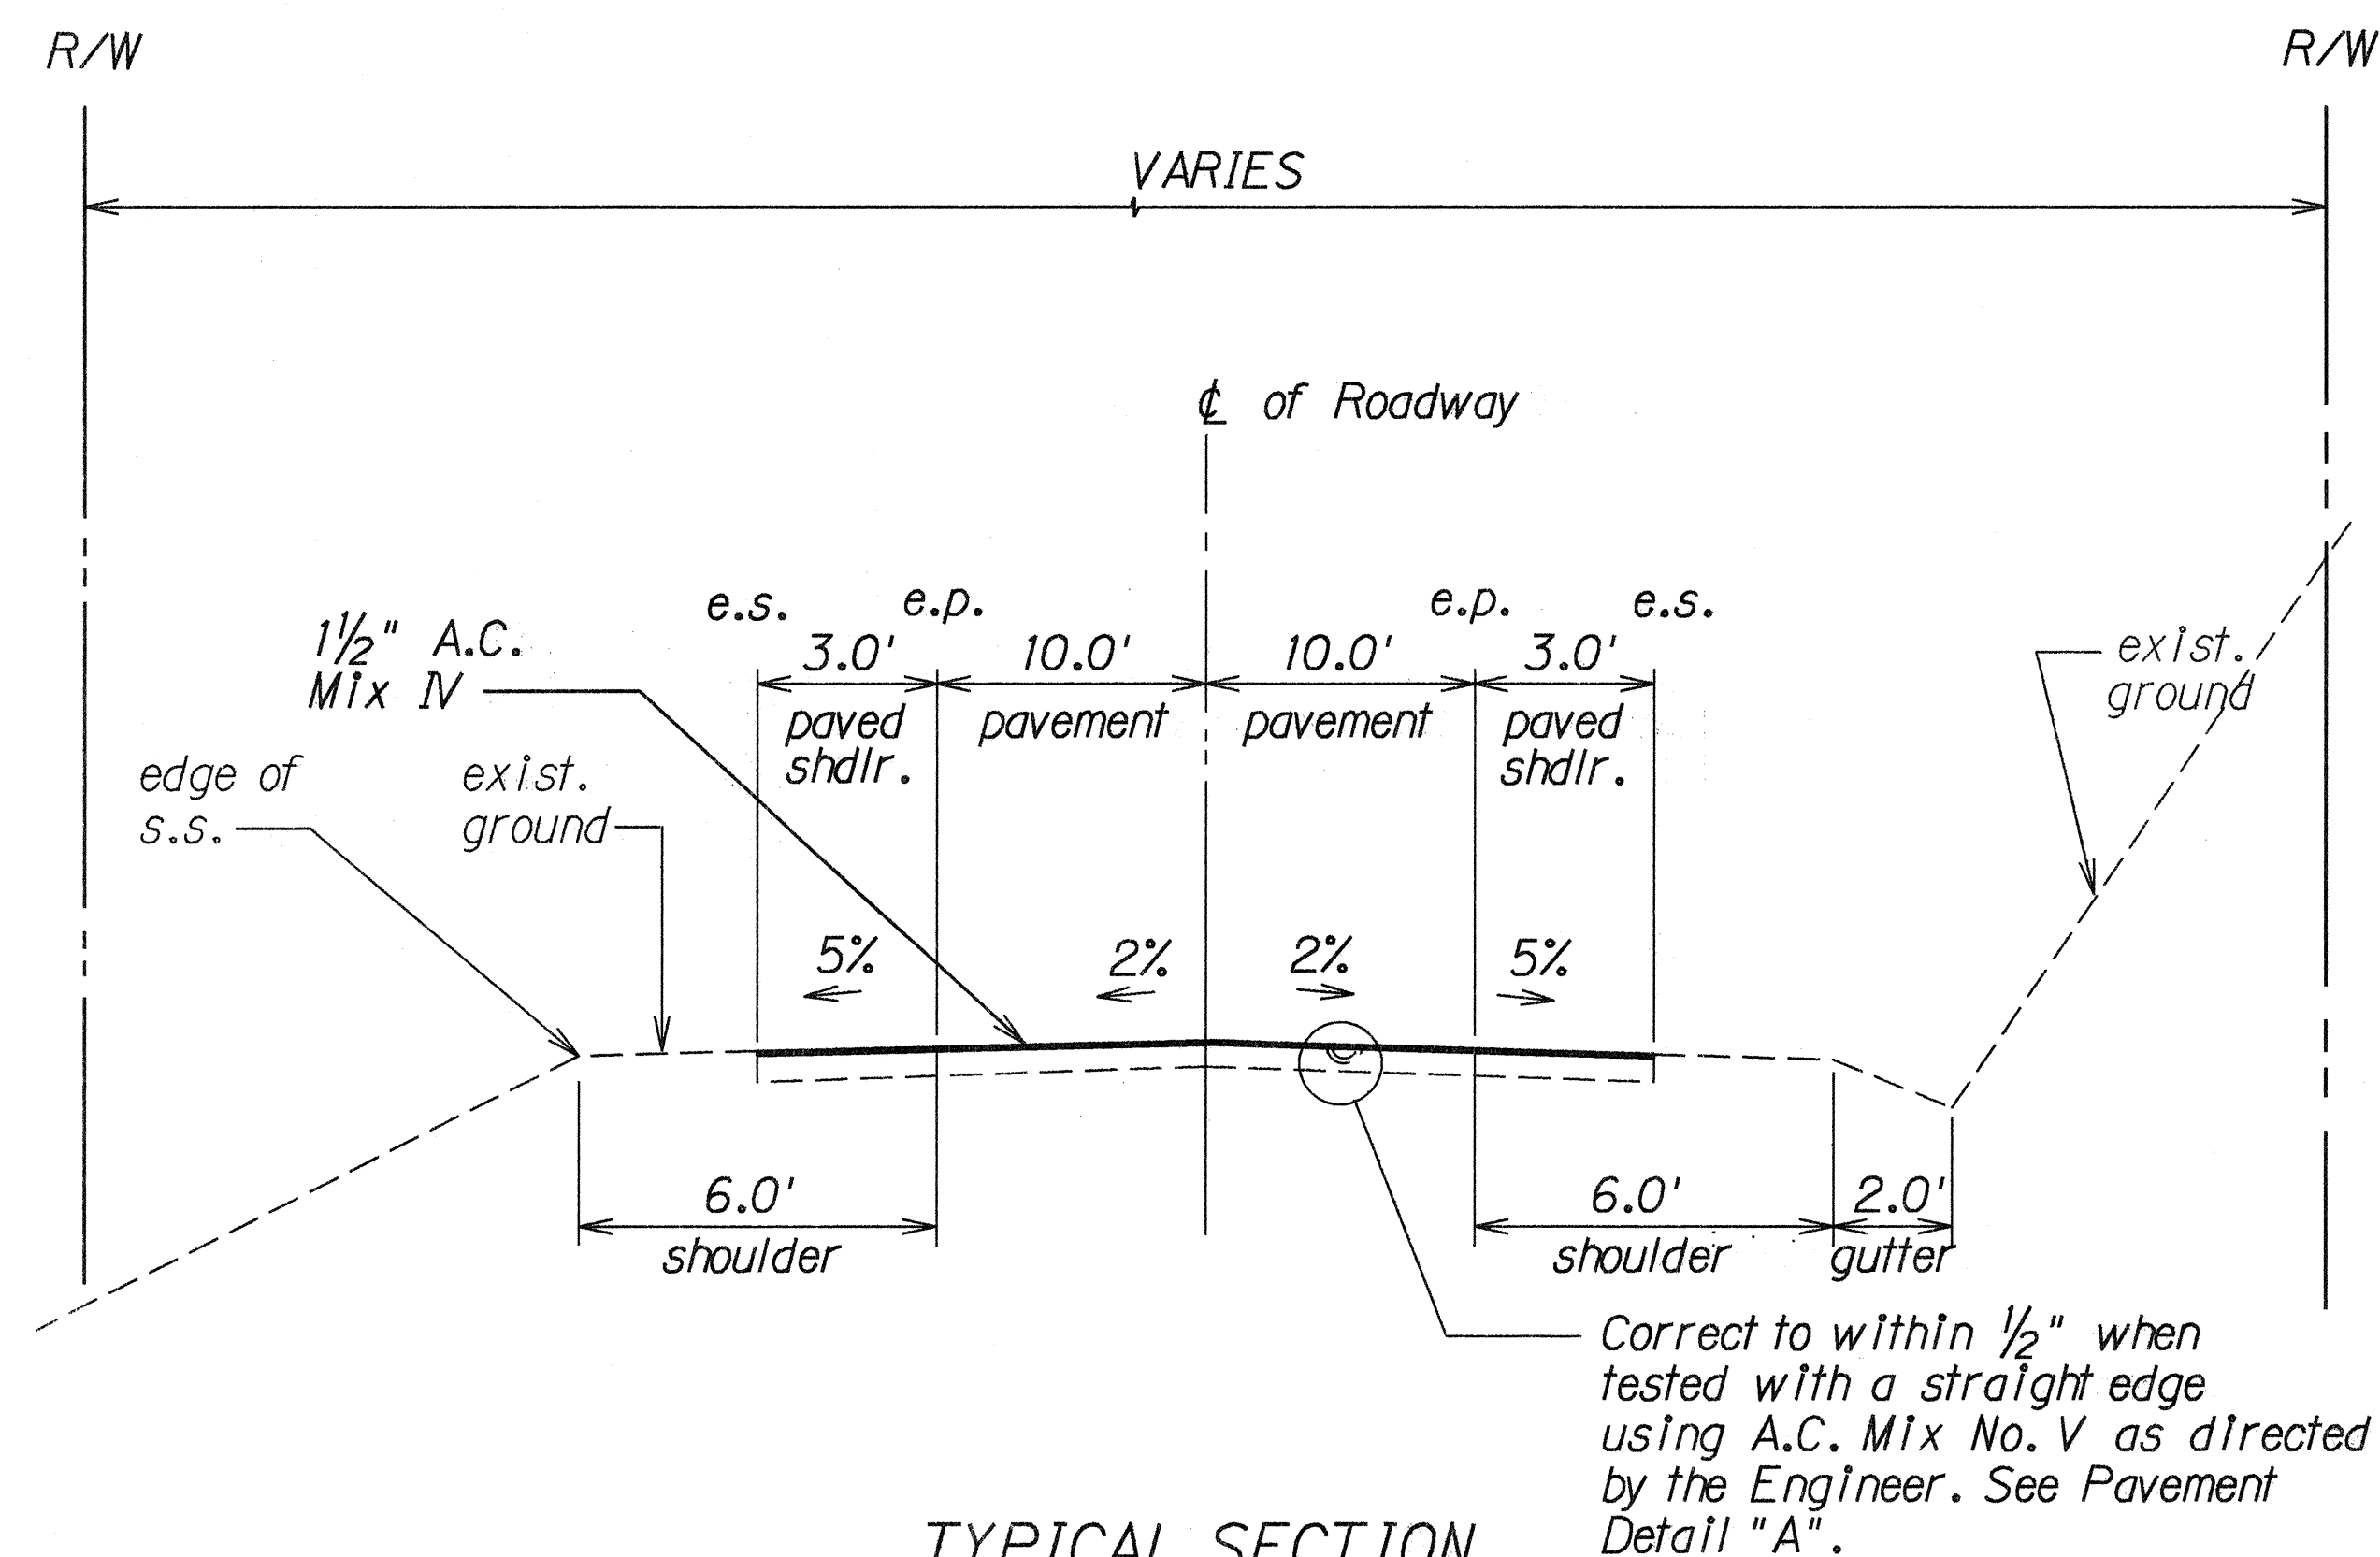

TYPICAL SECTION
BEGINNING OF PROJECT M.P. 109.4
STA. 272+18.08 TO STA. 222+50
 Not To Scale

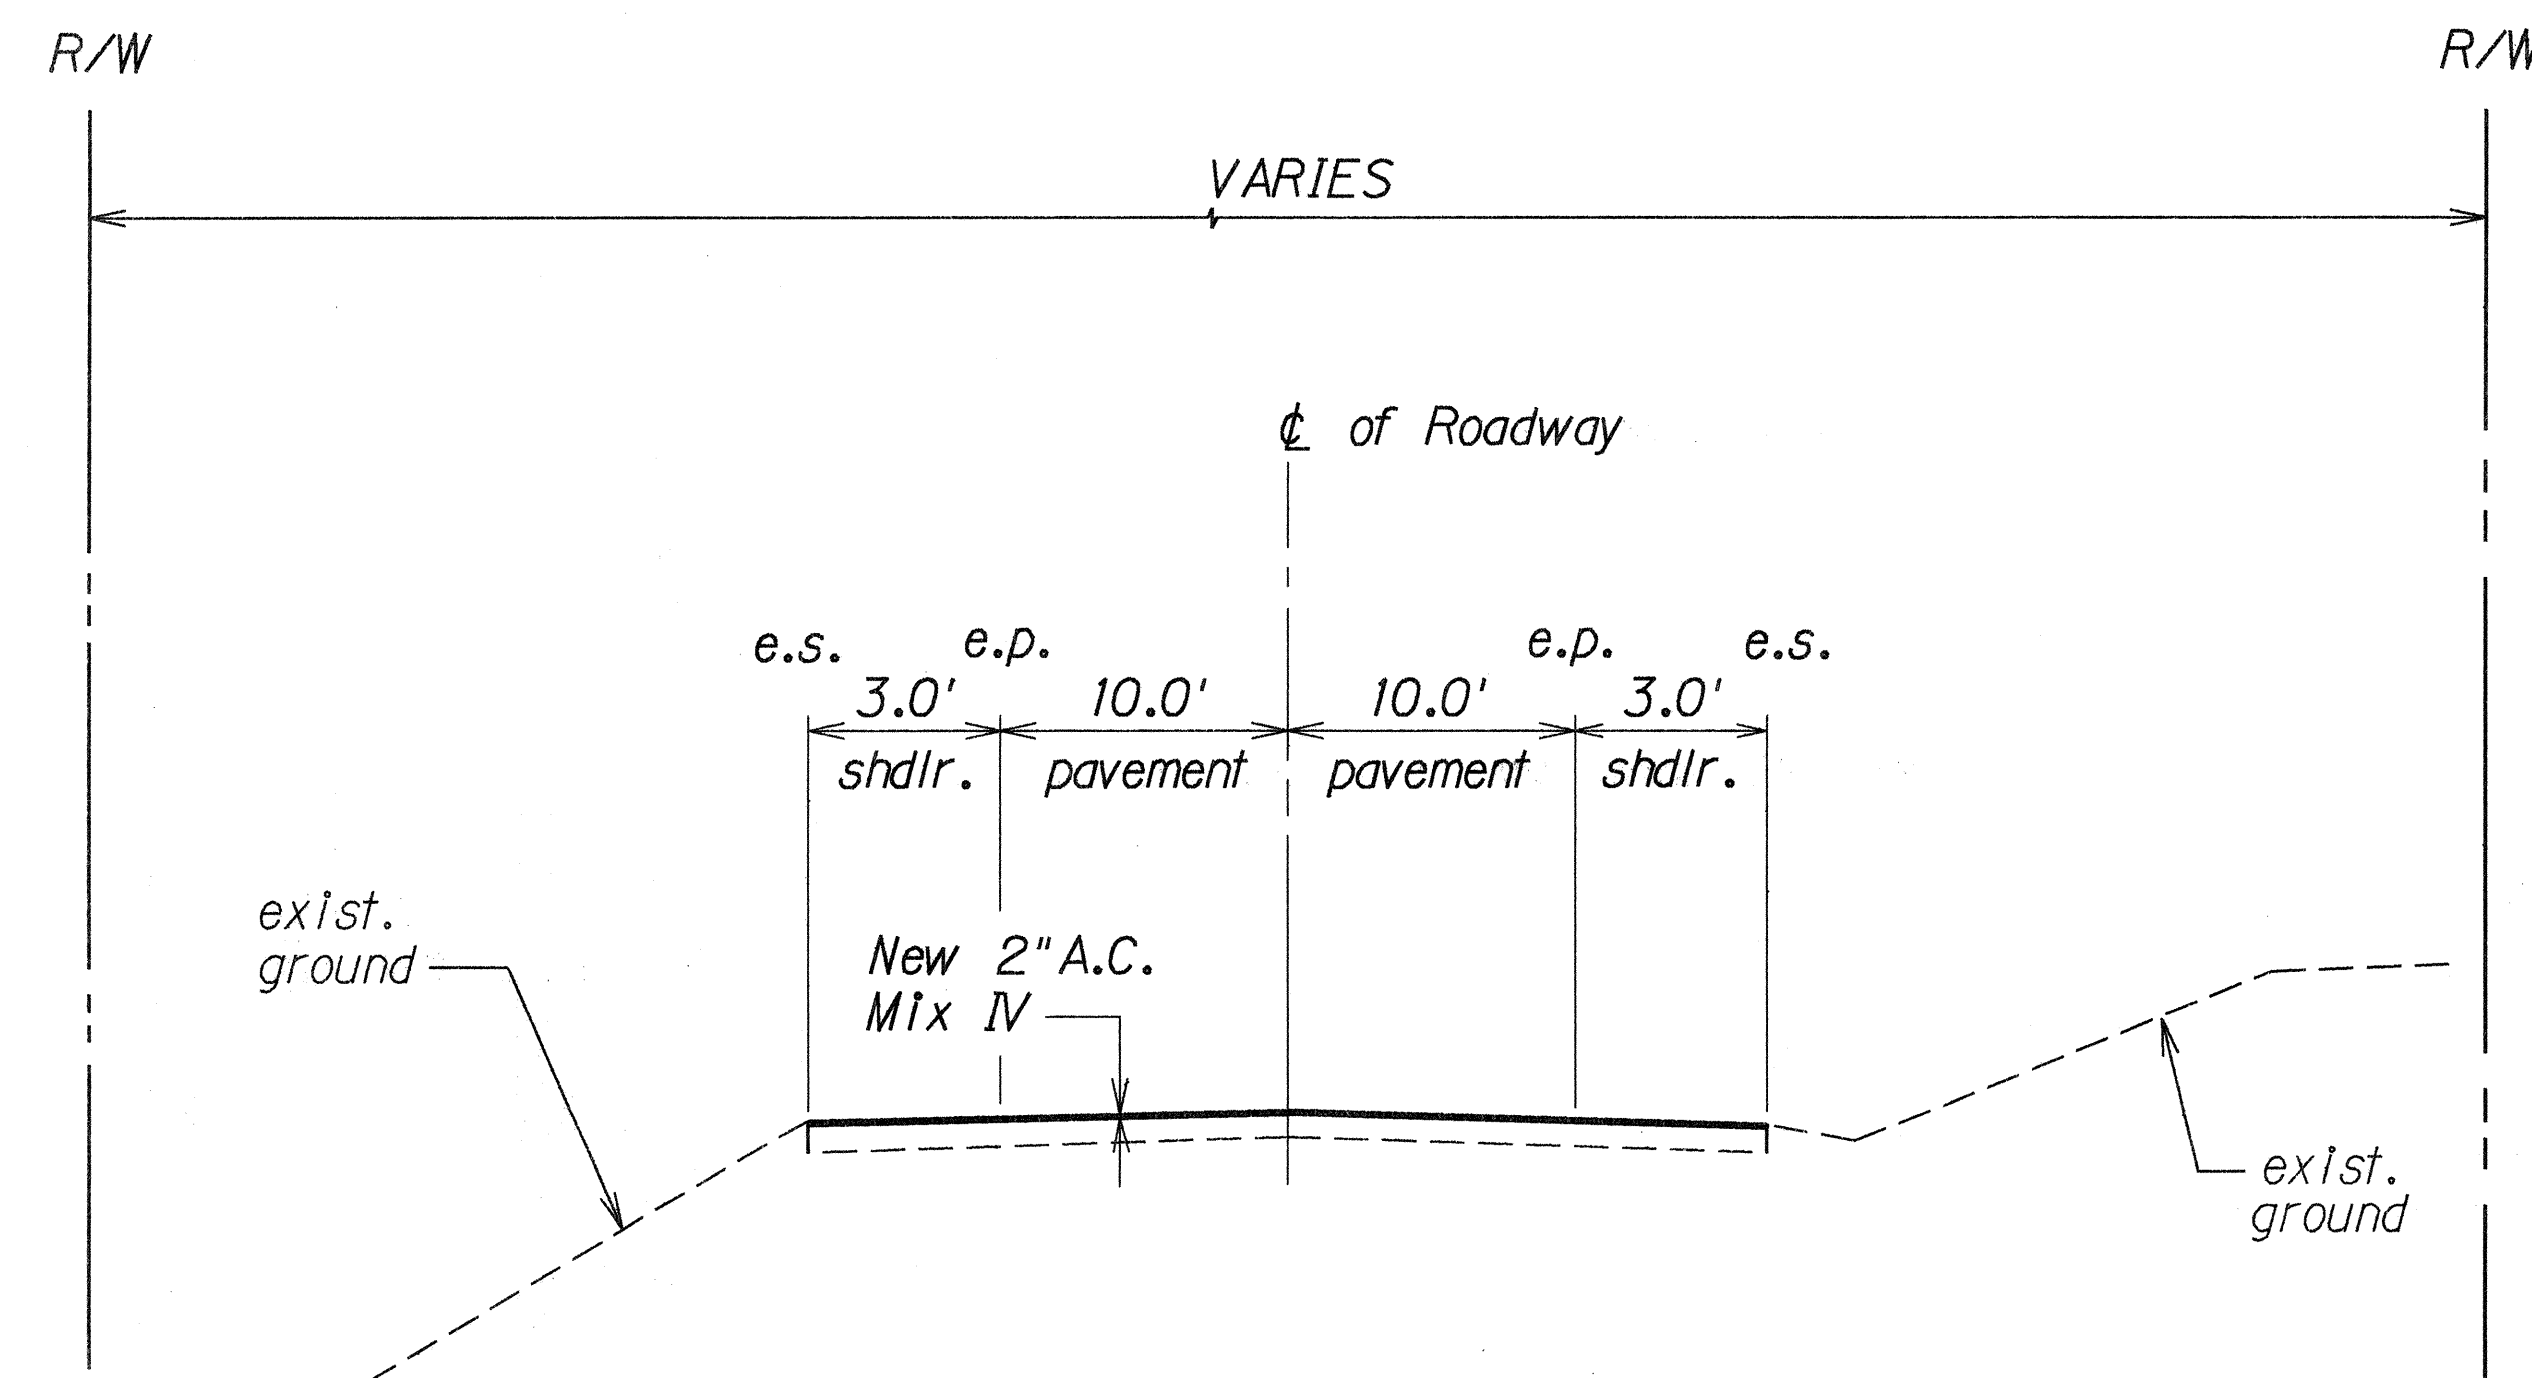

TYPICAL SECTION
END OF PROJECT M.P. 103.0
STA. 222+50 TO STA. 389+89.15
 Not To Scale

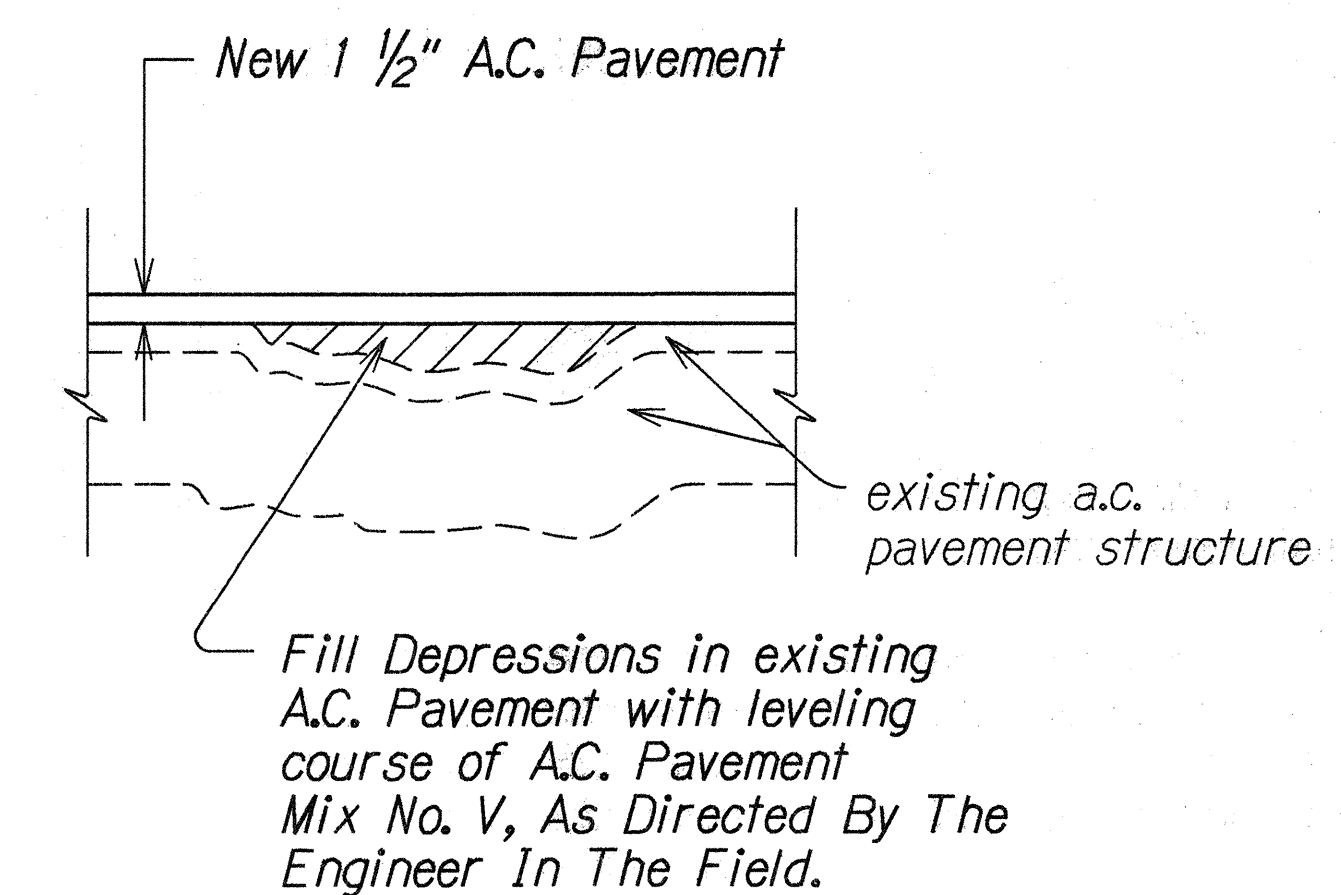

PAVEMENT DETAIL "A"
 Not To Scale

STATE OF HAWAII
 DEPARTMENT OF TRANSPORTATION
 HIGHWAYS DIVISION

TYPICAL SECTION

HAWAII BELT ROAD RESURFACING
KEALAKEKUA TO KIILAE
PROJECT NO. 11B-01-96M

Scale: As Shown Date: May, 1996

SHEET No. 1 OF 1 SHEETS