



FED. ROAD DIST. NO.	STATE	FED. AID PROJ. NO.	FISCAL YEAR	SHEET NO.	TOTAL SHEETS
HAWAII	HAW.	NH-011-2(33)	1996	86	102

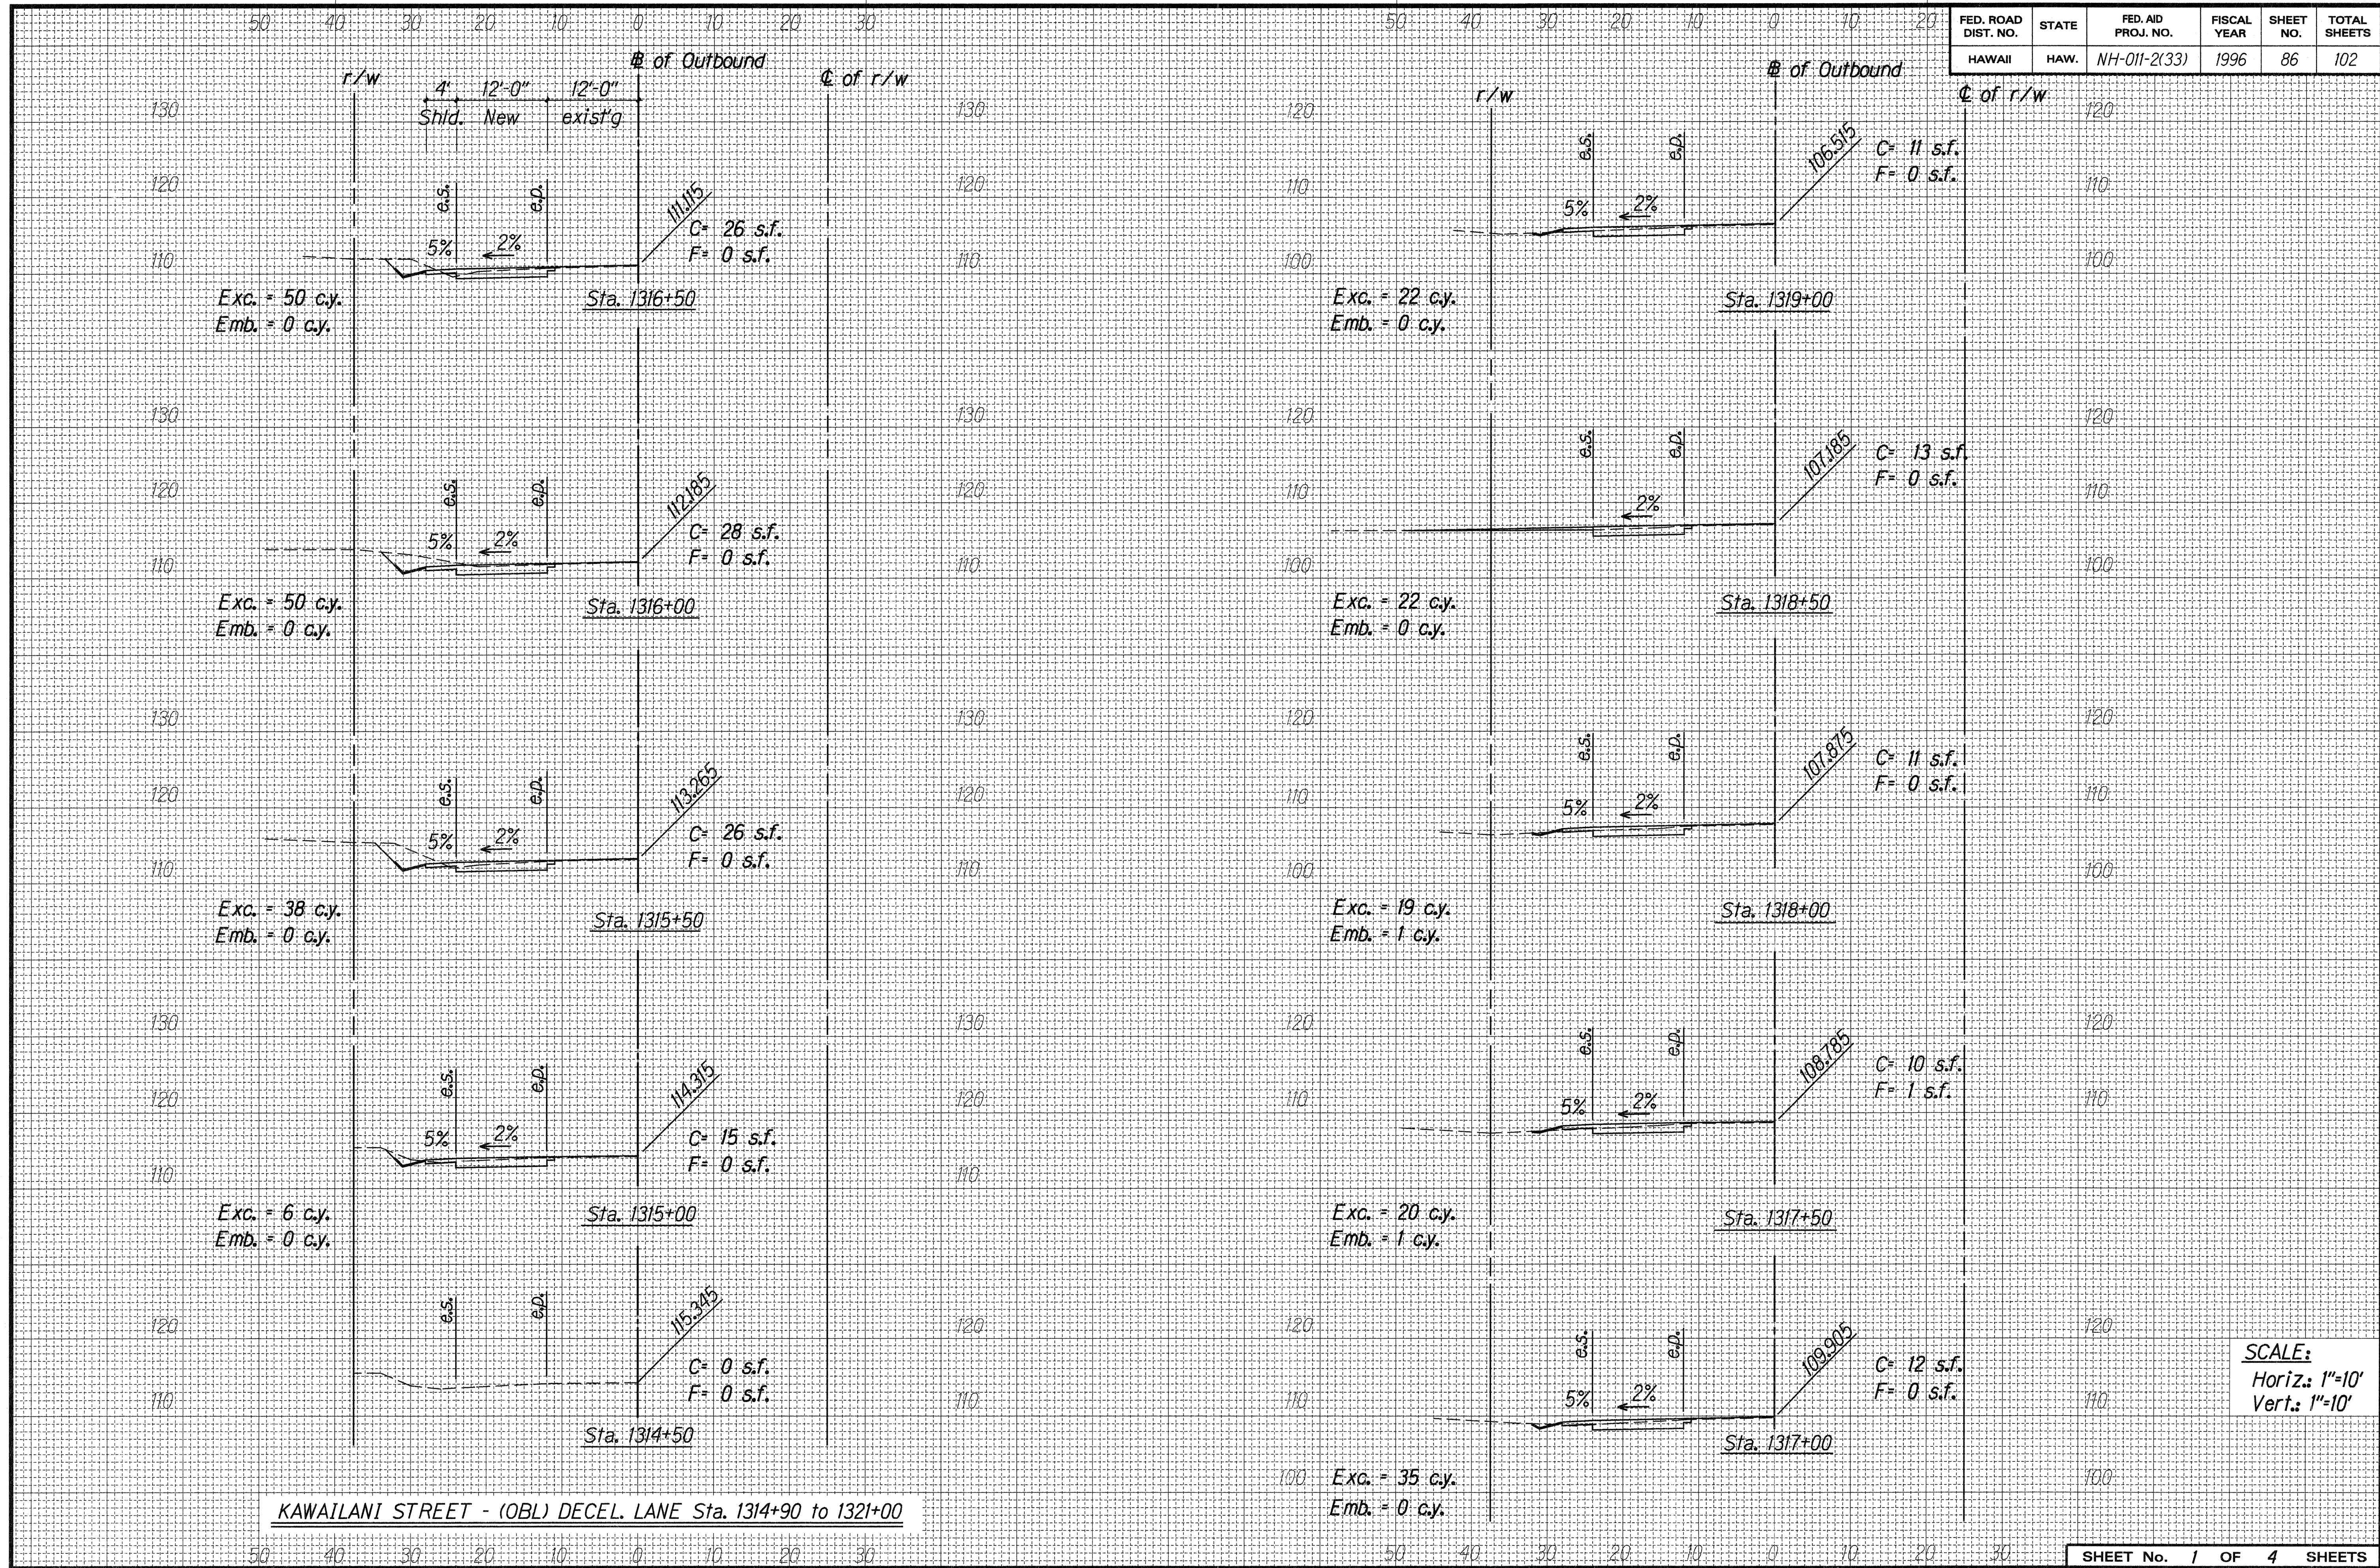



FED. ROAD DIST. NO.	STATE	FED. AID PROJ. NO.	FISCAL YEAR	SHEET NO.	TOTAL SHEETS
HAWAII	HAW.	NH-011-2(33)	1996	87	102

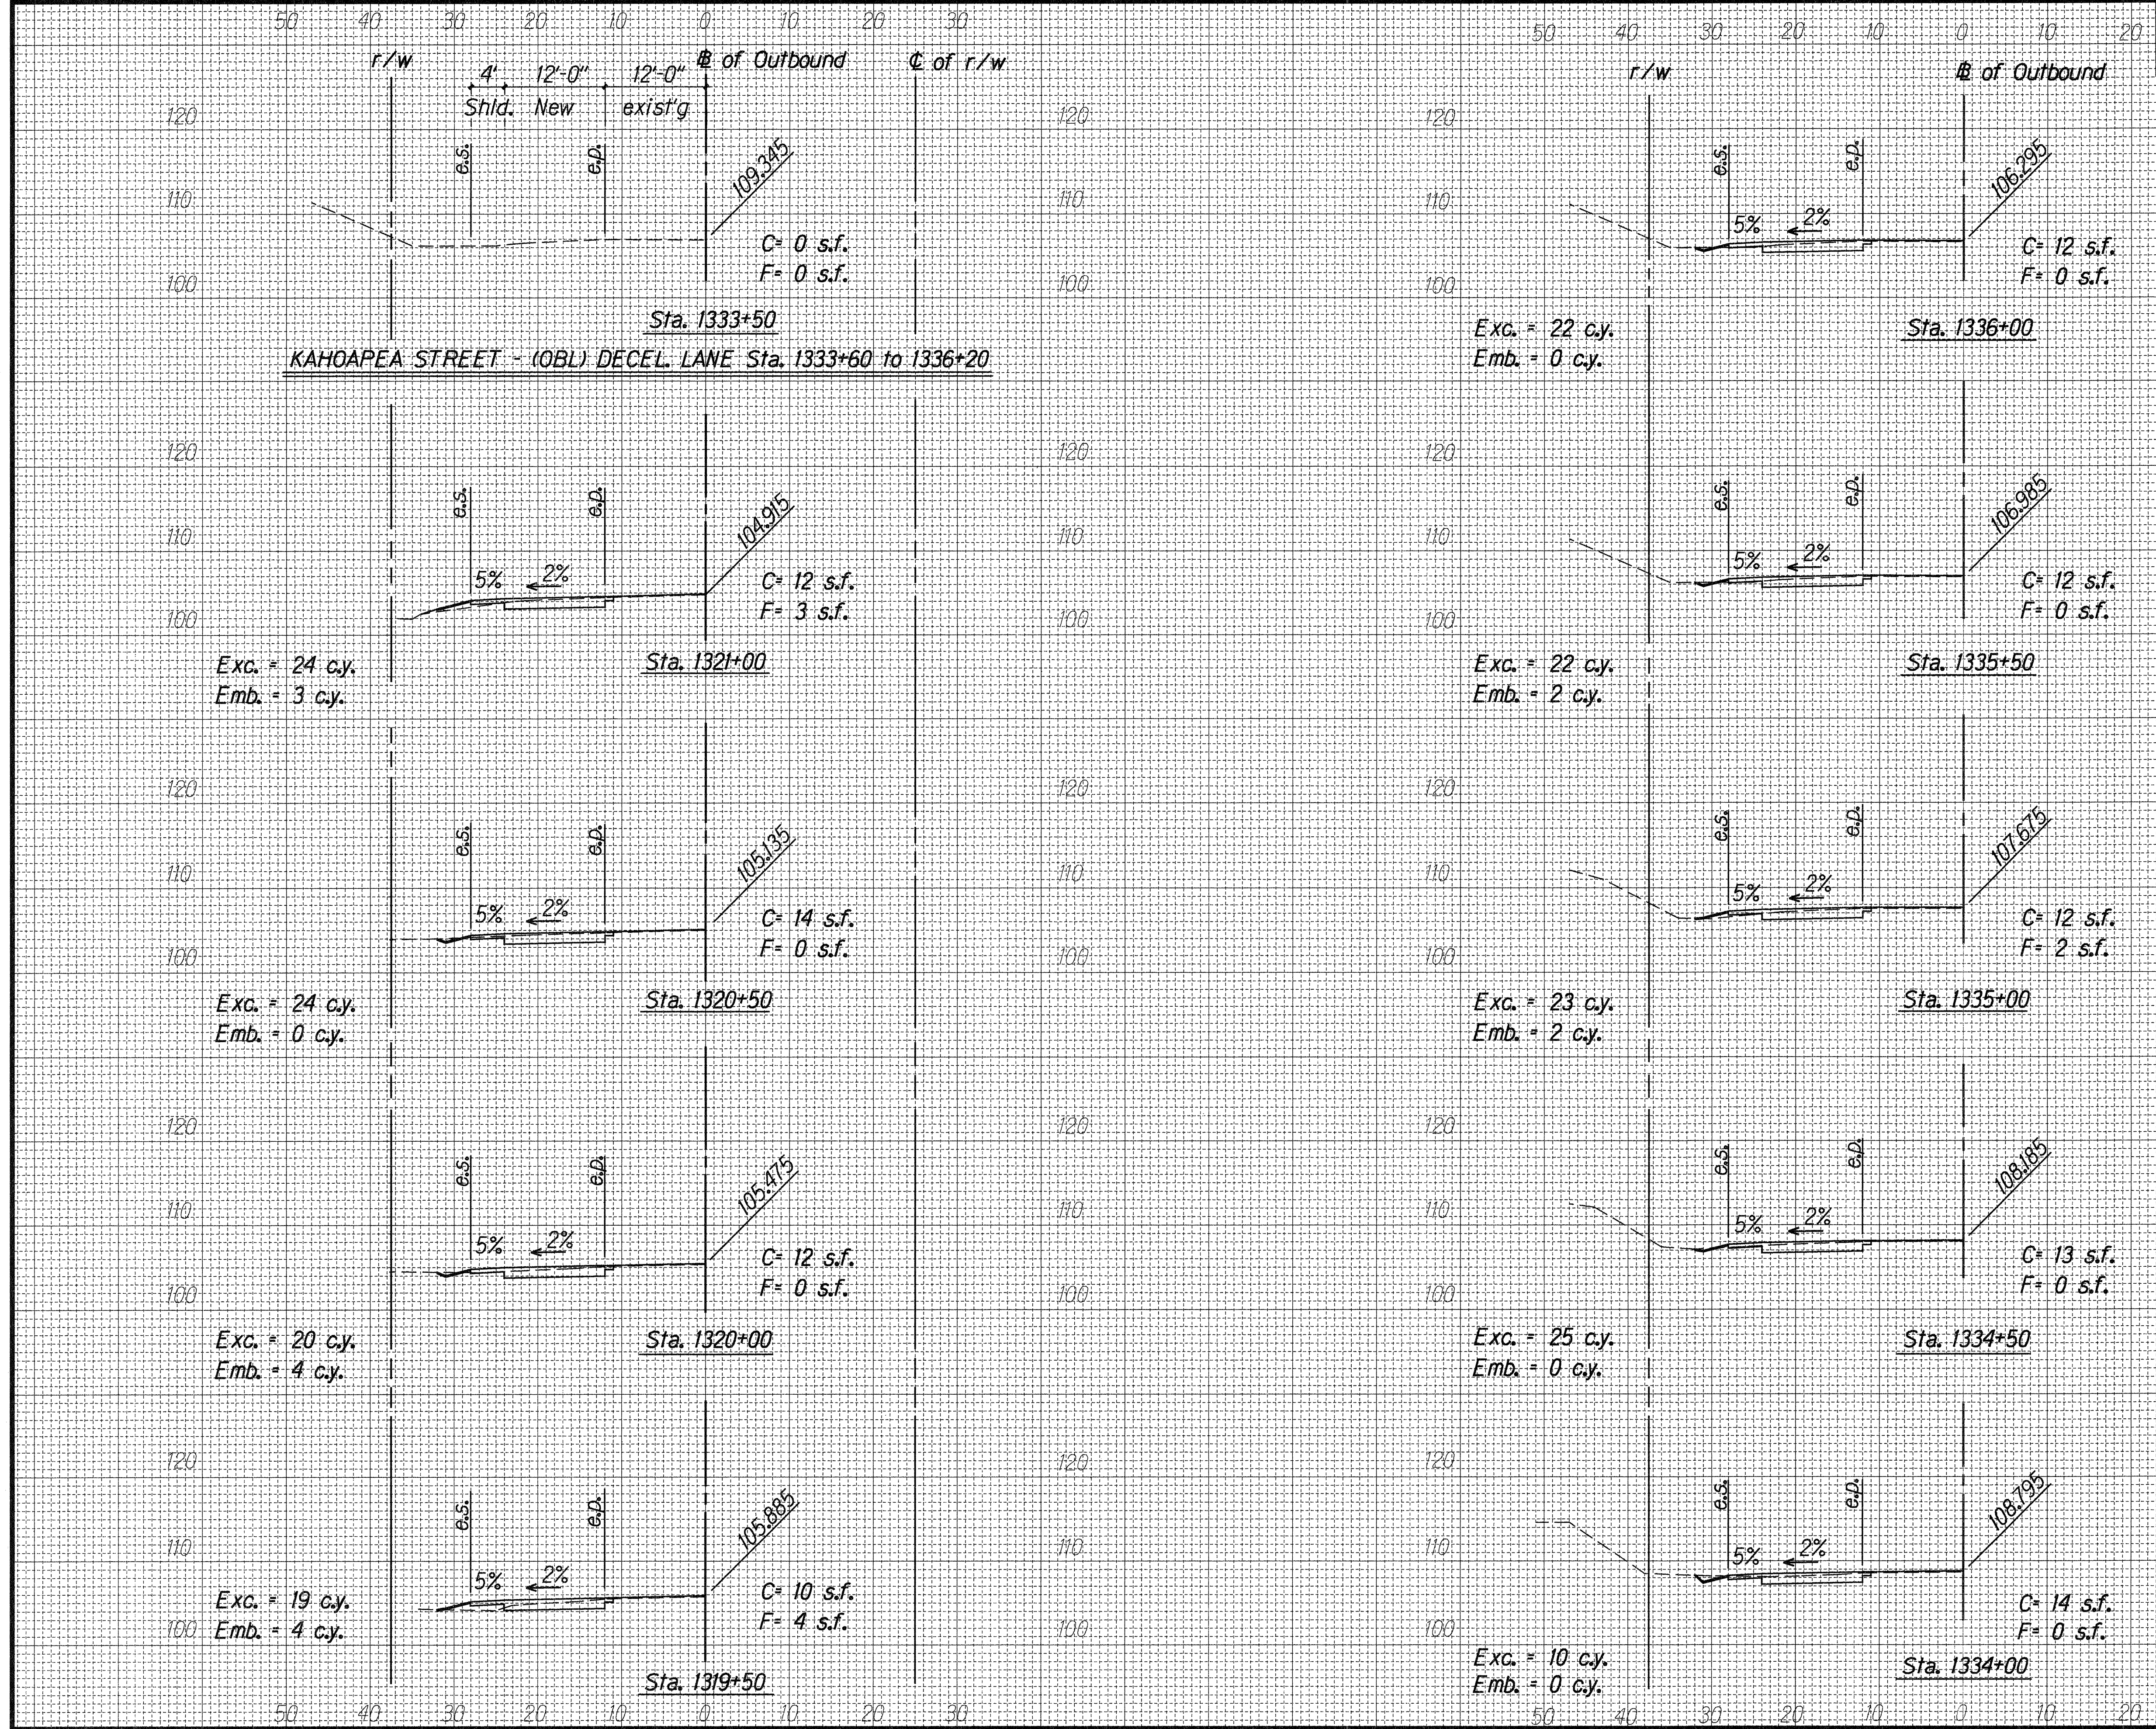

ORIGINAL PLAN	DATE	1/96
SURVEY DICTATED BY	DRAWN BY	
TRACED BY	DESIGNED BY	
NOTED BY	CHECKED BY	
004	3/19/96	

SCALE:
 Horiz.: 1"=10'
 Vert.: 1"=10'



FED. ROAD DIST. NO.	STATE	FED. AID PROJ. NO.	FISCAL YEAR	SHEET NO.	TOTAL SHEETS
HAWAII	HAW.	NH-011-2(33)	1996	88	102

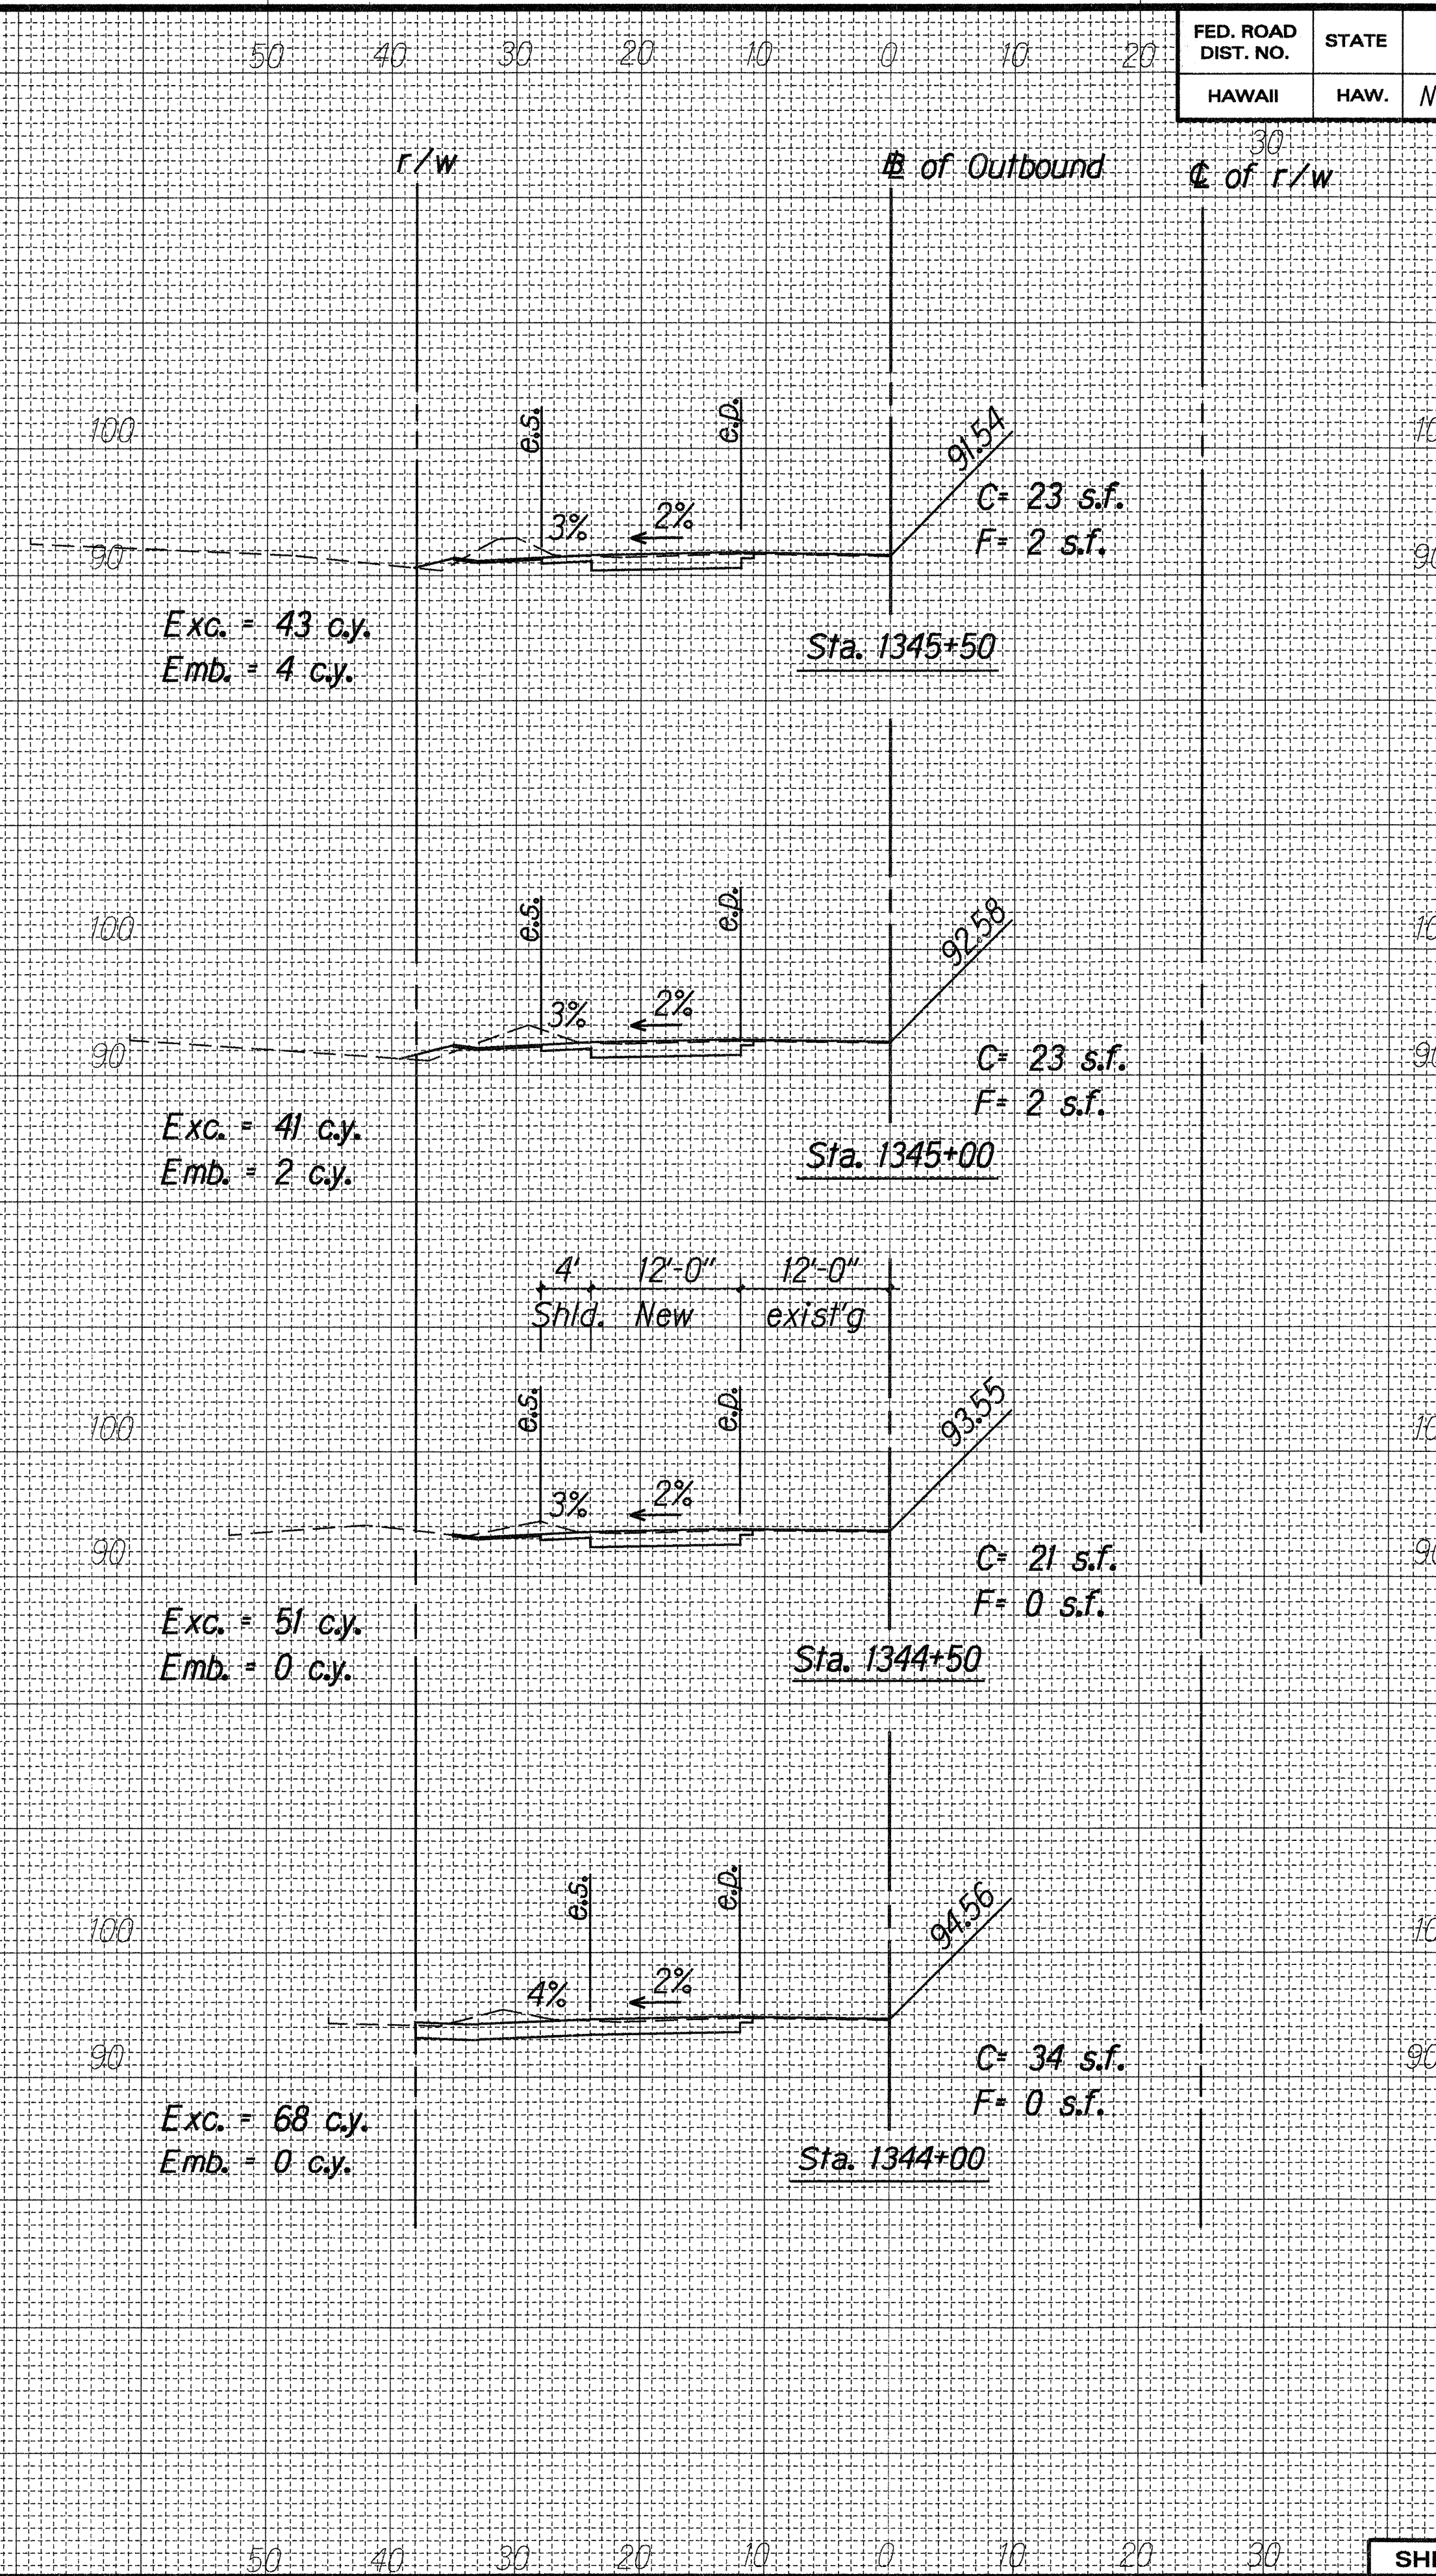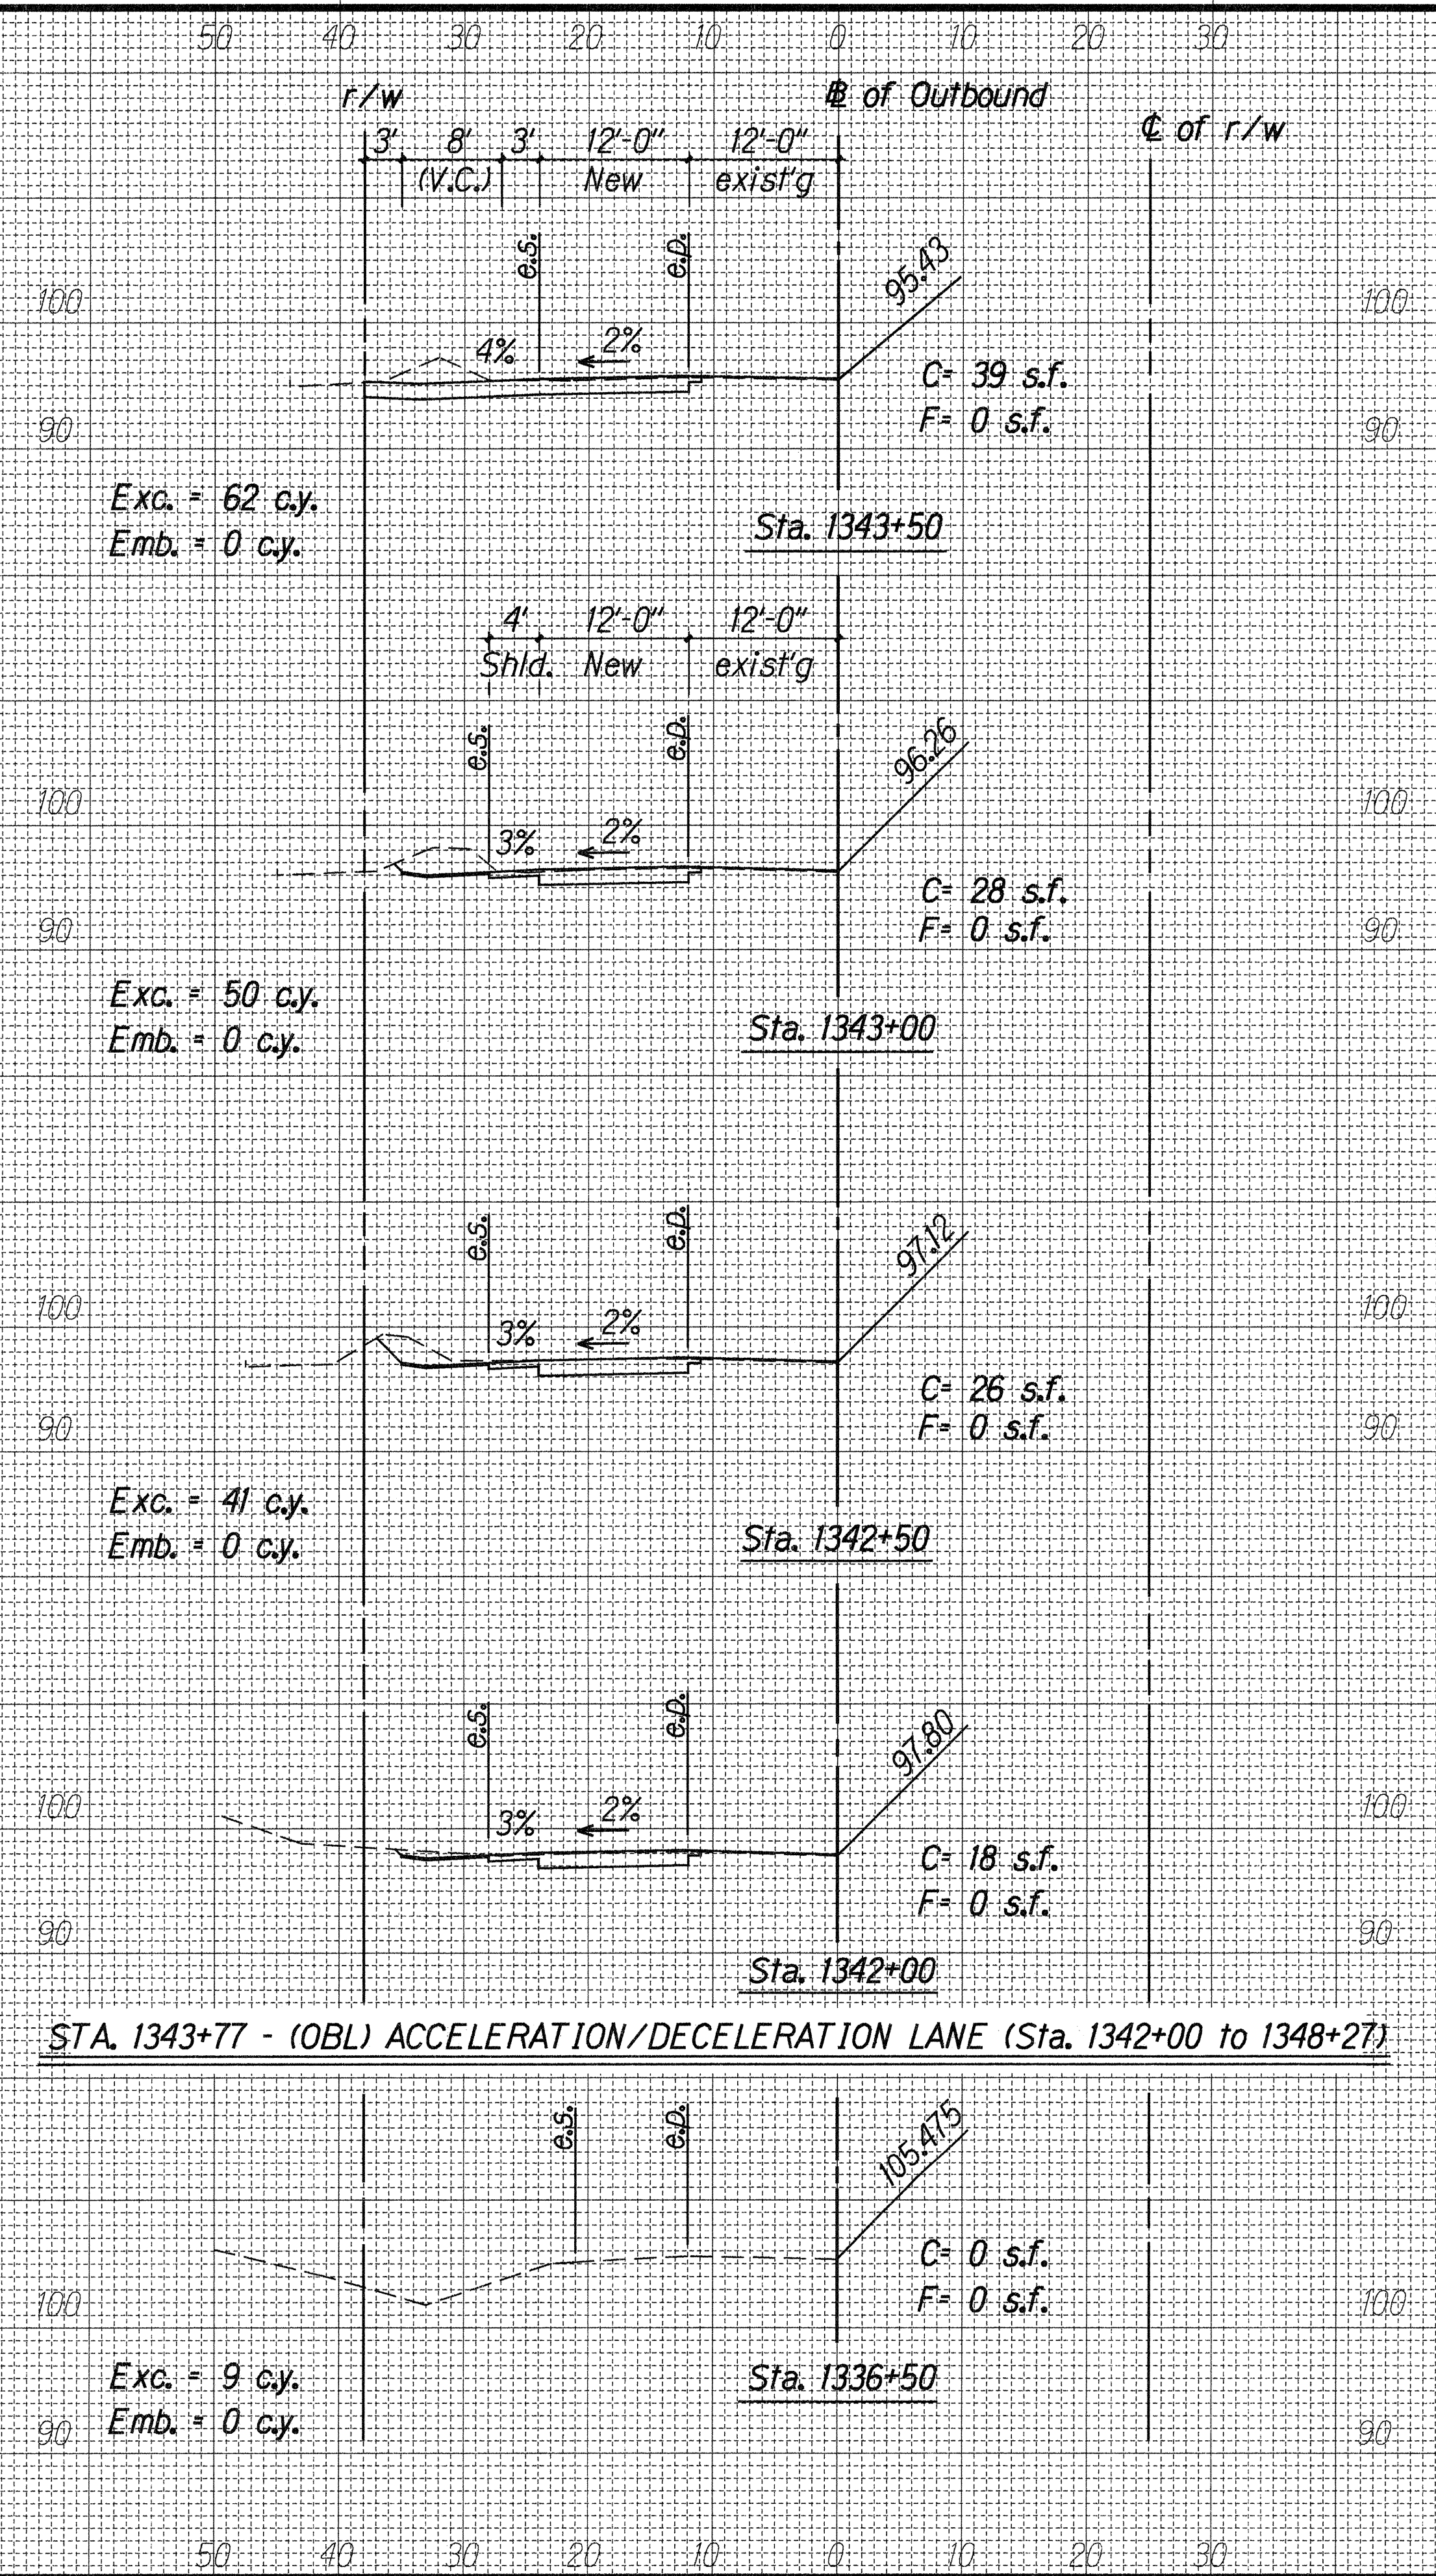

DESIGNED BY	DATE
DRAWN BY	1/96
CHECKED BY	
IN CHARGE	
QUANTITY BY	
REVISIONS BY	

SCALE:
Horiz.: 1"=10'
Vert.: 1"=10'

FED. ROAD DIST. NO.	STATE	FED. AID PROJ. NO.	FISCAL YEAR	SHEET NO.	TOTAL SHEETS
HAWAII	HAW.	NH-011-2(33)	1996	89	102

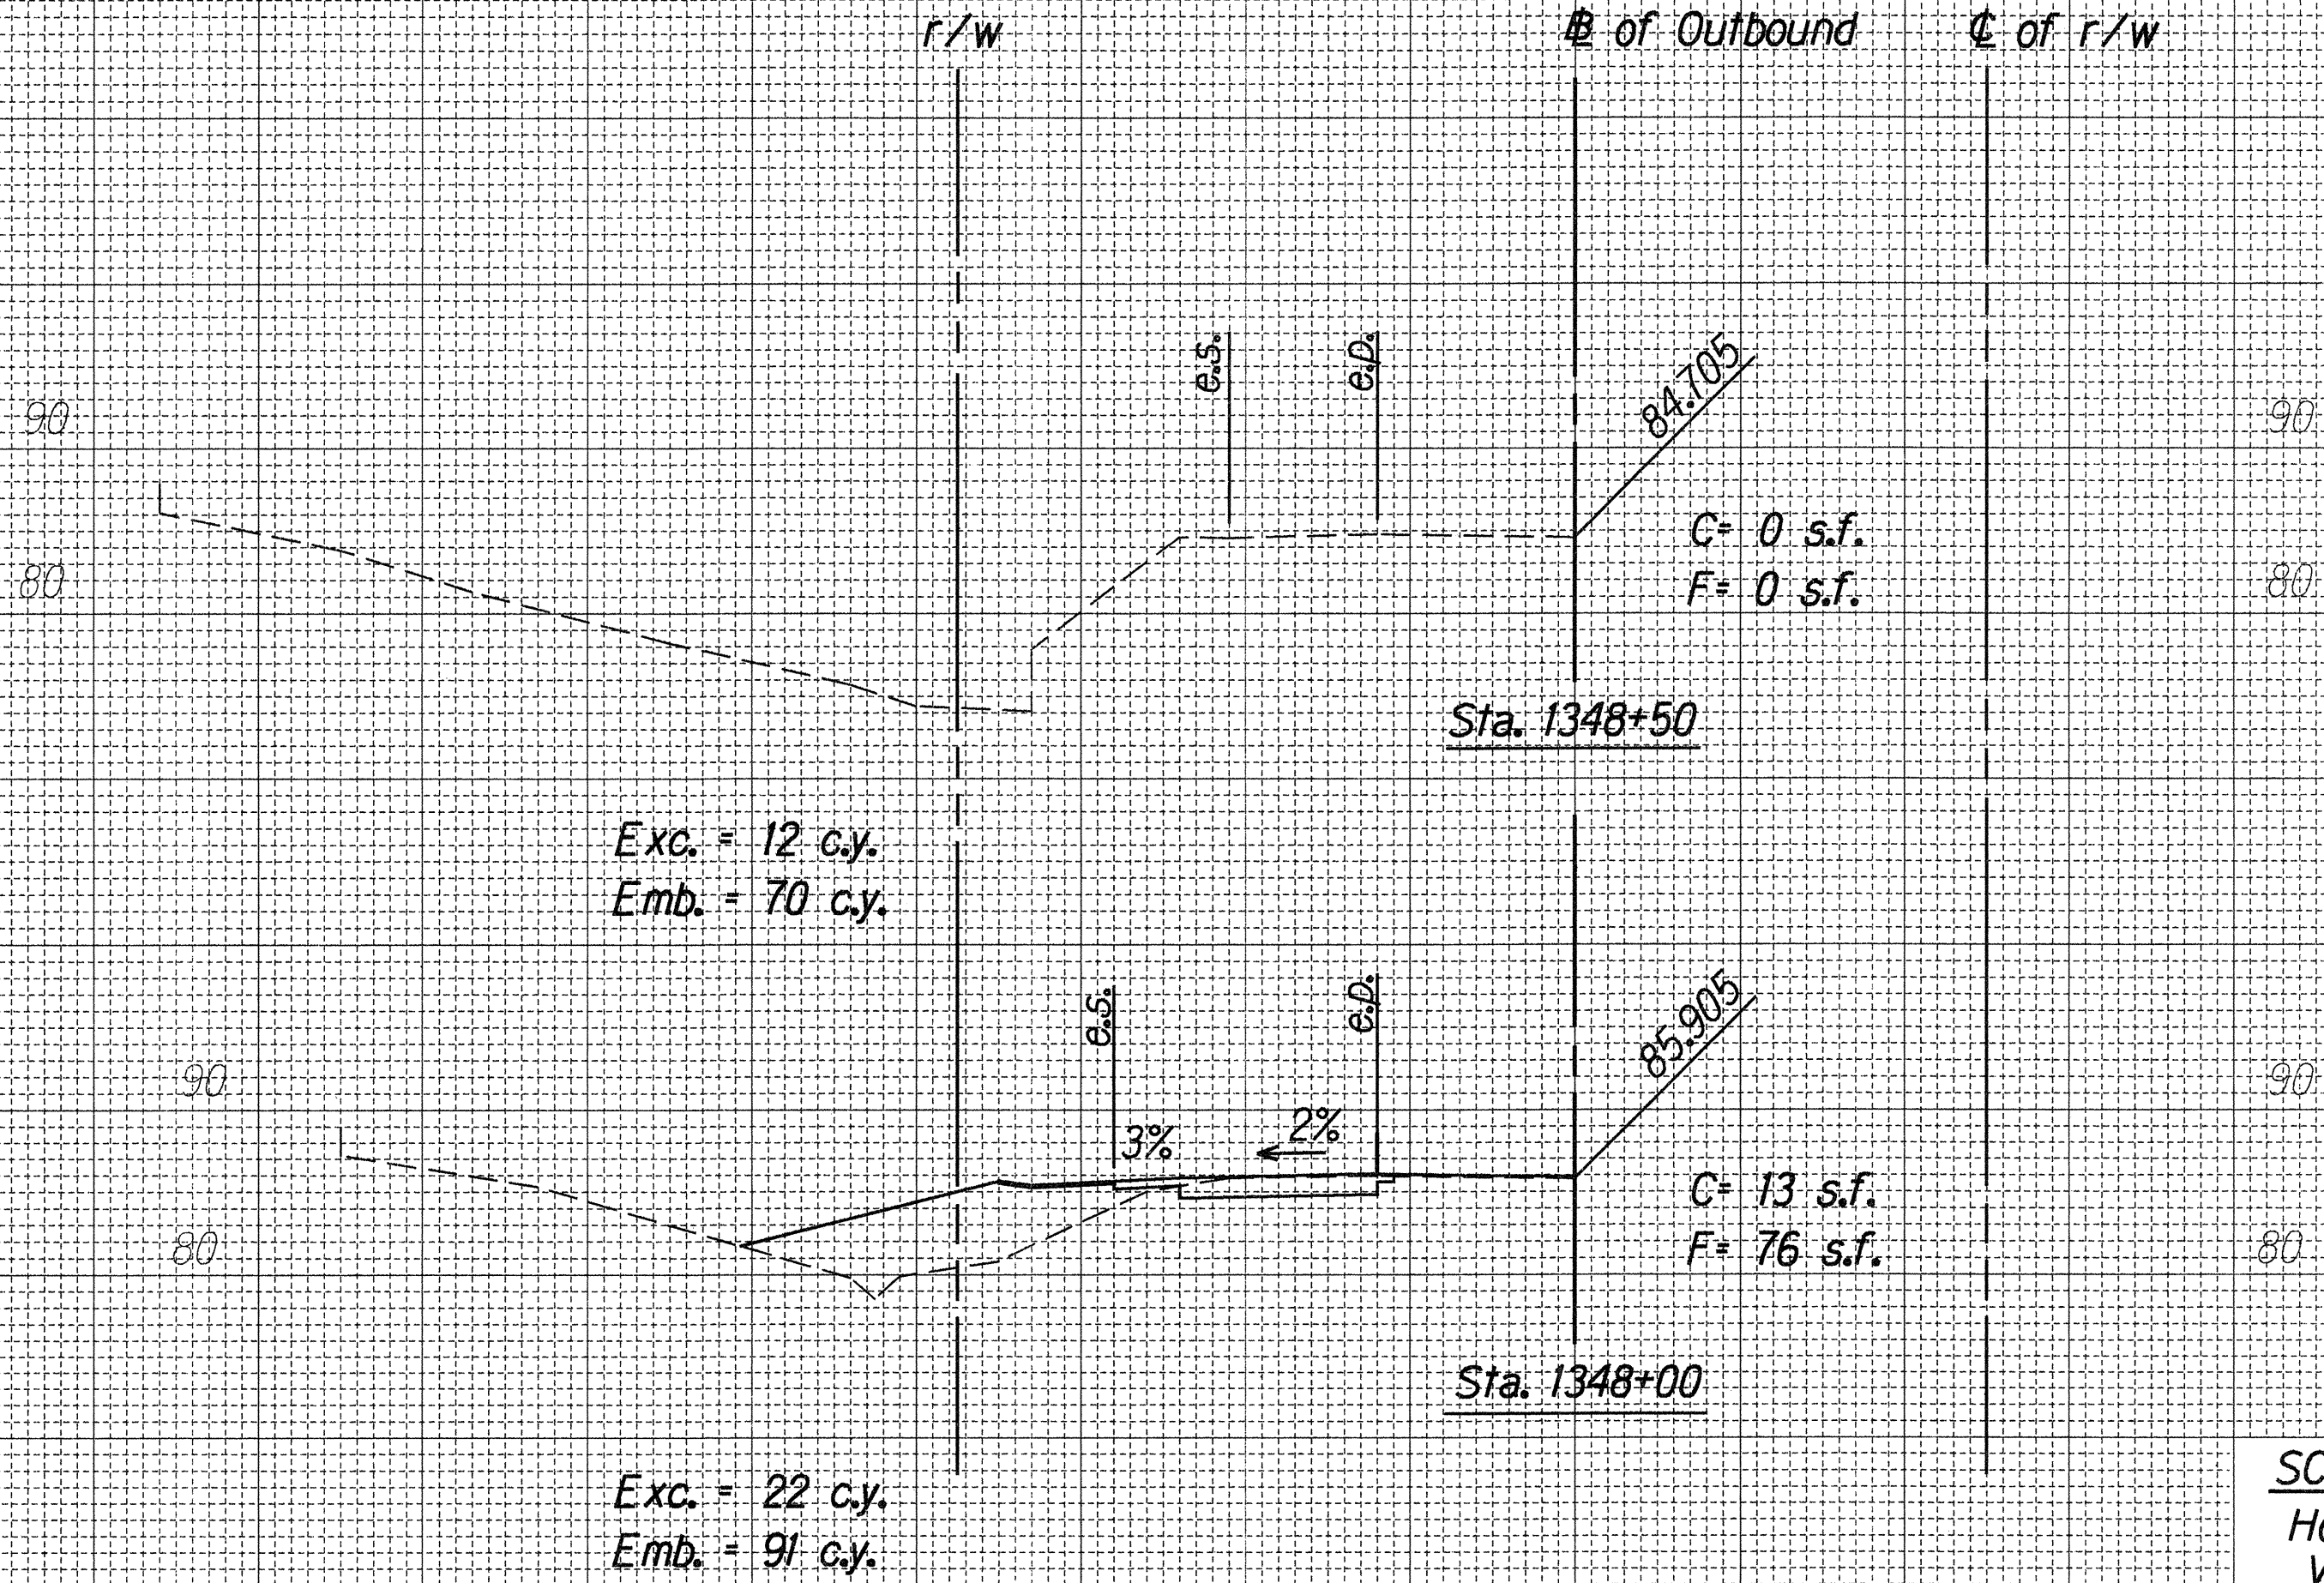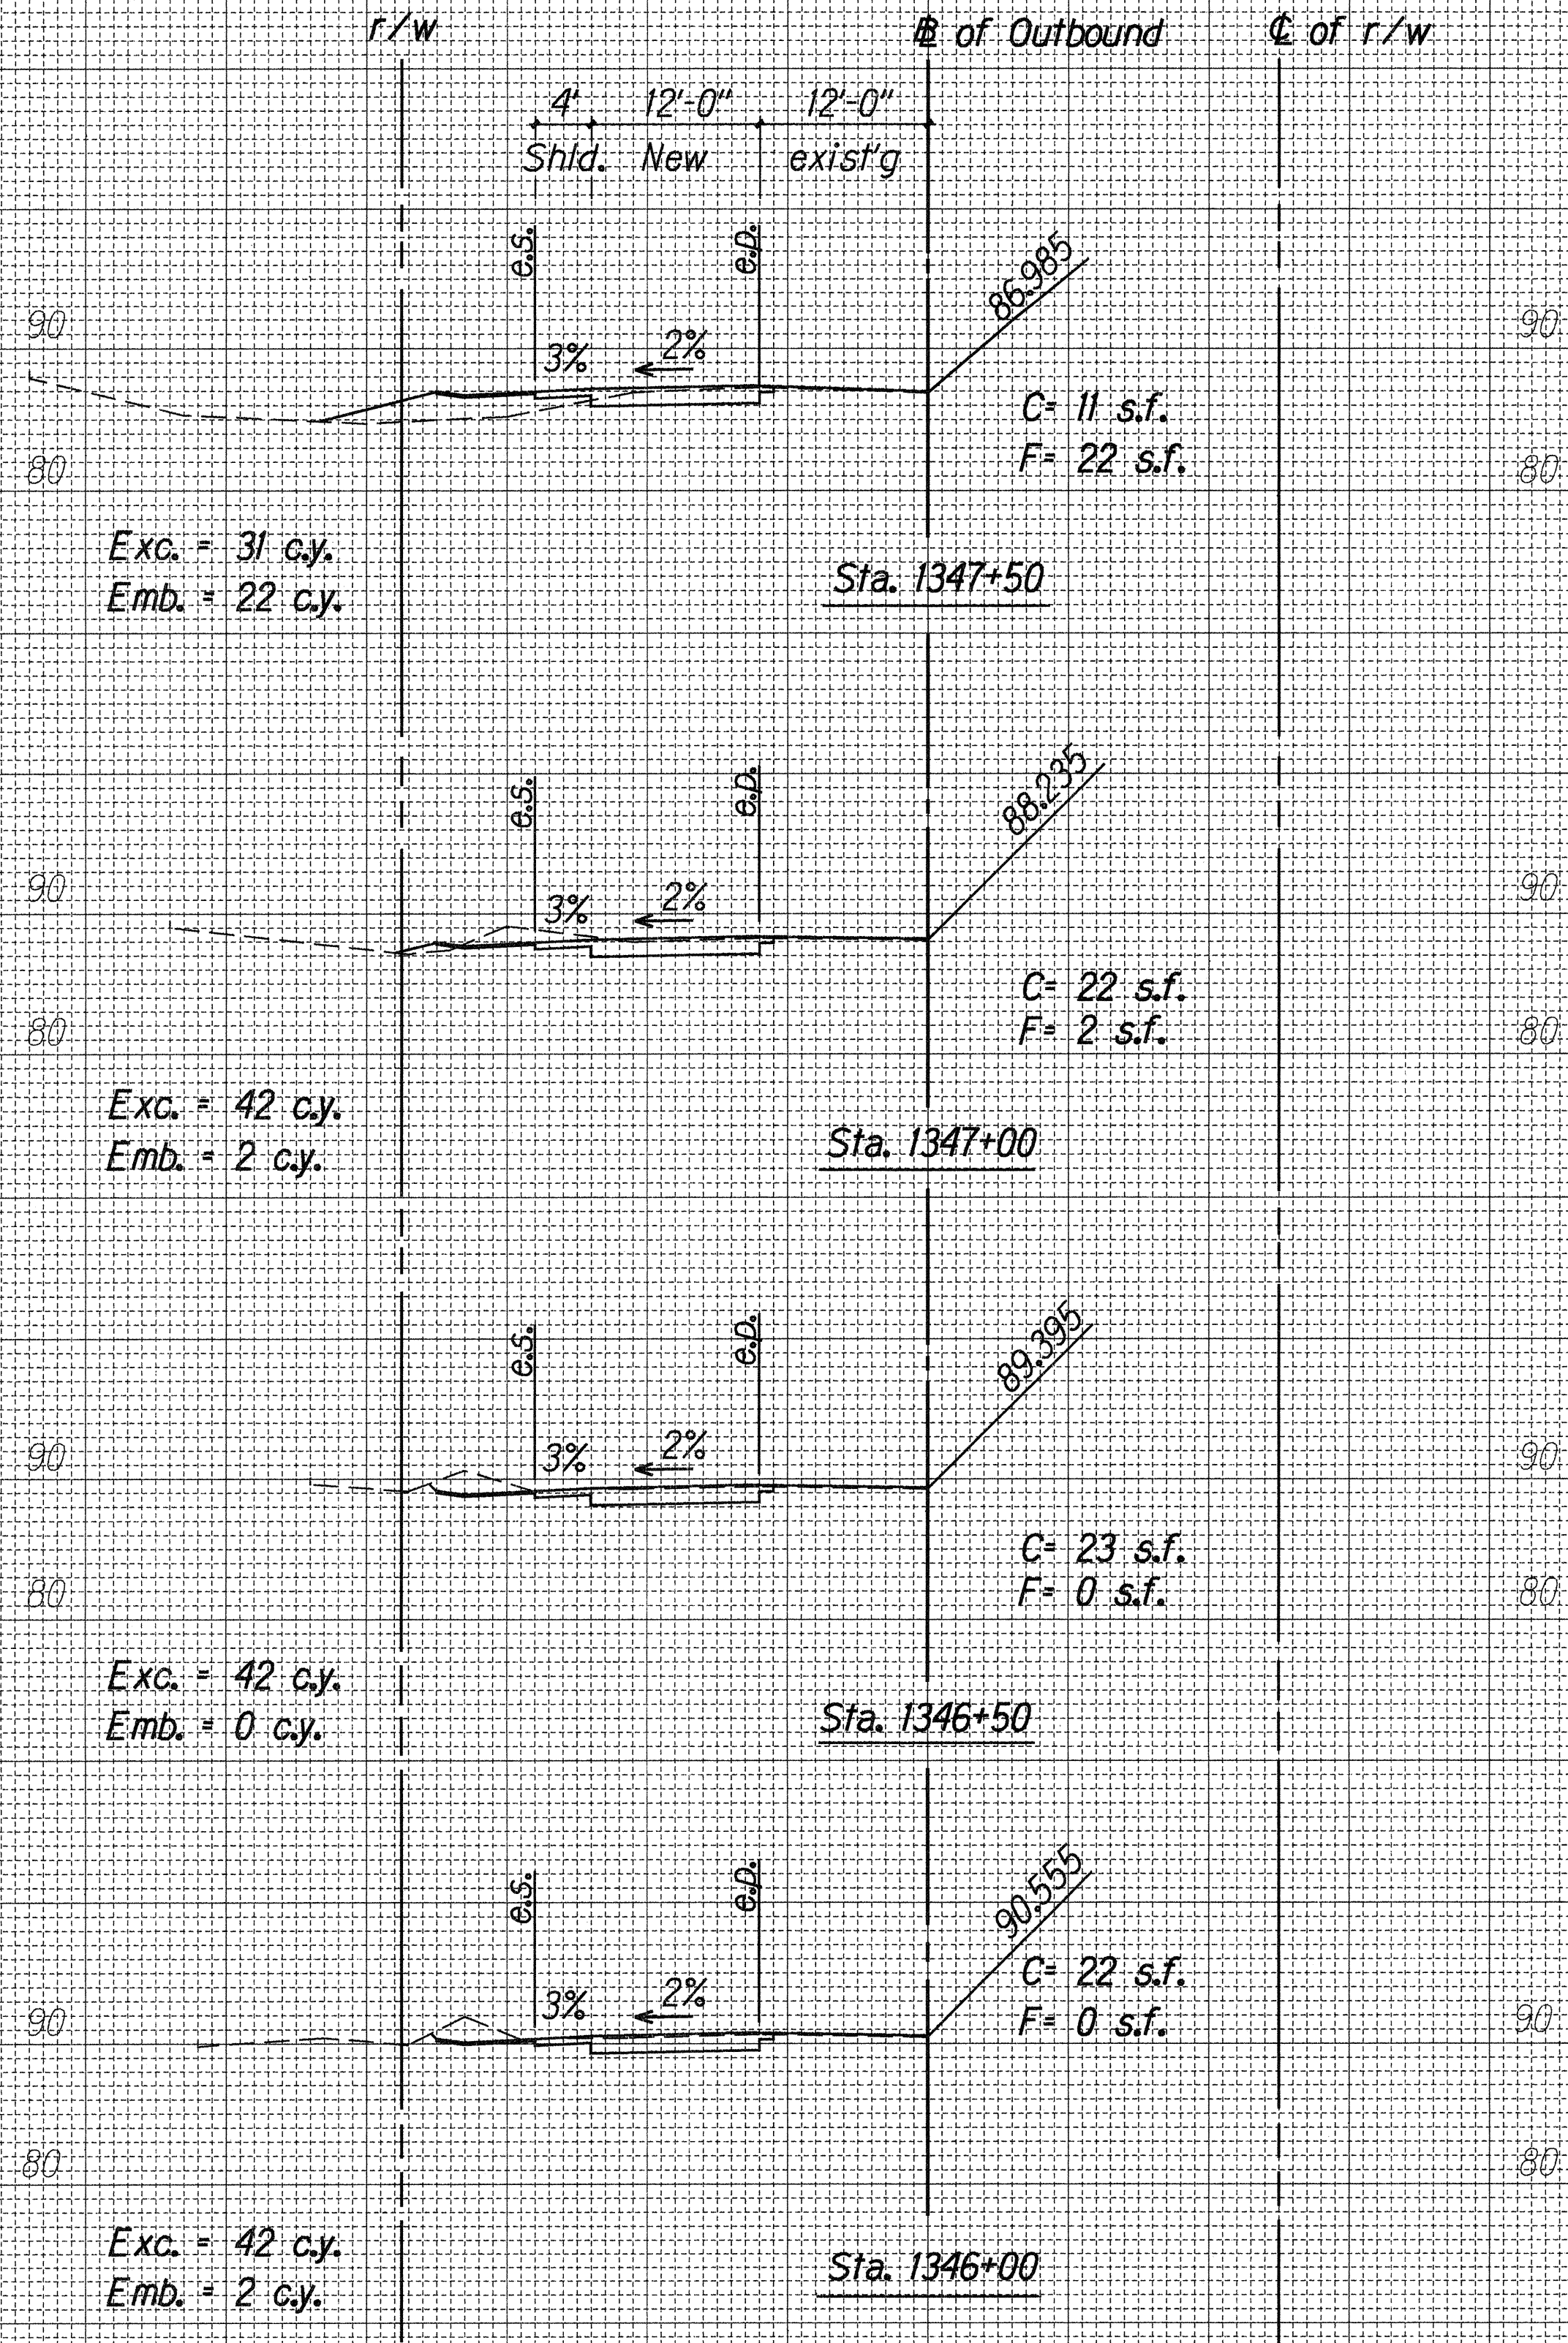

SCALE:
 Horiz.: 1"=10'
 Vert.: 1"=10'

ORIGINAL PLAN	DATE 1/96
SURVEY DICTATED BY	
DRAWN BY	
DESIGNED BY	
CHECKED BY	
IN CHARGE	
NO. 3/11/96	