


FED. ROAD DIST. NO.	STATE	FED. AID PROJ. NO.	FISCAL YEAR	SHEET NO.	TOTAL SHEETS
HAWAII	HAW.	NH-011-2(33)	1996	34	102

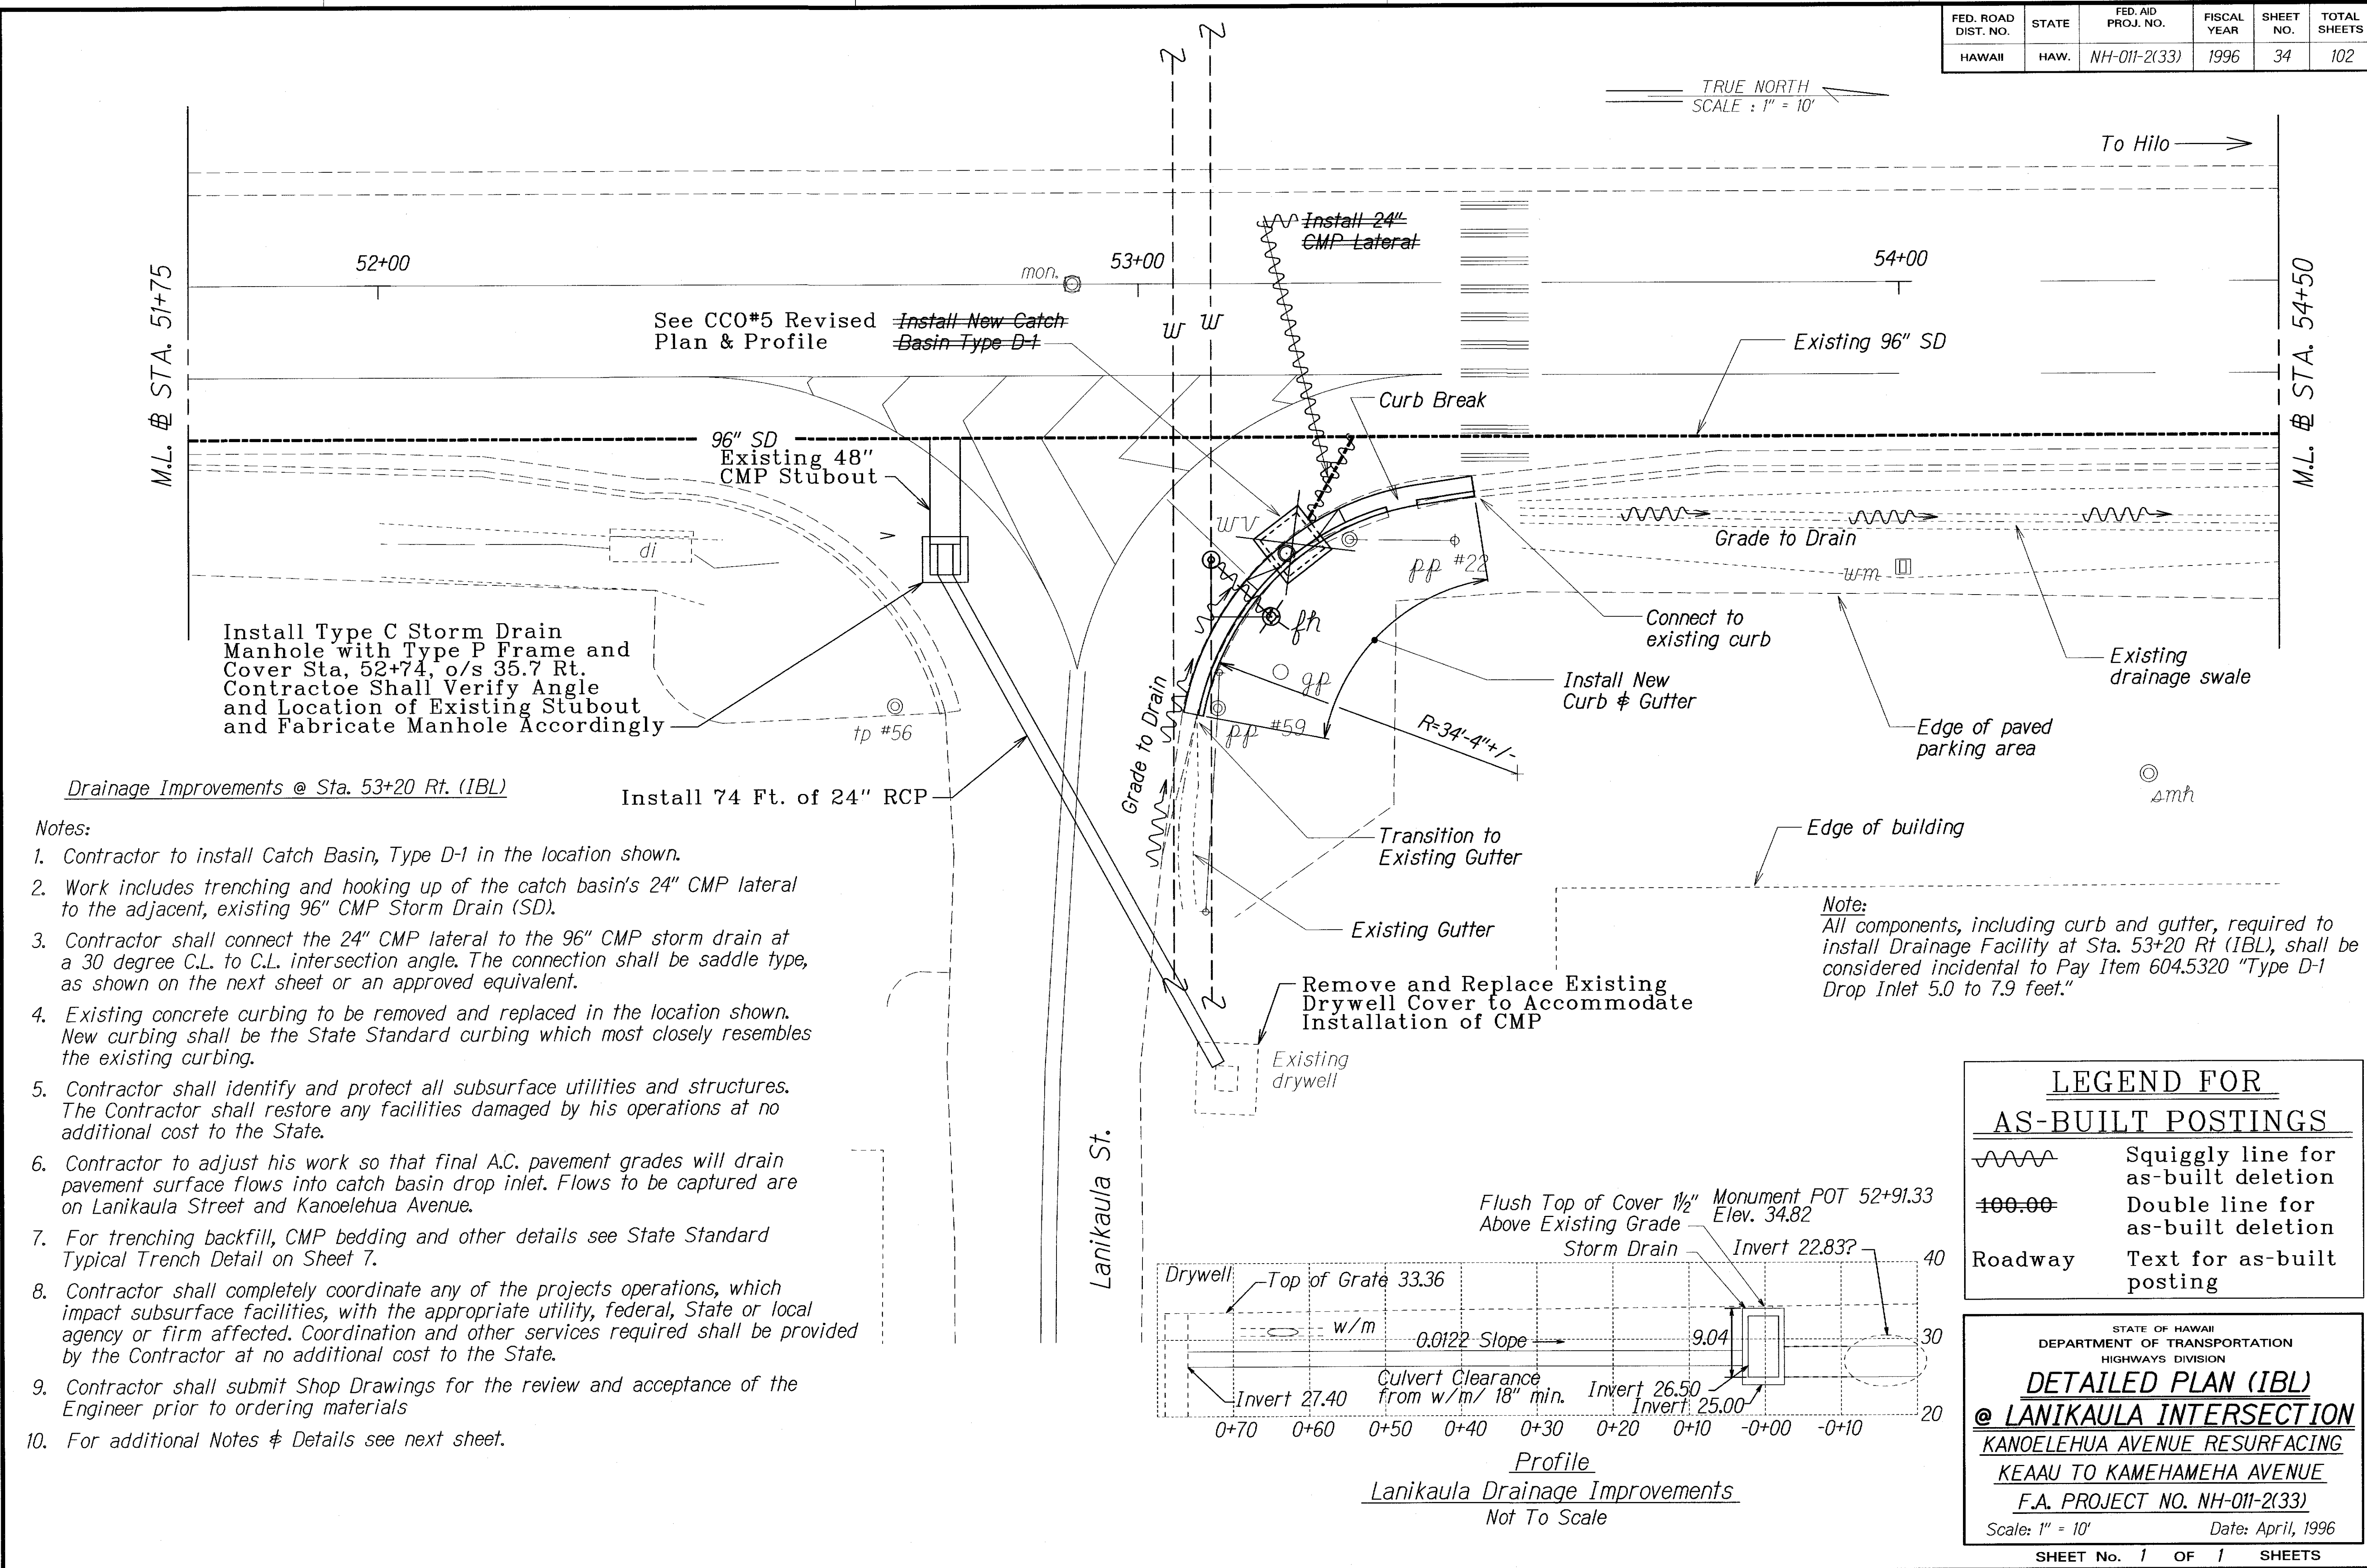

ORIGINAL PLAN	DATE	4/96
DESIGNED BY		
NOTED BY		
QUANTITIES BY		
CHECKED BY		

"AS-BUILT"