


FED. ROAD DIST. NO.	STATE	FED. AID PROJ. NO.	FISCAL YEAR	SHEET NO.	TOTAL SHEETS
HAWAII	HAW.	NH-011-2(33)	1996	8	102

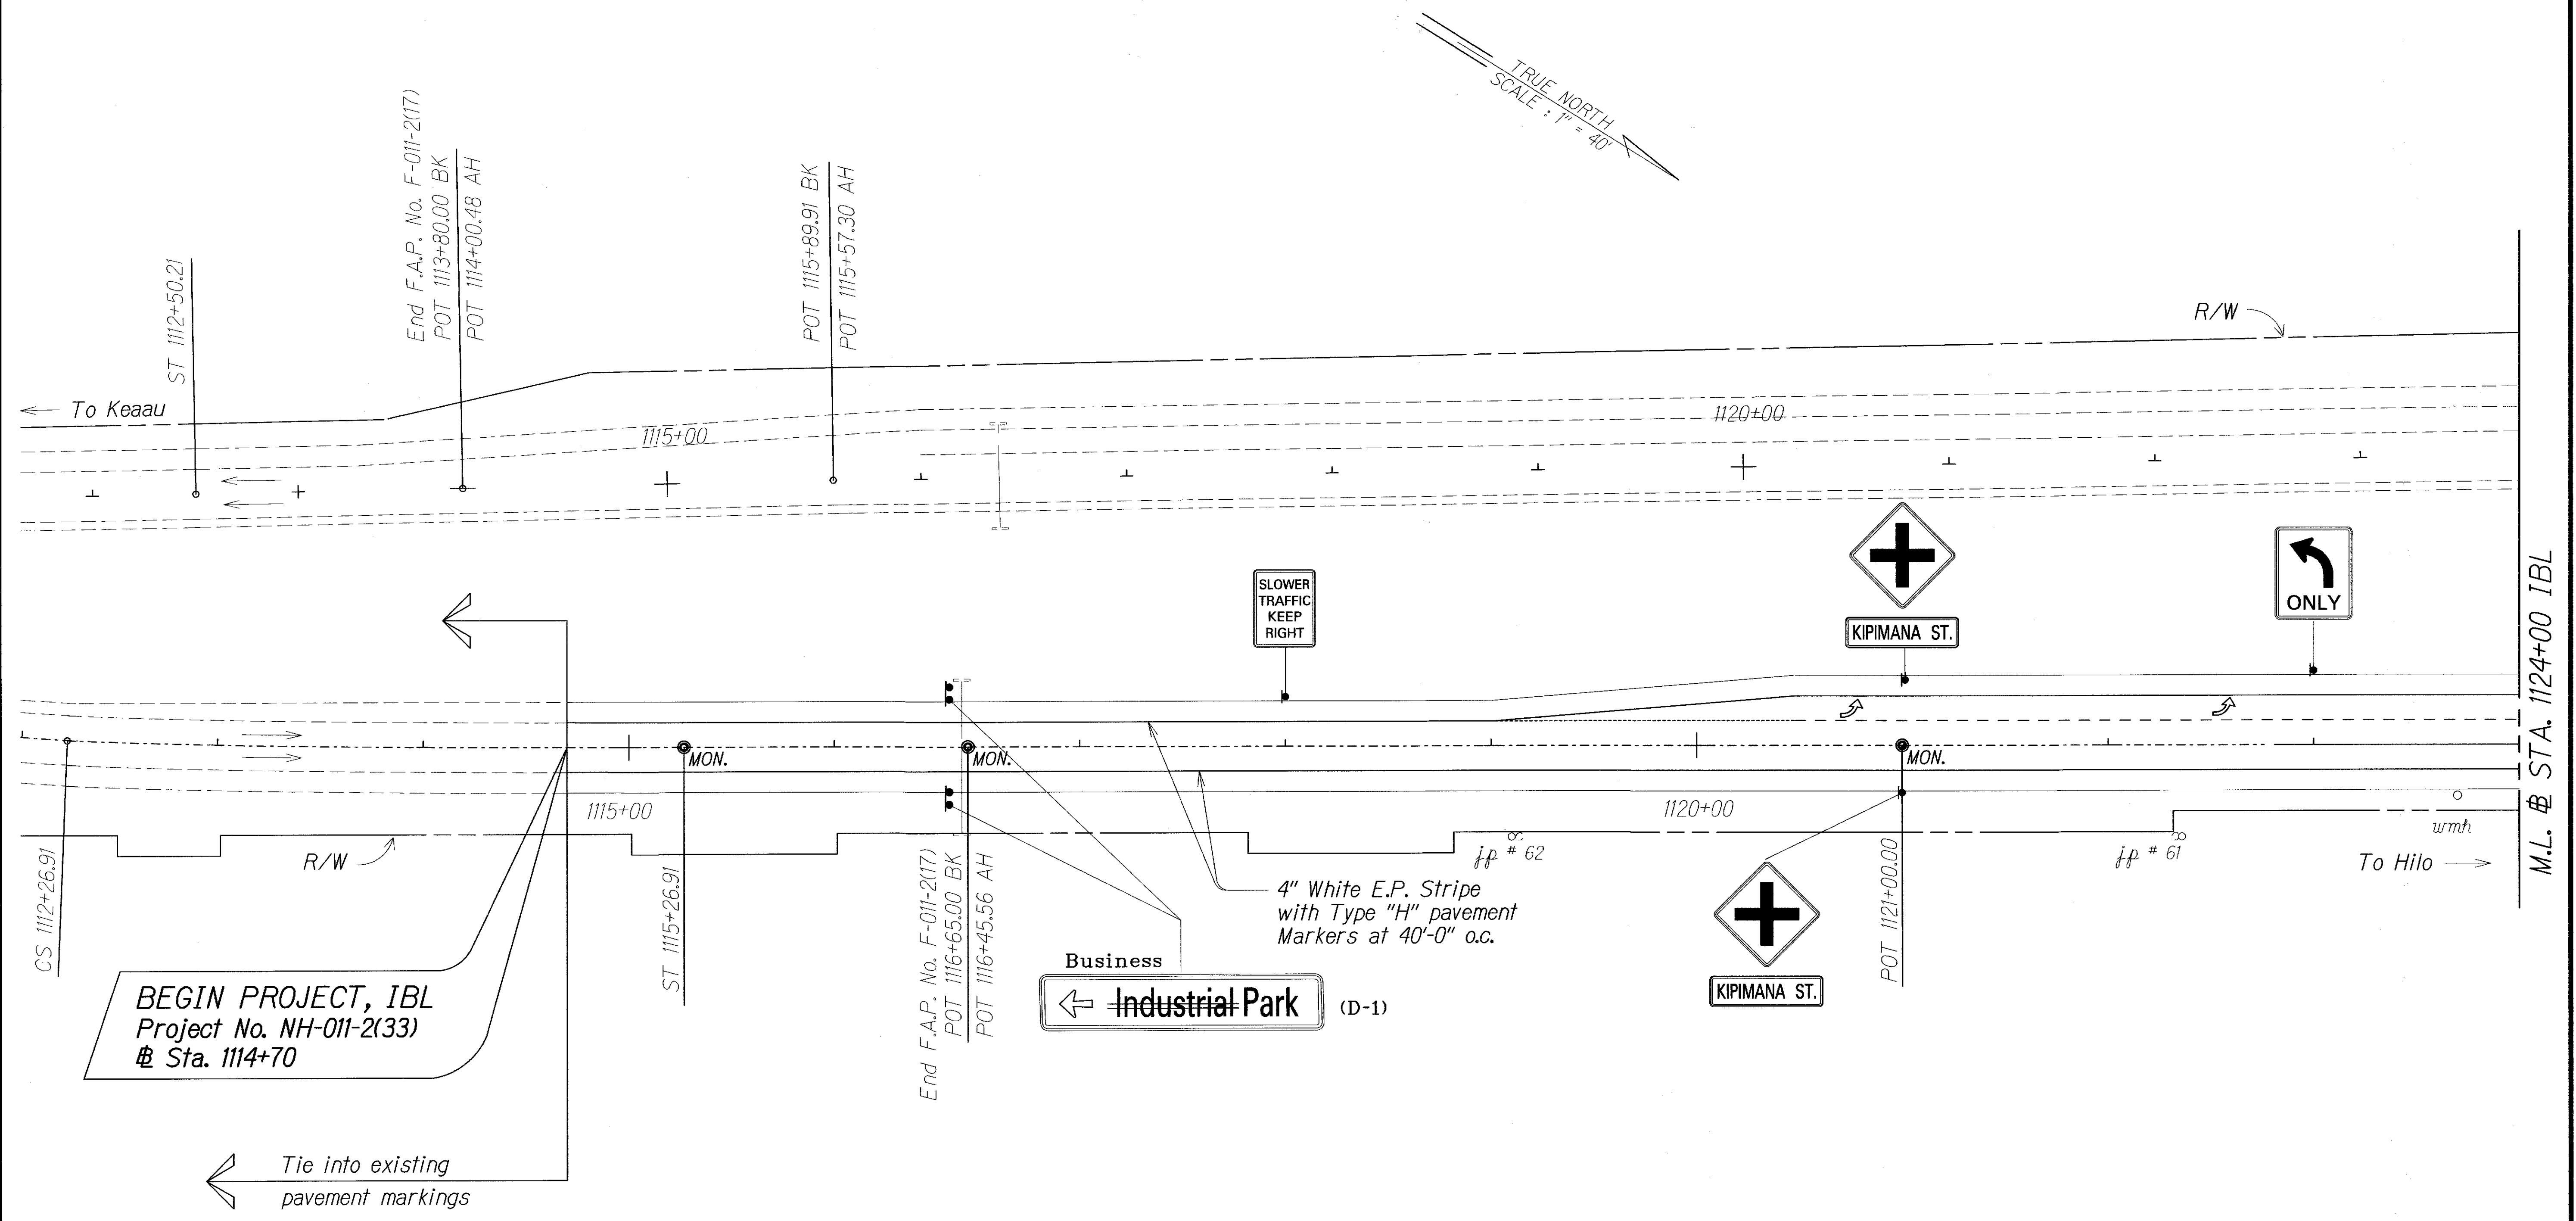

DESIGNED BY	DATE
DRAWN BY	4/96
CHECKED BY	
NOTED BY	
QUANTITIES BY	
DATE	

LEGEND FOR AS-BUILT POSTINGS	
	Squiggly line for as-built deletion
	Double line for as-built deletion
Roadway	Text for as-built posting


STATE OF HAWAII
DEPARTMENT OF TRANSPORTATION
HIGHWAYS DIVISION

ROADWAY PLAN (IBL)

KANOELEHUA AVENUE RESURFACING
KEAAU TO KAMEHAMEHA AVENUE
F. A. PROJECT NO. NH-011-2(33)

Scale: 1"=40' Date: April, 1996

FED. ROAD DIST. NO.	STATE	FED. AID PROJ. NO.	FISCAL YEAR	SHEET NO.	TOTAL SHEETS
HAWAII	HAW.	NH-011-2(33)	1996	9	102

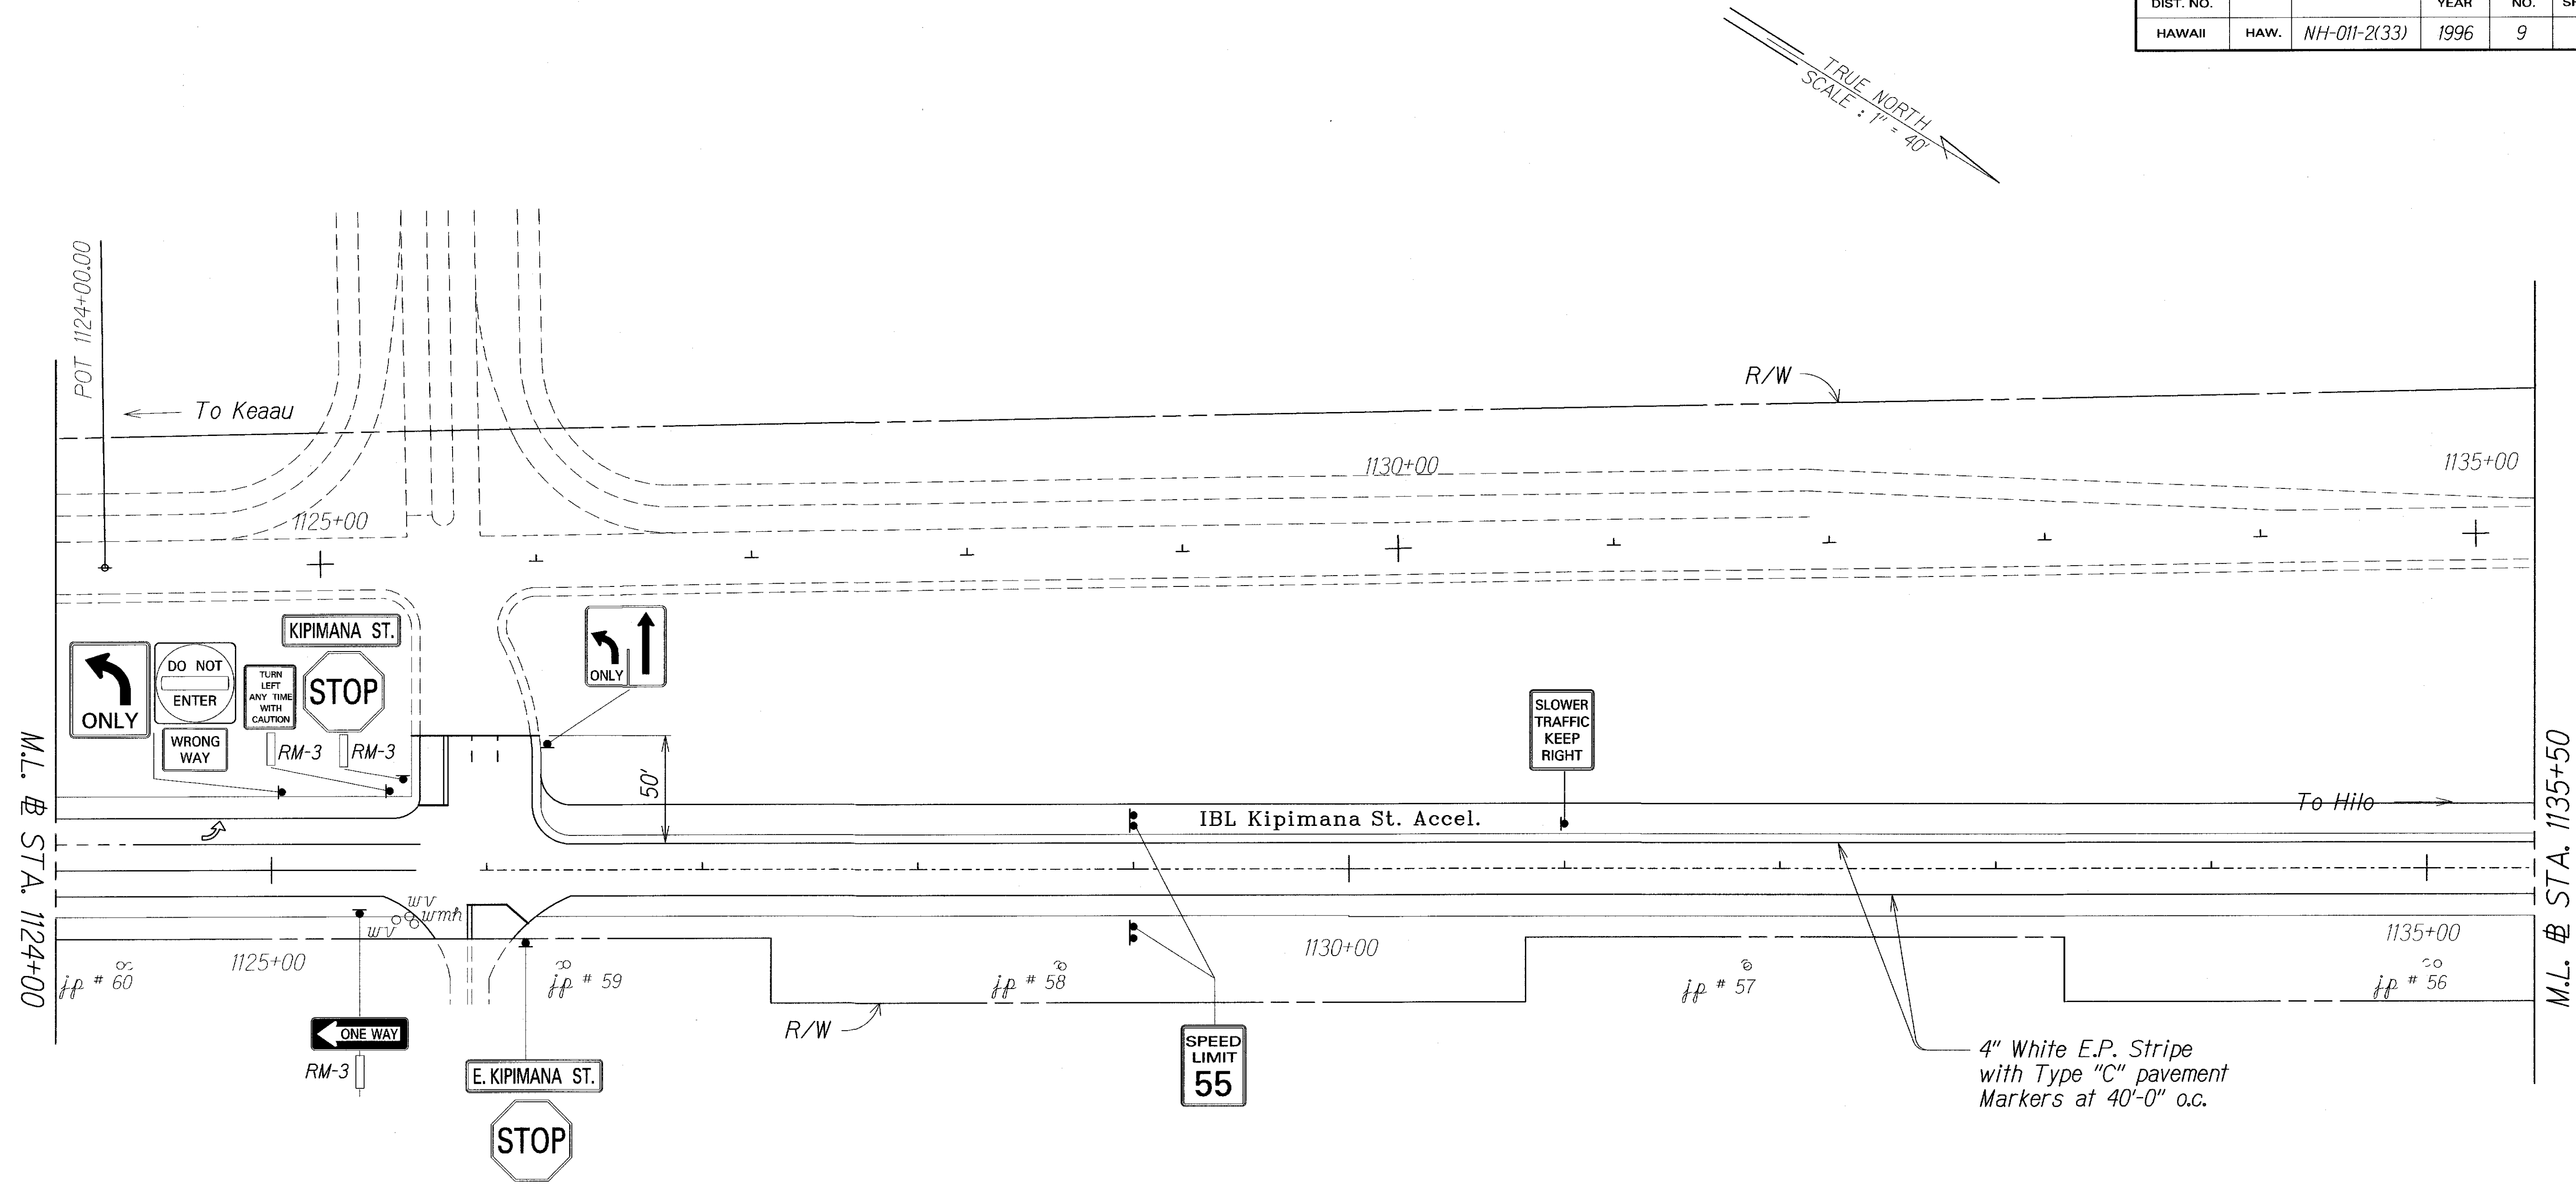

ORIGINAL PLAN	SURVEY PLOTTED BY	DATE
PLAN	DRAWN BY	4/96
NOTE BOOK	TRACED BY	
DESIGNED BY	CHECKED BY	
DATE		
NO.		

LEGEND FOR AS-BUILT POSTINGS	
	Squiggly line for as-built deletion
	Double line for as-built deletion
Roadway	Text for as-built posting

STATE OF HAWAII
DEPARTMENT OF TRANSPORTATION
HIGHWAYS DIVISION


ROADWAY PLAN (IBL)
KAOELEHUA AVENUE RESURFACING
KEAAU TO KAMEHAMEHA AVENUE
F. A. PROJECT NO. NH-011-2(33)

Scale: 1"=40' Date: April, 1996

SHEET No. 2 OF 23 SHEETS

"AS-BUILT"

FED. ROAD DIST. NO.	STATE	FED. AID PROJ. NO.	FISCAL YEAR	SHEET NO.	TOTAL SHEETS
HAWAII	HAW.	NH-011-2(33)	1996	10	102

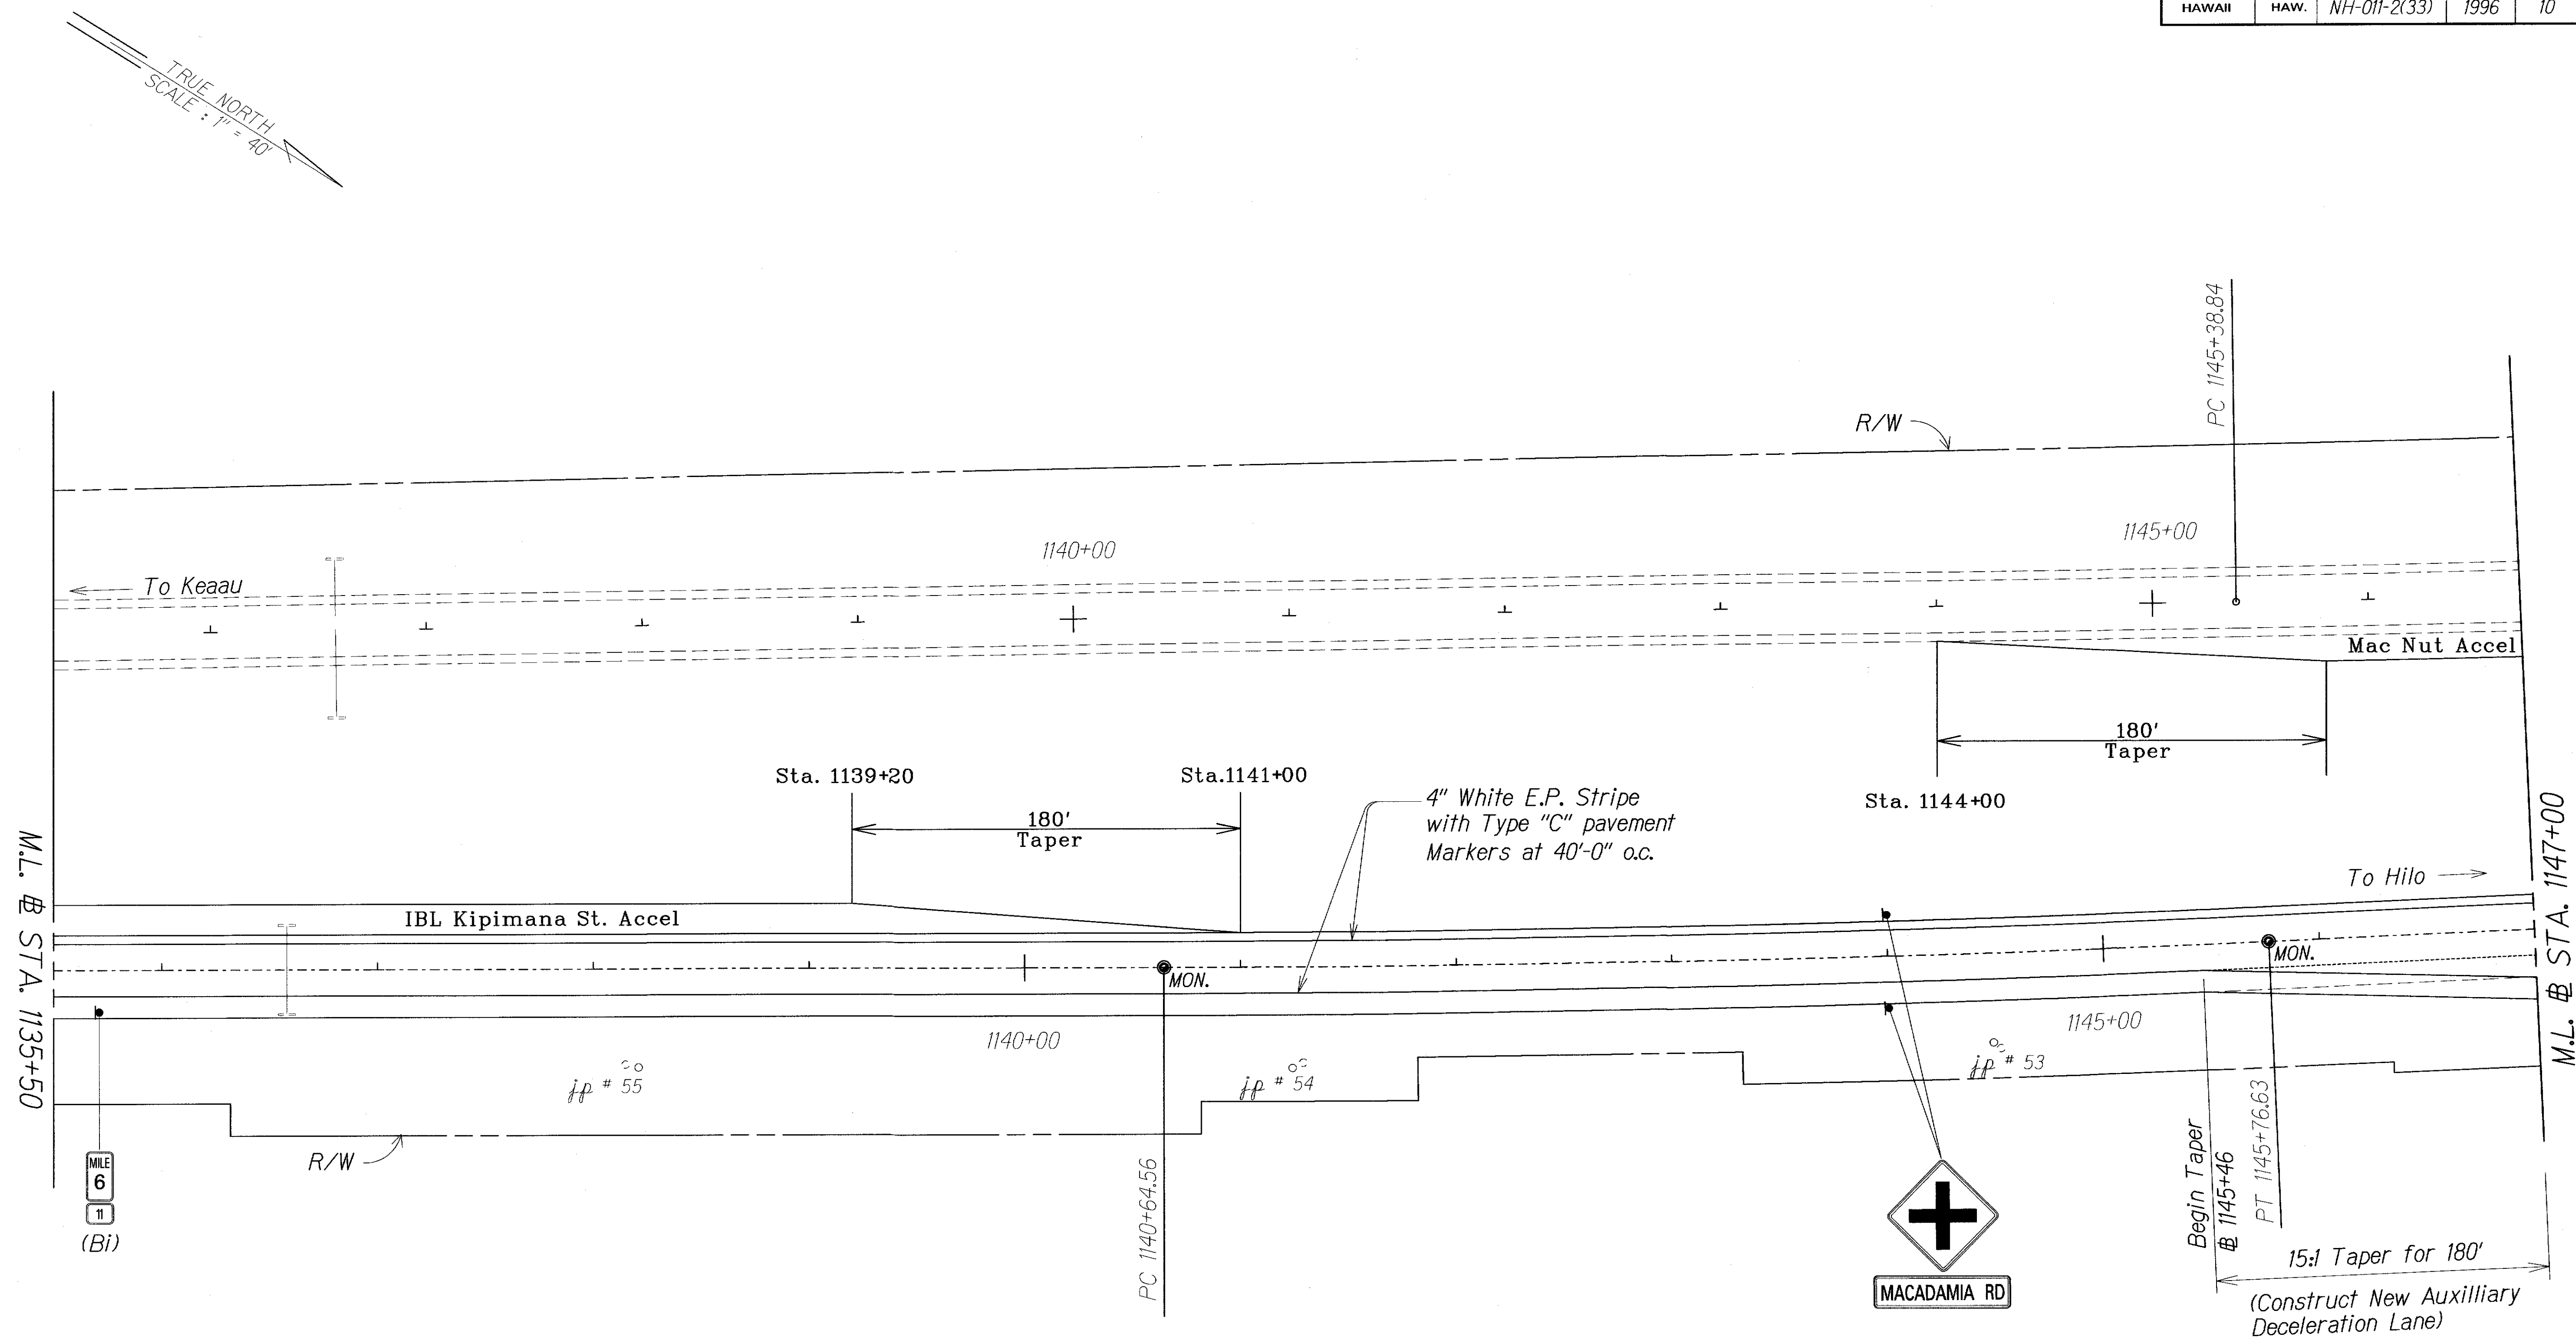

ORIGINAL PLAN	SURVEY PLOTTED BY	DATE
NOTE BOOK	DRAWN BY	4/96
DESIGNED BY	CHECKED BY	
NO. 40203		

LEGEND FOR AS-BUILT POSTINGS	
	Squiggly line for as-built deletion
	Double line for as-built deletion
Roadway	Text for as-built posting


STATE OF HAWAII
DEPARTMENT OF TRANSPORTATION
HIGHWAYS DIVISION

ROADWAY PLAN (IBL)
KAOOLEHUA AVENUE RESURFACING
KEAAU TO KAMEHAMEHA AVENUE
F. A. PROJECT NO. NH-011-2(33)
Scale: 1"=40' Date: April, 1996

SHEET No. 3 OF 23 SHEETS

"AS-BUILT"

FED. ROAD DIST. NO.	STATE	FED. AID PROJ. NO.	FISCAL YEAR	SHEET NO.	TOTAL SHEETS
HAWAII	HAW.	NH-011-2(33)	1996	12	102

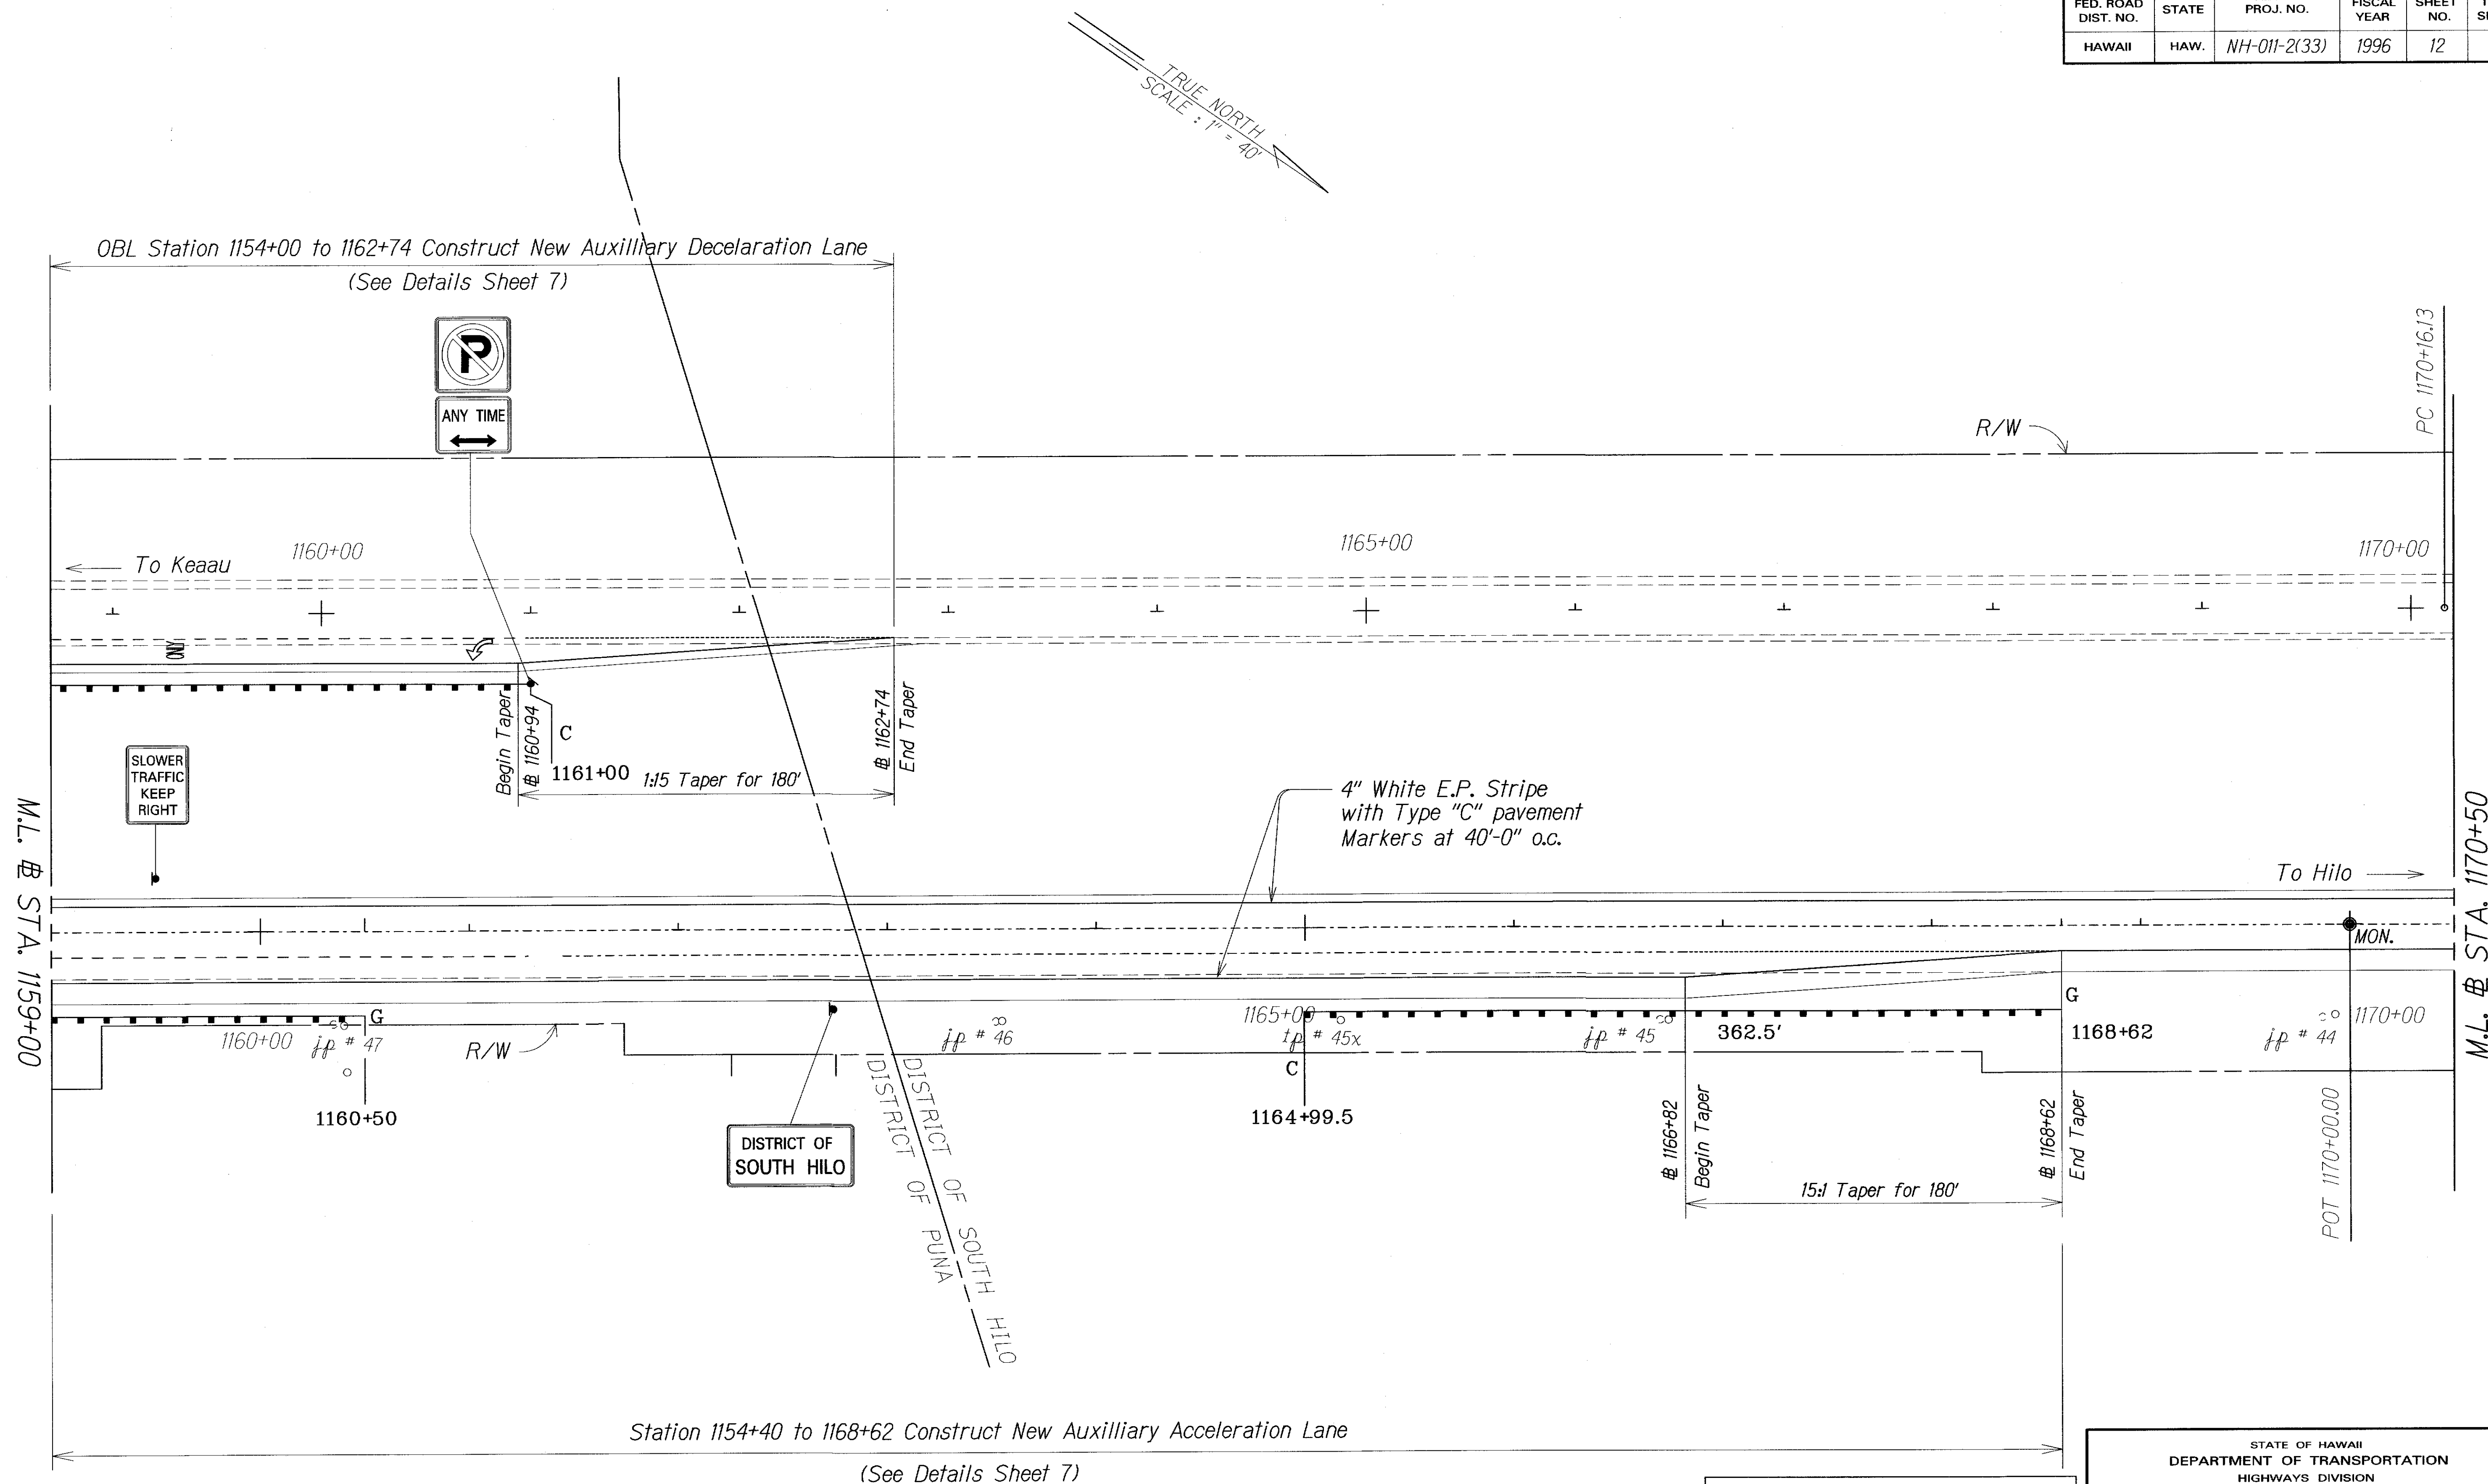


ORIGINAL PLAN	DATE	4/96
SURVEY PLOTTED BY	DESIGNED BY	
TRACED BY	DESIGNED BY	
NOTE BOOK	DESIGNED BY	
04/19/96	DESIGNED BY	
QUANTITIES BY	DESIGNED BY	
CHECKED BY	DESIGNED BY	

LEGEND FOR AS-BUILT POSTINGS	
	Squiggly line for as-built deletion
	Double line for as-built deletion
Roadway	Text for as-built posting

STATE OF HAWAII
DEPARTMENT OF TRANSPORTATION
HIGHWAYS DIVISION
ROADWAY PLAN (IBL)
KAOELEHUA AVENUE RESURFACING
KEAAU TO KAMEHAMEHA AVENUE
F. A. PROJECT NO. NH-011-2(33)
Scale: 1"=40' Date: April, 1996
SHEET No. 5 OF 23 SHEETS

"AS-BUILT"

FED. ROAD DIST. NO.	STATE	FED. AID PROJ. NO.	FISCAL YEAR	SHEET NO.	TOTAL SHEETS
HAWAII	HAW.	NH-011-2(33)	1996	13	102

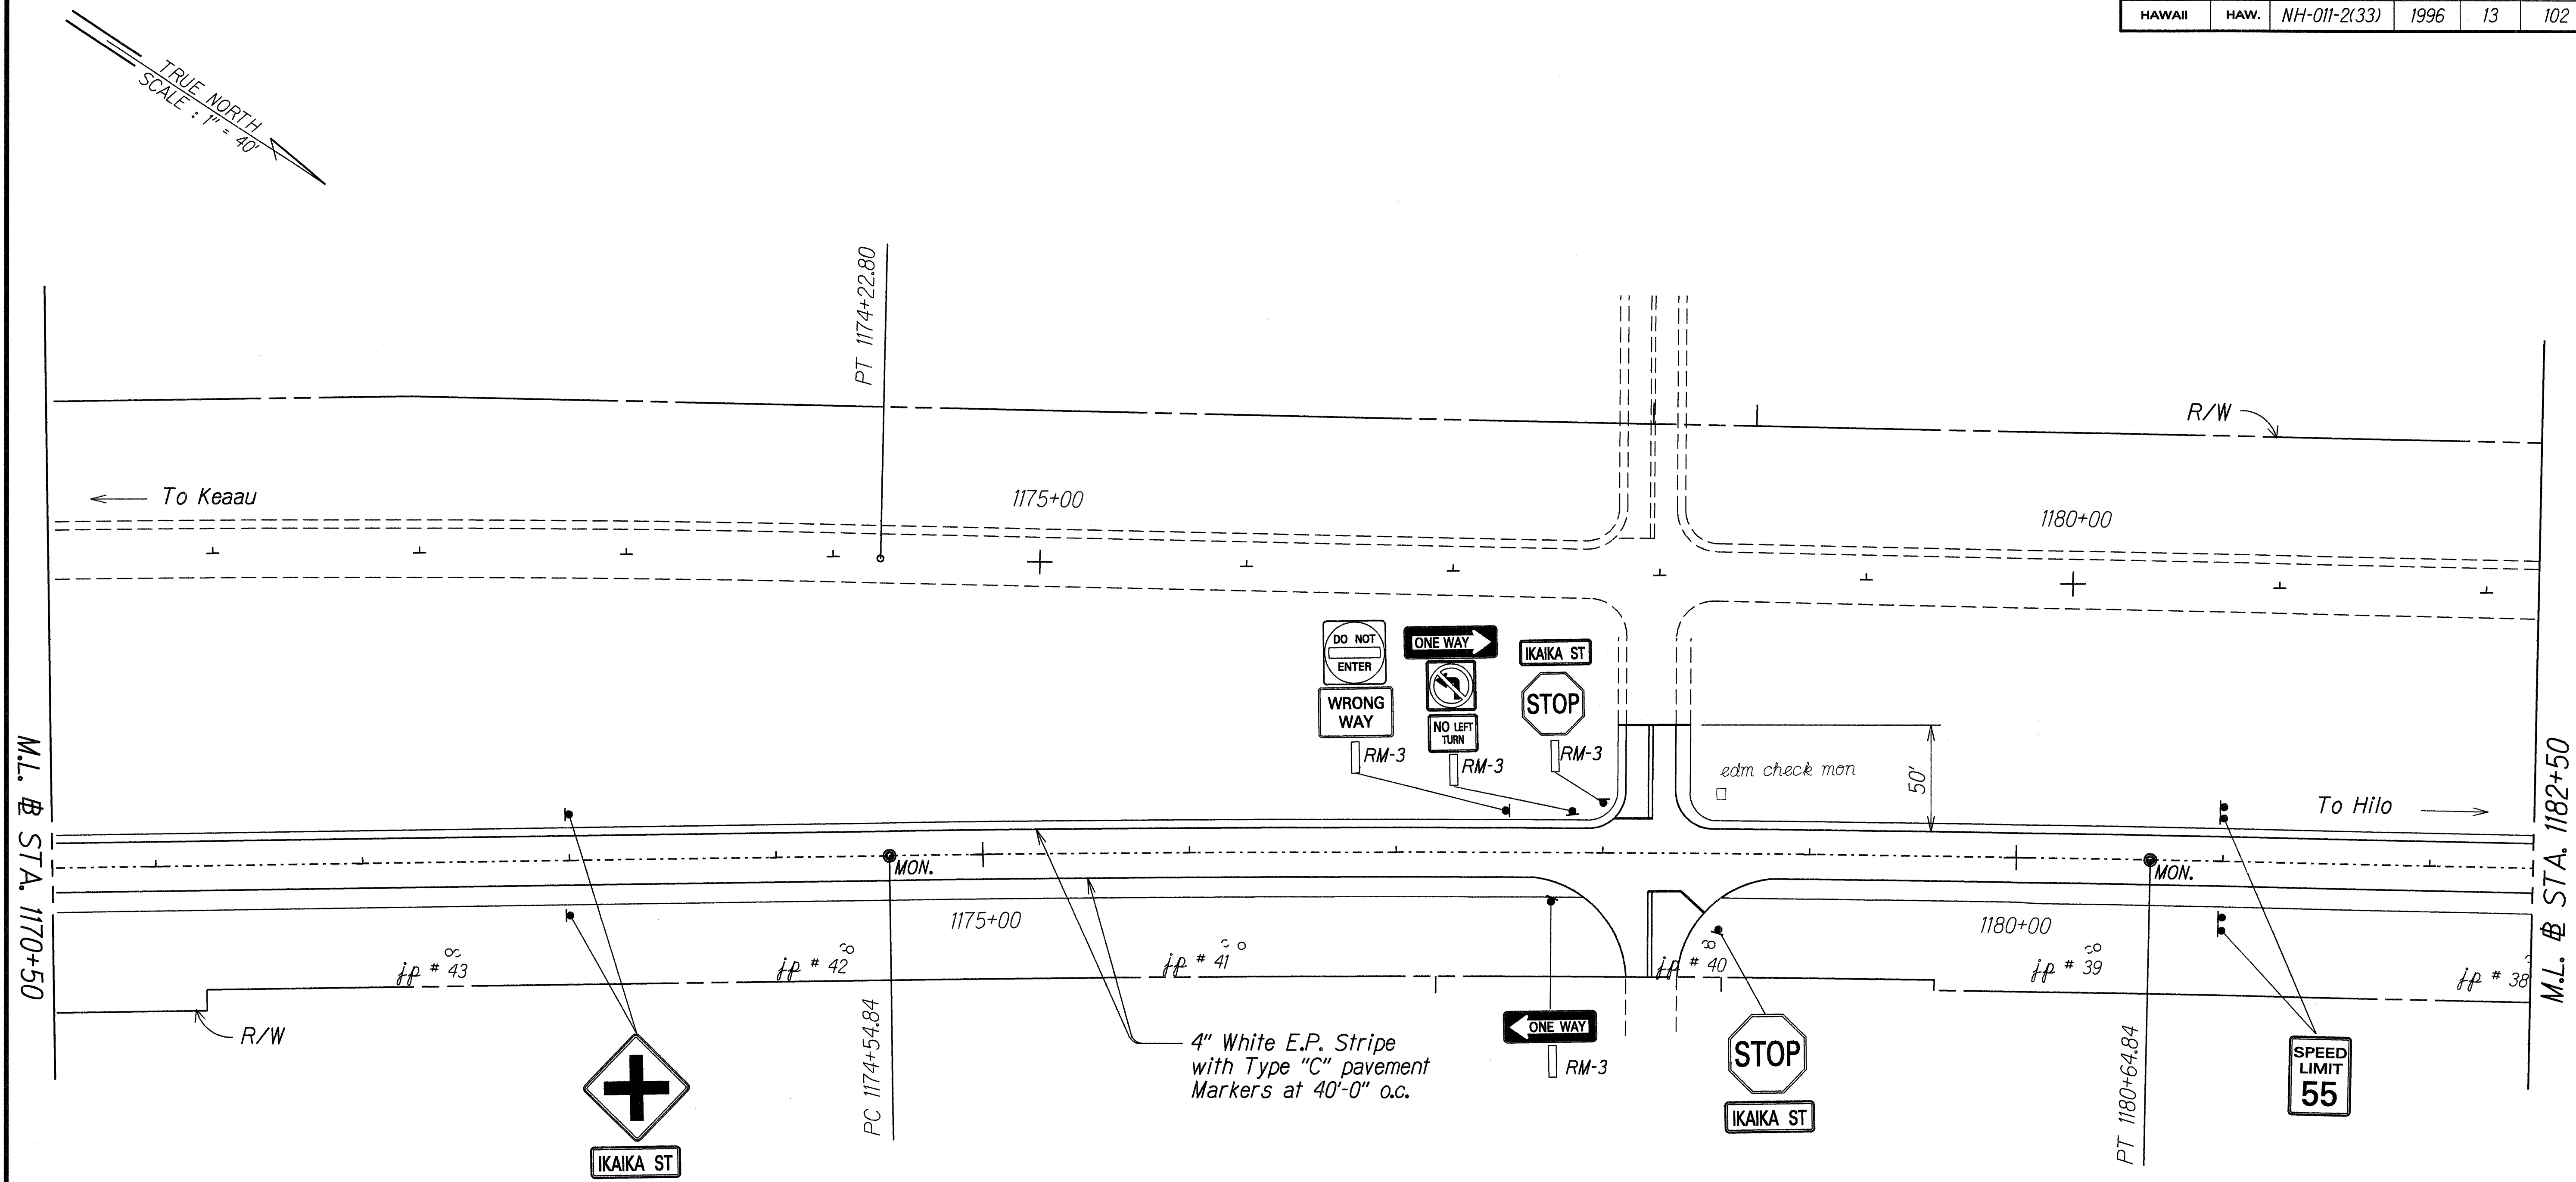

ORIGINAL PLAN	SURVEY DATED BY	DATE
NOTED	DRAWN BY	4/96
DESIGNED BY	DESIGNED BY	
CHECKED BY	CHECKED BY	
NO.	NO.	

STATE OF HAWAII
DEPARTMENT OF TRANSPORTATION
HIGHWAYS DIVISION


ROADWAY PLAN (IBL)
KANOELEHUA AVENUE RESURFACING
KEAAU TO KAMEHAMEHA AVENUE
F. A. PROJECT NO. NH-011-2(33)

Scale: 1"=40'
Date: April, 1996

SHEET No. 6 OF 23 SHEETS

FED. ROAD DIST. NO.	STATE	FED. AID PROJ. NO.	FISCAL YEAR	SHEET NO.	TOTAL SHEETS
HAWAII	HAW.	NH-011-2(33)	1996	14	102

TRUE NORTH
SCALE: 1" = 40'

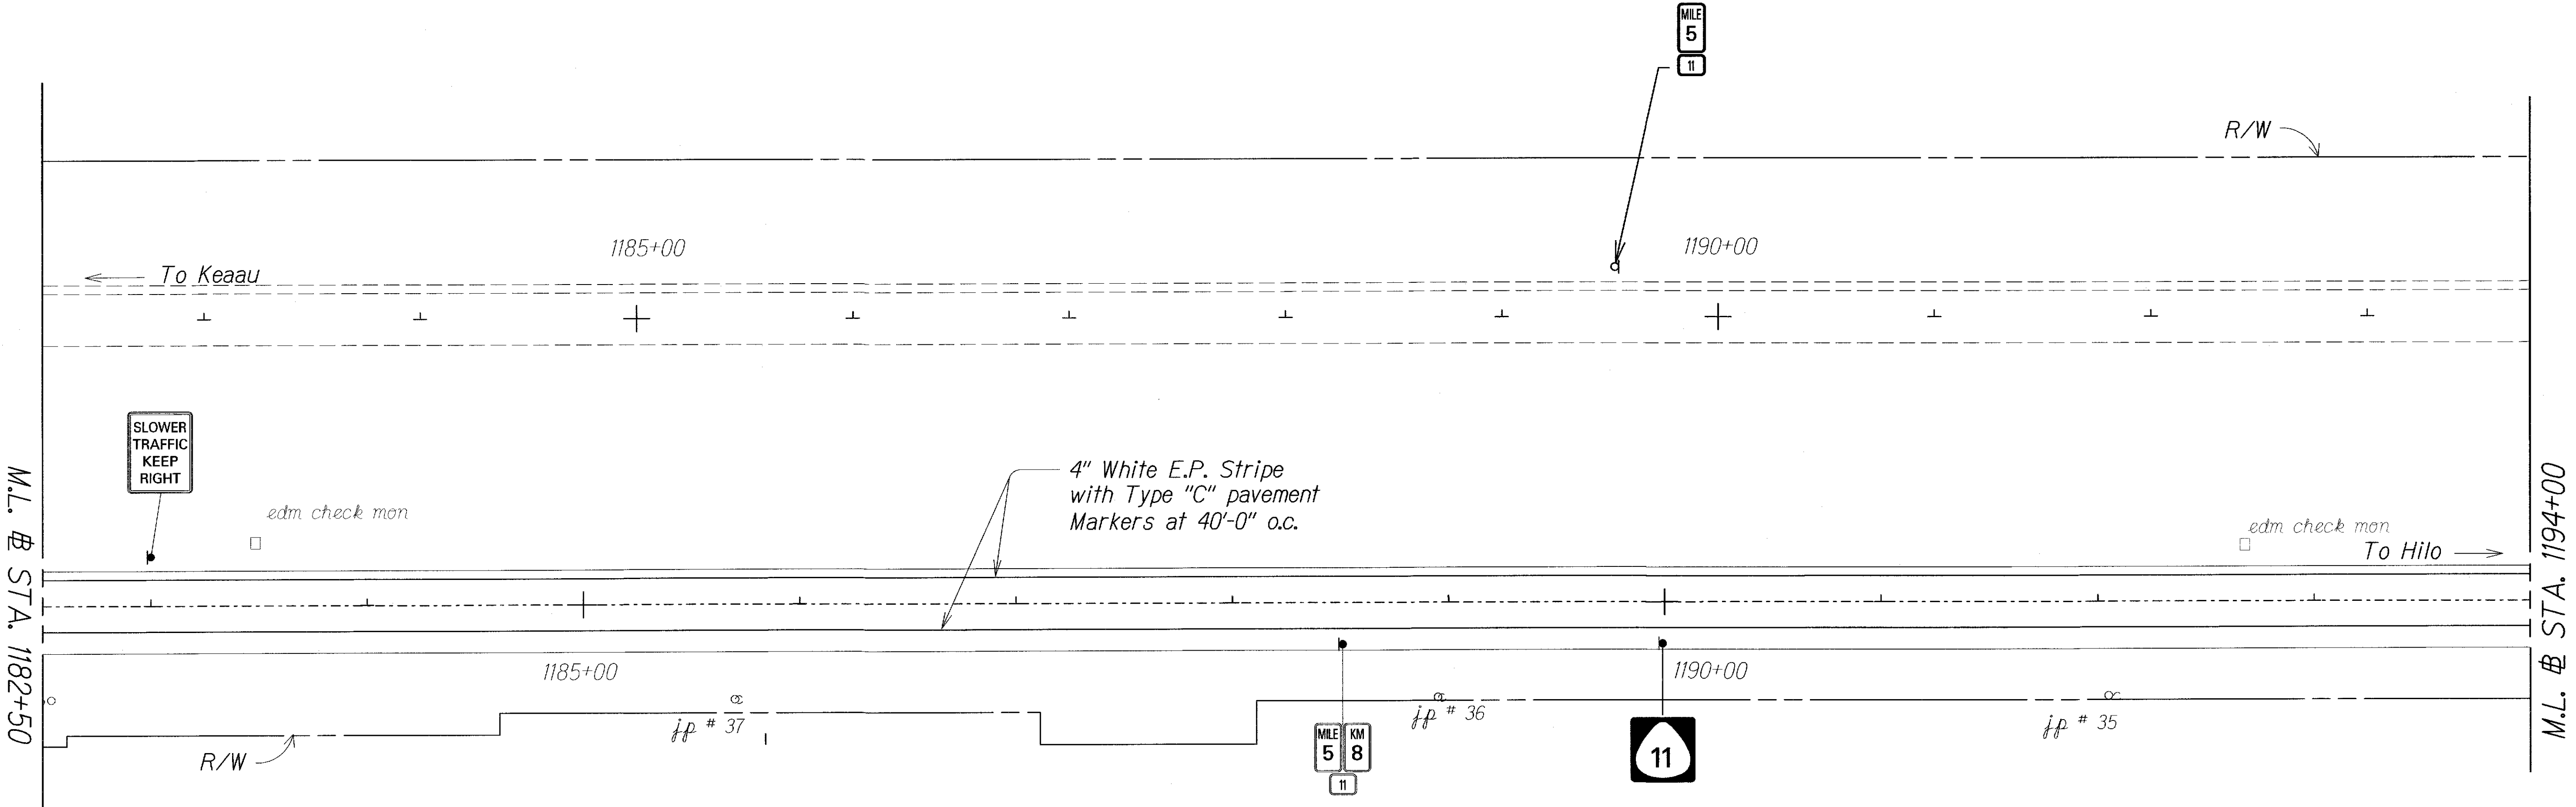

SURVEY PLOTTED BY	DATE
PLAN	4/96
NOTE BOOK	
DESIGNED BY	
QUANTITIES BY	
CHECKED BY	

LEGEND FOR AS-BUILT POSTINGS	
	Squiggly line for as-built deletion
	Double line for as-built deletion
Roadway	Text for as-built posting

STATE OF HAWAII
DEPARTMENT OF TRANSPORTATION
HIGHWAYS DIVISION

ROADWAY PLAN (IBL)

KANOELEHUA AVENUE RESURFACING
KEAAU TO KAMEHAMEHA AVENUE
F. A. PROJECT NO. NH-011-2(33)


Scale: 1"=40' Date: April, 1996

SHEET No. 7 OF 23 SHEETS

"AS-BUILT"

FED. ROAD DIST. NO.	STATE	FED. AID PROJ. NO.	FISCAL YEAR	SHEET NO.	TOTAL SHEETS
HAWAII	HAW.	NH-011-2(33)	1996	15	102

TRUE NORTH
SCALE: 1" = 40'

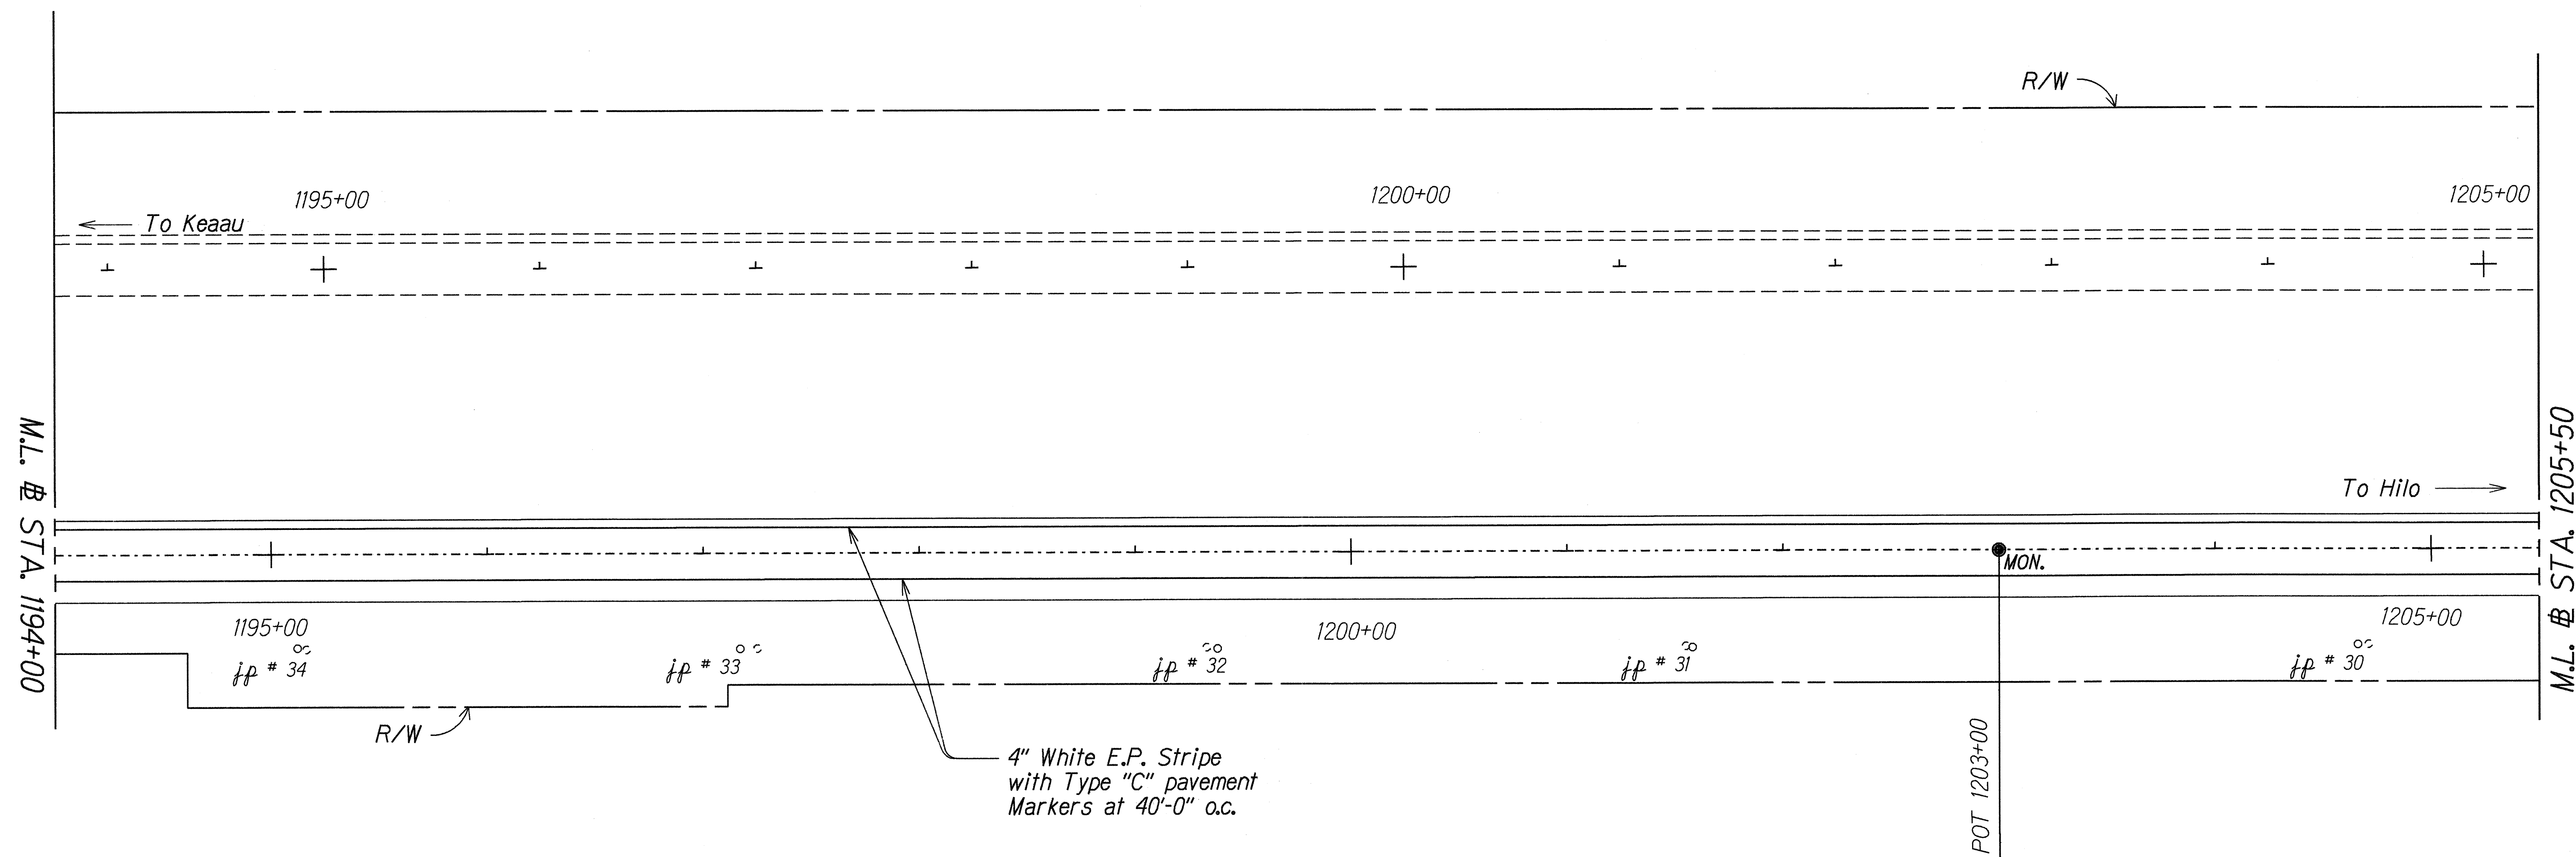

ORIGINAL PLAN	DATE	4/96
DESIGNED BY	TRACED BY	
NOTED BY	DESIGNED BY	
QUANTITIES BY	DESIGNED BY	
CHECKED BY	DESIGNED BY	

STATE OF HAWAII
DEPARTMENT OF TRANSPORTATION
HIGHWAYS DIVISION



ROADWAY PLAN (IBL)

KAMEHAMEHA AVENUE RESURFACING
KEAUA TO KAMEHAMEHA AVENUE
F. A. PROJECT NO. NH-001-2(33)

Scale: 1"=40' Date: April, 1996

SHEET No. 8 OF 23 SHEETS

FED. ROAD DIST. NO.	STATE	FED. AID PROJ. NO.	FISCAL YEAR	SHEET NO.	TOTAL SHEETS
HAWAII	HAW.	NH-011-2(33)	1996	16	102

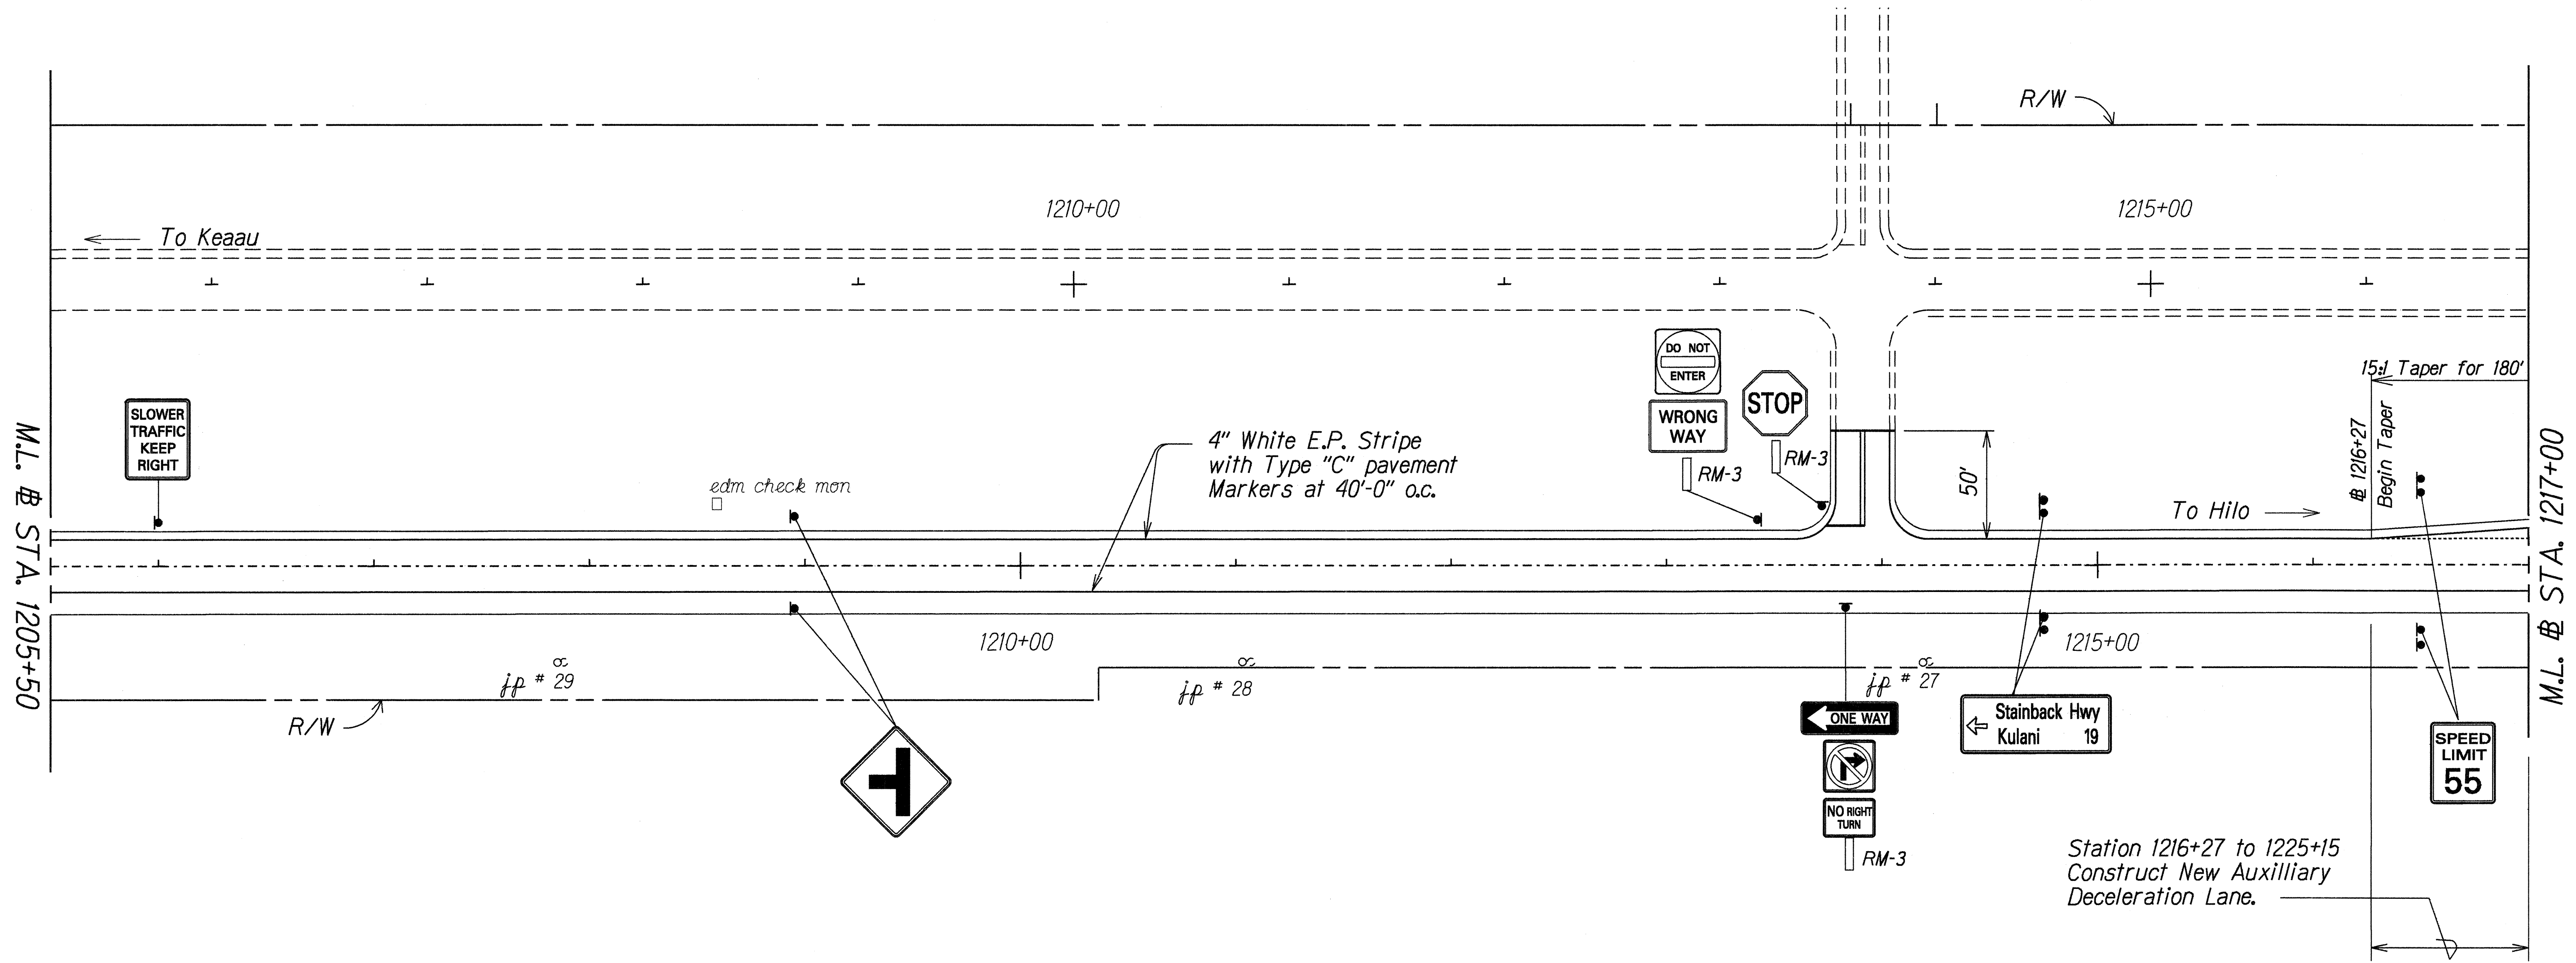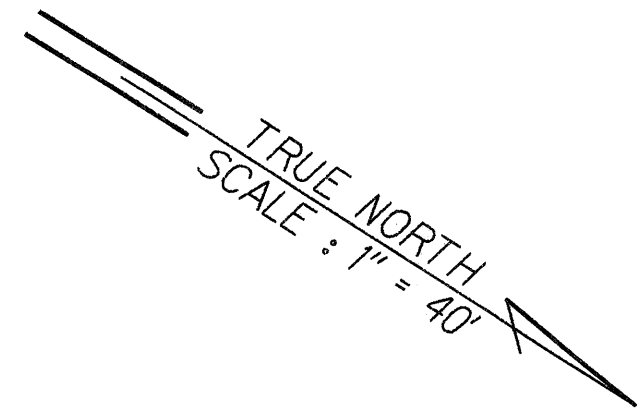

ORIGINAL PLAN	DATE
DESIGNED BY	4/96
DRAWN BY	
CHECKED BY	
NOTED BY	
DATE	
BY	
NO.	


STATE OF HAWAII
DEPARTMENT OF TRANSPORTATION
HIGHWAYS DIVISION

ROADWAY PLAN (IBL)
KAOELEHUA AVENUE RESURFACING
KEAAU TO KAMEHAMEHA AVENUE
F. A. PROJECT NO. NH-011-2(33)

Scale: 1"=40'
Date: April, 1996

SHEET No. 9 OF 23 SHEETS

FED. ROAD DIST. NO.	STATE	FED. AID PROJ. NO.	FISCAL YEAR	SHEET NO.	TOTAL SHEETS
HAWAII	HAW.	NH-011-2(33)	1996	18	102

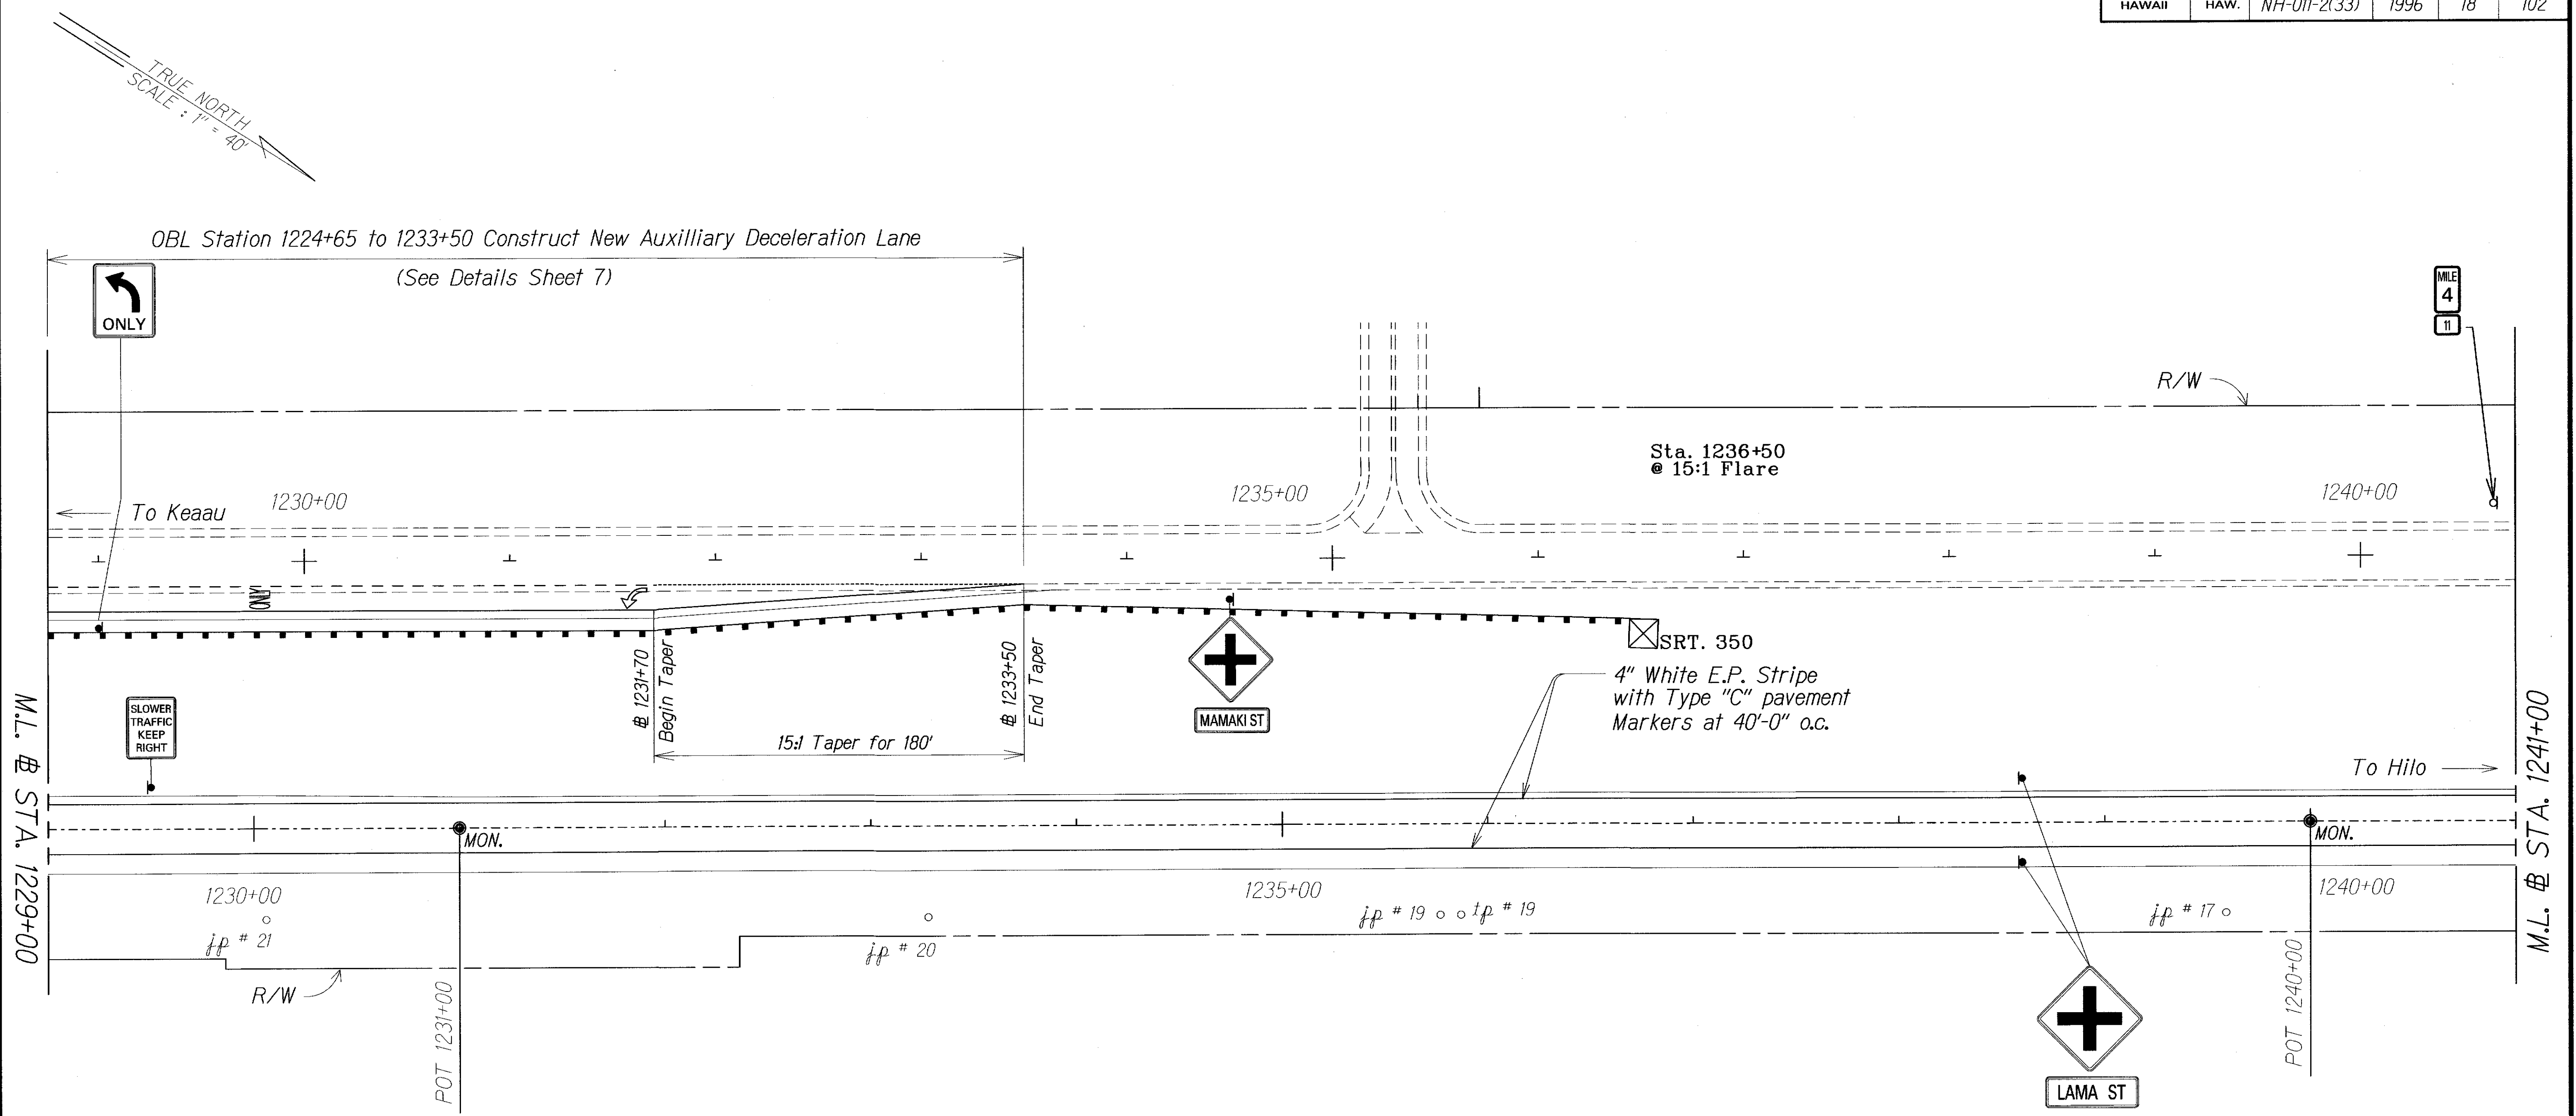


DESIGNED BY	DATE
TRACED BY	4/96
DESIGNED BY	
QUANTITIES BY	
CHECKED BY	

LEGEND FOR AS-BUILT POSTINGS	
	Squiggly line for as-built deletion
	Double line for as-built deletion
Roadway	Text for as-built posting

STATE OF HAWAII
DEPARTMENT OF TRANSPORTATION
HIGHWAYS DIVISION
ROADWAY PLAN (IBL)
KAOELEHUA AVENUE RESURFACING
KEAAU TO KAMEHAMEHA AVENUE
F. A. PROJECT NO. NH-011-2(33)
Scale: 1"=40' Date: April, 1996
SHEET No. 11 OF 23 SHEETS

"AS-BUILT"

FED. ROAD DIST. NO.	STATE	FED. AID PROJ. NO.	FISCAL YEAR	SHEET NO.	TOTAL SHEETS
HAWAII	HAW.	NH-011-2(33)	1996	19	102

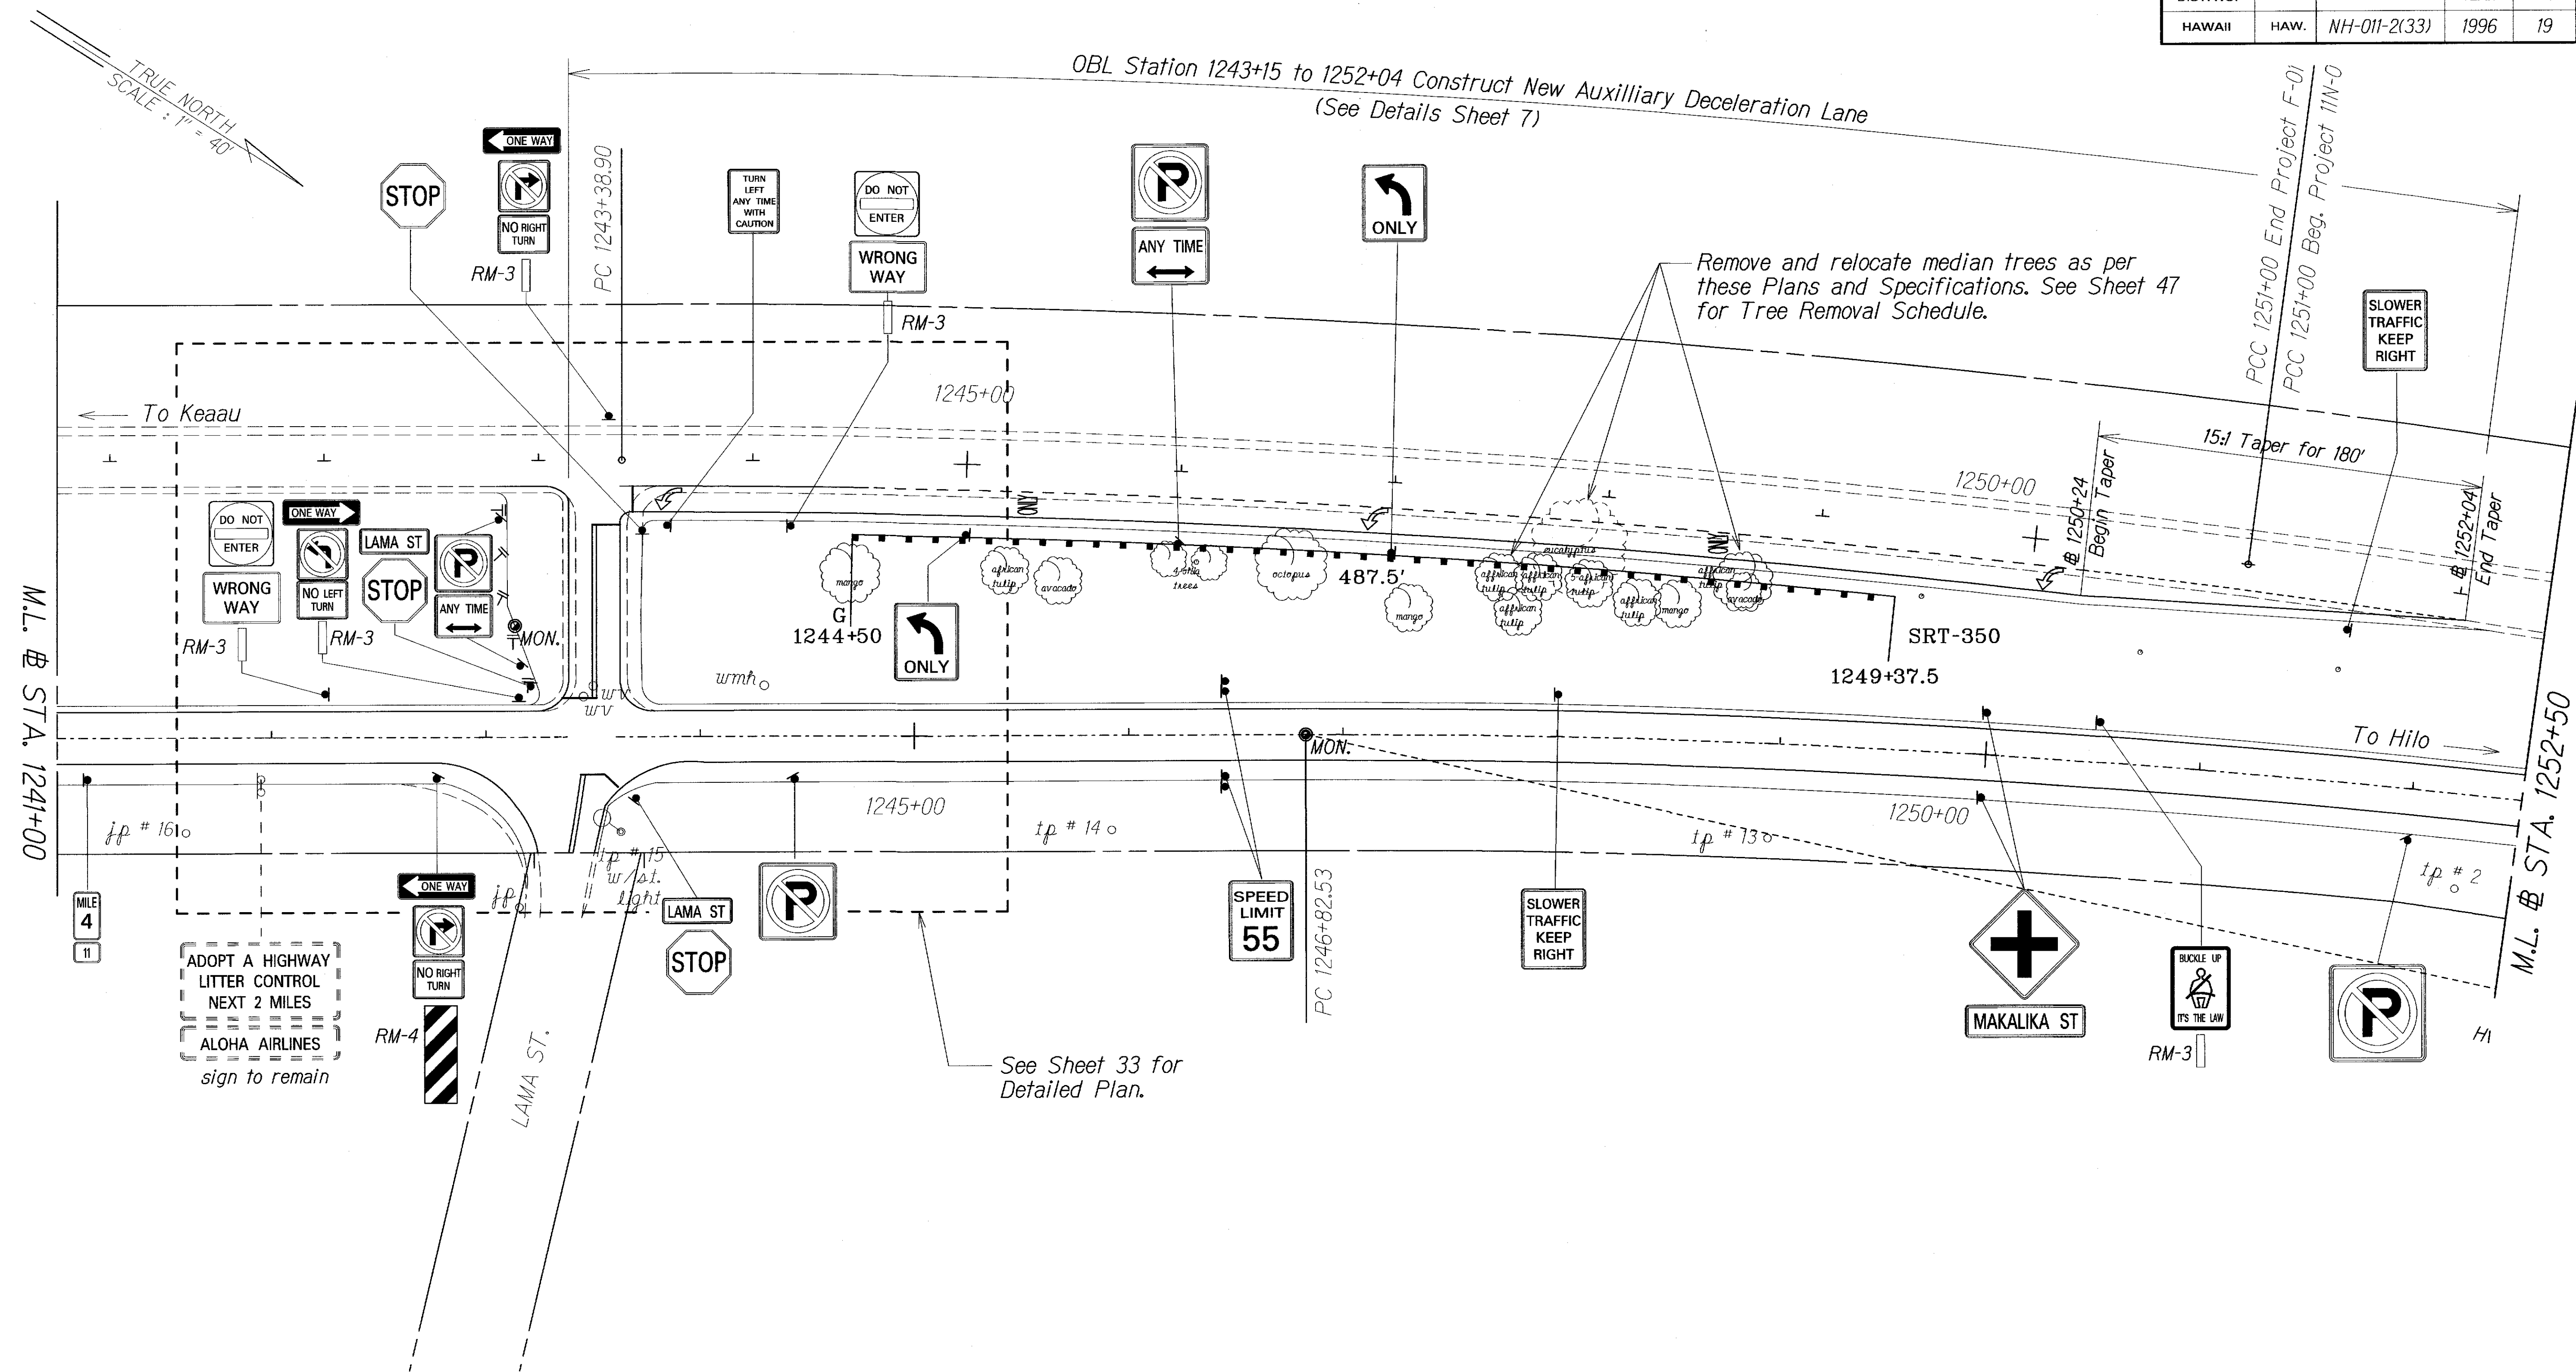

ORIGINAL PLAN	DATE
SURVEY PLOTTED BY	4/96
DESIGNED BY	
QUANTITIES BY	
CHECKED BY	

LEGEND FOR AS-BUILT POSTINGS	
	Squiggly line for as-built deletion
	Double line for as-built deletion
Roadway	Text for as-built posting


STATE OF HAWAII
DEPARTMENT OF TRANSPORTATION
HIGHWAYS DIVISION

ROADWAY PLAN (IBL)
KANOELEHUA AVENUE RESURFACING
KEAAU TO KAMEHAMEHA AVENUE
F. A. PROJECT NO. NH-011-2(33)
Scale: 1"=40' Date: April, 1996

SHEET No. 12 OF 23 SHEETS

FED. ROAD DIST. NO.	STATE	FED. AID PROJ. NO.	FISCAL YEAR	SHEET NO.	TOTAL SHEETS
HAWAII	HAW.	NH-011-2(33)	1996	20	102

TRUE NORTH
SCALE: 1" = 40'

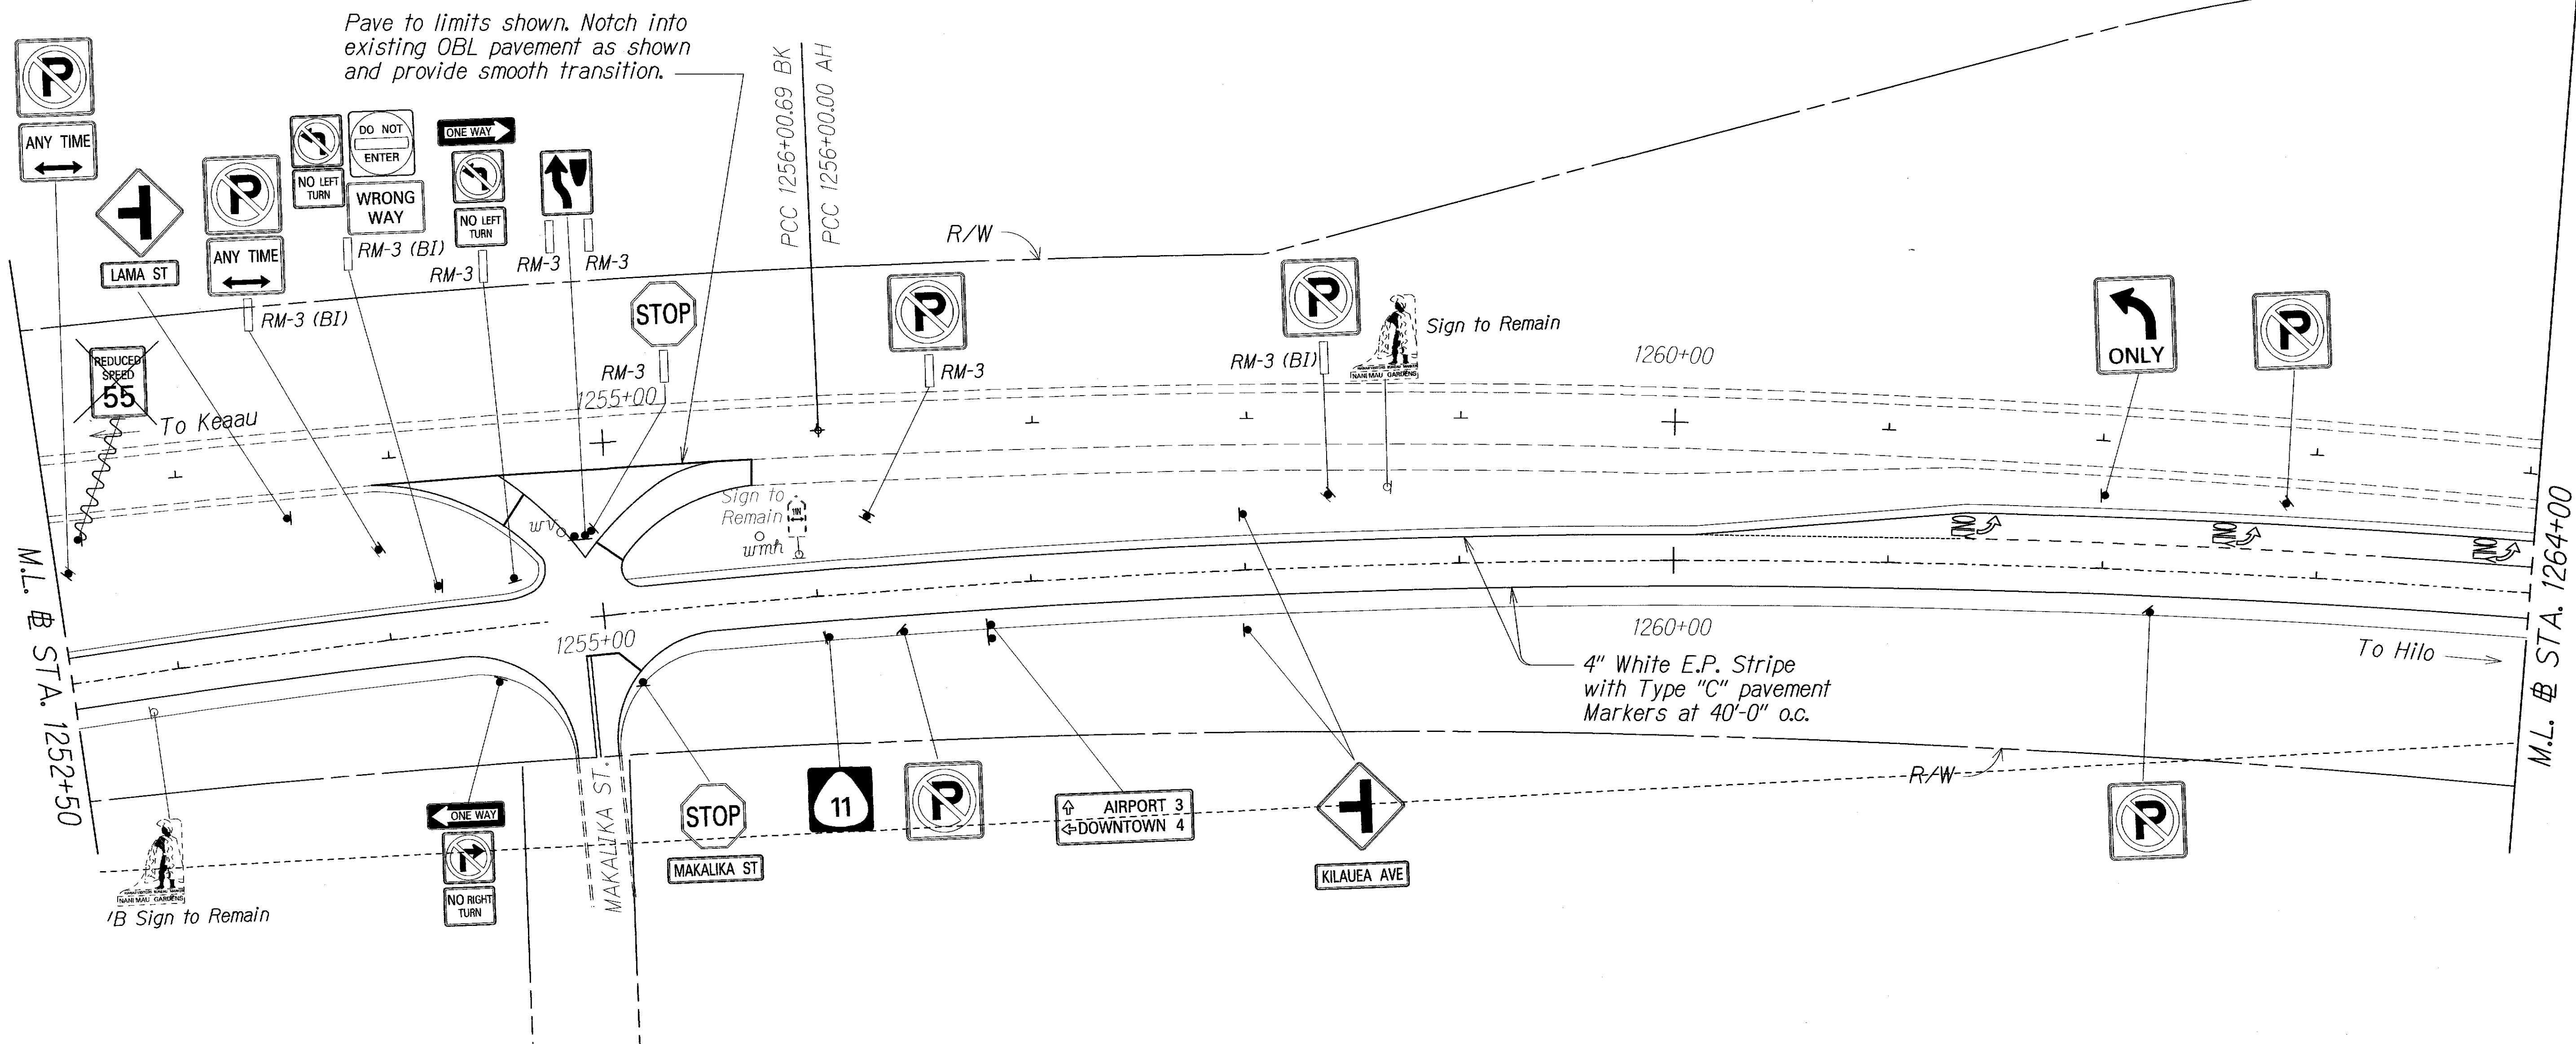


ORIGINAL PLAN	DATE
SURVEY PLOTTED BY	4/96
DRAWN BY	
DESIGNED BY	
CHECKED BY	
NOTED BY	
DATE	
BY	

LEGEND FOR AS-BUILT POSTINGS	
	Squiggly line for as-built deletion
	Double line for as-built deletion
Roadway	Text for as-built posting

STATE OF HAWAII
DEPARTMENT OF TRANSPORTATION
HIGHWAYS DIVISION
ROADWAY PLAN (IBL)
KAOELEHUA AVENUE RESURFACING
KEAAU TO KAMEHAMEHA AVENUE
F. A. PROJECT NO. NH-011-2(33)
Scale: 1"=40' Date: April, 1996
SHEET No. 13 OF 23 SHEETS

FED. ROAD DIST. NO.	STATE	FED. AID PROJ. NO.	FISCAL YEAR	SHEET NO.	TOTAL SHEETS
HAWAII	HAW.	NH-011-2(33)	1996	22	102

TRUE NORTH
SCALE: 1" = 40'

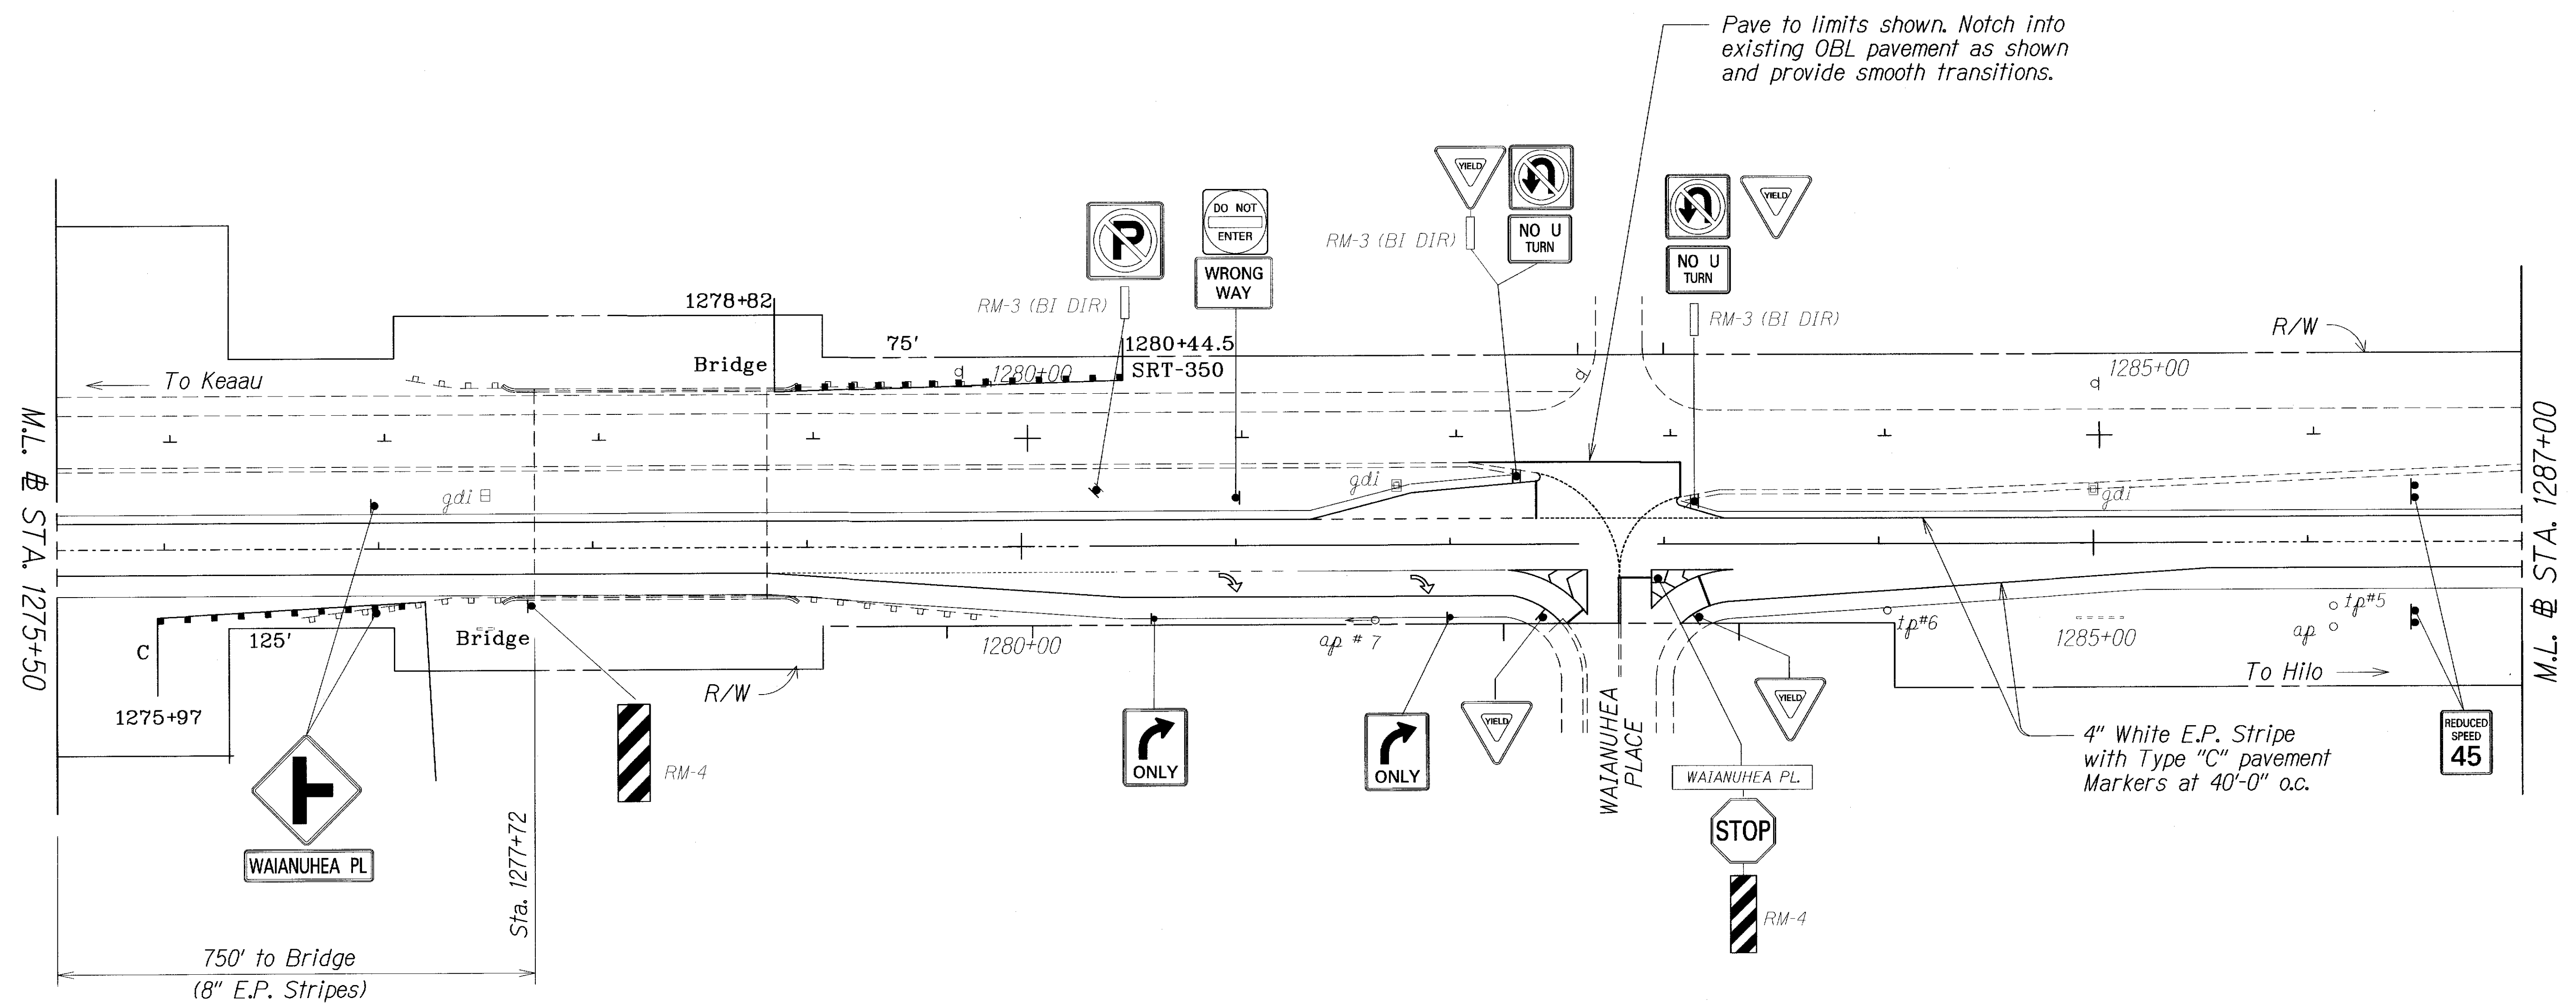

ORIGINAL PLAN	DATE
NO. 10000	4/96
SURVEY PLOTTED BY	
DRAWN BY	
DESIGNED BY	
QUANTITIES BY	
CHECKED BY	


LEGEND FOR AS-BUILT POSTINGS	
	Squiggly line for as-built deletion
	Double line for as-built deletion
Roadway	Text for as-built posting

STATE OF HAWAII DEPARTMENT OF TRANSPORTATION HIGHWAYS DIVISION
ROADWAY PLAN (IBL)
KANOIEHUA AVENUE RESURFACING KEAAU TO KAMEHAMEHA AVENUE F. A. PROJECT NO. NH-011-2(33)
Scale: 1"=40' Date: April, 1996
SHEET No. 15 OF 23 SHEETS

"AS-BUILT"

FED. ROAD DIST. NO.	STATE	FED. AID PROJ. NO.	FISCAL YEAR	SHEET NO.	TOTAL SHEETS
HAWAII	HAW.	NH-011-2(33)	1996	22	102

TRUE NORTH
SCALE: 1" = 40'

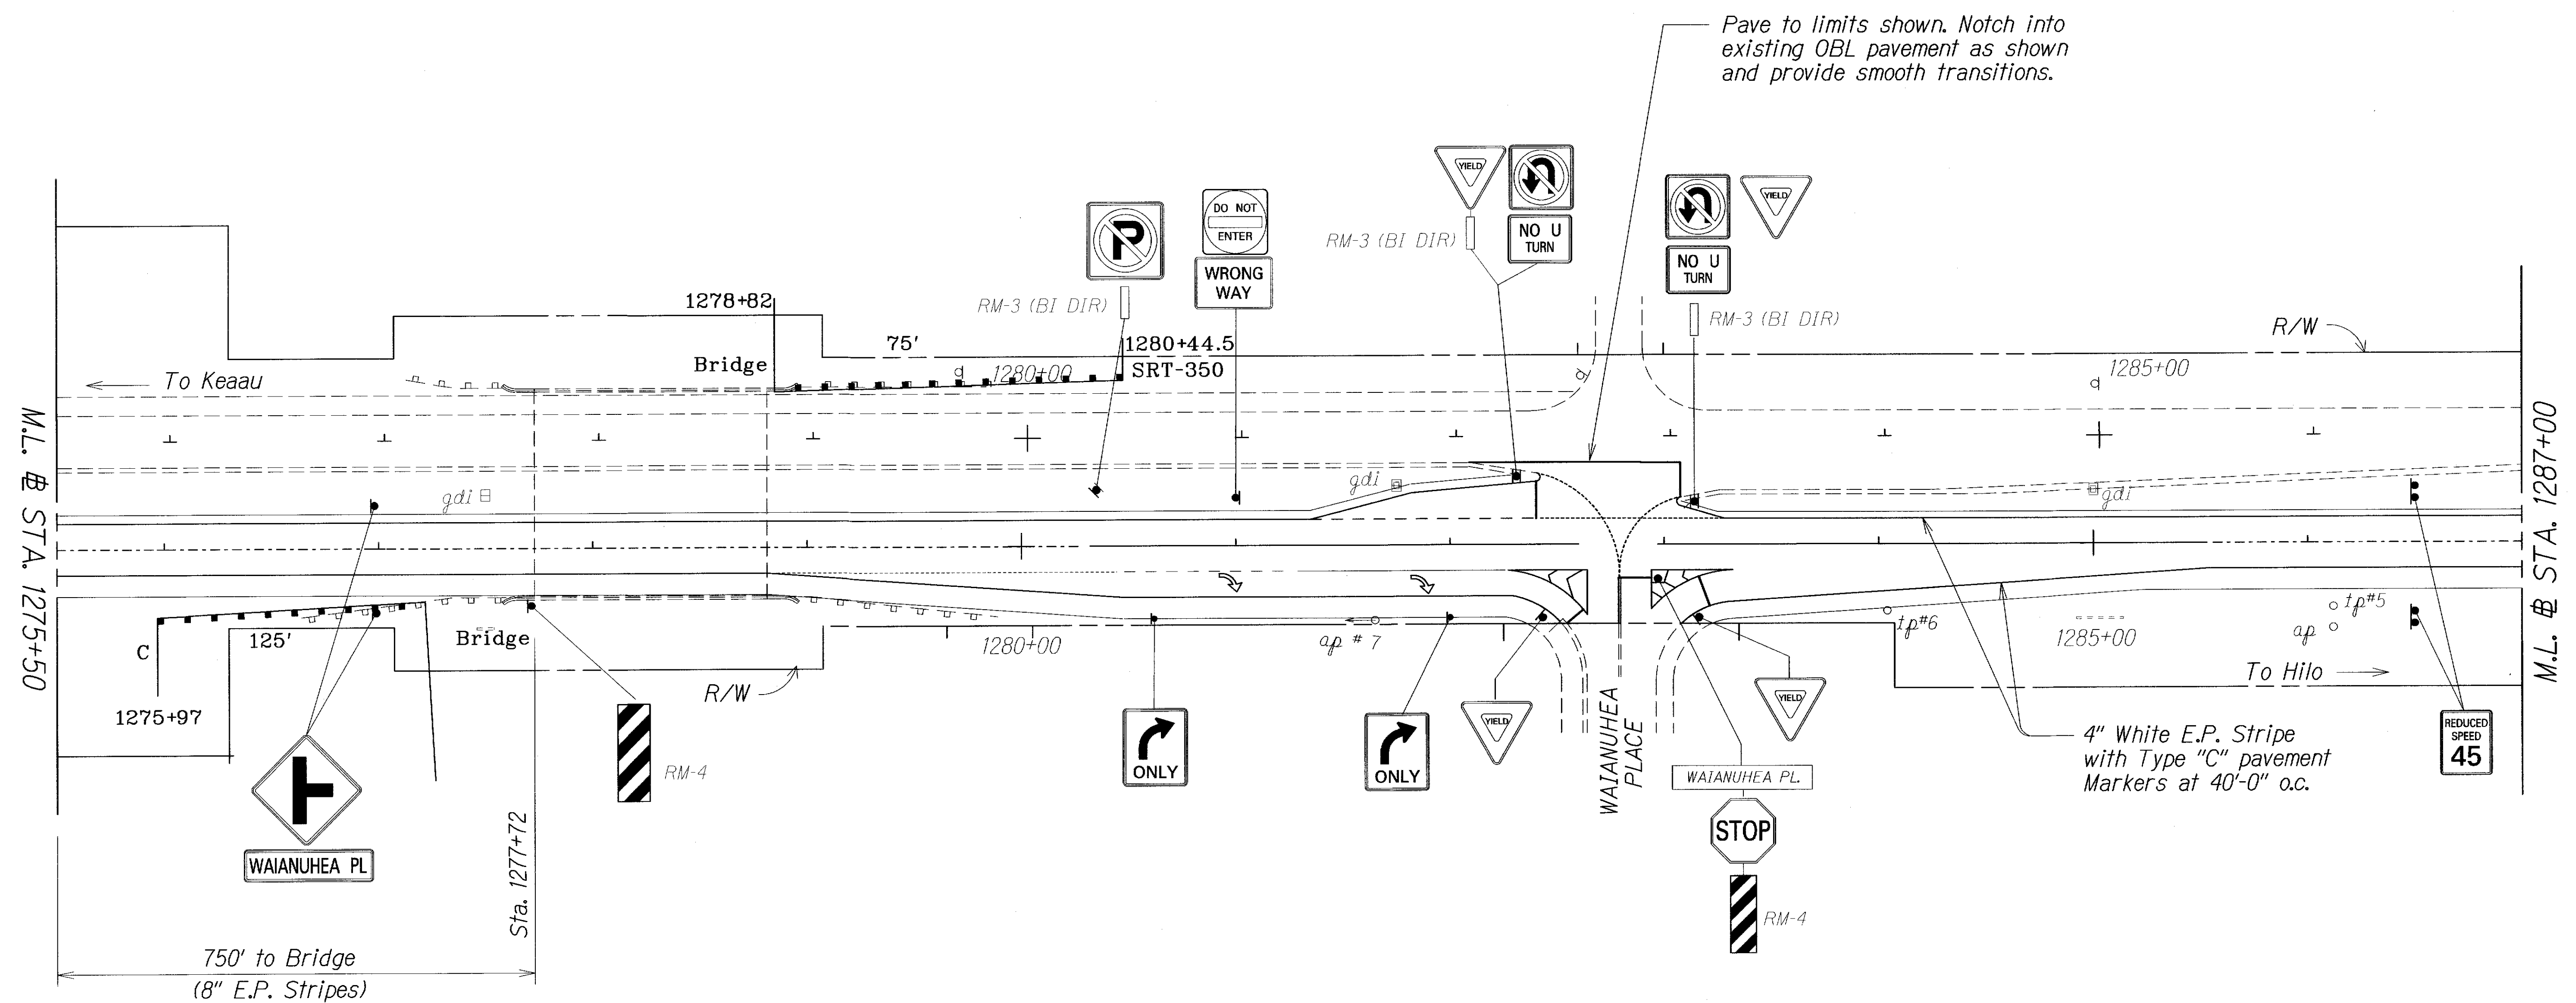

ORIGINAL PLAN	DATE
NO. 10000	4/96
DESIGNED BY	
CHECKED BY	
QUANTITIES BY	
NOTE BOOK	
DATE	
BY	

LEGEND FOR AS-BUILT POSTINGS	
	Squiggly line for as-built deletion
	Double line for as-built deletion
Roadway	Text for as-built posting

STATE OF HAWAII
DEPARTMENT OF TRANSPORTATION
HIGHWAYS DIVISION

ROADWAY PLAN (IBL)


KANOIEHUA AVENUE RESURFACING
KEAAU TO KAMEHAMEHA AVENUE
F. A. PROJECT NO. NH-011-2(33)

Scale: 1"=40' Date: April, 1996

SHEET No. 15 OF 23 SHEETS

"AS-BUILT"


FED. ROAD DIST. NO.	STATE	FED. AID PROJ. NO.	FISCAL YEAR	SHEET NO.	TOTAL SHEETS
HAWAII	HAW.	NH-011-2(33)	1996	23	102

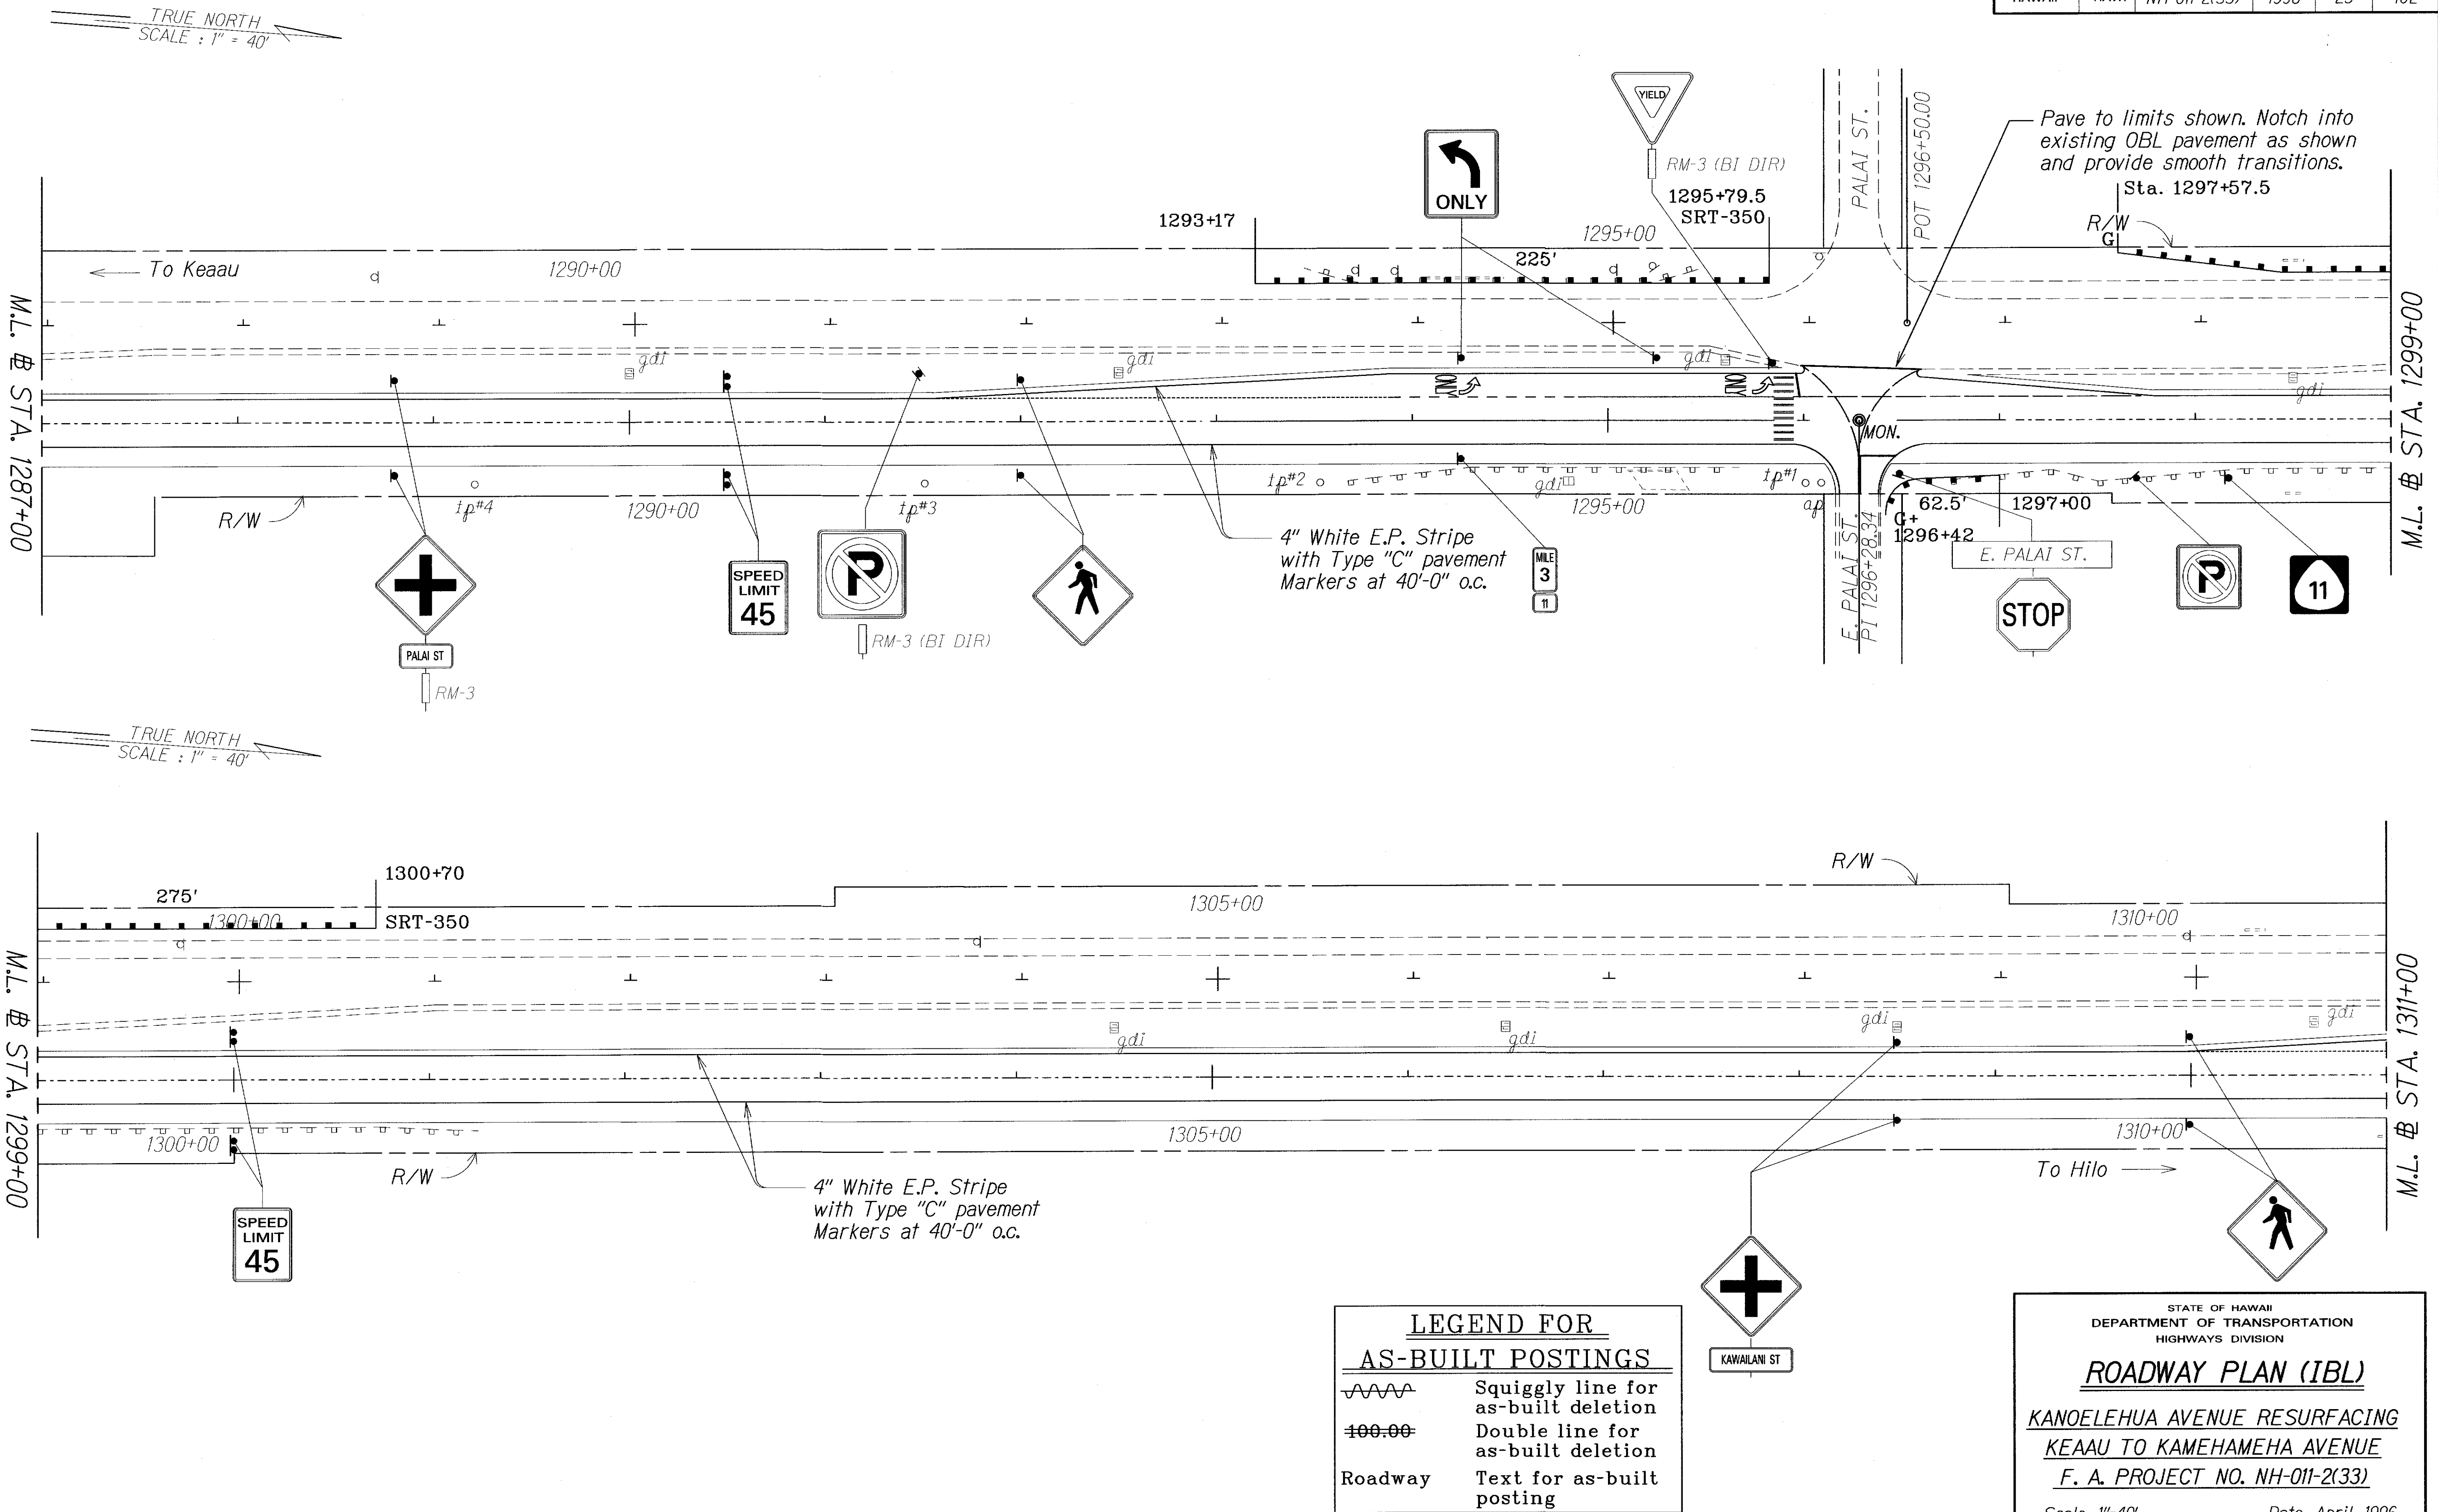

ORIGINAL PLAN	DATE	SURVEY PLOTTED BY
	1/96	
NOTE BOOK		DRAWN BY
064/2007		
N. 4/10/96		DESIGNED BY
		QUANTITIES BY
		CHECKED BY


"AS-BUILT"

FED. ROAD DIST. NO.	STATE	FED. AID PROJ. NO.	FISCAL YEAR	SHEET NO.	TOTAL SHEETS
HAWAII	HAW.	NH-011-2(33)	1996	24	102

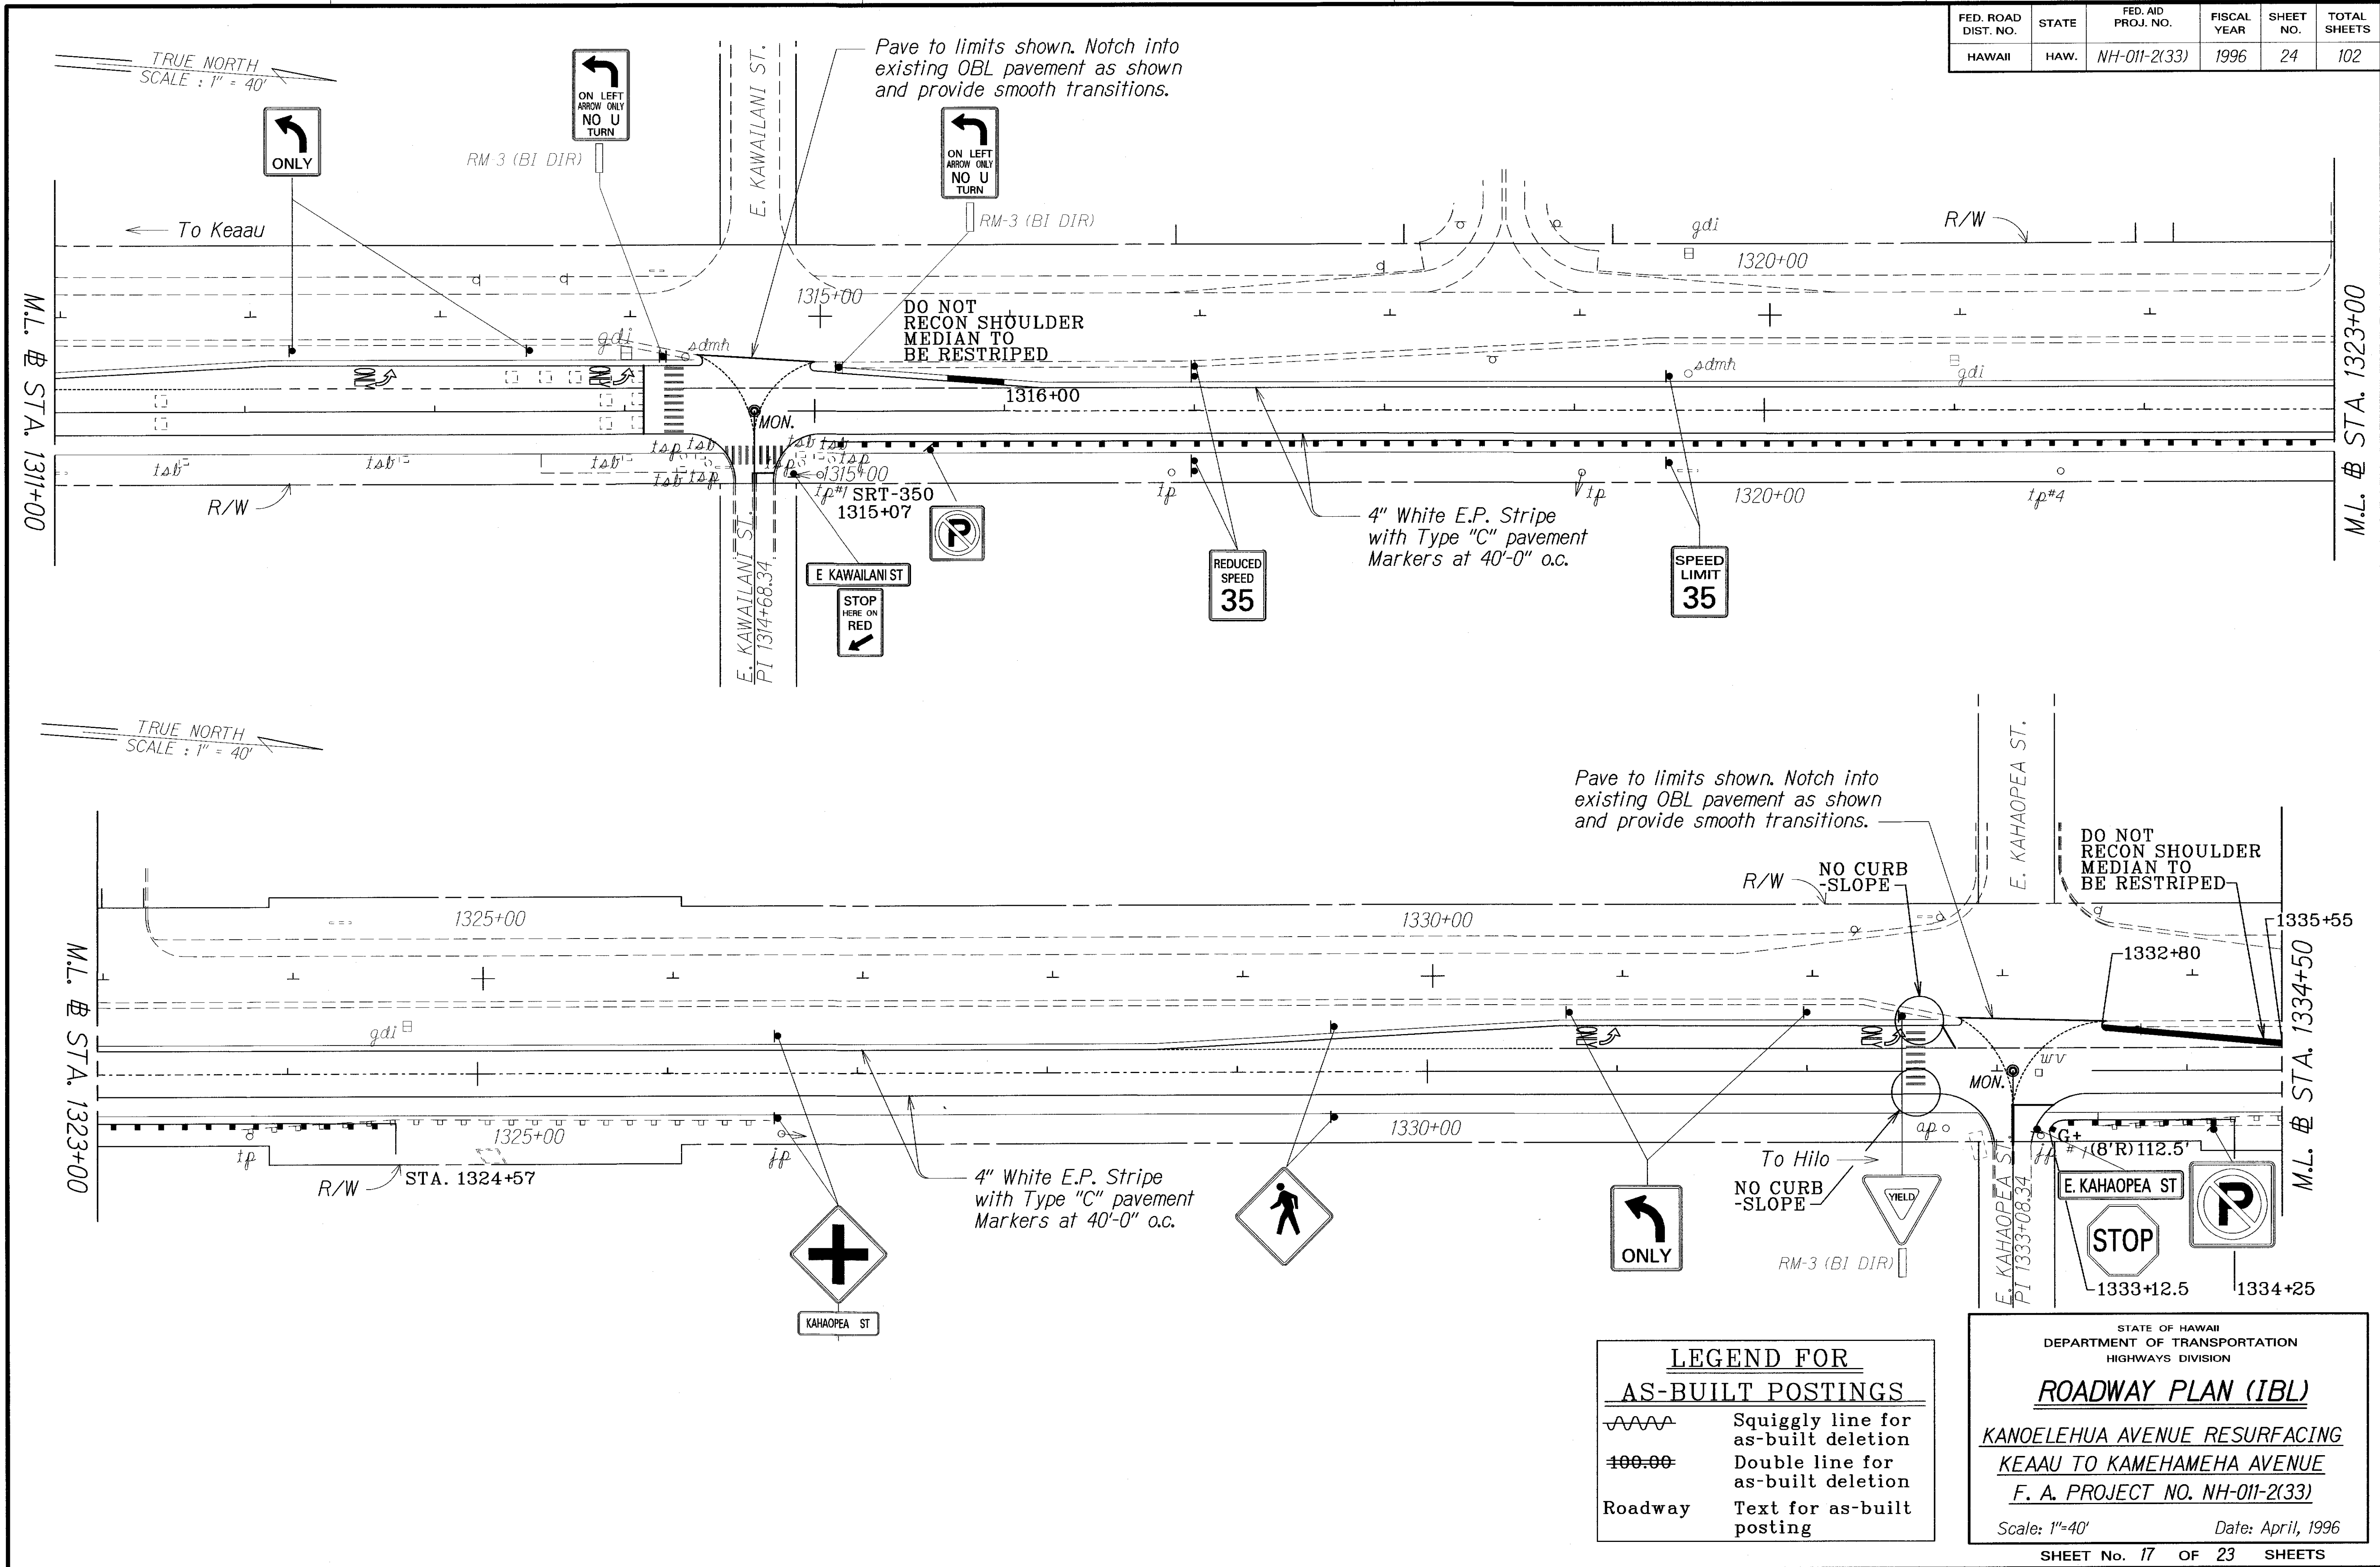

ORIGINAL PLAN	SURVEY PLOTTED BY	DATE
NOTED BY	DRAWN BY	4/96
NOTED BY	CHECKED BY	
NOTED BY	CHECKED BY	
NOTED BY	CHECKED BY	

FED. ROAD DIST. NO.	STATE	FED. AID PROJ. NO.	FISCAL YEAR	SHEET NO.	TOTAL SHEETS
HAWAII	HAW.	NH-011-2(33)	1996	25	102

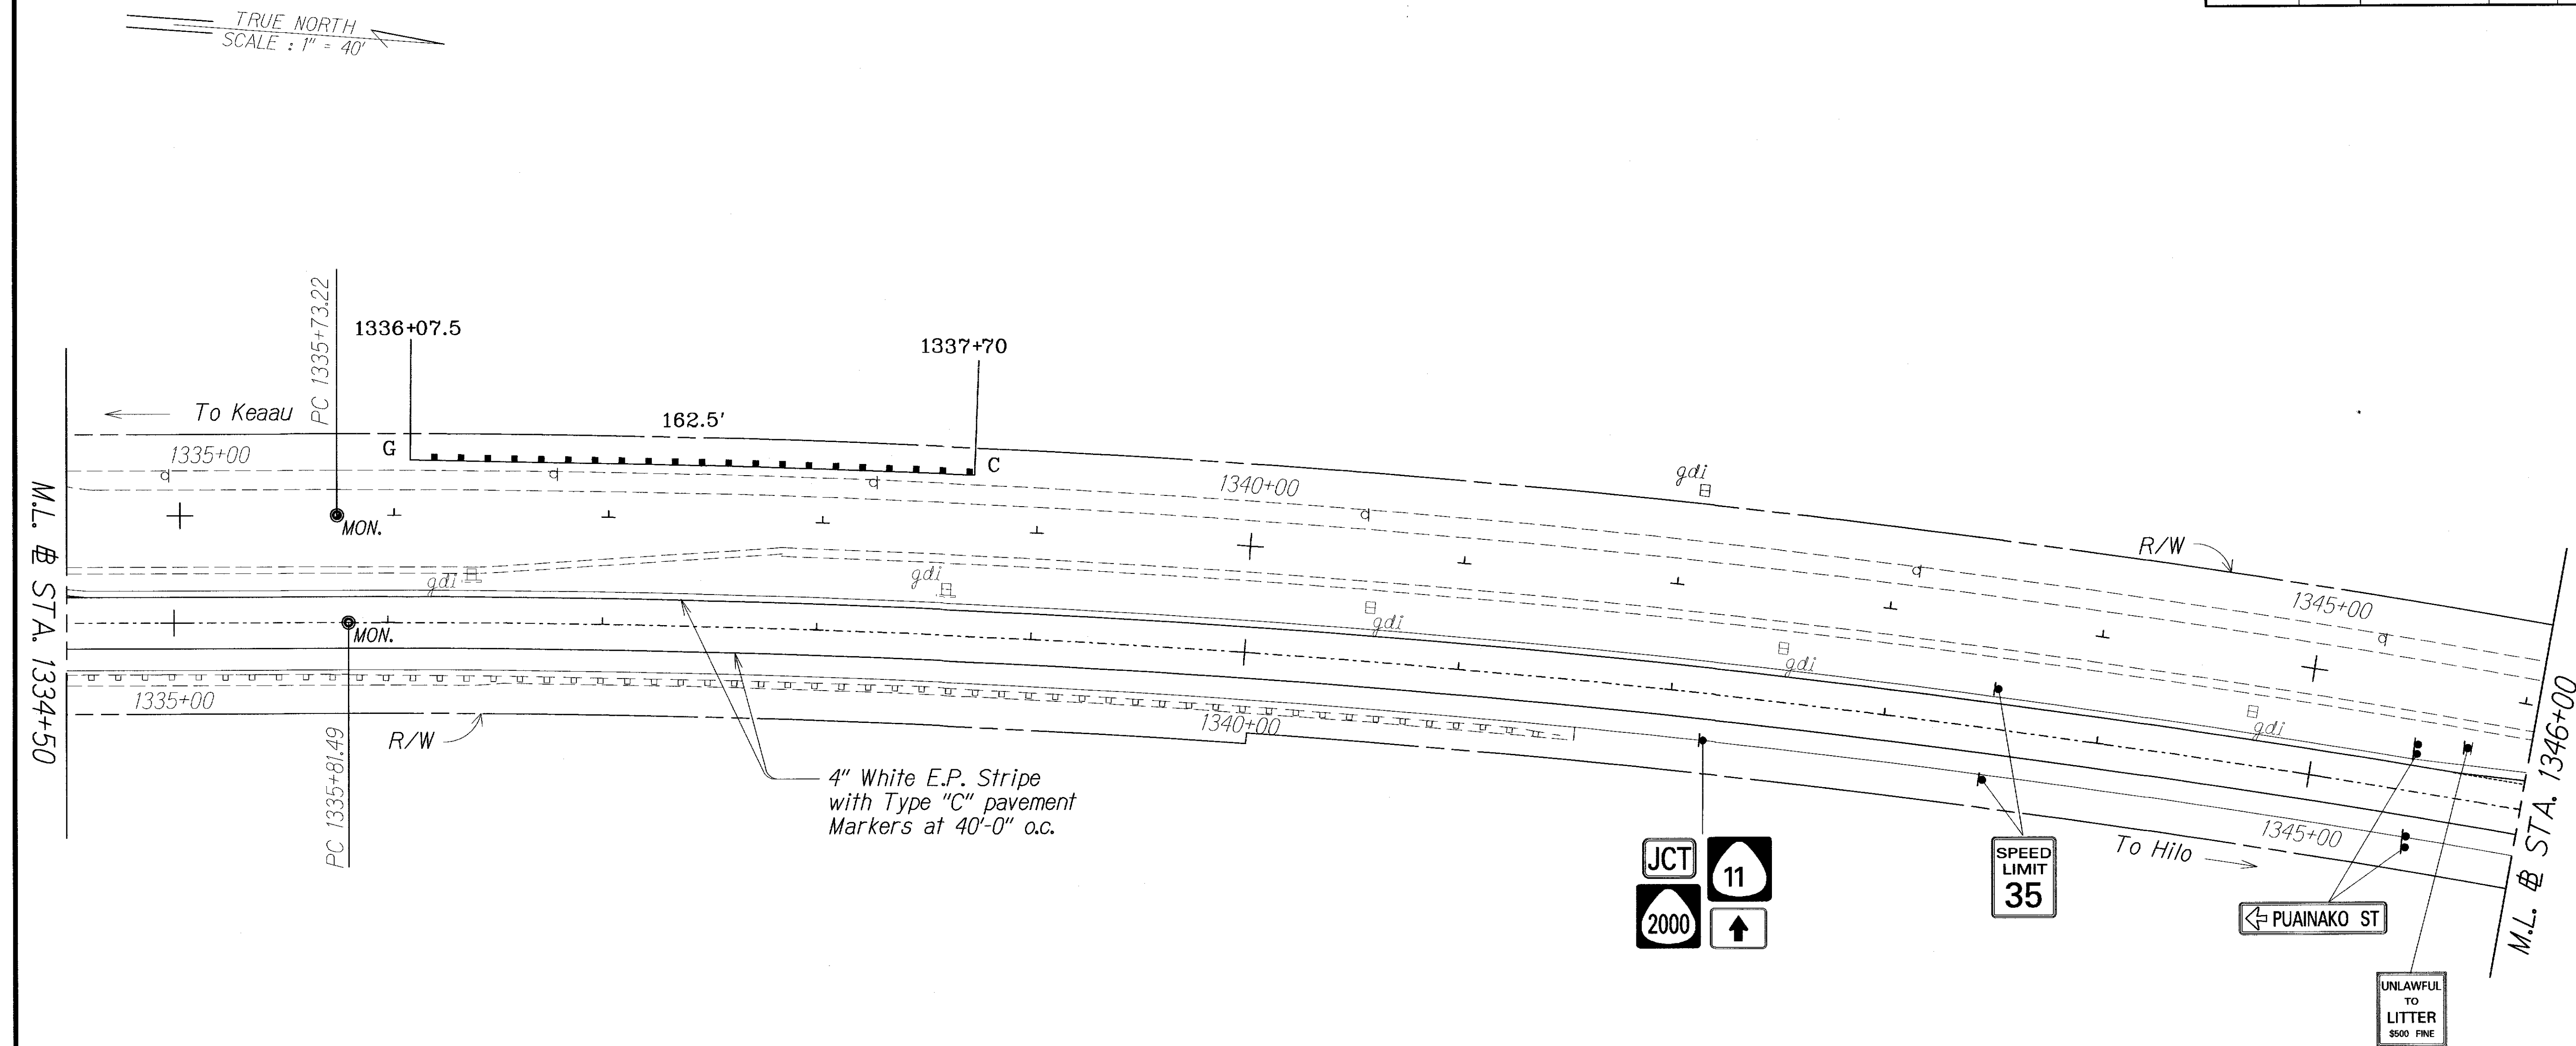

ORIGINAL PLAN	SURVEY PLOTTED BY	DATE
NOTE BOOK	DESIGNED BY	
	QUANTITIES BY	
	CHECKED BY	

LEGEND FOR AS-BUILT POSTINGS	
	Squiggly line for as-built deletion
	Double line for as-built deletion
Roadway	Text for as-built posting


STATE OF HAWAII
DEPARTMENT OF TRANSPORTATION
HIGHWAYS DIVISION

ROADWAY PLAN (IBL)
KAOELEHUA AVENUE RESURFACING
KEAAU TO KAMEHAMEHA AVENUE
F. A. PROJECT NO. NH-011-2(33)
Scale: 1"=40' Date: April, 1996

SHEET No. 18 OF 23 SHEETS

FED. ROAD DIST. NO.	STATE	FED. AID PROJ. NO.	FISCAL YEAR	SHEET NO.	TOTAL SHEETS
HAWAII	HAW.	NH-011-2(33)	1996	26	102

TRUE NORTH
SCALE : 1" = 40'

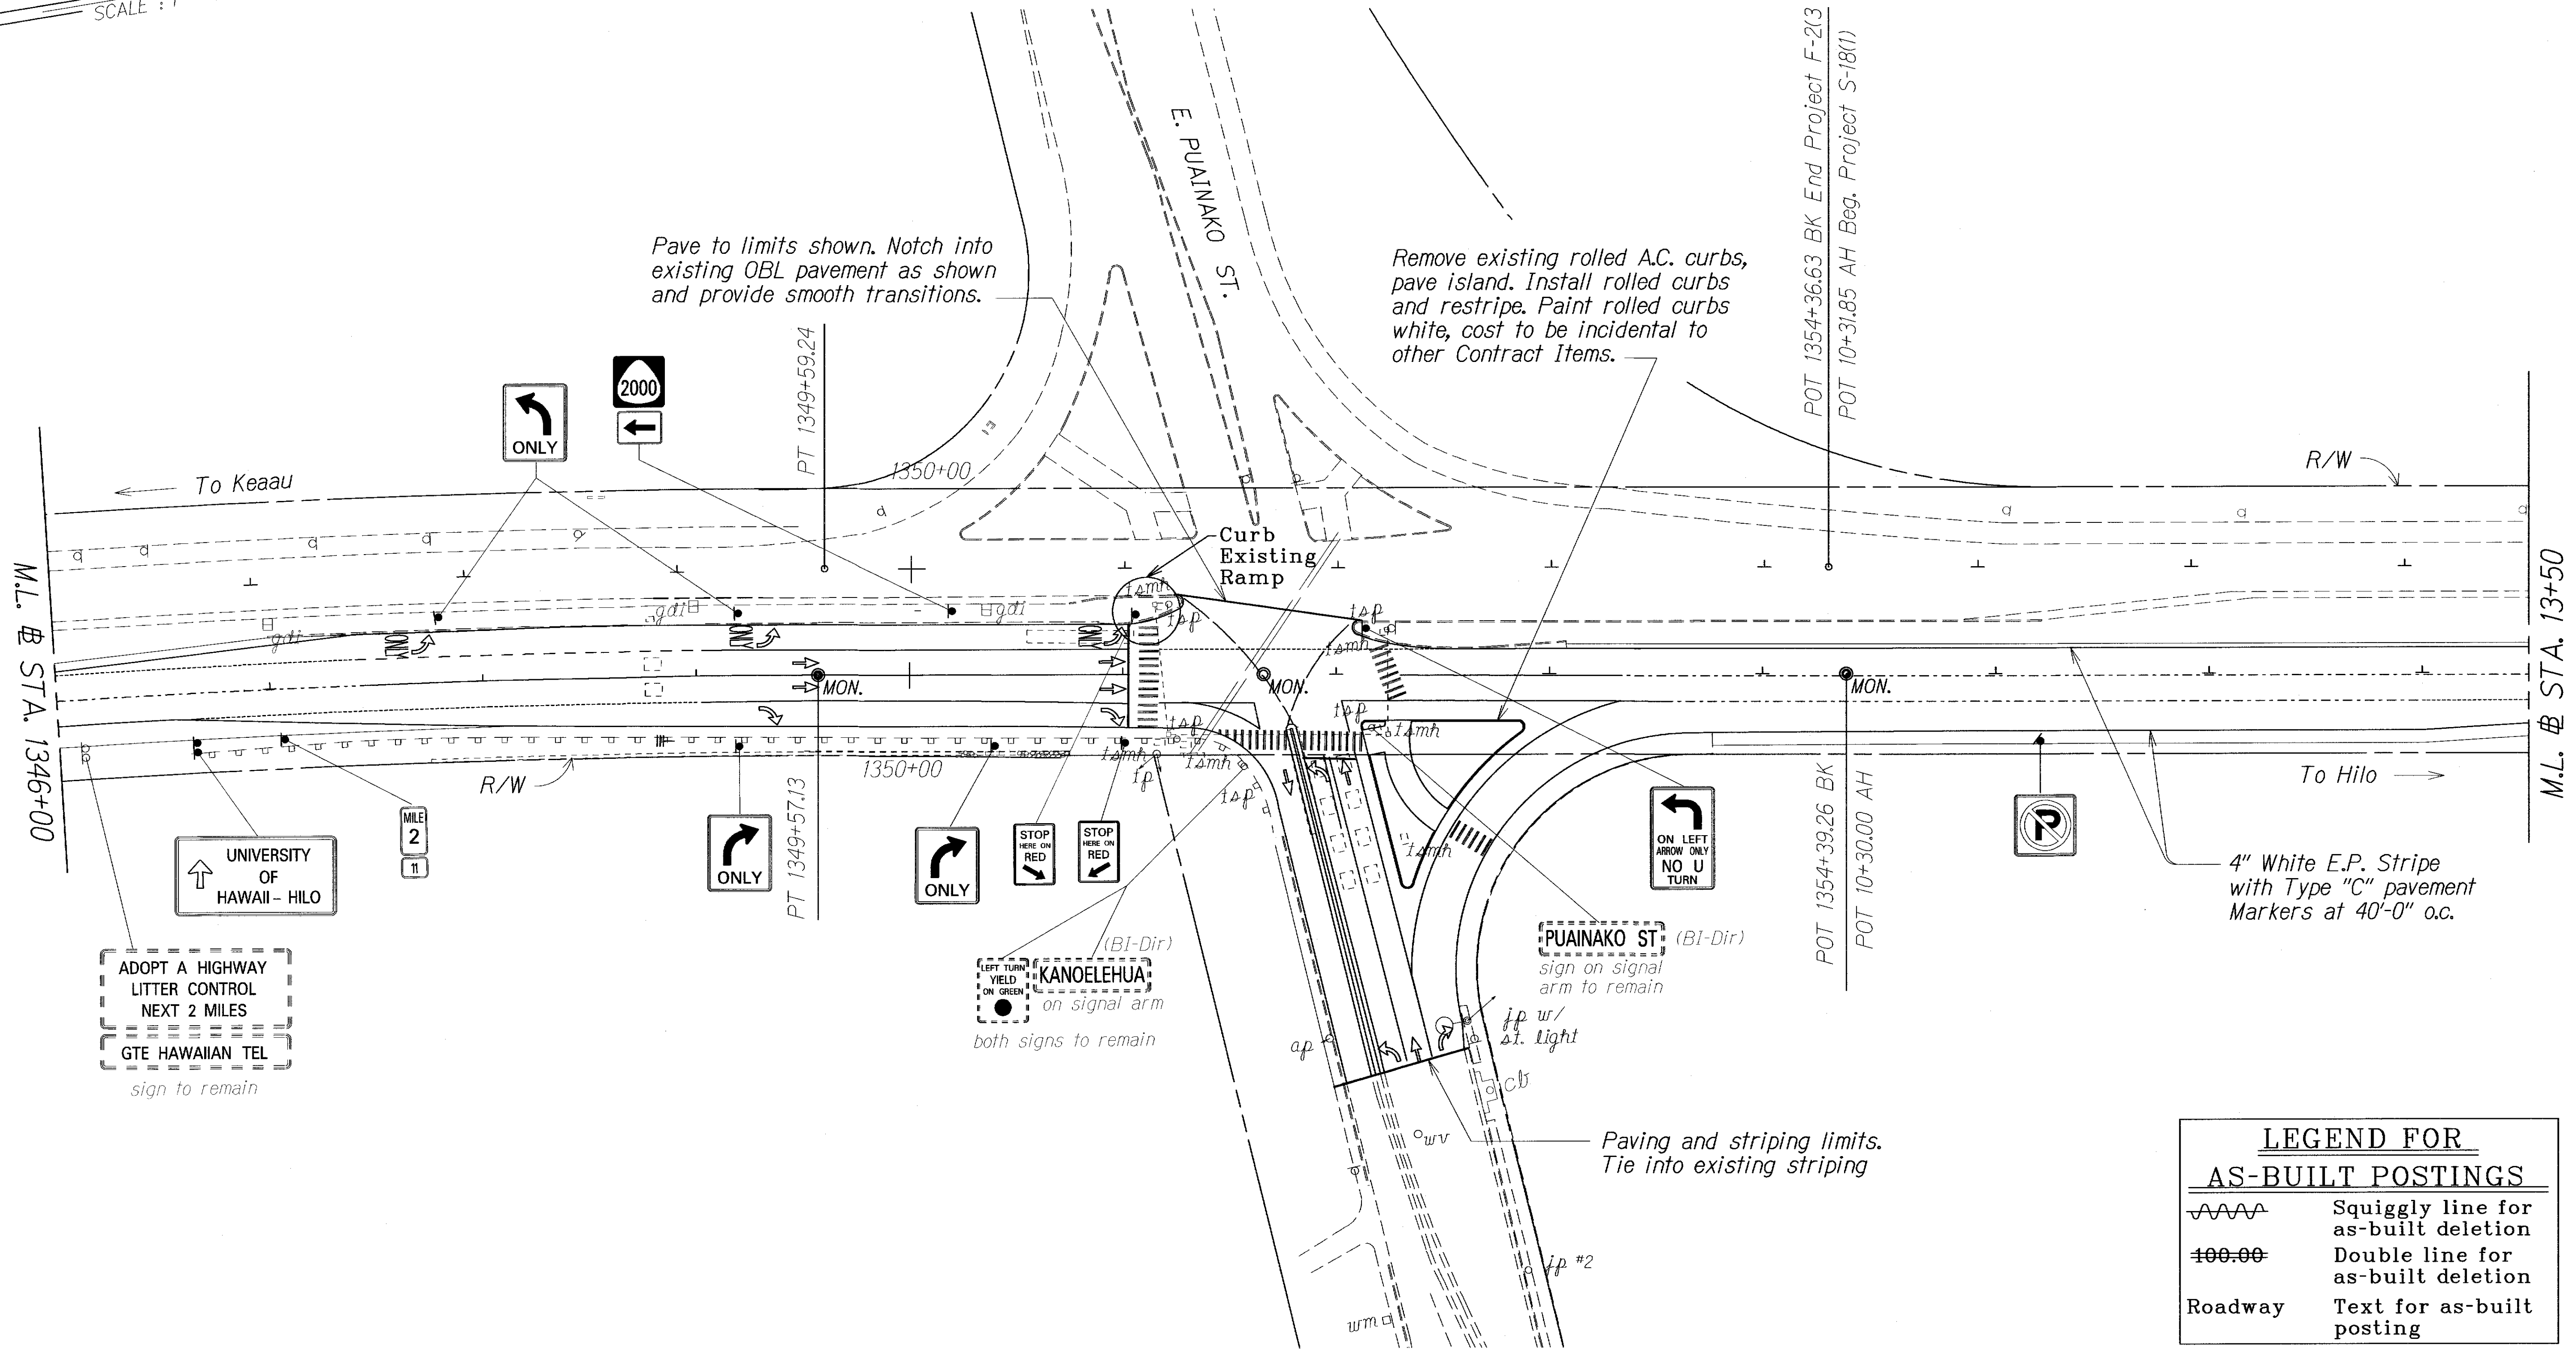

LEGEND FOR AS-BUILT POSTINGS	
	Squiggly line for as-built deletion
	Double line for as-built deletion
Roadway	Text for as-built posting

STATE OF HAWAII
DEPARTMENT OF TRANSPORTATION
HIGHWAYS DIVISION

ROADWAY PLAN (IBL)
KANOELEHUA AVENUE RESURFACING
KEAAU TO KAMEHAMEHA AVENUE
F. A. PROJECT NO. NH-011-2(33)
Scale: 1"=40' Date: April, 1996


SHEET No. 19 OF 23 SHEETS

ORIGINAL PLAN	SURVEY PLOTTED BY	DATE
NOTE BOOK	DRAWN BY	4/96
064/ason	TRACED BY	
N. drinap	CHECKED BY	


"AS-BUILT"

FED. ROAD DIST. NO.	STATE	FED. AID PROJ. NO.	FISCAL YEAR	SHEET NO.	TOTAL SHEETS
HAWAII	HAW.	NH-011-2(33)	1996	27	102

TRUE NORTH
SCALE: 1" = 40'

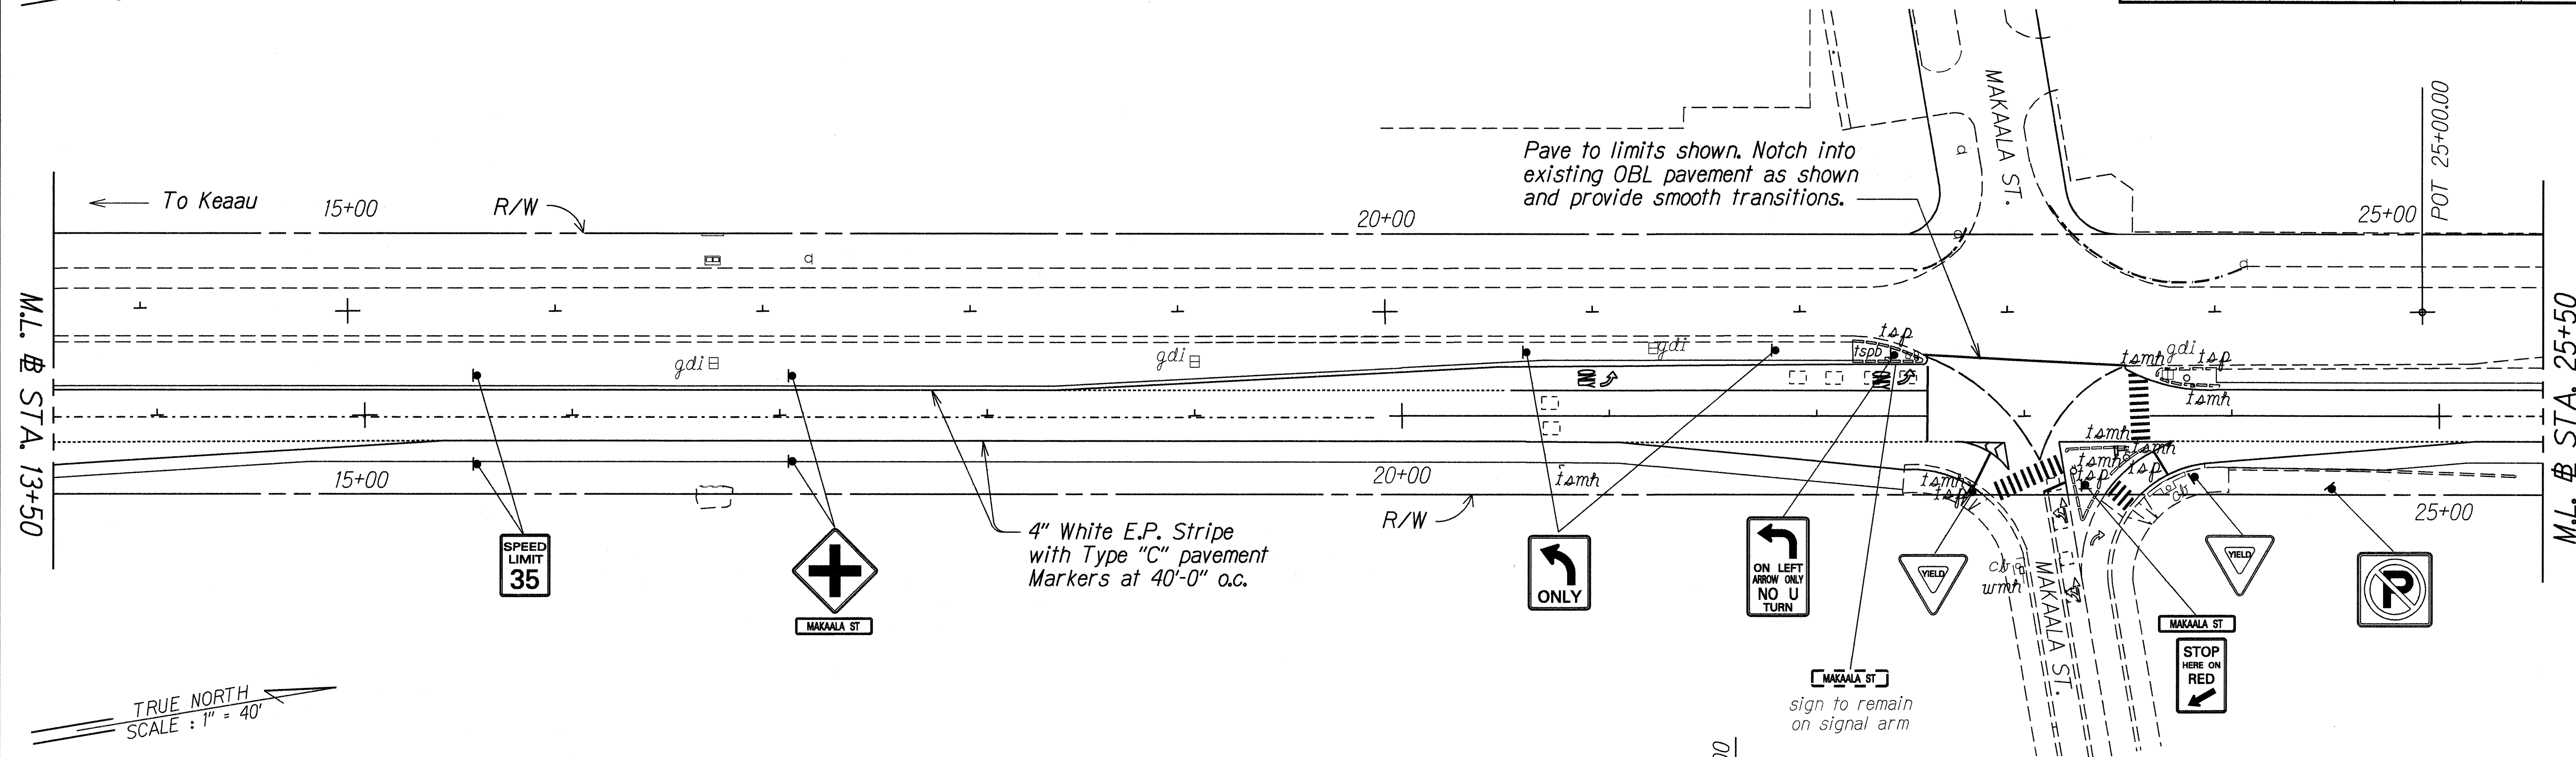

TRUE NORTH
SCALE: 1" = 40'

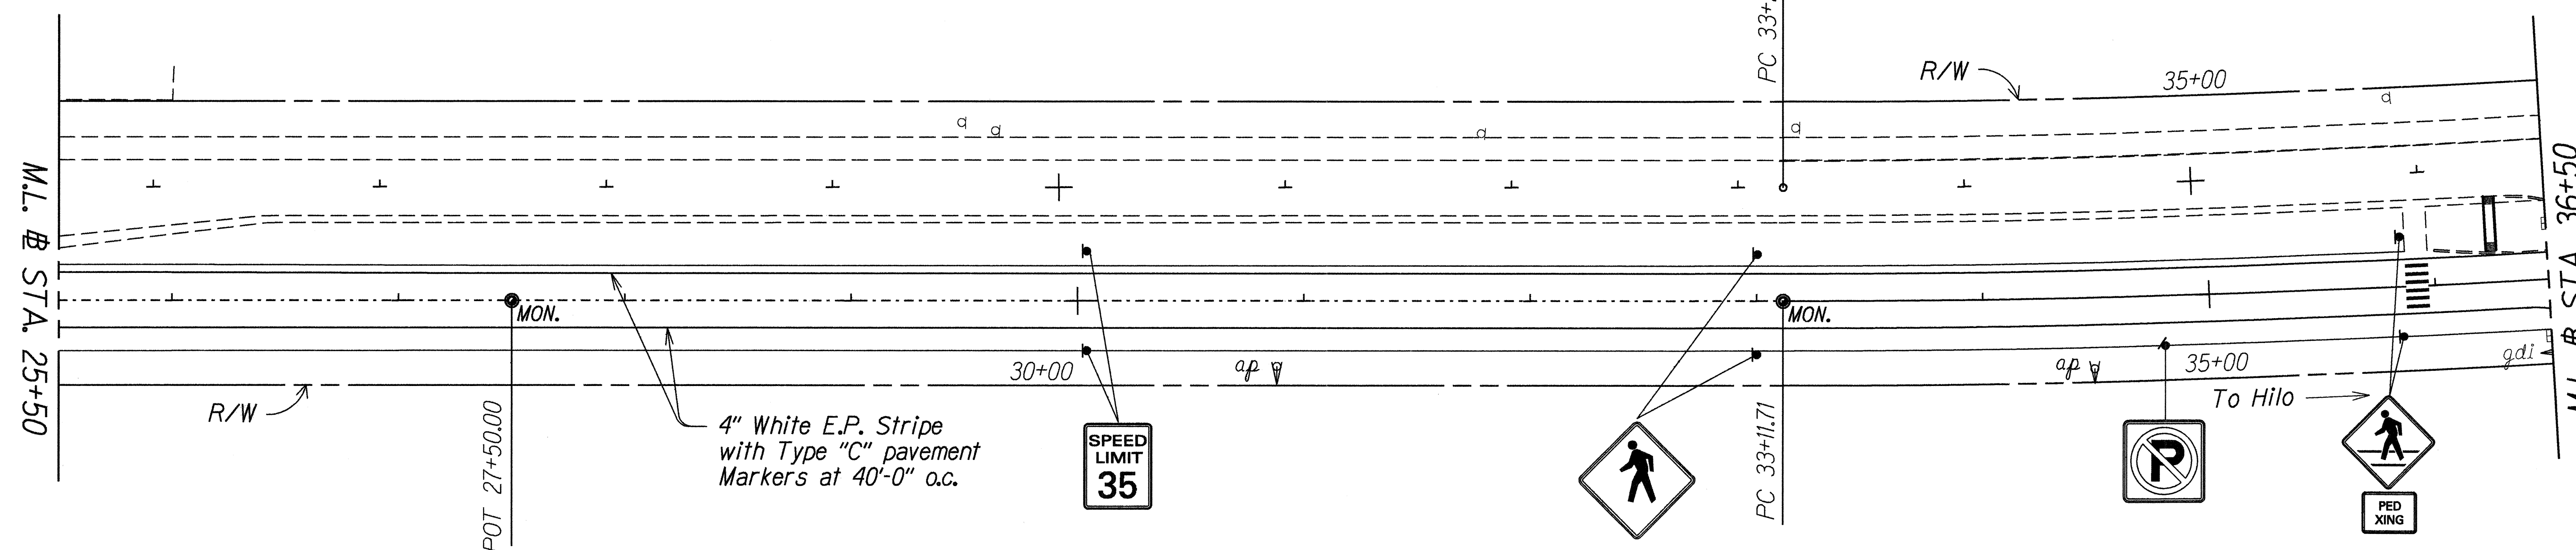

ORIGINAL PLAN	DATE	7/96
DESIGNED BY		
CHECKED BY		
NOTED BY		
DATE		
BY		

STATE OF HAWAII
DEPARTMENT OF TRANSPORTATION
HIGHWAYS DIVISION


ROADWAY PLAN (IBL)

KAOELEHUA AVENUE RESURFACING
KEAAU TO KAMEHAMEHA AVENUE
F. A. PROJECT NO. NH-011-2(33)

Scale: 1"=40' Date: April, 1996

SHEET No. 20 OF 23 SHEETS

FED. ROAD DIST. NO.	STATE	FED. AID PROJ. NO.	FISCAL YEAR	SHEET NO.	TOTAL SHEETS
HAWAII	HAW.	NH-011-2(33)	1996	28	102

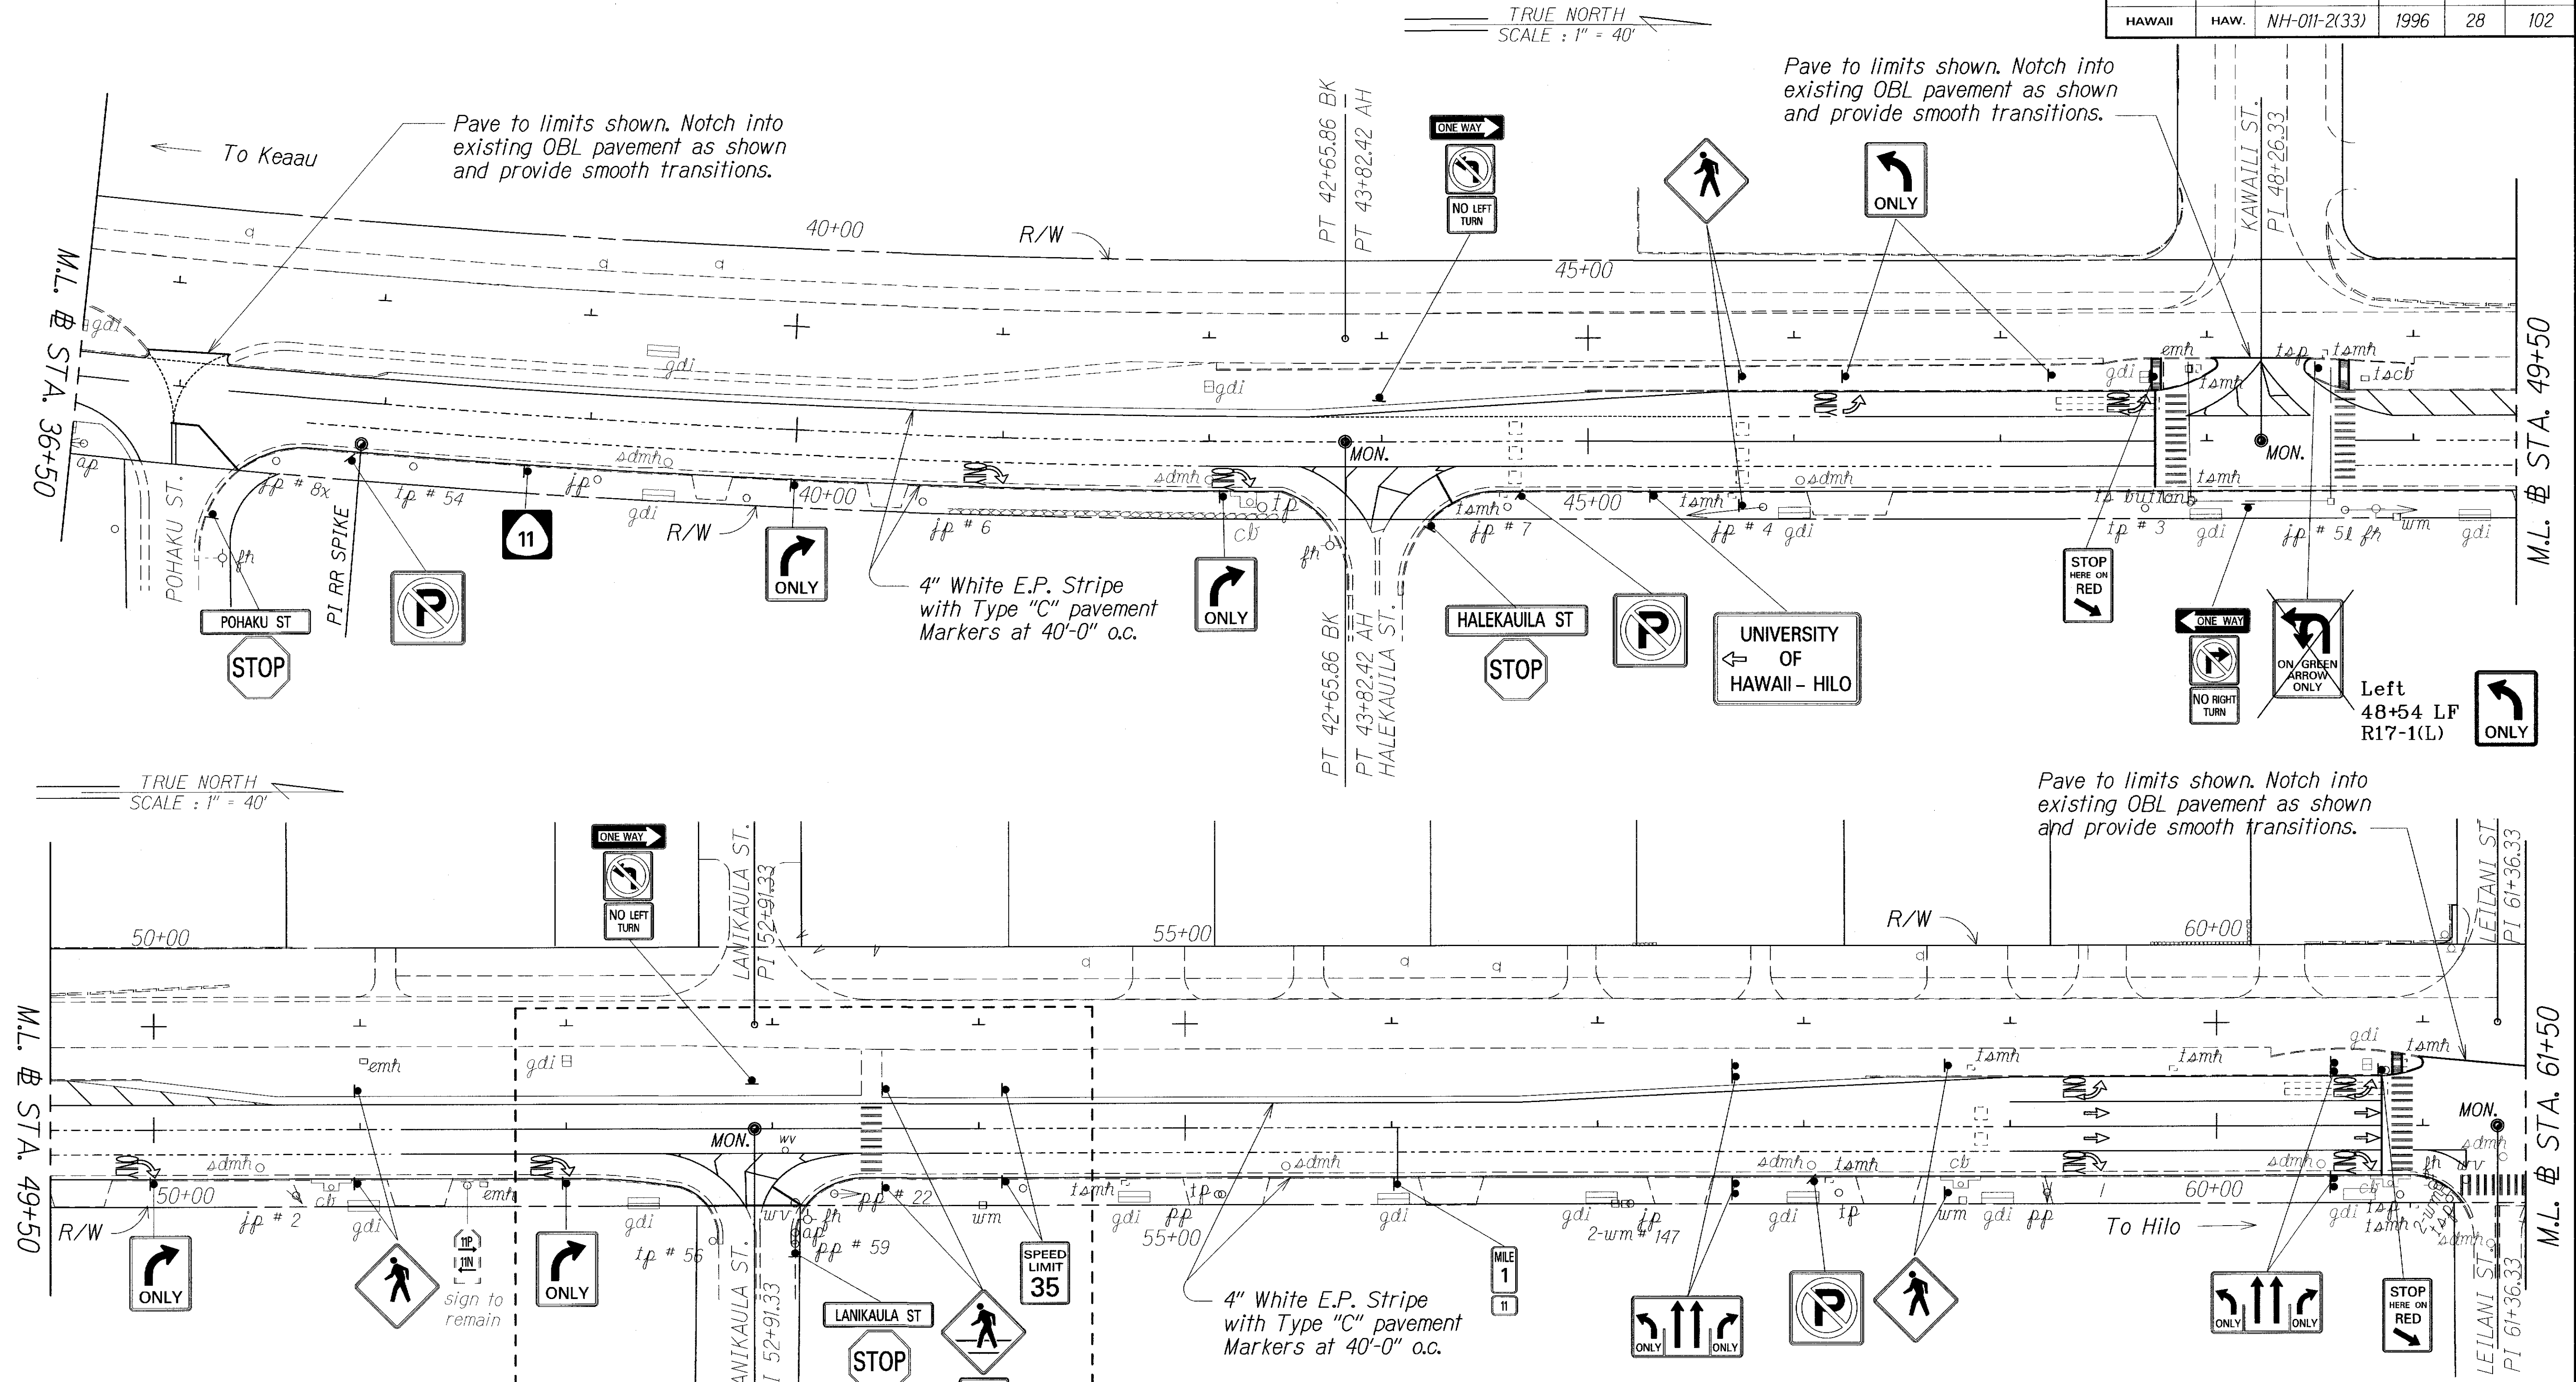

ORIGINAL PLAN	DATE	4/95
SURVEY PLOTTED BY		
DRAWN BY		
DESIGNED BY		
CHECKED BY		

LEGEND FOR AS-BUILT POSTINGS	
	Squiggly line for as-built deletion
	Double line for as-built deletion
Roadway	Text for as-built posting

STATE OF HAWAII
DEPARTMENT OF TRANSPORTATION
HIGHWAYS DIVISION

ROADWAY PLAN (IBL)


KAOELEHUA AVENUE RESURFACING
KEAAU TO KAMEHAMEHA AVENUE
F. A. PROJECT NO. NH-011-2(33)

Scale: 1"=40' Date: April, 1996

SHEET No. 21 OF 23 SHEETS

"AS-BUILT"

FED. ROAD DIST. NO.	STATE	FED. AID PROJ. NO.	FISCAL YEAR	SHEET NO.	TOTAL SHEETS
HAWAII	HAW.	NH-011-2(33)	1996	28	102

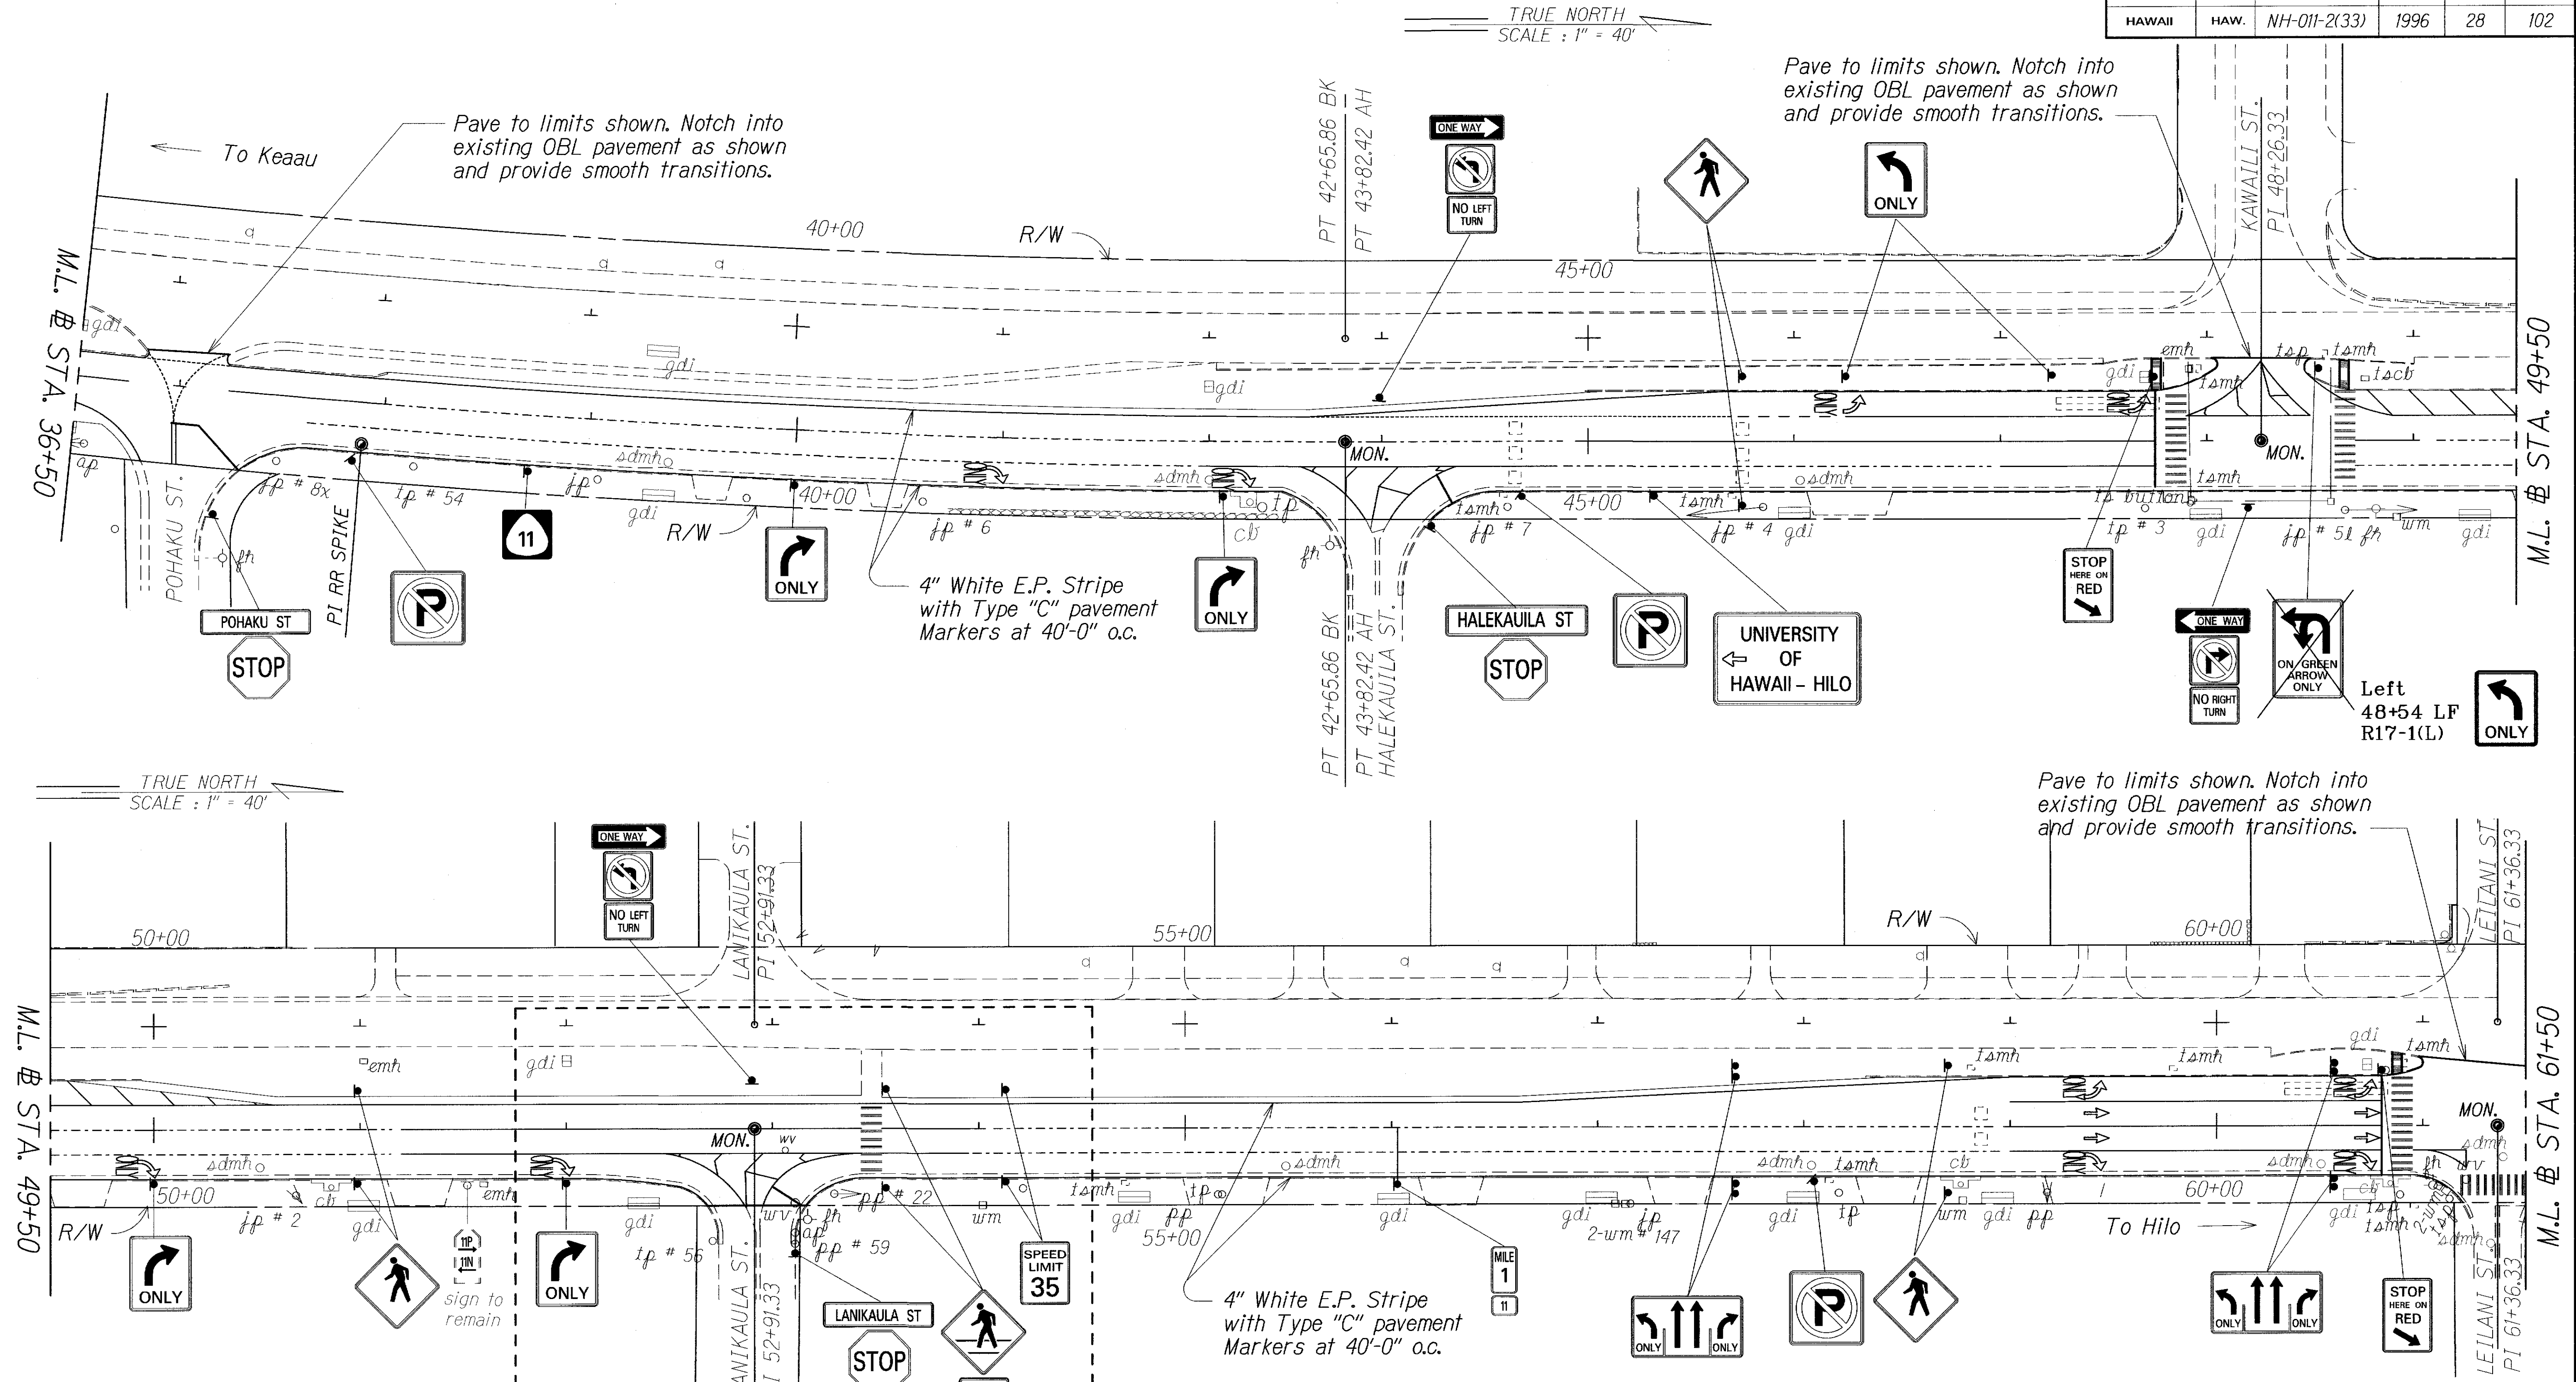

ORIGINAL PLAN	DATE	4/95
SURVEY PLOTTED BY		
DRAWN BY		
DESIGNED BY		
CHECKED BY		

LEGEND FOR AS-BUILT POSTINGS	
	Squiggly line for as-built deletion
	Double line for as-built deletion
Roadway	Text for as-built posting

STATE OF HAWAII
DEPARTMENT OF TRANSPORTATION
HIGHWAYS DIVISION

ROADWAY PLAN (IBL)


KAOELEHUA AVENUE RESURFACING
KEAAU TO KAMEHAMEHA AVENUE
F. A. PROJECT NO. NH-011-2(33)

Scale: 1"=40' Date: April, 1996

SHEET No. 21 OF 23 SHEETS

"AS-BUILT"

FED. ROAD DIST. NO.	STATE	FED. AID PROJ. NO.	FISCAL YEAR	SHEET NO.	TOTAL SHEETS
HAWAII	HAW.	NH-01102(33)	1996	30	102

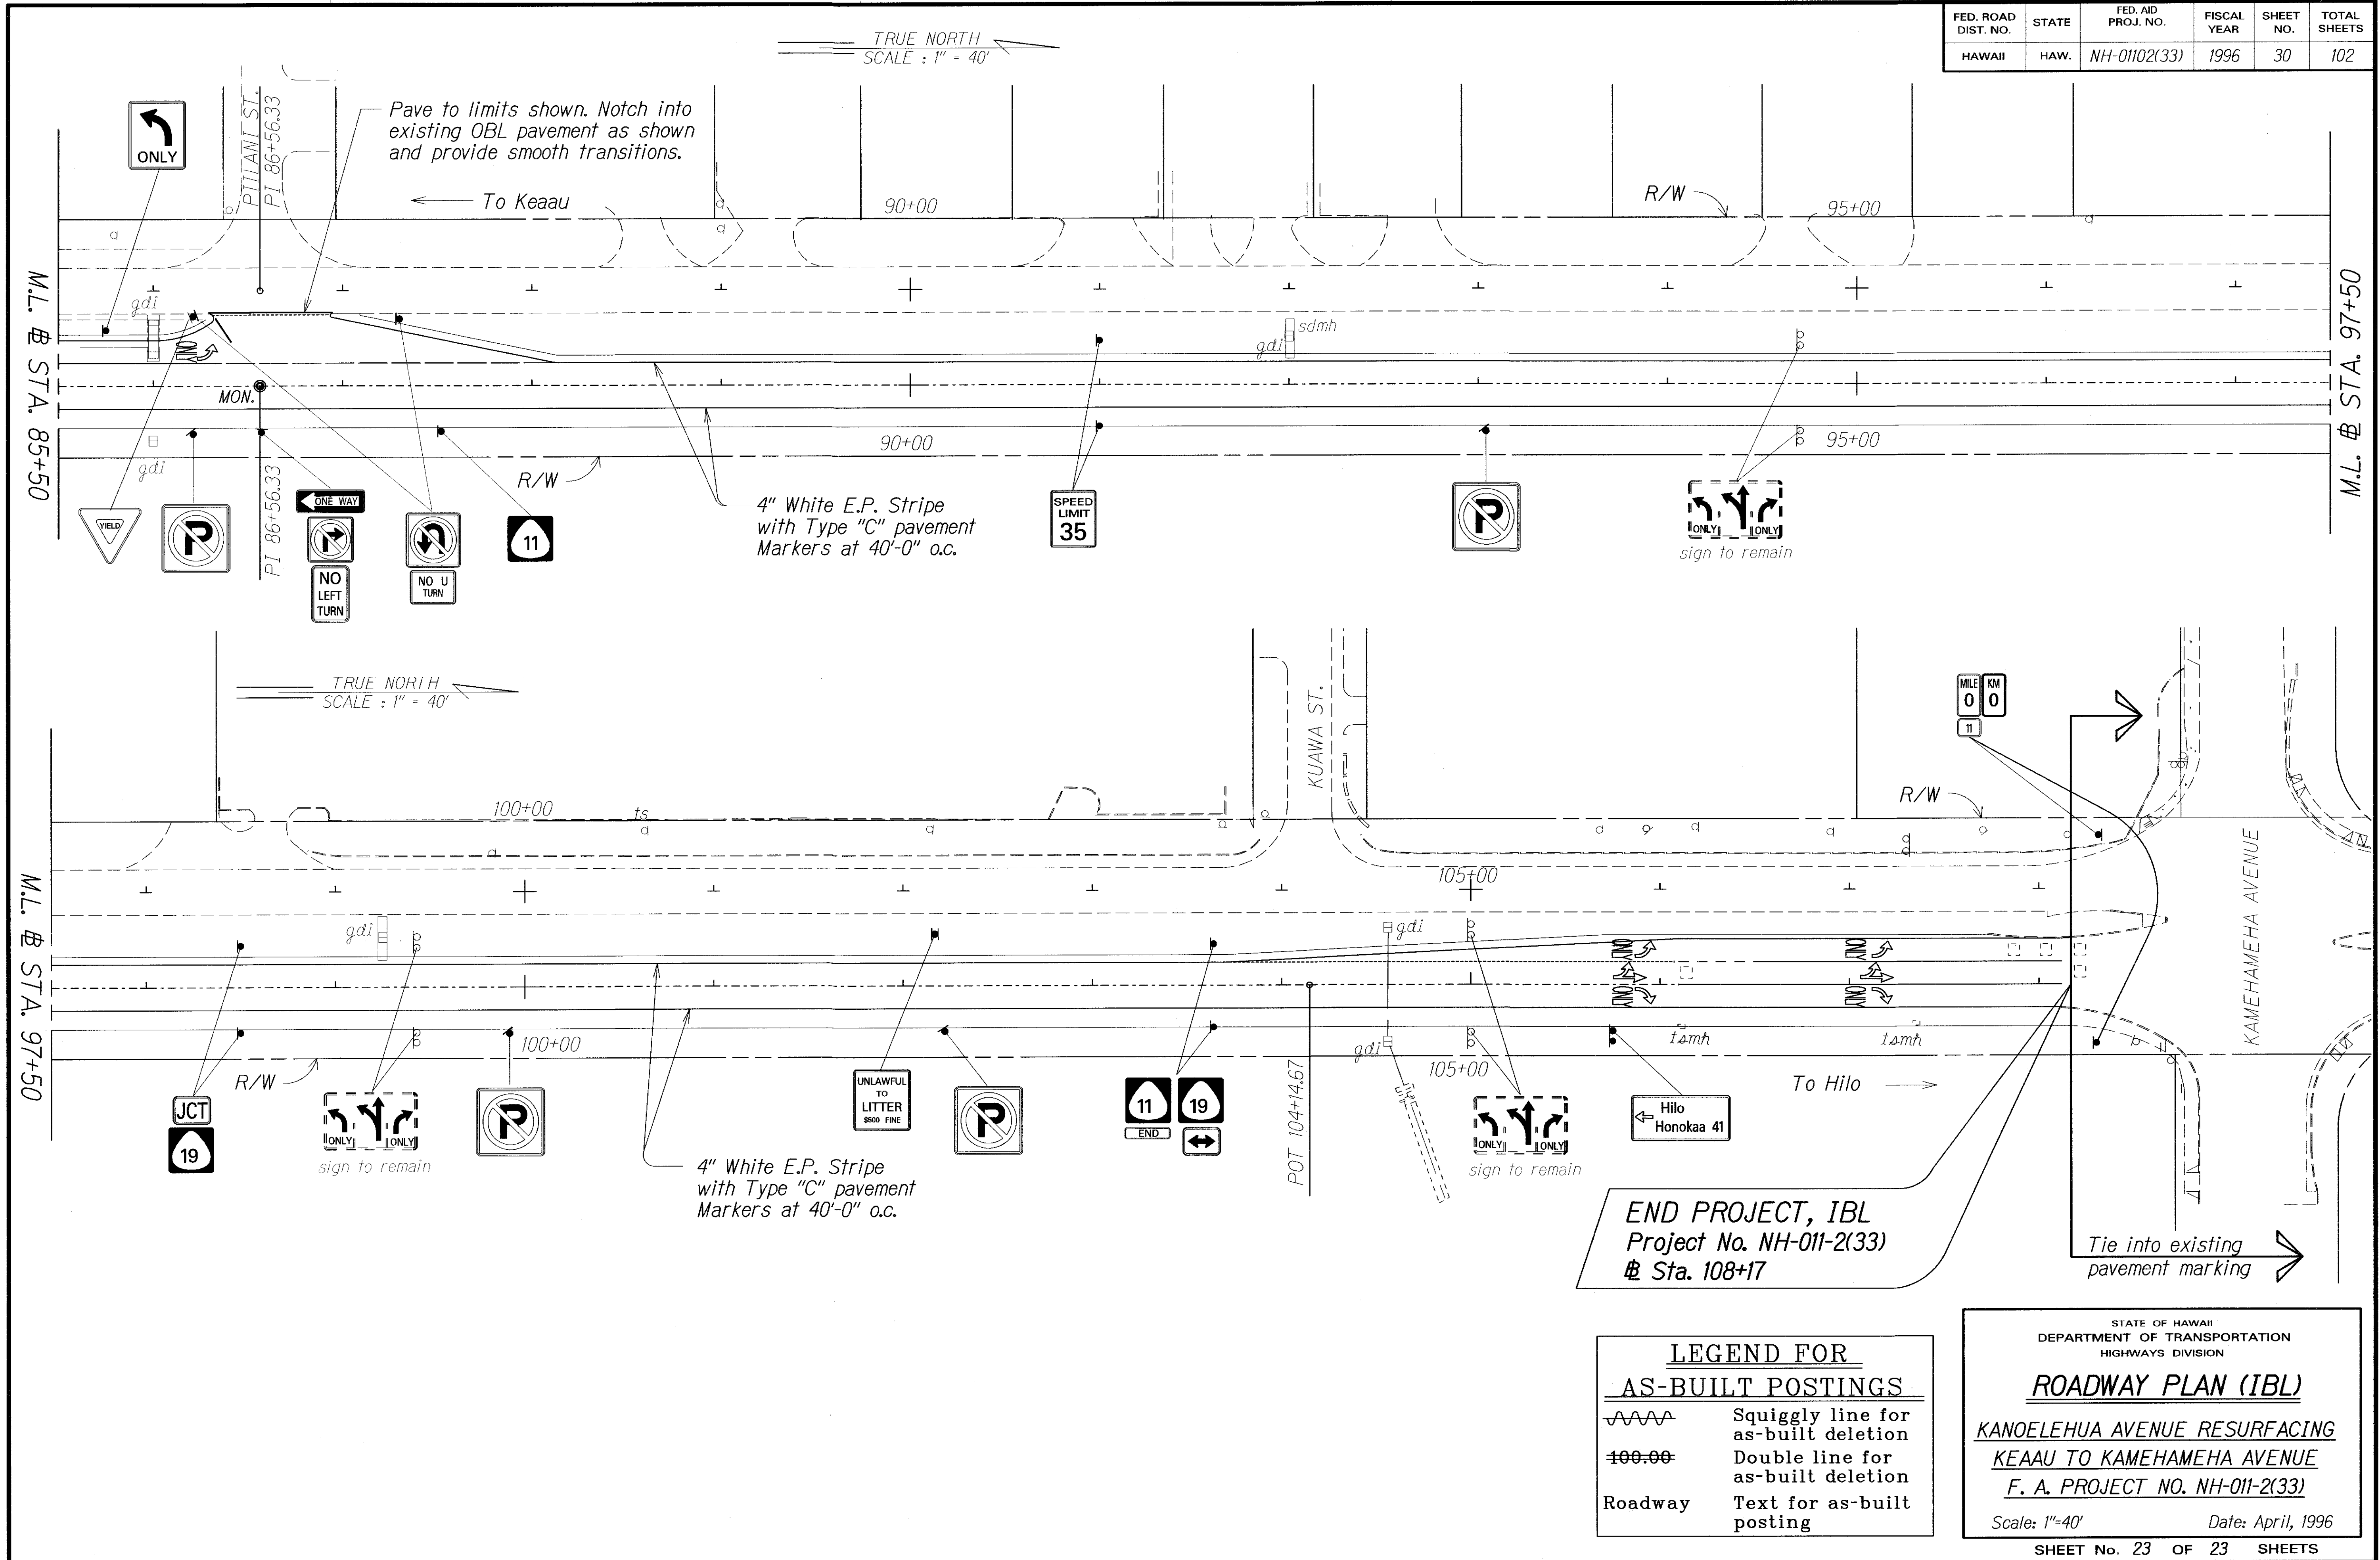

ORIGINAL PLAN	SURVEY PLOTTED BY	DATE
	DRAWN BY	4/96
NOTE BOOK	DESIGNED BY	
	CHECKED BY	

END PROJECT, IBL
Project No. NH-011-2(33)
Sta. 108+17

LEGEND FOR AS-BUILT POSTINGS	
	Squiggly line for as-built deletion
	Double line for as-built deletion
Roadway	Text for as-built posting

STATE OF HAWAII
DEPARTMENT OF TRANSPORTATION
HIGHWAYS DIVISION

ROADWAY PLAN (IBL)
KANOELEHUA AVENUE RESURFACING
KEAAU TO KAMEHAMEHA AVENUE
F. A. PROJECT NO. NH-011-2(33)
Scale: 1"=40'
Date: April, 1996

SHEET No. 23 OF 23 SHEETS