


FED. ROAD DIST. NO.	STATE	FED. AID PROJ. NO.	FISCAL YEAR	SHEET NO.	TOTAL SHEETS
HAWAII	HAW.	NH-011-2(33)	1996	65	102

TRUE NORTH
SCALE : 1" = 40'

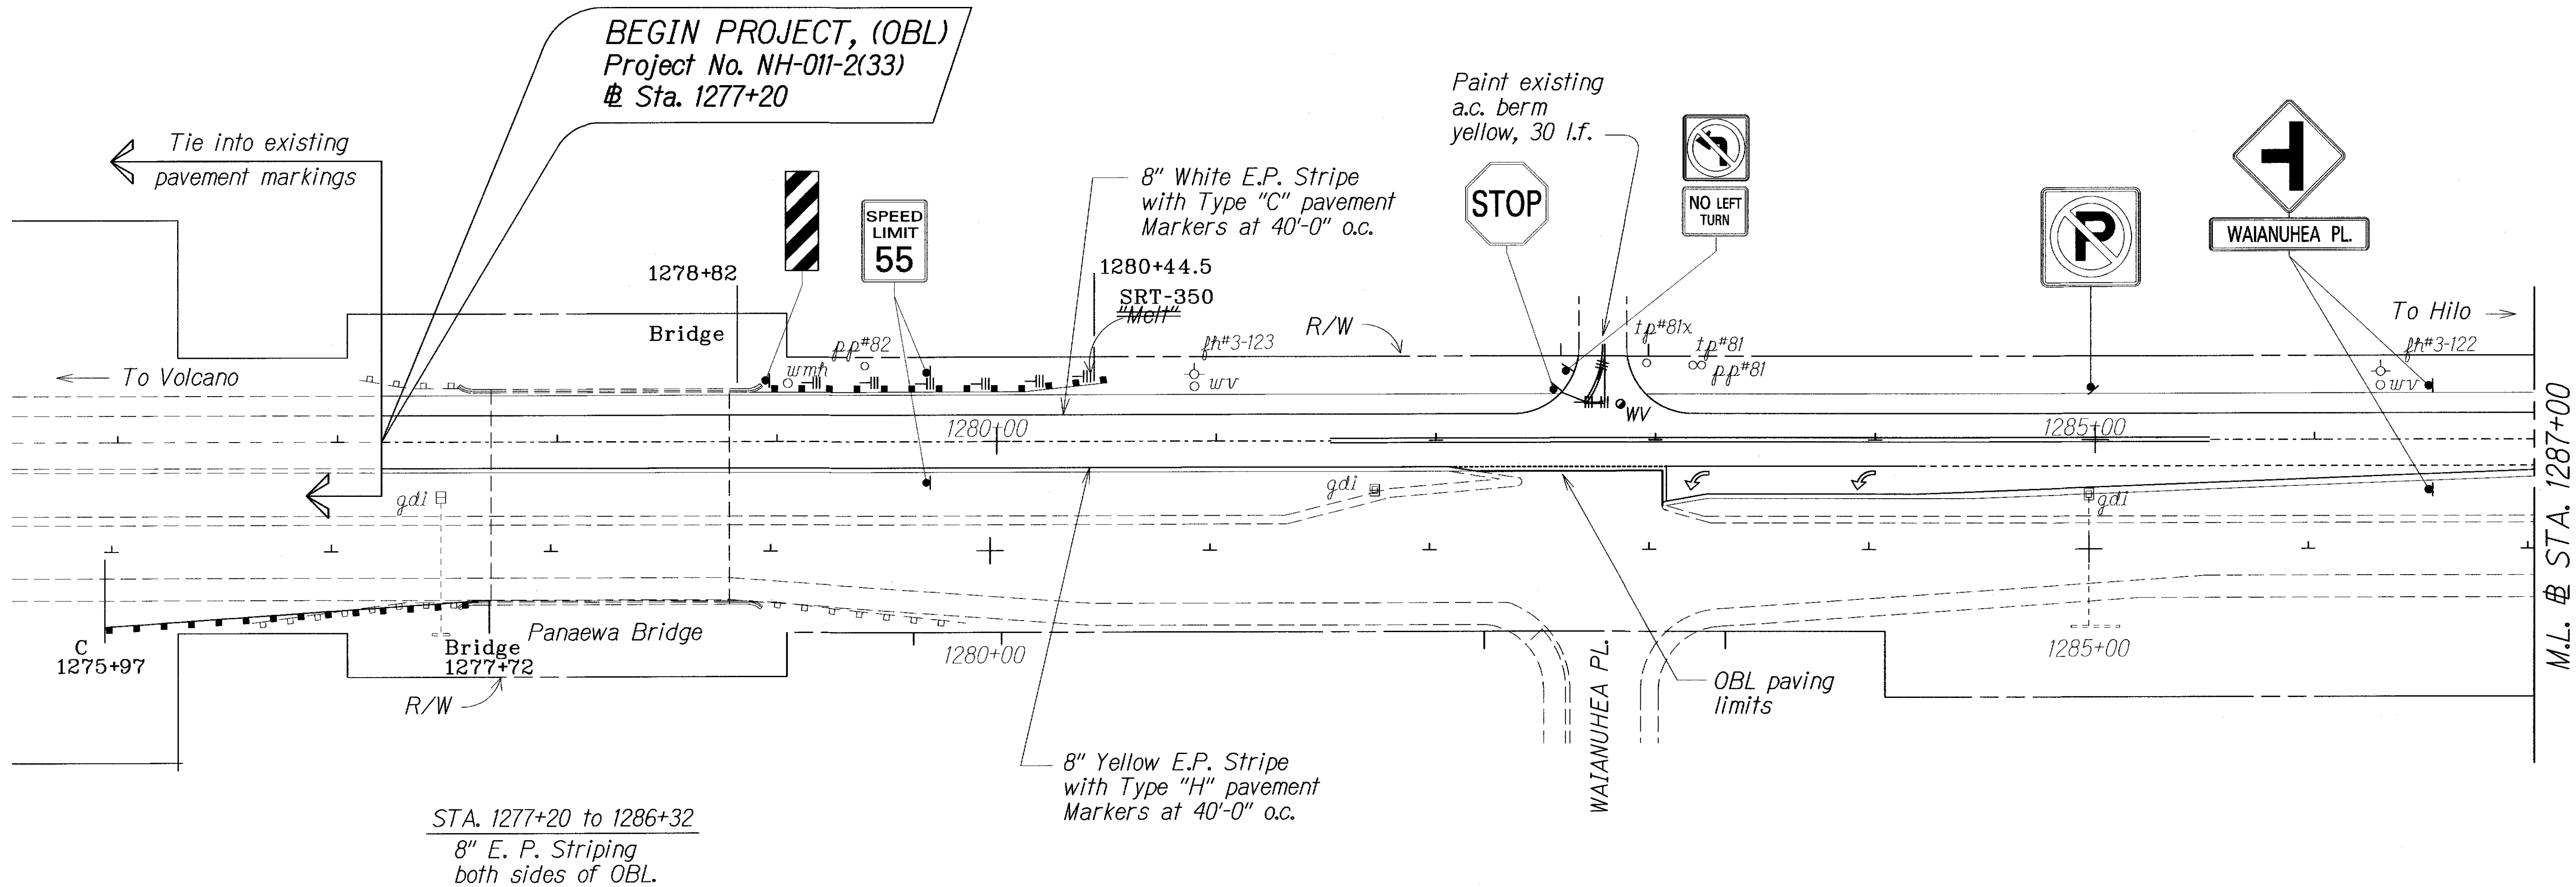

ORIGINAL PLAN	DATE
DESIGNED BY	4/96
NOTED BY	
QUANTITIES BY	
CHECKED BY	

LEGEND FOR AS-BUILT POSTINGS	
	Squiggly line for as-built deletion
	Double line for as-built deletion
Roadway	Text for as-built posting

STATE OF HAWAII
DEPARTMENT OF TRANSPORTATION
HIGHWAYS DIVISION

ROADWAY PLAN (OBL)

KANOELEHUA AVENUE RESURFACING
PANAWEA BRIDGE TO PUAINAKO ST.
F. A. PROJECT NO. NH-011-2(33)


Scale: 1"=40'

Date: April, 1996

SHEET No. 1 OF 5 SHEETS

"AS-BUILT"



FED. ROAD DIST. NO.	STATE	FED. AID PROJ. NO.	FISCAL YEAR	SHEET NO.	TOTAL SHEETS
HAWAII	HAW.	NH-011-2(33)	1996	66	102

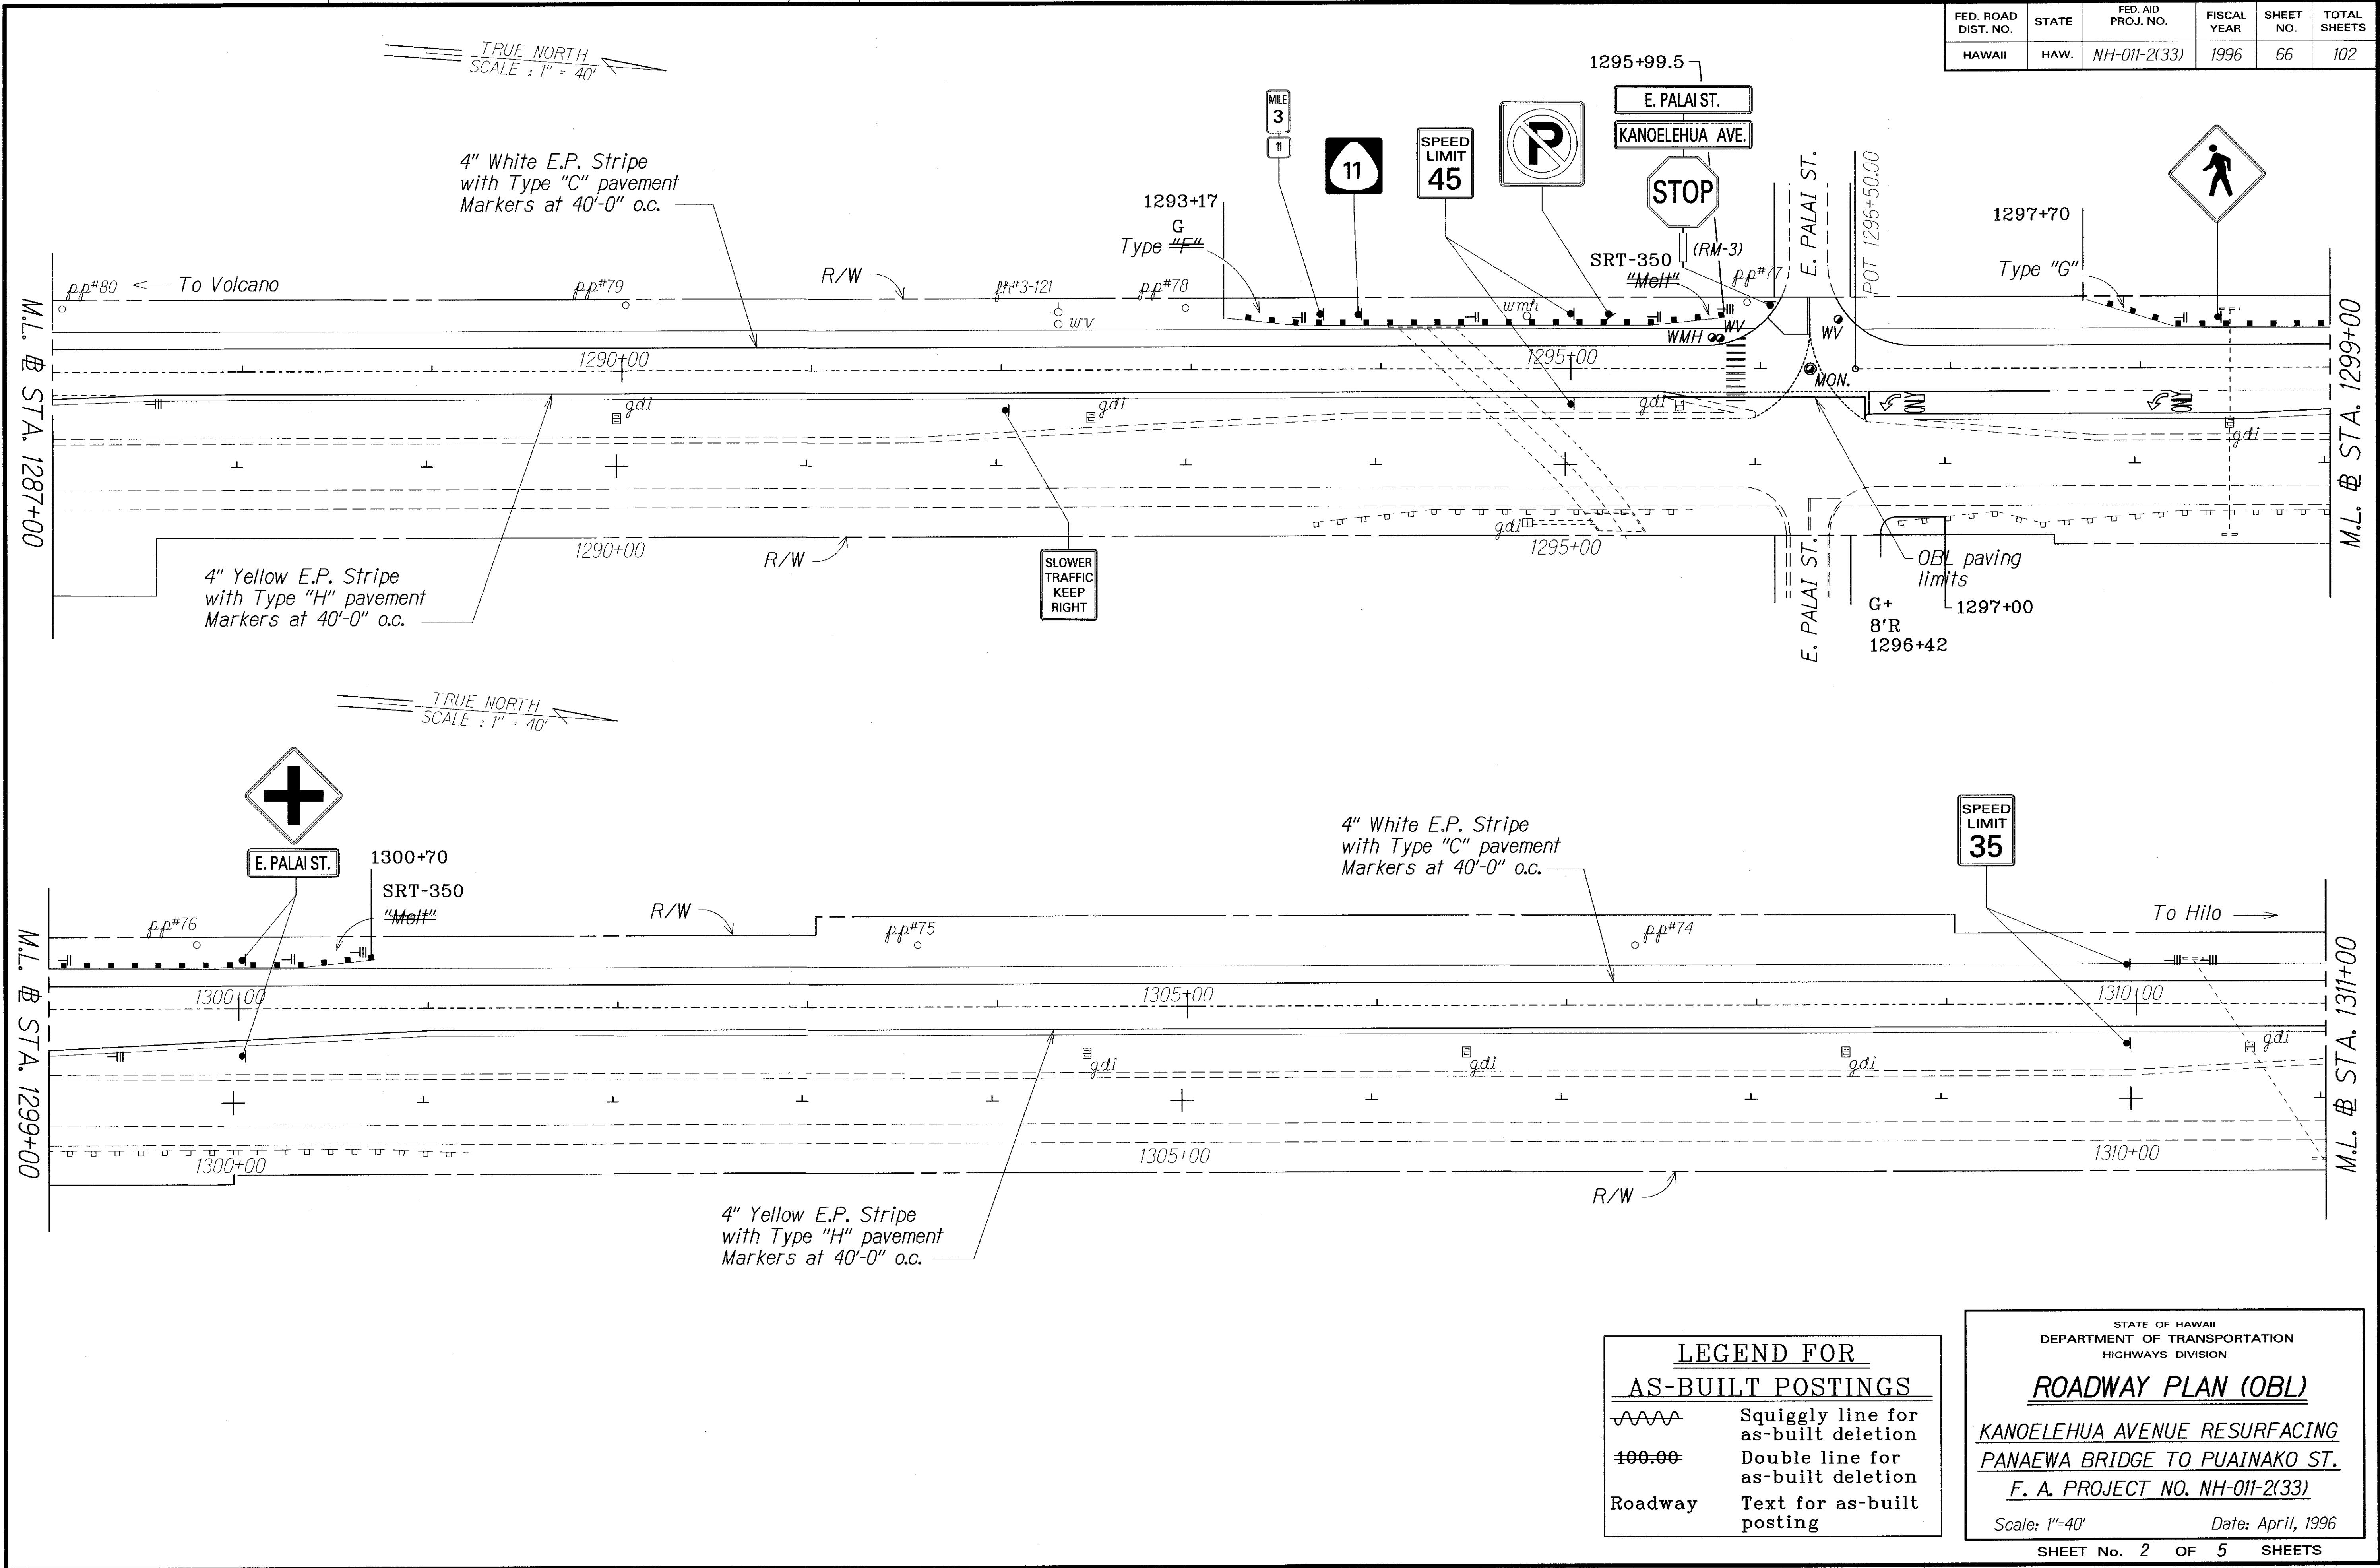

ORIGINAL PLAN	DATE	4/96
DRAWN BY		
TRACED BY		
NOTED BY		
QUANTITIES BY		
CHECKED BY		
IN CHARGE		

"AS-BUILT"

FED. ROAD DIST. NO.	STATE	FED. AID PROJ. NO.	FISCAL YEAR	SHEET NO.	TOTAL SHEETS
HAWAII	HAW.	NH-011-2(33)	1996	67	102

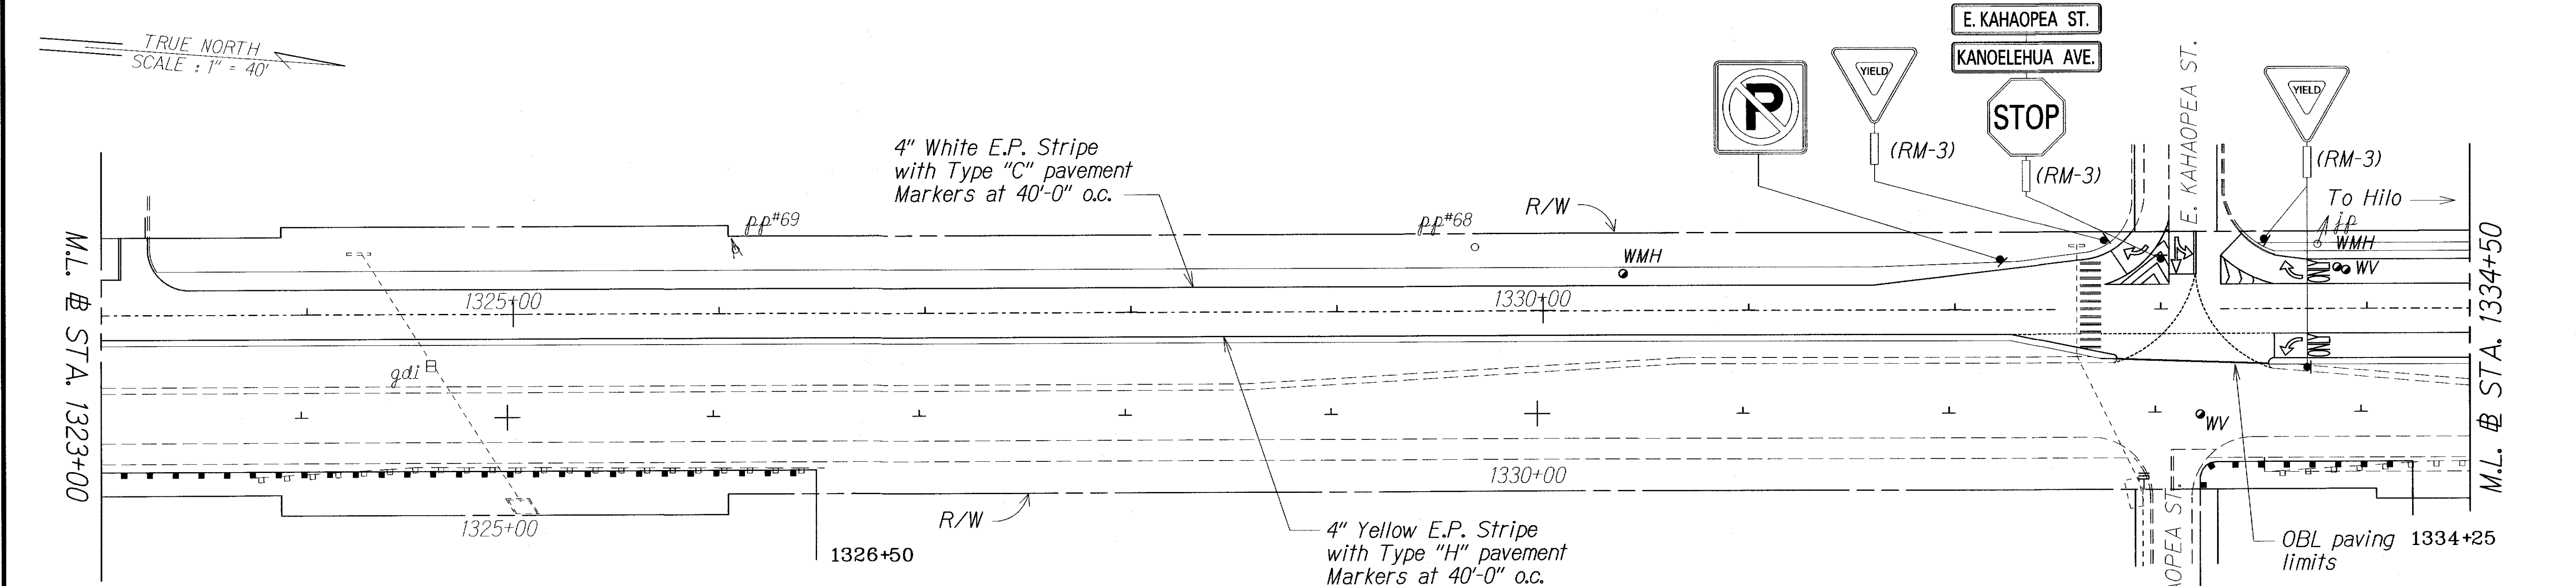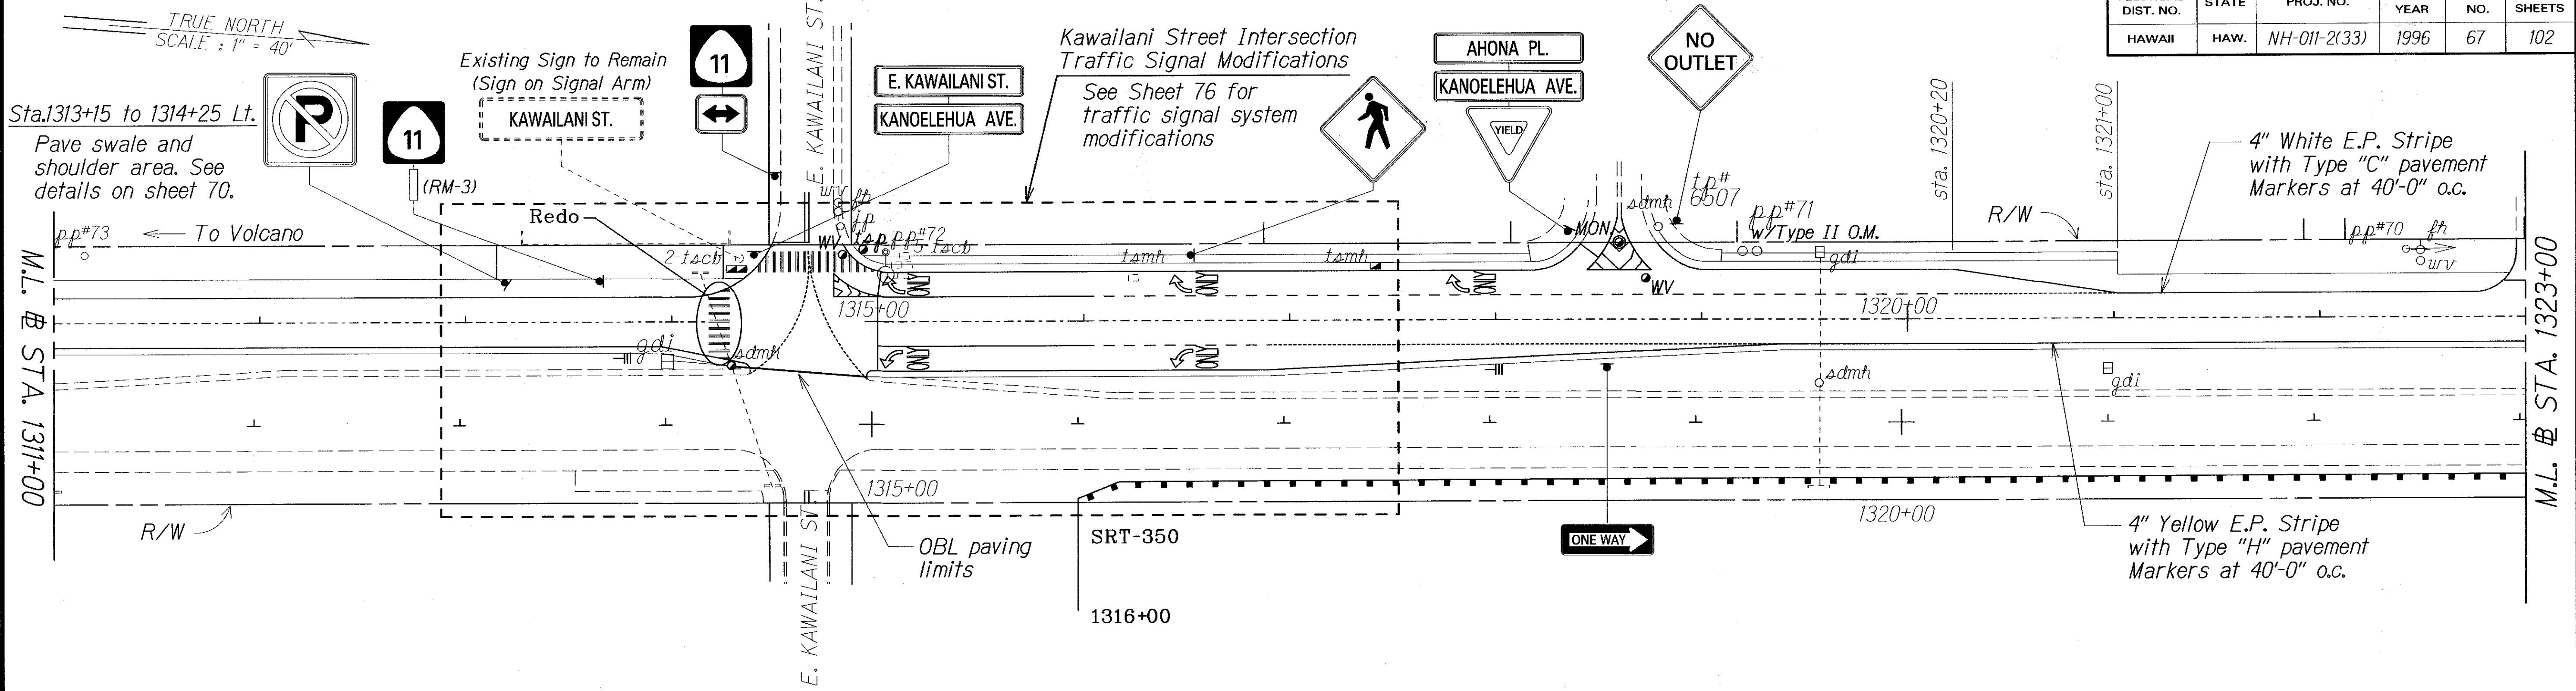

NOTE:

- Contractor attention is directed to the requirements for installation of conduits for street lighting and interconnecting the Puainako Street and Kawaiilani Street traffic signals. See Interconnect Pullbox and Conduit Summary, sheet no. 80.
- Contractor shall coordinate all work at the Kanoelehua Avenue/Kawaiilani Street intersection with the County of Hawaii Hilo Road Improvements, Phase II project, F.A. Project No. STP-0100(037). No adjustments shall be made to the contract for such coordination efforts.

ORIGINAL PLAN	DATE
SURVEY LOCATED BY	4/96
DRAWN BY	
DESIGNED BY	
CHECKED BY	

LEGEND FOR AS-BUILT POSTINGS	
	Squiggly line for as-built deletion
	Double line for as-built deletion
Roadway	Text for as-built posting

STATE OF HAWAII
DEPARTMENT OF TRANSPORTATION
HIGHWAYS DIVISION


ROADWAY PLAN (OBL)

**KANOELEHUAA AVENUE RESURFACING
PANAHEWA BRIDGE TO PUAINAKO ST.
F. A. PROJECT NO. NH-011-2(33)**

Scale: 1"=40' Date: April, 1996

SHEET No. 3 OF 5 SHEETS

FED. ROAD DIST. NO.	STATE	FED. AID PROJ. NO.	FISCAL YEAR	SHEET NO.	TOTAL SHEETS
HAWAII	HAW.	NH-011-2(33)	1996	68	102

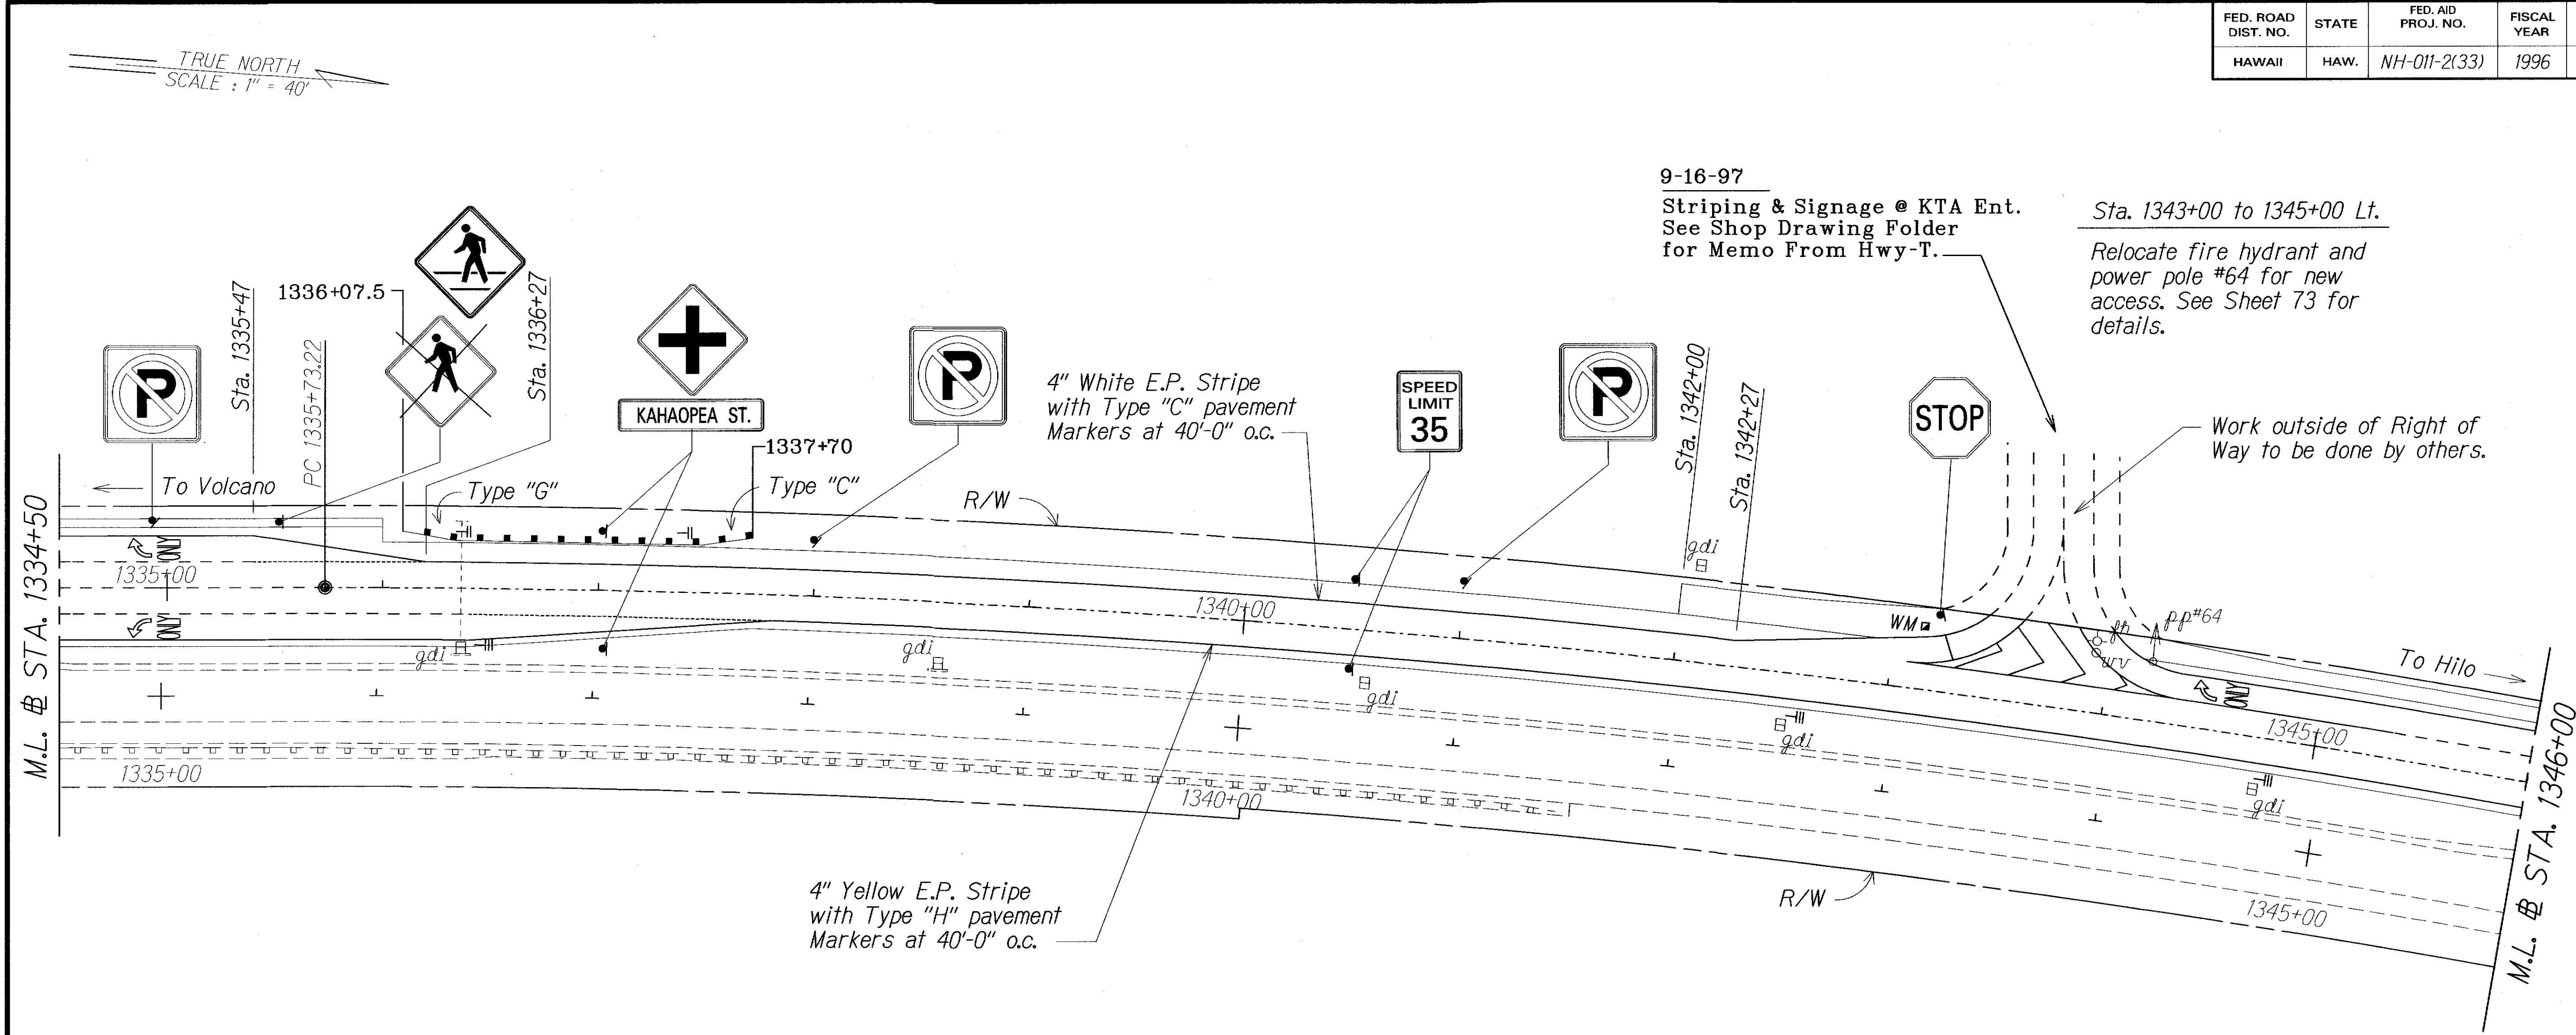

ORIGINAL PLAN	SURVEY PLOTTED BY	DATE
NOTE BOOK	DRAWN BY	4/96
DESIGNED BY	DESIGNED BY	
QUANTITIES BY	QUANTITIES BY	
CHECKED BY	CHECKED BY	

LEGEND FOR AS-BUILT POSTINGS	
	Squiggly line for as-built deletion
	Double line for as-built deletion
Roadway	Text for as-built posting


STATE OF HAWAII
DEPARTMENT OF TRANSPORTATION
HIGHWAYS DIVISION

ROADWAY PLAN (OBL)
KANOELEHUA AVENUE RESURFACING
PANAewa BRIDGE TO PUAINAKO ST.
F. A. PROJECT NO. NH-011-2(33)
Scale: 1"=40' Date: April, 1996

SHEET No. 4 OF 5 SHEETS

FED. ROAD DIST. NO.	STATE	FED. AID PROJ. NO.	FISCAL YEAR	SHEET NO.	TOTAL SHEETS
HAWAII	HAW.	NH-011-2(33)	1996	69	102

TRUE NORTH
SCALE : 1" = 40'

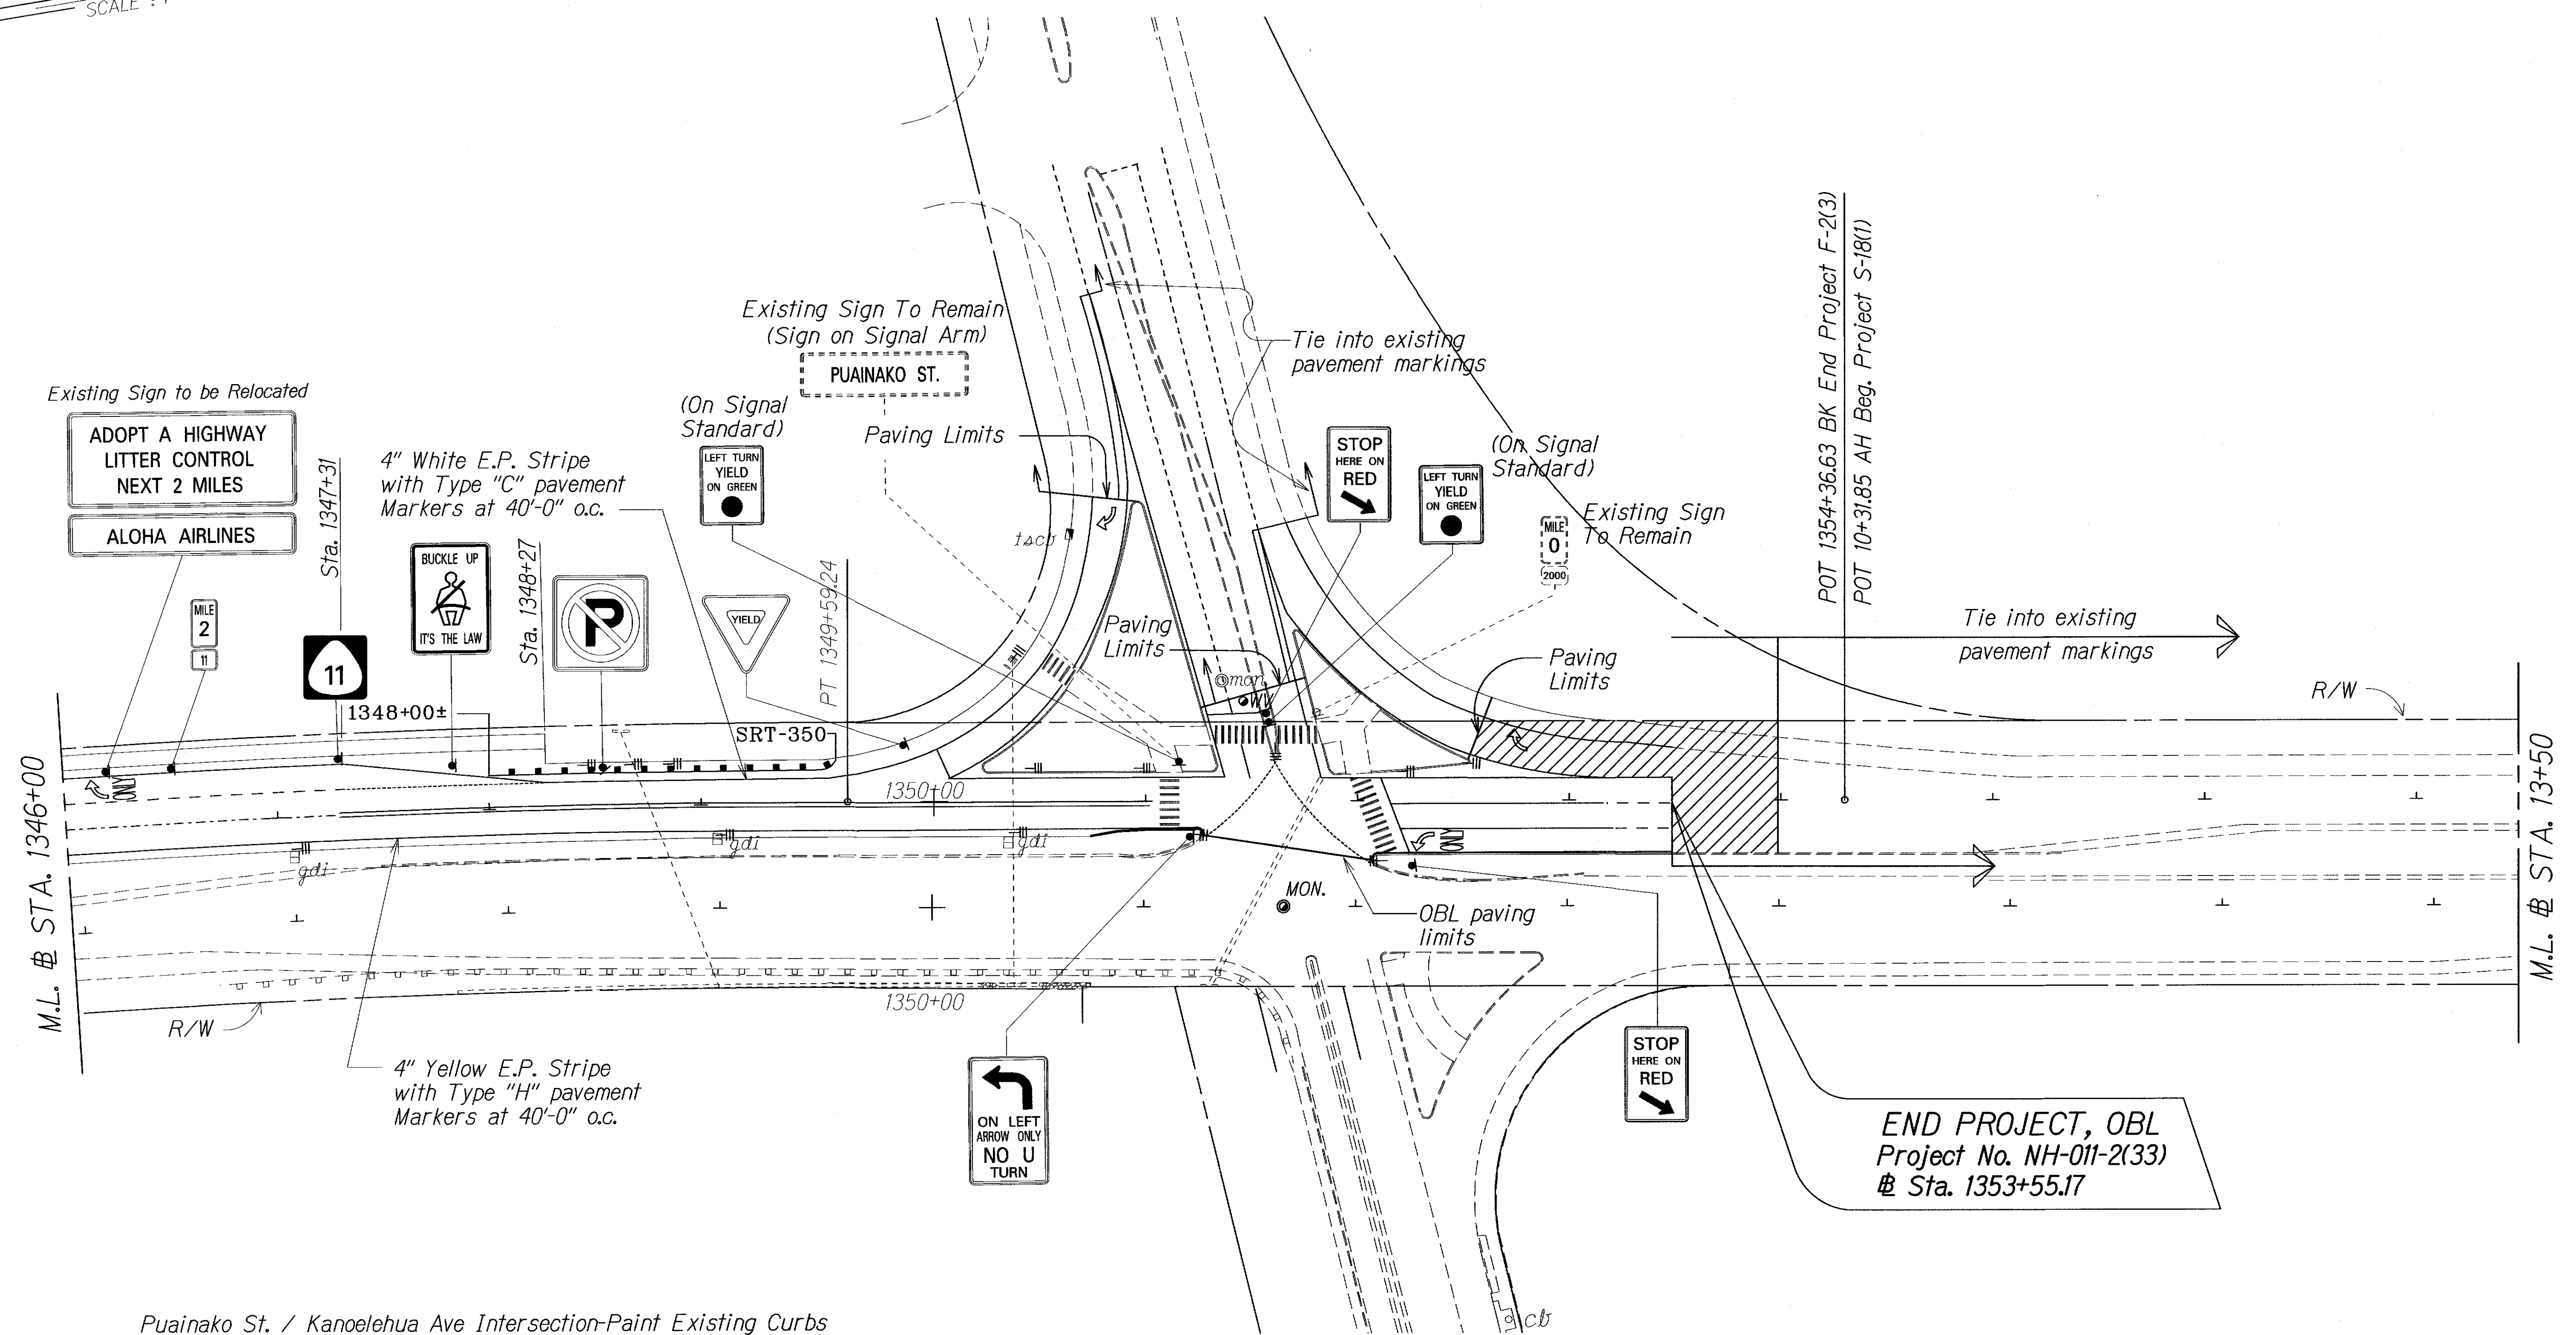

Puainako St. / Kanoelehwa Ave Intersection-Paint Existing Curbs
Channelizing Islands 920 l.f. white
Median 300 l.f. yellow

ORIGINAL PLAN	DATE
SURVEY PLOTTED BY	4/96
DRAWN BY	
DESIGNED BY	
QUANTITIES BY	
CHECKED BY	

LEGEND FOR AS-BUILT POSTINGS	
	Squiggly line for as-built deletion
	Double line for as-built deletion
Roadway	Text for as-built posting

STATE OF HAWAII
DEPARTMENT OF TRANSPORTATION
HIGHWAYS DIVISION
ROADWAY PLAN (OBL)
KANOELEHUA AVENUE RESURFACING
PANAUEWA BRIDGE TO PUAINAKO ST.
F. A. PROJECT NO. NH-011-2(33)
Scale: 1"=40' Date: April, 1996
SHEET No. 5 OF 5 SHEETS