

INDEX TO DRAWINGS	
SHEET NO.	DESCRIPTION
5	TITLE SHEET (IBL)
6-7	TYPICAL SECTIONS AND DETAILS
8-30	ROADWAY PLANS
31-33	DETAILED PLANS
34	LANIKAULA ST. INTERSECTION DETAILS
35	CATCH BASIN DETAILS TYPE-D1
36-37	RECONSTRUCTION AREA SCHEDULE
38-45	SIGN SCHEDULE
46-48	MISCELLANEOUS SCHEDULES
49-61	CROSS SECTIONS

FED. ROAD DIST. NO.	STATE	FED. AID PROJ. NO.	FISCAL YEAR	SHEET NO.	TOTAL SHEETS
HAWAII	HAW.	NH-011-2(33)	1996	5	102

"AS-BUILT"

PLANS FOR

KANOELEHUA AVENUE RESURFACING


INBOUND LANES

KEA'AU TO KAMEHAMEHA AVENUE

FEDERAL AID PROJECT NO. NH-011-2(33)


DISTRICT OF SOUTH HILO AND PUNA

ISLAND OF HAWAI'I

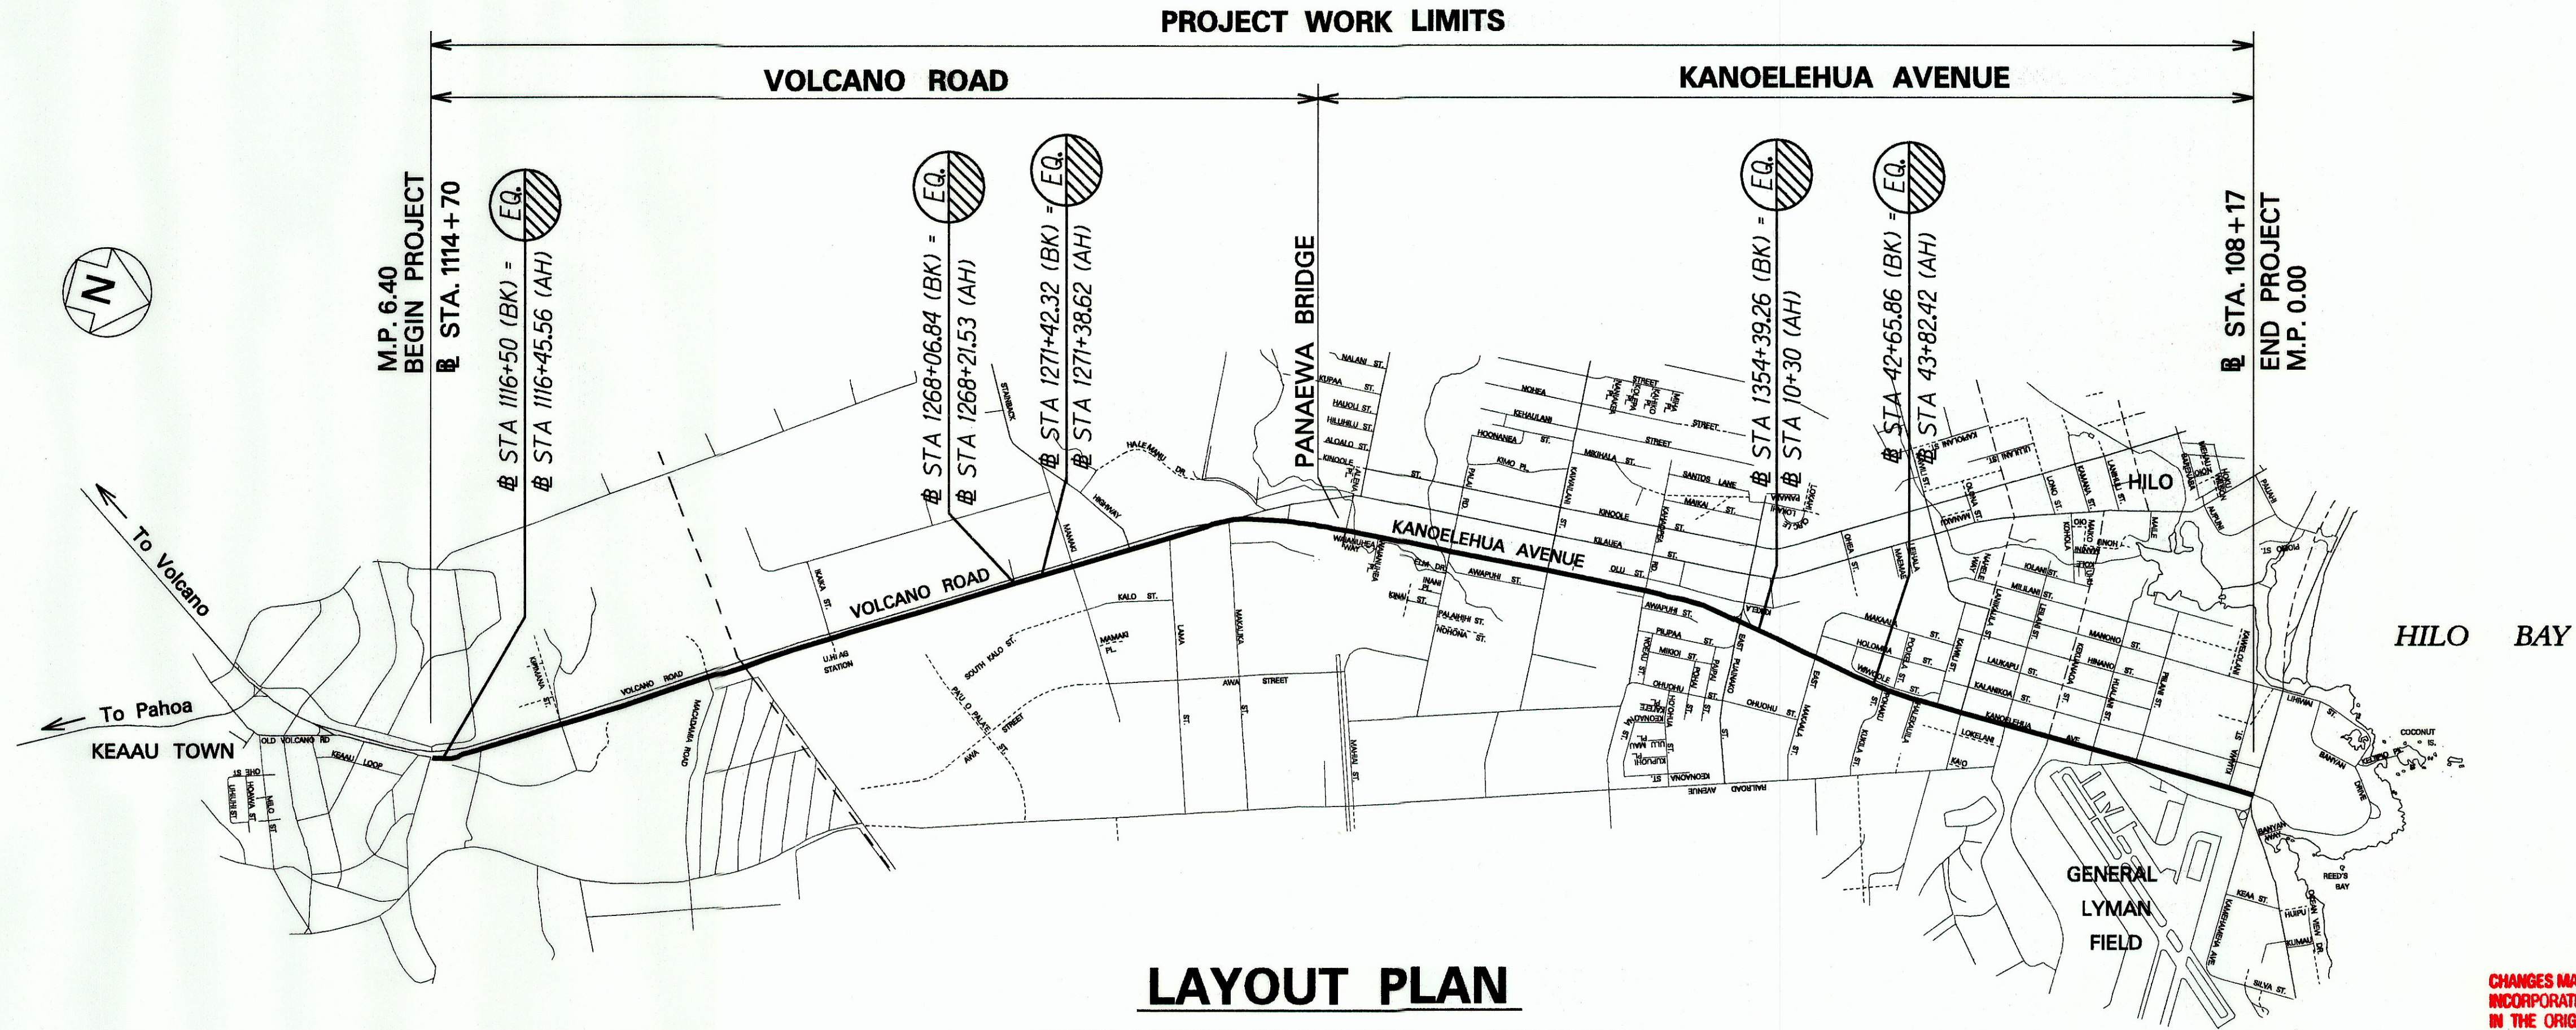

LAYOUT PLAN

GROSS LENGTH OF PROJECT.....6.40 MILES
NET LENGTH OF PROJECT.....6.39 MILES

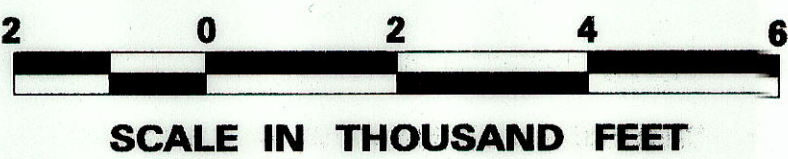

CHANGES MADE DURING CONSTRUCTION HAVE BEEN INCORPORATED ON THESE PLANS EXCEPT CHANGES IN THE ORIGINAL THEORETICAL QUANTITIES. FOR ACTUAL QUANTITIES, REFER TO PROJECT LEDGER AND/OR COMPUTATION BOOK.

RESIDENT ENGINEER *[Signature]* DATE 8-28-14

MILE POST 6.40 TO MILE POST 0.00