

INDEX TO DRAWINGS	
SHEET NO.	DESCRIPTION
62	TITLE SHEET (OBL)
63	TYPICAL SECTION AND DETAILS
64	BRIDGE WORK AND PAVING DETAILS
65-69	ROADWAY PLANS
70-71	KAWAILANI ST. INTERSECTION DETAILS
72	KAHAOPEA ST. INTERSECTION DETAILS
73-75	STA. 1343 + 77 INTERSECTION DETAILS
76-80	KAWAILANI STREET TRAFFIC SIGNAL MODIFICATIONS
81-82	RECONSTRUCTION AREA SCHEDULE AND DETAILS
83	SIGN SCHEDULE
① 84-85	MISCELLANEOUS SCHEDULES
86-89	CROSS SECTIONS

**"AS-BUILT"**

**PLANS FOR**


**KANOELEHUA AVENUE RESURFACING**

**OUTBOUND LANES**

**PANAewa BRIDGE TO PUAINAKO STREET**

**F.A. PROJECT NO. NH-011-2(33)**

**DISTRICT OF SOUTH HILO  
ISLAND OF HAWAII**

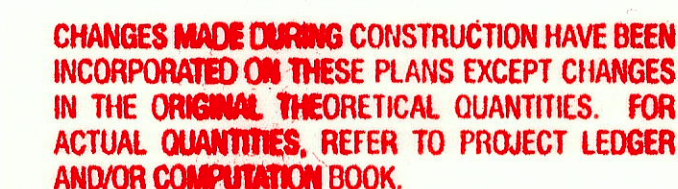

Resident Engineer 8-28-14  
DATE

**NOTE:**

All stationing in this "Outbound Lane" portion of the project are referenced to the outbound lane baseline.

MILE POST 3.31 TO MILE POST 1.87