
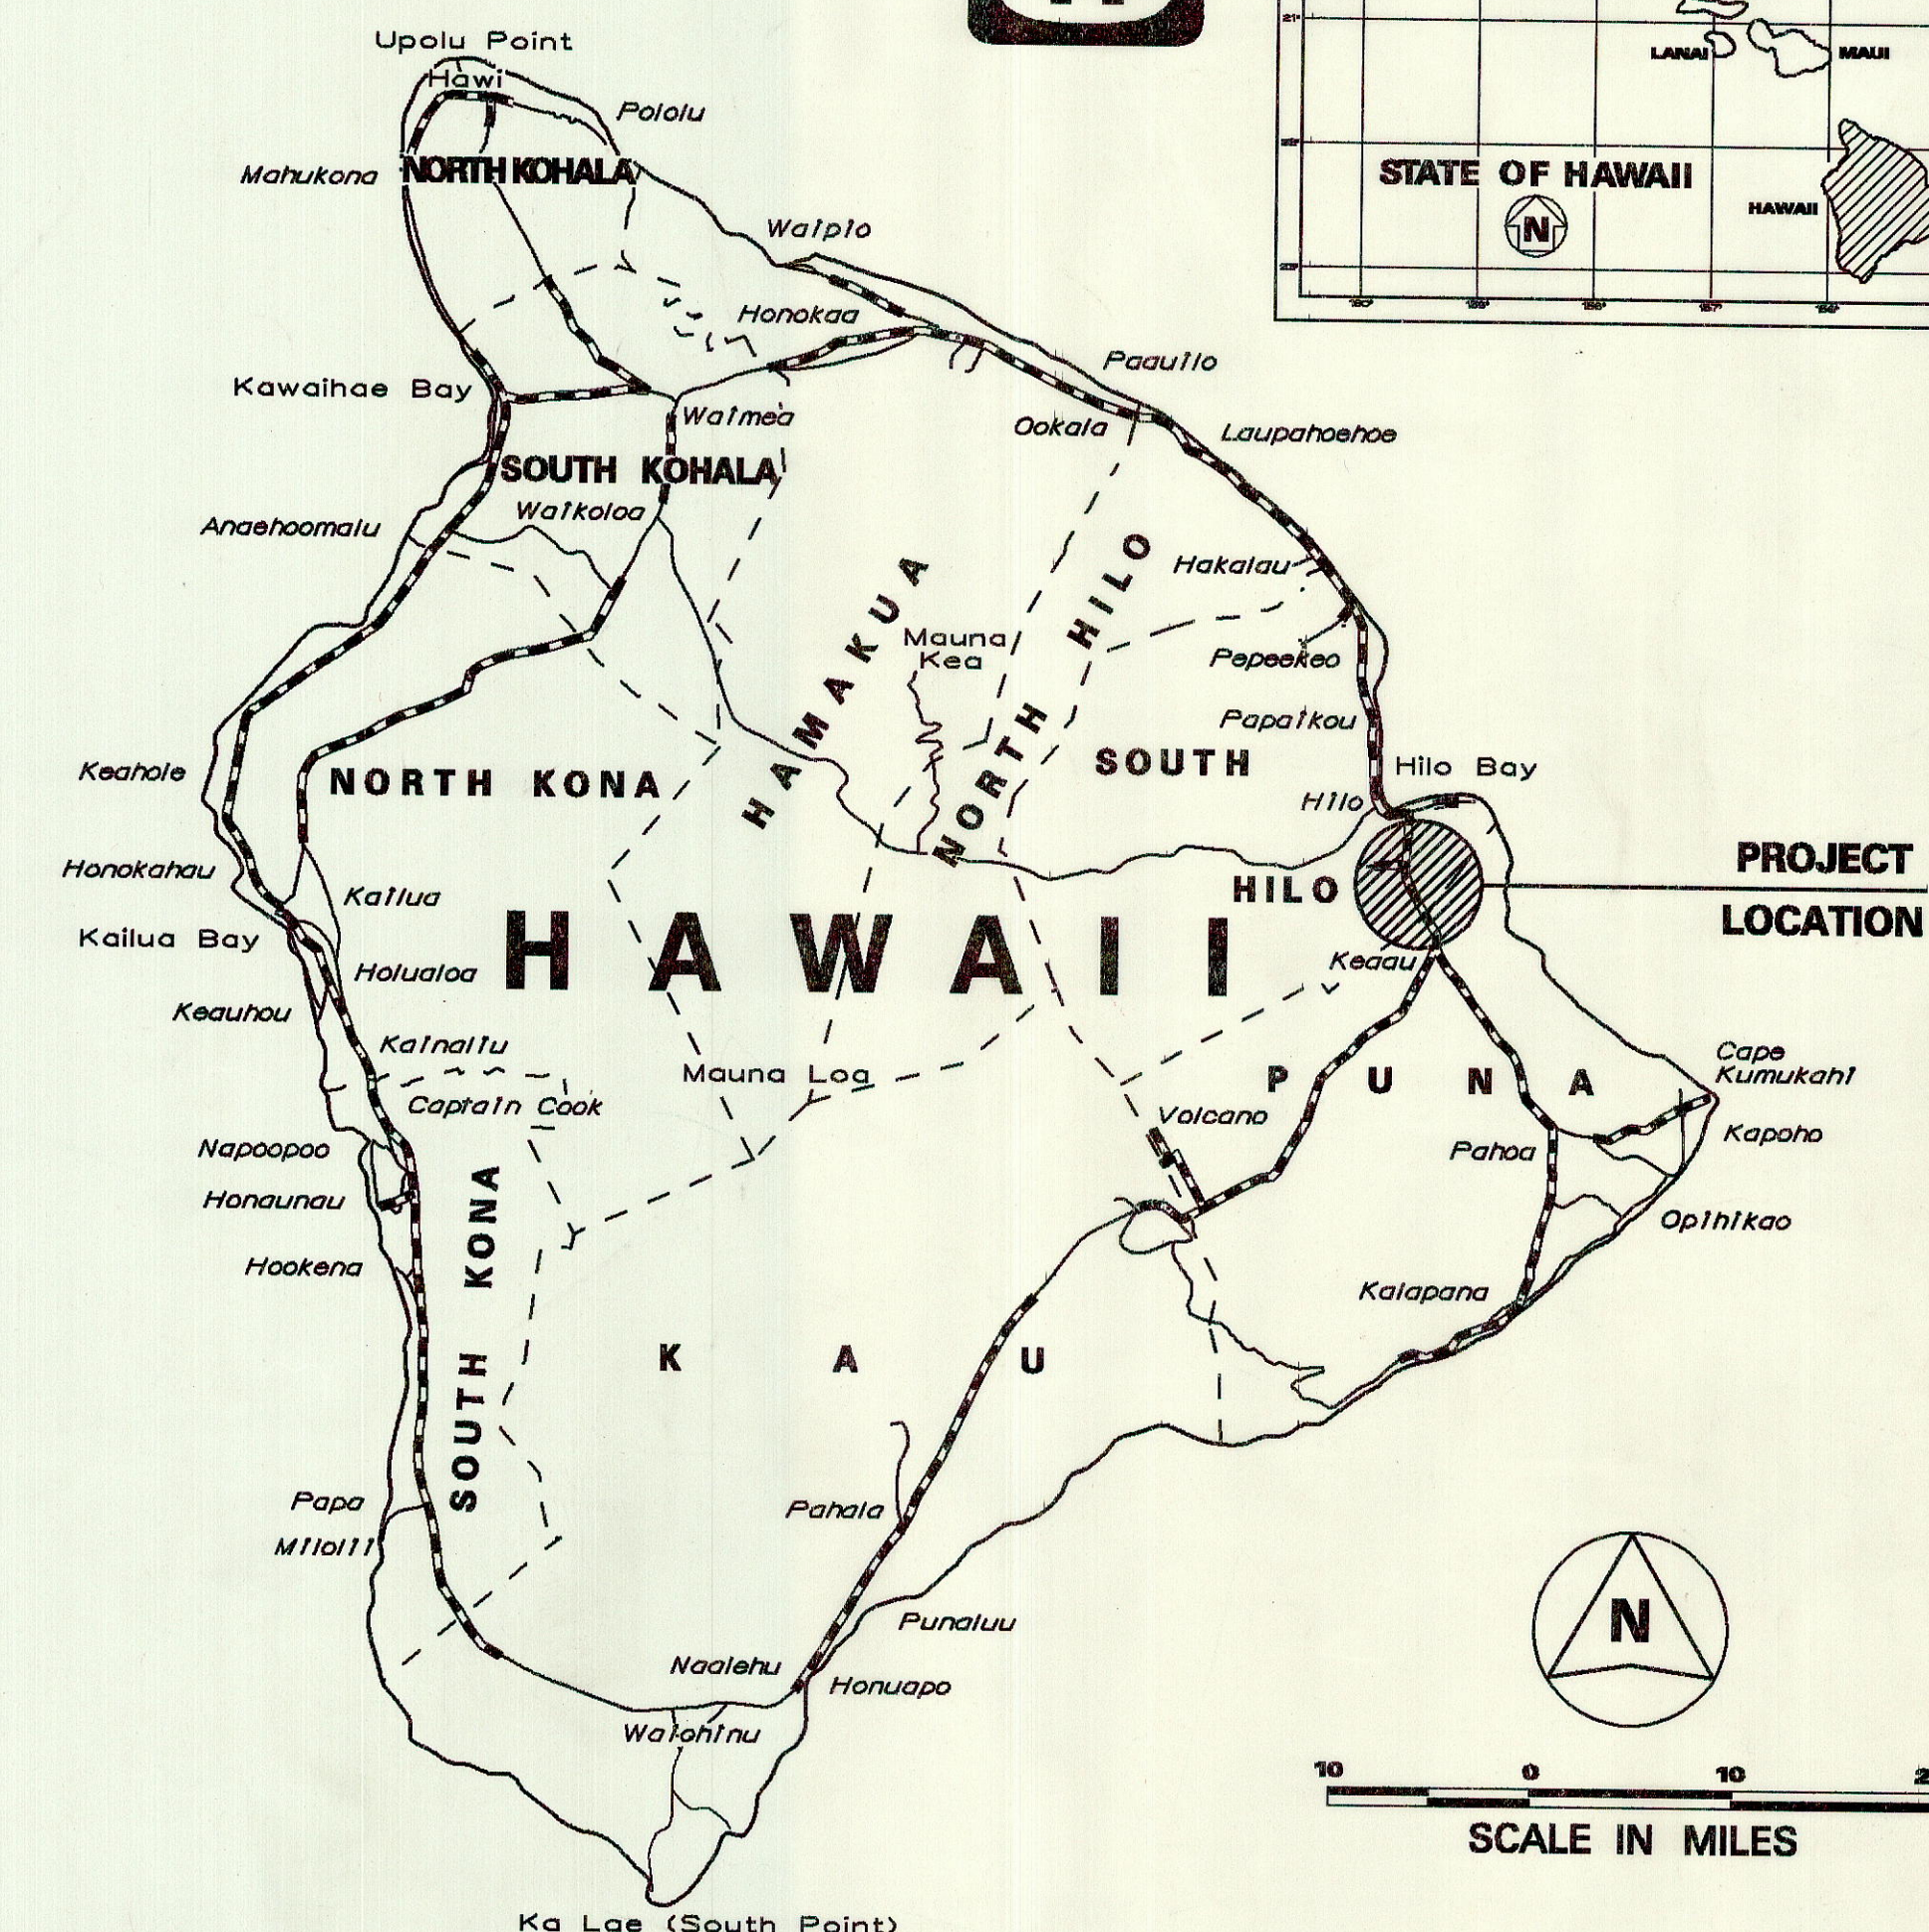


INDEX TO DRAWINGS	
SHEET NO.	DESCRIPTION
1	TITLE SHEET
2	STANDARD PLANS SUMMARY
3	GENERAL NOTES
4	NPDES GENERAL NOTES
5	TITLE SHEET (IBL)
6-7	TYPICAL SECTIONS AND DETAILS
8-30	ROADWAY PLANS
31-33	DETAILED PLANS
34	LANIKAULA ST. INTERSECTION DETAILS
35	CATCH BASIN DETAILS TYPE-D1
36-37	RECONSTRUCTION AREA SCHEDULE
38-45	SIGN SCHEDULE
46-48	MISCELLANEOUS SCHEDULES
49-61	CROSS SECTIONS
62	TITLE SHEET (OBL)
63	TYPICAL SECTIONS AND DETAILS
64	BRIDGE WORK AND PAVING DETAILS
65-69	ROADWAY PLANS
70-71	KAWAILANI ST. INTERSECTION DETAILS
72	KAHAOPEA ST. INTERSECTION DETAILS
73-75	STA. 1343+77 INTERSECTION DETAILS
76-80	KAWAILANI STREET TRAFFIC SIGNAL MODIFICATIONS
81-82	RECONSTRUCTION AREA SCHEDULE AND DETAILS
83	SIGN SCHEDULE
① 84-85	MISCELLANEOUS SCHEDULES
86-89	CROSS SECTIONS
PROJECT DETAILS	
90	TYPICAL PAVEMENT RECONSTRUCTION DETAILS
91	DRYWELL DETAILS
92	PAVEMENT MARKING LEGEND & NOTES
93-96	SIGN DETAILS & NOTES
97	CONSTRUCTION SIGN PLAN AND SCHEDULE
98	GUARDRAIL DETAILS & NOTES
99-101	M.E.L.T. DETAILS
102	BRIDGE CONNECTION DETAILS & NOTES

Sheet No. ① 84S-1 is a supplementary sheet to this project. Total sheet count after "AS-BUILT" posting 102 sheets.

STATE OF HAWAII
DEPARTMENT OF TRANSPORTATION
HIGHWAYS DIVISION
HONOLULU, HAWAII
"AS-BUILT"
PLANS FOR
KANOELEHUA AVENUE RESURFACING
KEA'AU TO KAMEHAMEHA AVENUE
M.P. 6.40 TO M.P. 0.00
FEDERAL AID PROJECT NO. NH-011-2(33)
DISTRICTS OF SOUTH HILO AND PUNA
ISLAND OF HAWAII

FED. ROAD DIST. NO.	STATE	FED. AID PROJ. NO.	FISCAL YEAR	SHEET NO.	TOTAL SHEETS
HAWAII	HAW.	NH-011-2(33)	1996	1	102

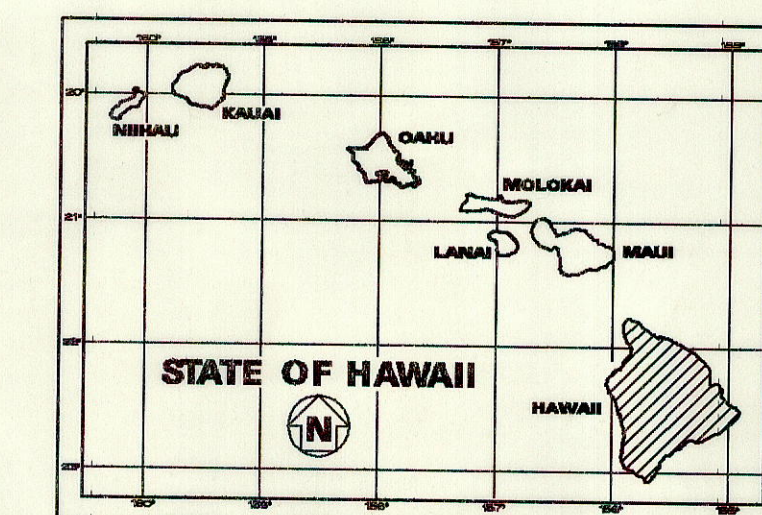

FEDERAL AID PROJECTS PREVIOUSLY CONSTRUCTED OR UNDER CONSTRUCTION

MILE POST 6.40 TO MILE POST 0.00

DESIGN DESIGNATION

ADT (1996)	35,204
ADT (2006)	48,337
DHV (2005)	3,384
D	50/50
T	7.0 %
V	40/50/60 M.P.H.

CHANGES MADE DURING CONSTRUCTION HAVE BEEN INCORPORATED ON THESE PLANS EXCEPT CHANGES IN THE ORIGINAL THEORETICAL QUANTITIES. FOR ACTUAL QUANTITIES, REFER TO PROJECT LEDGER AND/OR COMPUTATION BOOK.

RESIDENT ENGINEER DATE 6-28-14

DEPARTMENT OF WATER SUPPLY
COUNTY OF HAWAII
APPROVED: [Signature] 5/17/96
MANAGER DATE

DEPARTMENT OF TRANSPORTATION
STATE OF HAWAII
APPROVED: [Signature] 5/20/96
DIR. OF TRANSPORTATION DATE

HAWAII DISTRICT DESIGNED BY R. HIRONAKA P. S. & E. BY 587-2250 PHONE APRIL, 1996 DATE