




FED. ROAD DIST. NO.	STATE	FED. AID PROJ. NO.	FISCAL YEAR	SHEET NO.	TOTAL SHEETS
HAWAII	HAW.	NH-011-2(33)	1996	C.O. 63	102

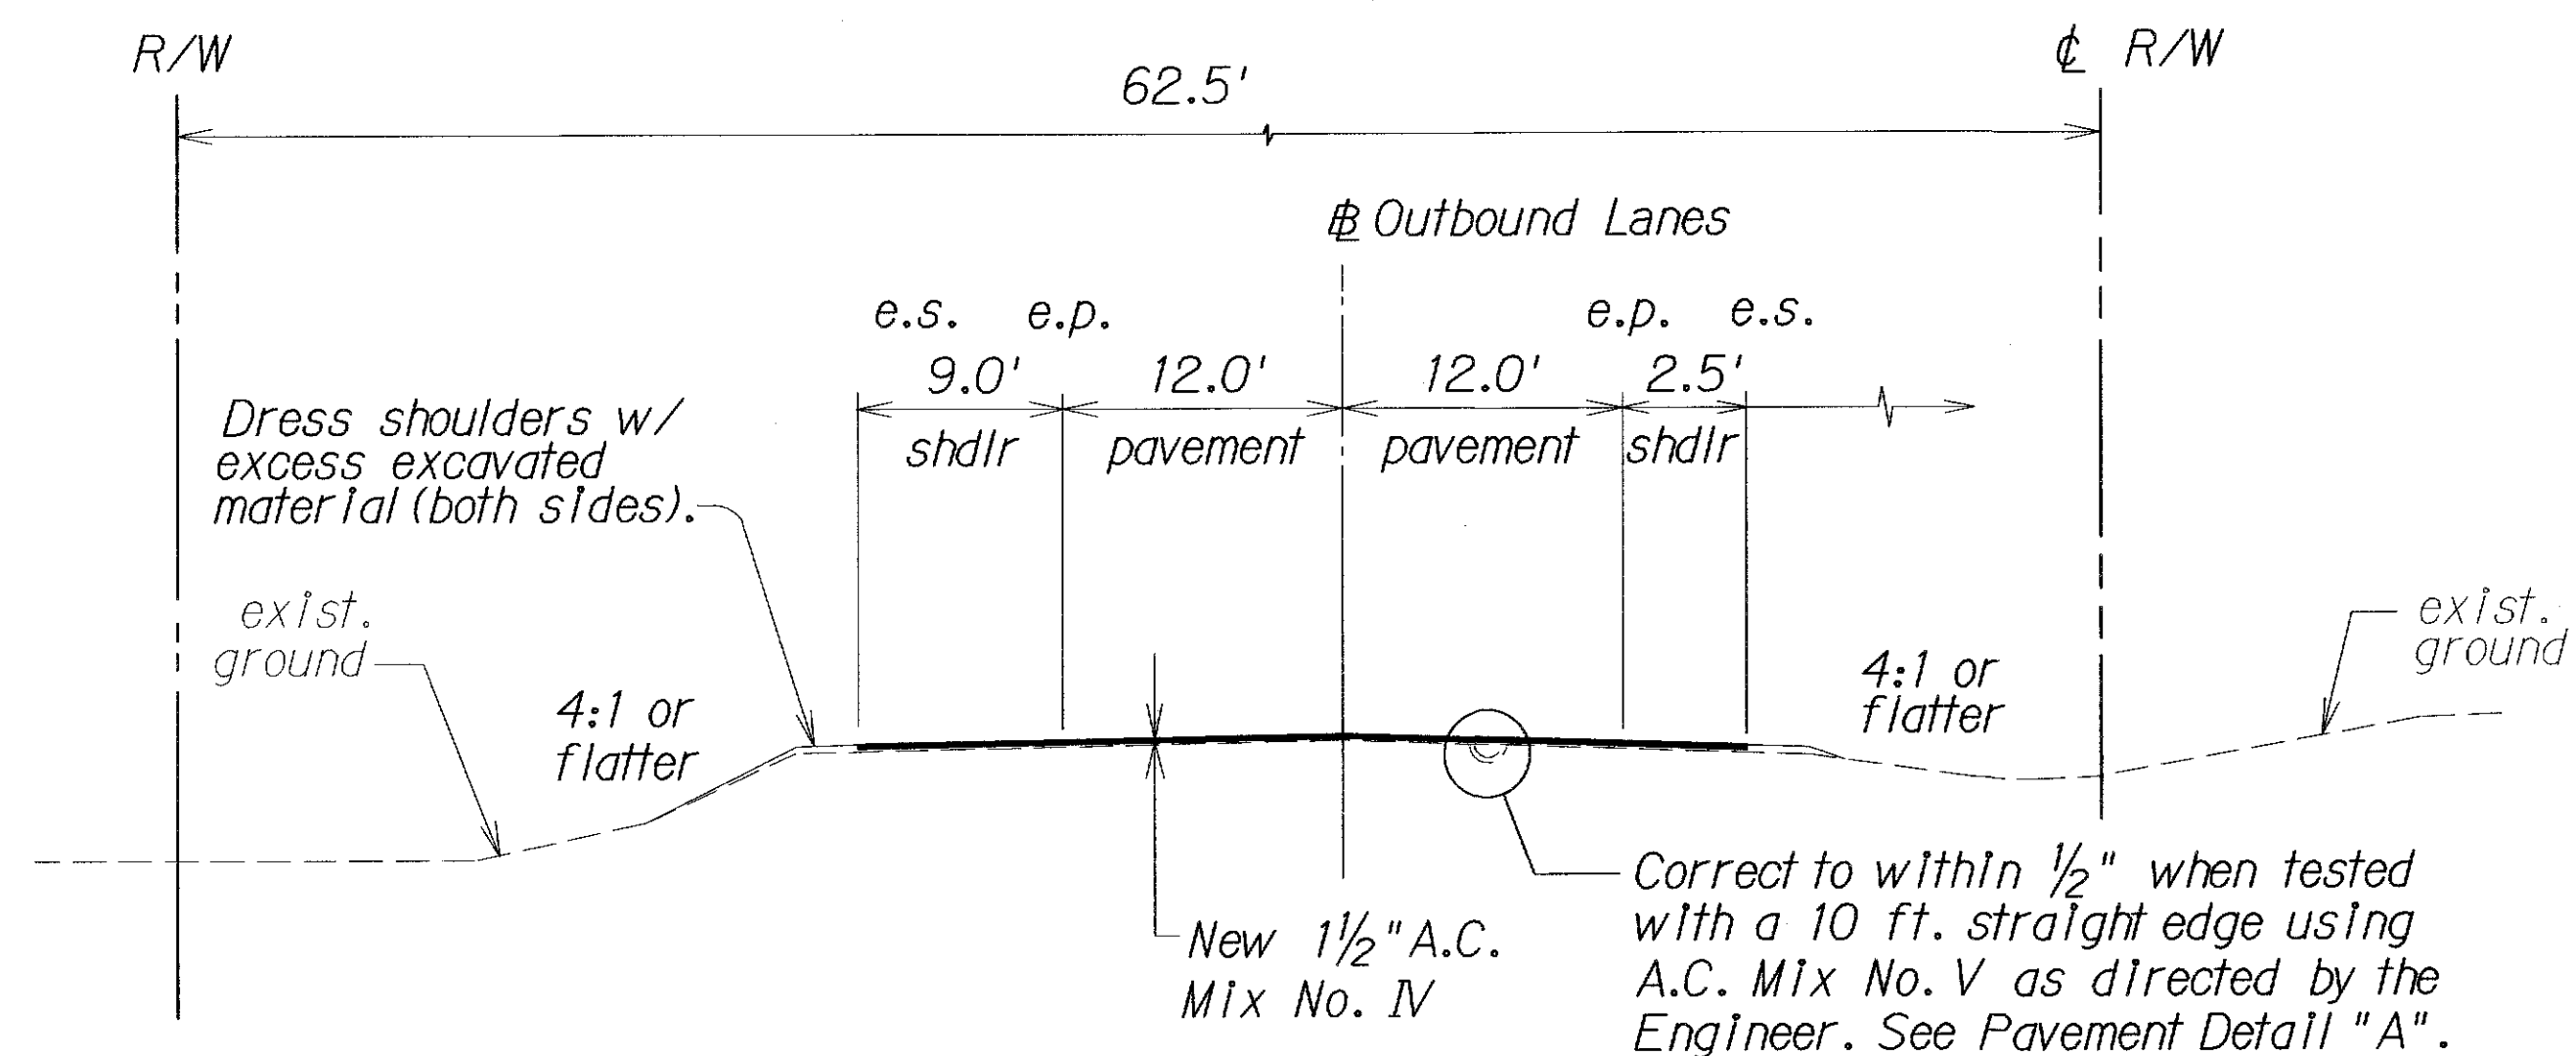


TYPICAL SECTION
Not To Scale

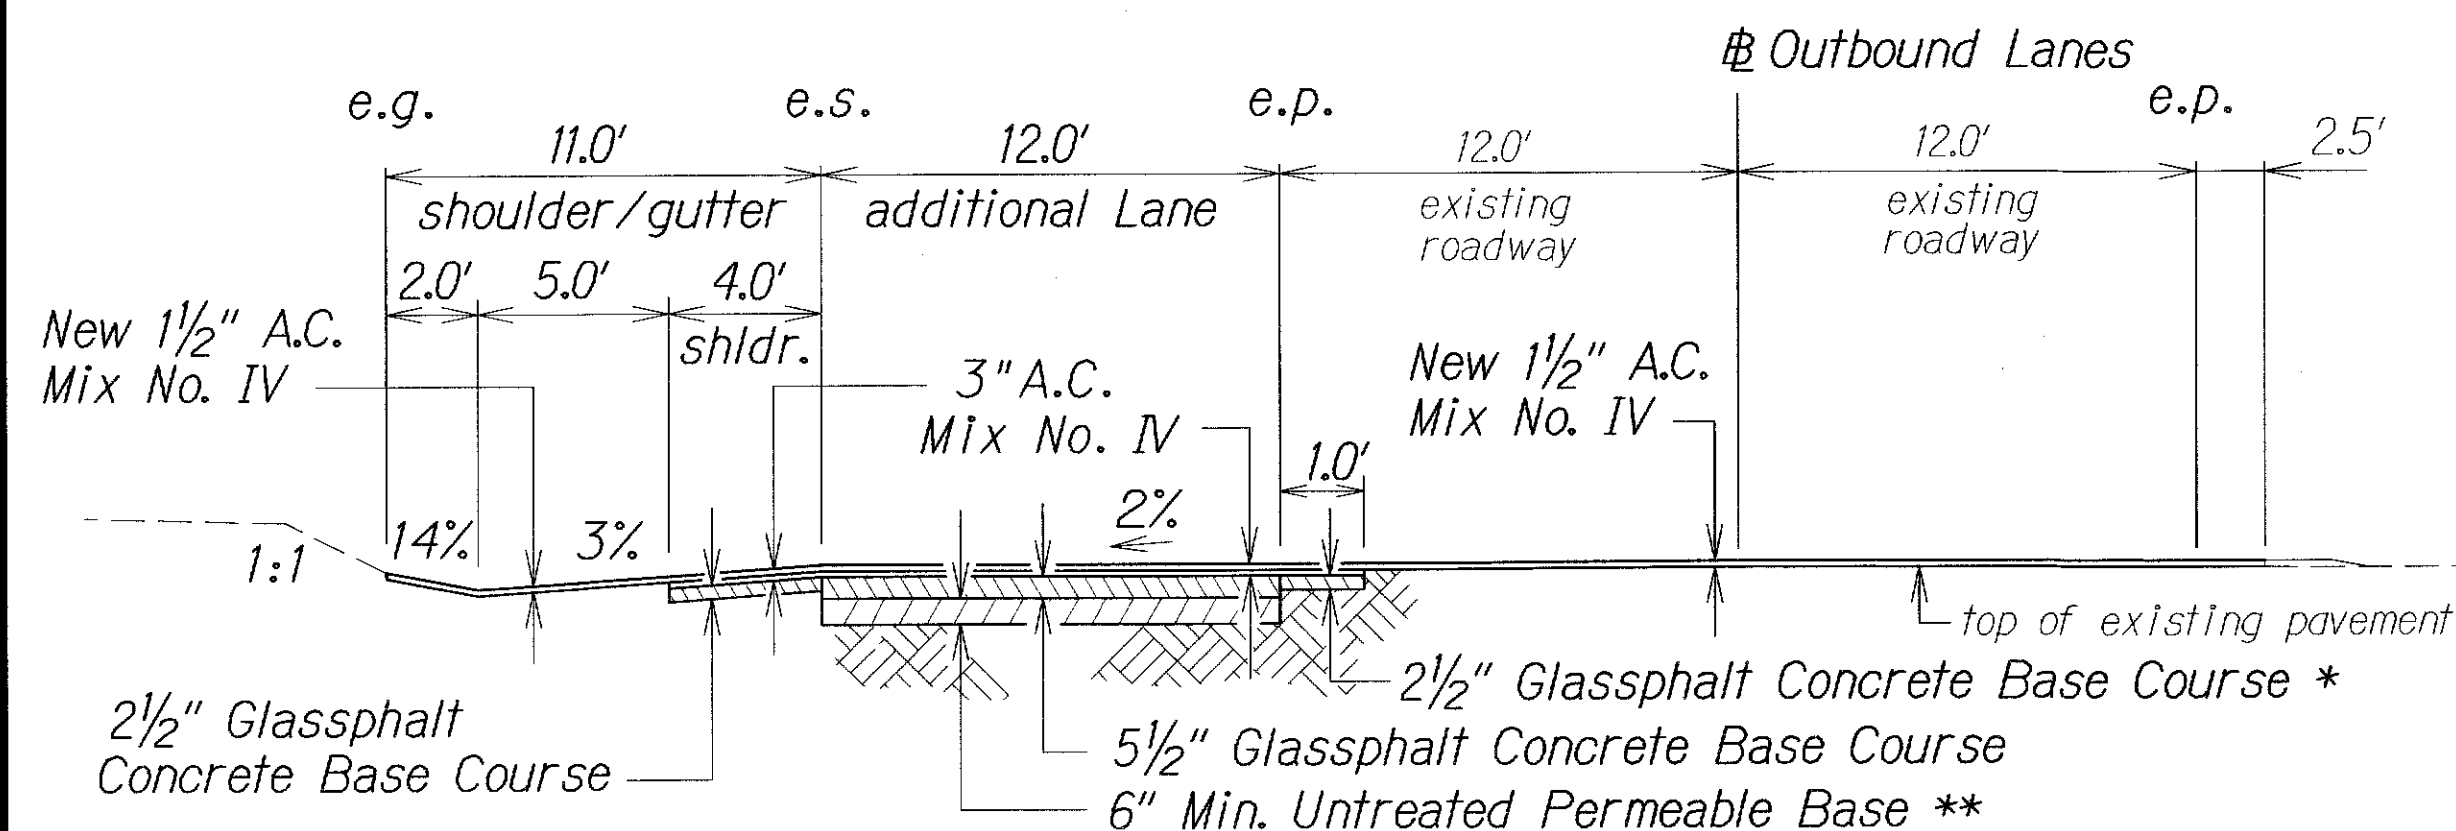

TYPICAL DECEL & ACCEL LANES AT STA. 1342+00 to STA. 1343+08 AND STA. 1344+36 to STA. 1348+27
Not to Scale

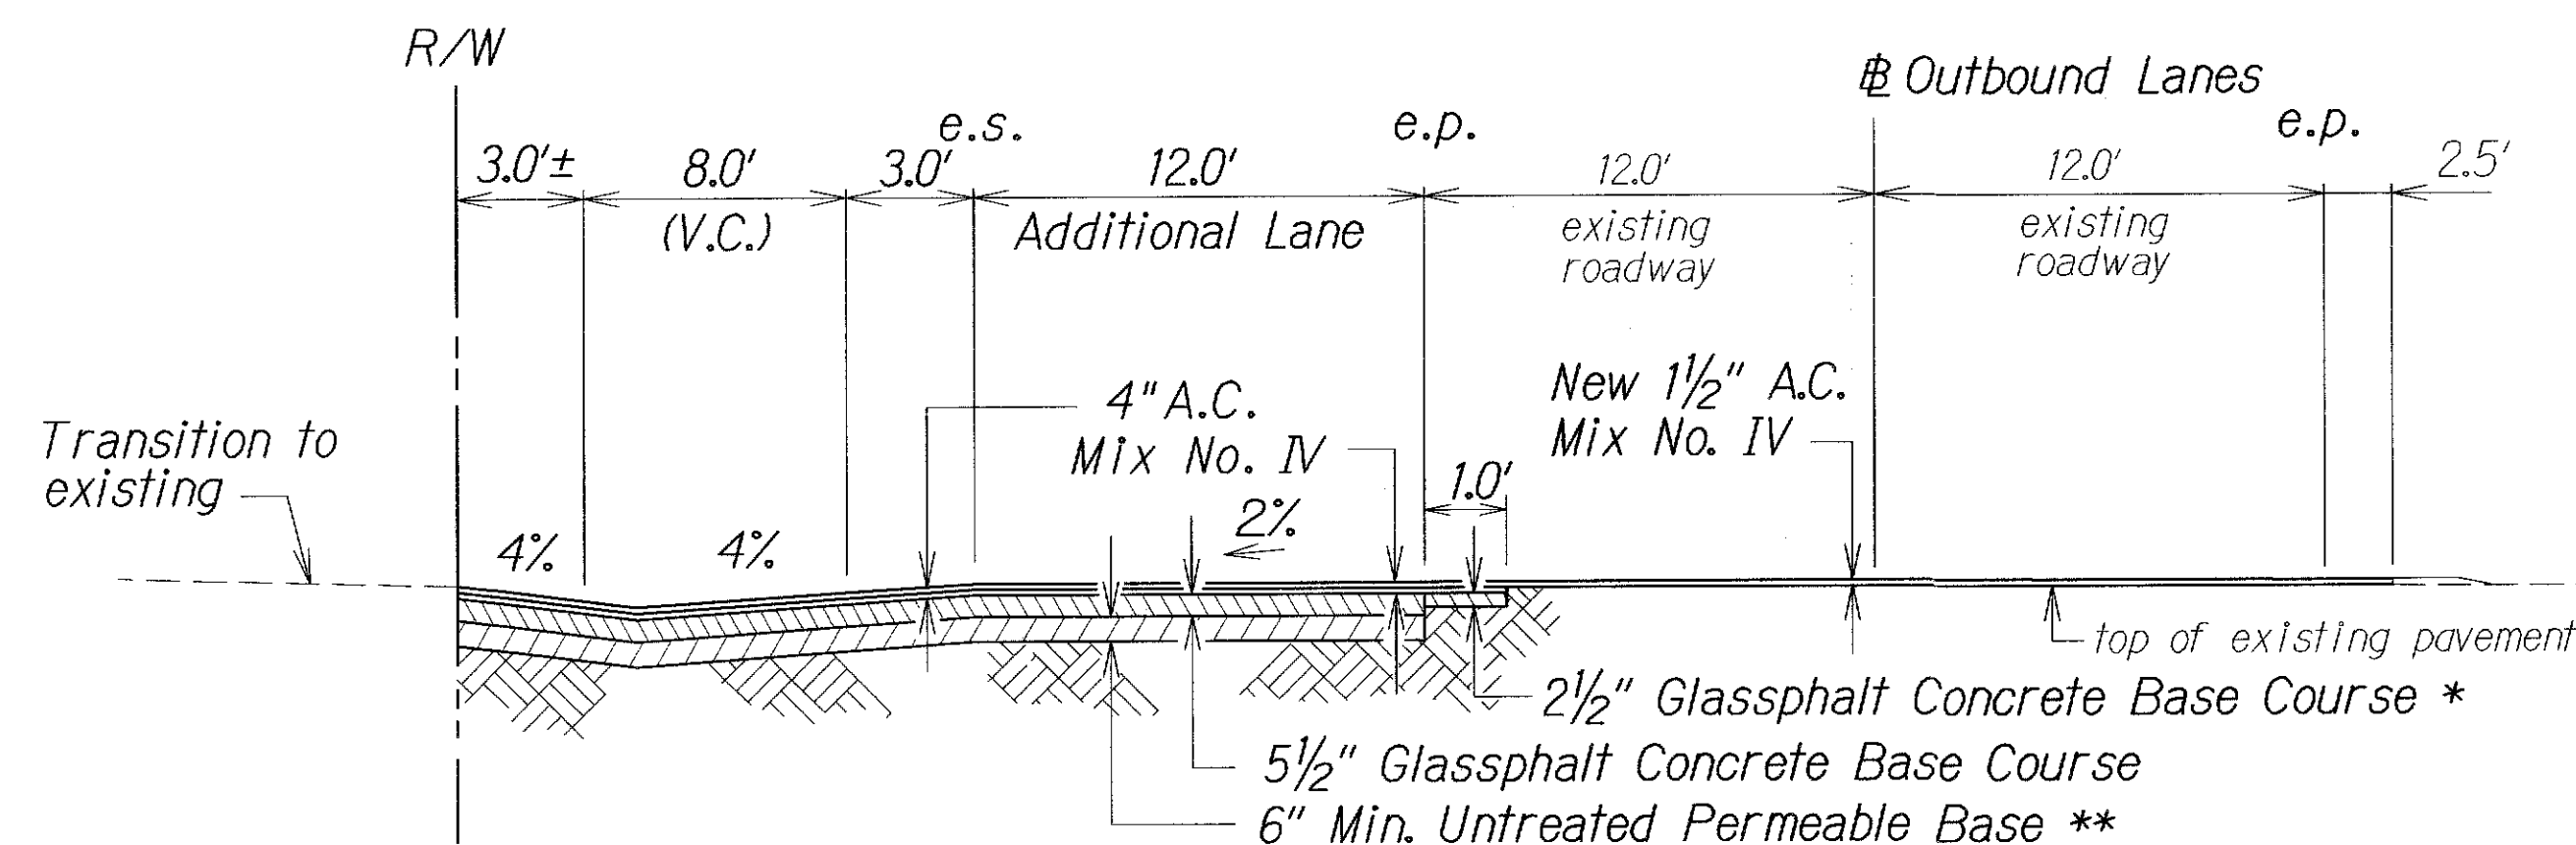


TYPICAL SIDE ROAD SECTION AT STA. 1343+08 to STA. 1344+36
Not to Scale

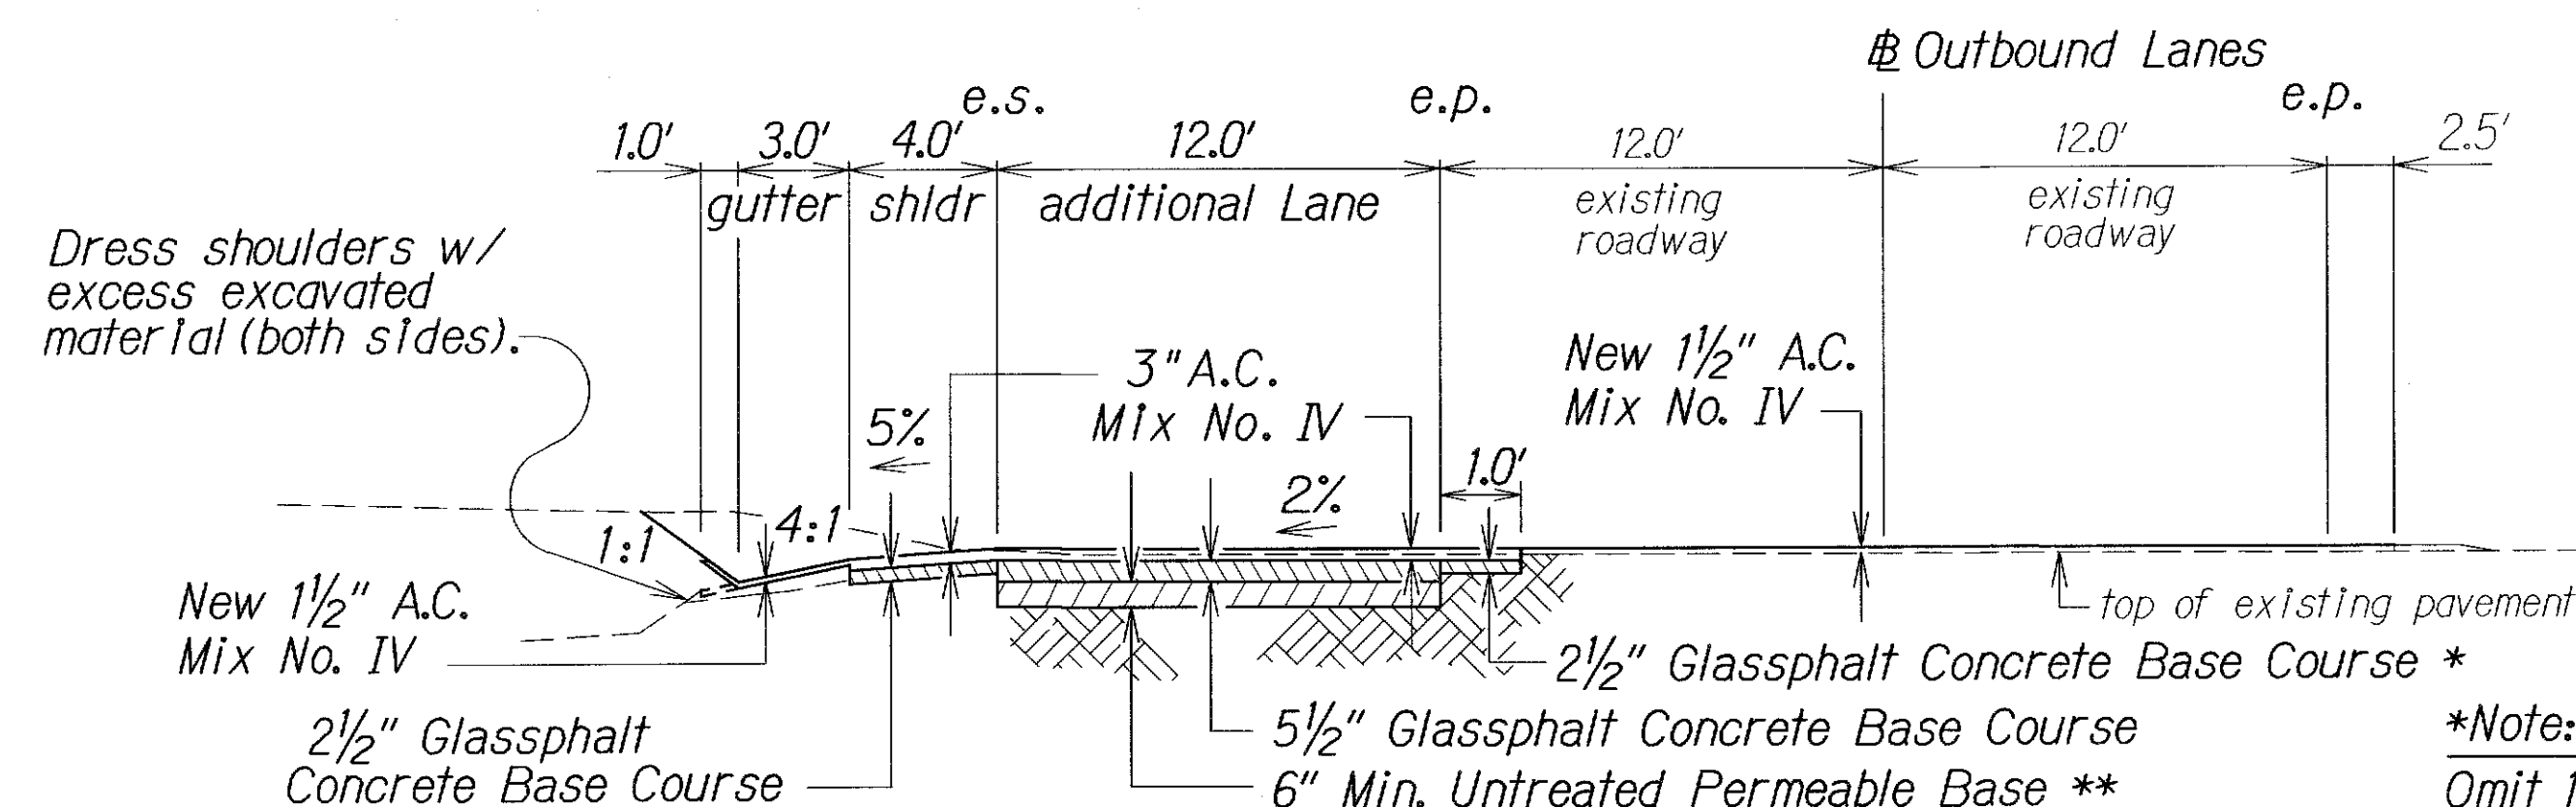


TYPICAL DECEL LANES AT STA. 1314+90 to STA. 1321+00 AND STA. 1333+60 to STA. 1335+40
Not to Scale

***Note:**
Omit 1.0' Cutback and 2 1/2" Glassphalt Concrete Base Course if Excavation is Done by Cold panning

****Note:**
Omit 4" Untreated Permeable Base Where Rocky Material is Encountered, Subject to Approval of the Engineer

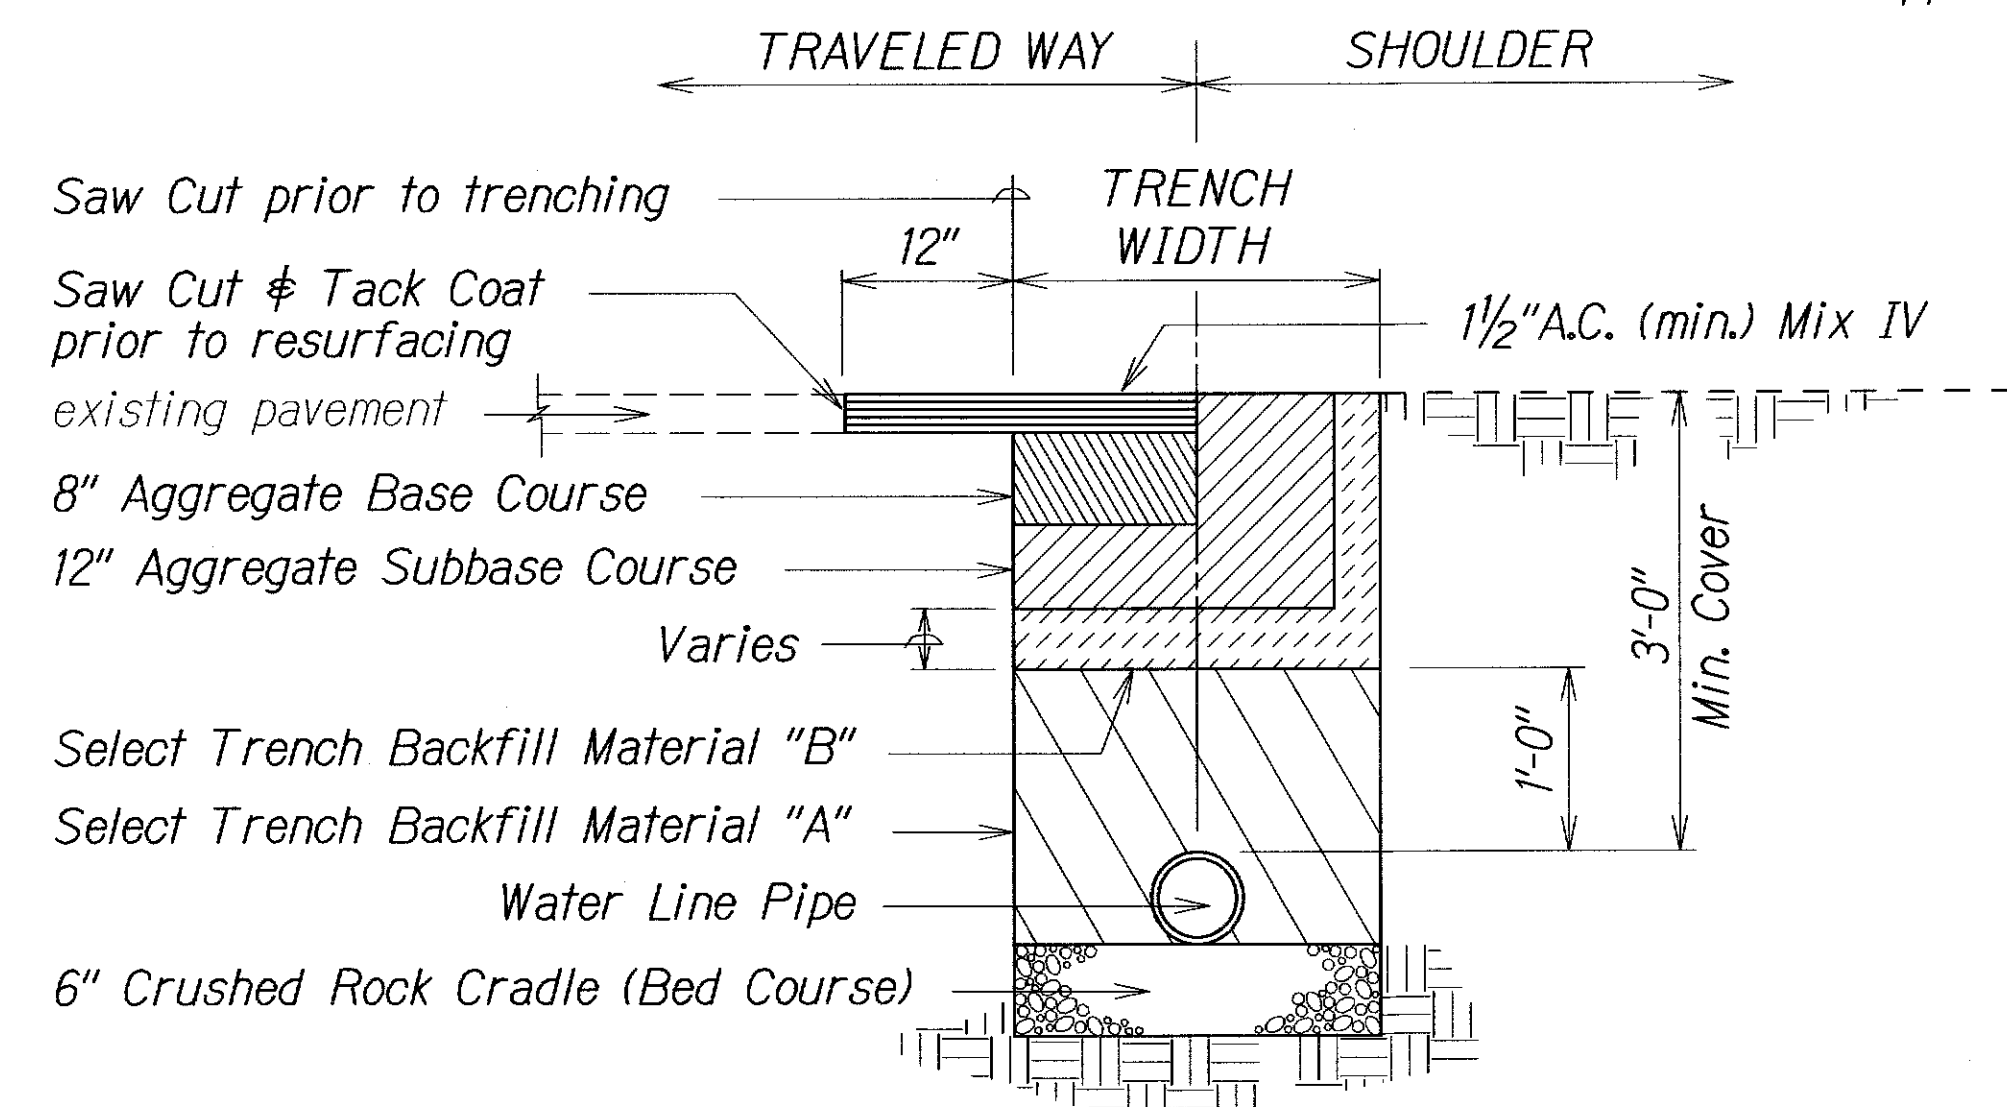

TYPICAL TRENCH DETAIL
Not To Scale

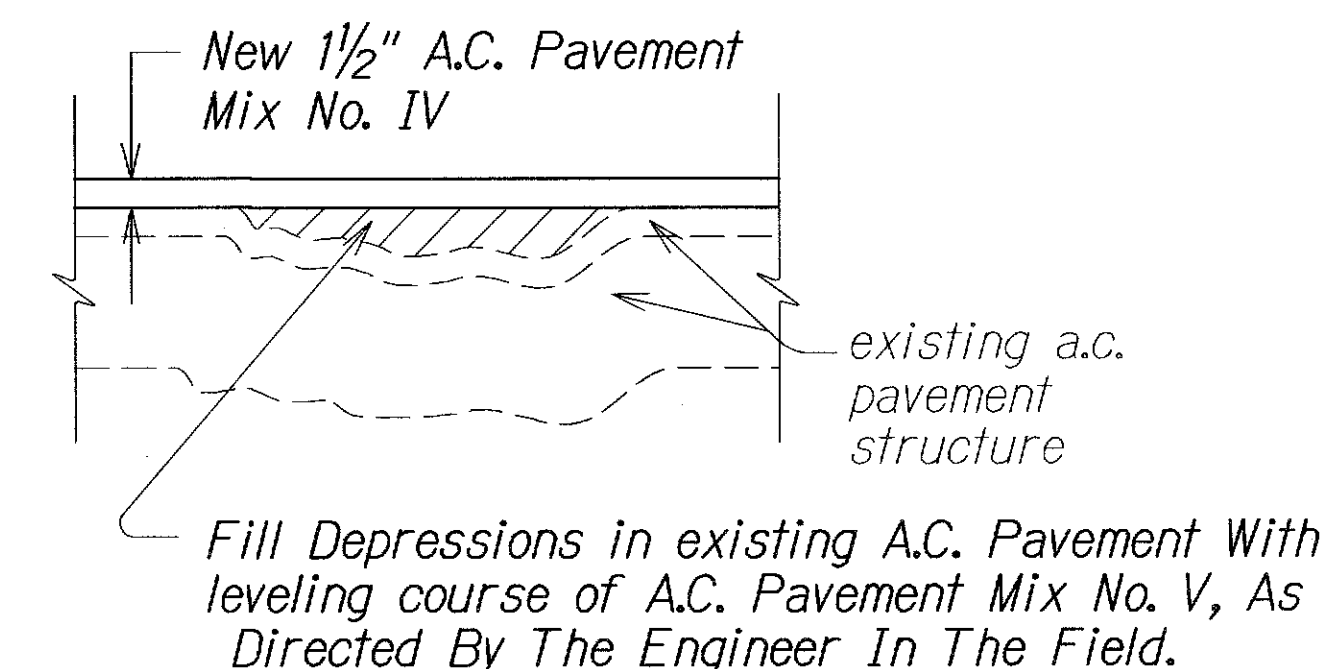

PAVEMENT DETAIL "A"
Not To Scale

***Note:**
Omit 1.0' Cutback and 2 1/2" Glassphalt Concrete Base Course if Excavation is Done by Cold panning

****Note:**
Omit 4" Untreated Permeable Base Where Rocky Material is Encountered, Subject to Approval of the Engineer

2/3/97 CO#2-Base, Pavement Thickness; Notes; Trench Def.

DATE REVISION

STATE OF HAWAII
DEPARTMENT OF TRANSPORTATION
HIGHWAYS DIVISION
TYPICAL SECTION AND DETAILS (OBL)
KAOELEHUA AVENUE RESURFACING
PANAewa BRIDGE TO PUAINAKO ST.
F.A. PROJECT NO. NH-011-2(33)

Scale: As Shown Date: April, 1996

SHEET No. 1 OF 1 SHEETS