


NOTES:

1. The work necessary to connect guardrail to concrete end post shall include all labor, materials, tools, equipment and incidentals necessary to complete the work and shall be incidental to the metal guardrail and will not be paid for separately.
2. Metal spacer block shall be W6x9. Guardrail post shall be W6x15. For other guardrail details, see "DOT Standard Plan" *TE-57 for Type 3 three beam guardrail details. See "DOT Standard Plan" *TE-50 & TE-51 for W beam metal guardrail details. Lap terminal connector and rail element in direction of traffic to prevent snagging.
3. Where double (nested) beam occur, 12" "Back-up Plate" not required.
4. Terminal connector and accessories will be considered incidental to item No. 606.3112 - guardrail, Type 3 three beam with steel post.



Scale: $\frac{1}{2}''=1'-0''$

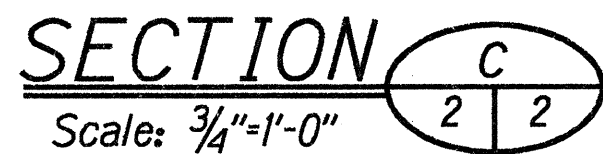

Scale: 6" = 1'-0"



Scale: $1\frac{1}{2}" = 1'-0"$

STATE OF HAWAII
DEPARTMENT OF TRANSPORTATION
HIGHWAYS DIVISION

BRIDGE CONNECTION
TYPE II - DETAILS & NOTES

HAWAII BELT ROAD
VICINITY OF PAHALA
PROJECT NO 11HKL-01-97M

Scale: As Noted

Date: June 1997

SHEET No. 2 OF 2 SHEETS