


FED. ROAD DIST. NO.	STATE	FED. AID PROJ. NO.	FISCAL YEAR	SHEET NO.	TOTAL SHEETS
HAWAII	HAW.	STP-011-2(30)	1998	13	13

Project No. F-011-2(2)
Sta. 167+22.73 =
Project No. S-0130(2)
Sta. 0+11.23

TRUE NORTH
SCALE: 1" = 20'

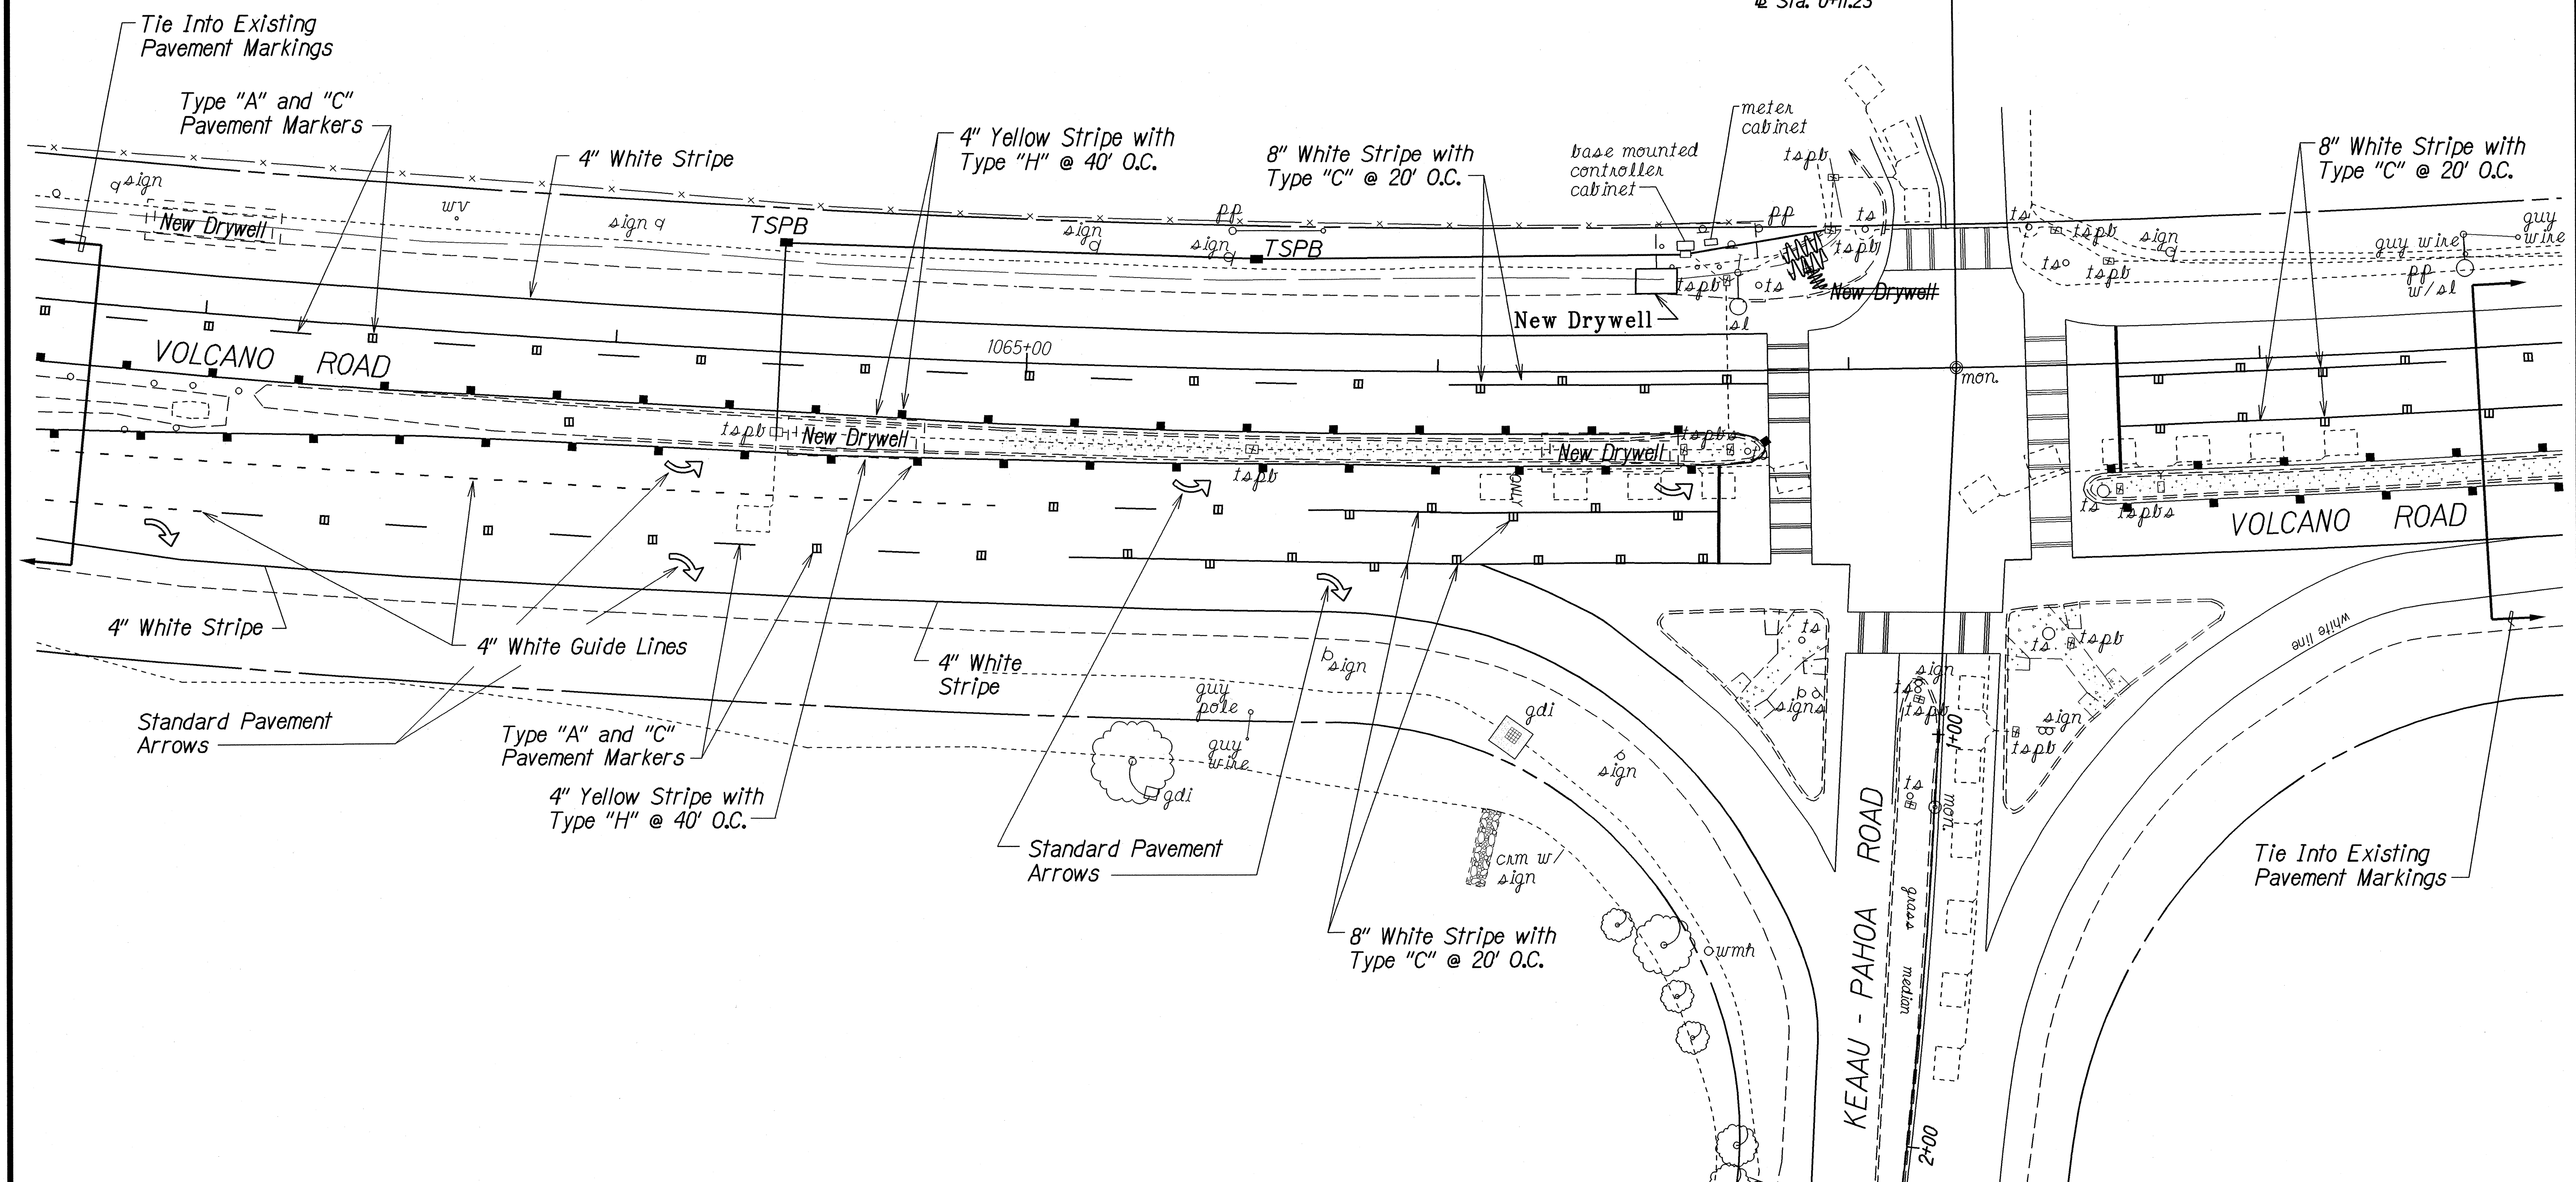

SURVEY PLOTTED BY	DATE
DRAWN BY	
TRACED BY	
QUANTITIES BY	
CHECKED BY	
ORIGINAL PLAN	
NOTE BOOK	
N ^o .	

LEGEND FOR AS-BUILT POSTINGS	
	Squiggly line for as-built deletion
	Double line for as-built deletion
Roadway	Text for as-built posting

STATE OF HAWAII
DEPARTMENT OF TRANSPORTATION
HIGHWAYS DIVISION

PAVEMENT MARKING PLAN

VOLCANO ROAD DRAINAGE IMPROVEMENTS
Vicinity of KeaaU Town
Federal Aid Project No. STP-011-2(30)

Scale: 1"=20' Date: April, 1997

SHEET No. T3 OF T3 SHEETS

"AS-BUILT"