

FED. ROAD DIST. NO.	STATE	FED. AID PROJ. NO.	FISCAL YEAR	SHEET NO.	TOTAL SHEETS
HAWAII	HAW.	STP-011-2(30)	1998	11	13

TRUE NORTH
SCALE: 1" = 20'


Project No. F-011-2(2)
Sta. 167+22.73 =
Project No. S-0130(2)
Sta. 0+11.23

Sta. 1075+00 Lt.

 W5-1
 36"x36"

Sta. 1078+00 Lt.

 35
 M.P.H.
 CW13-1(35)-A
 24"x24"

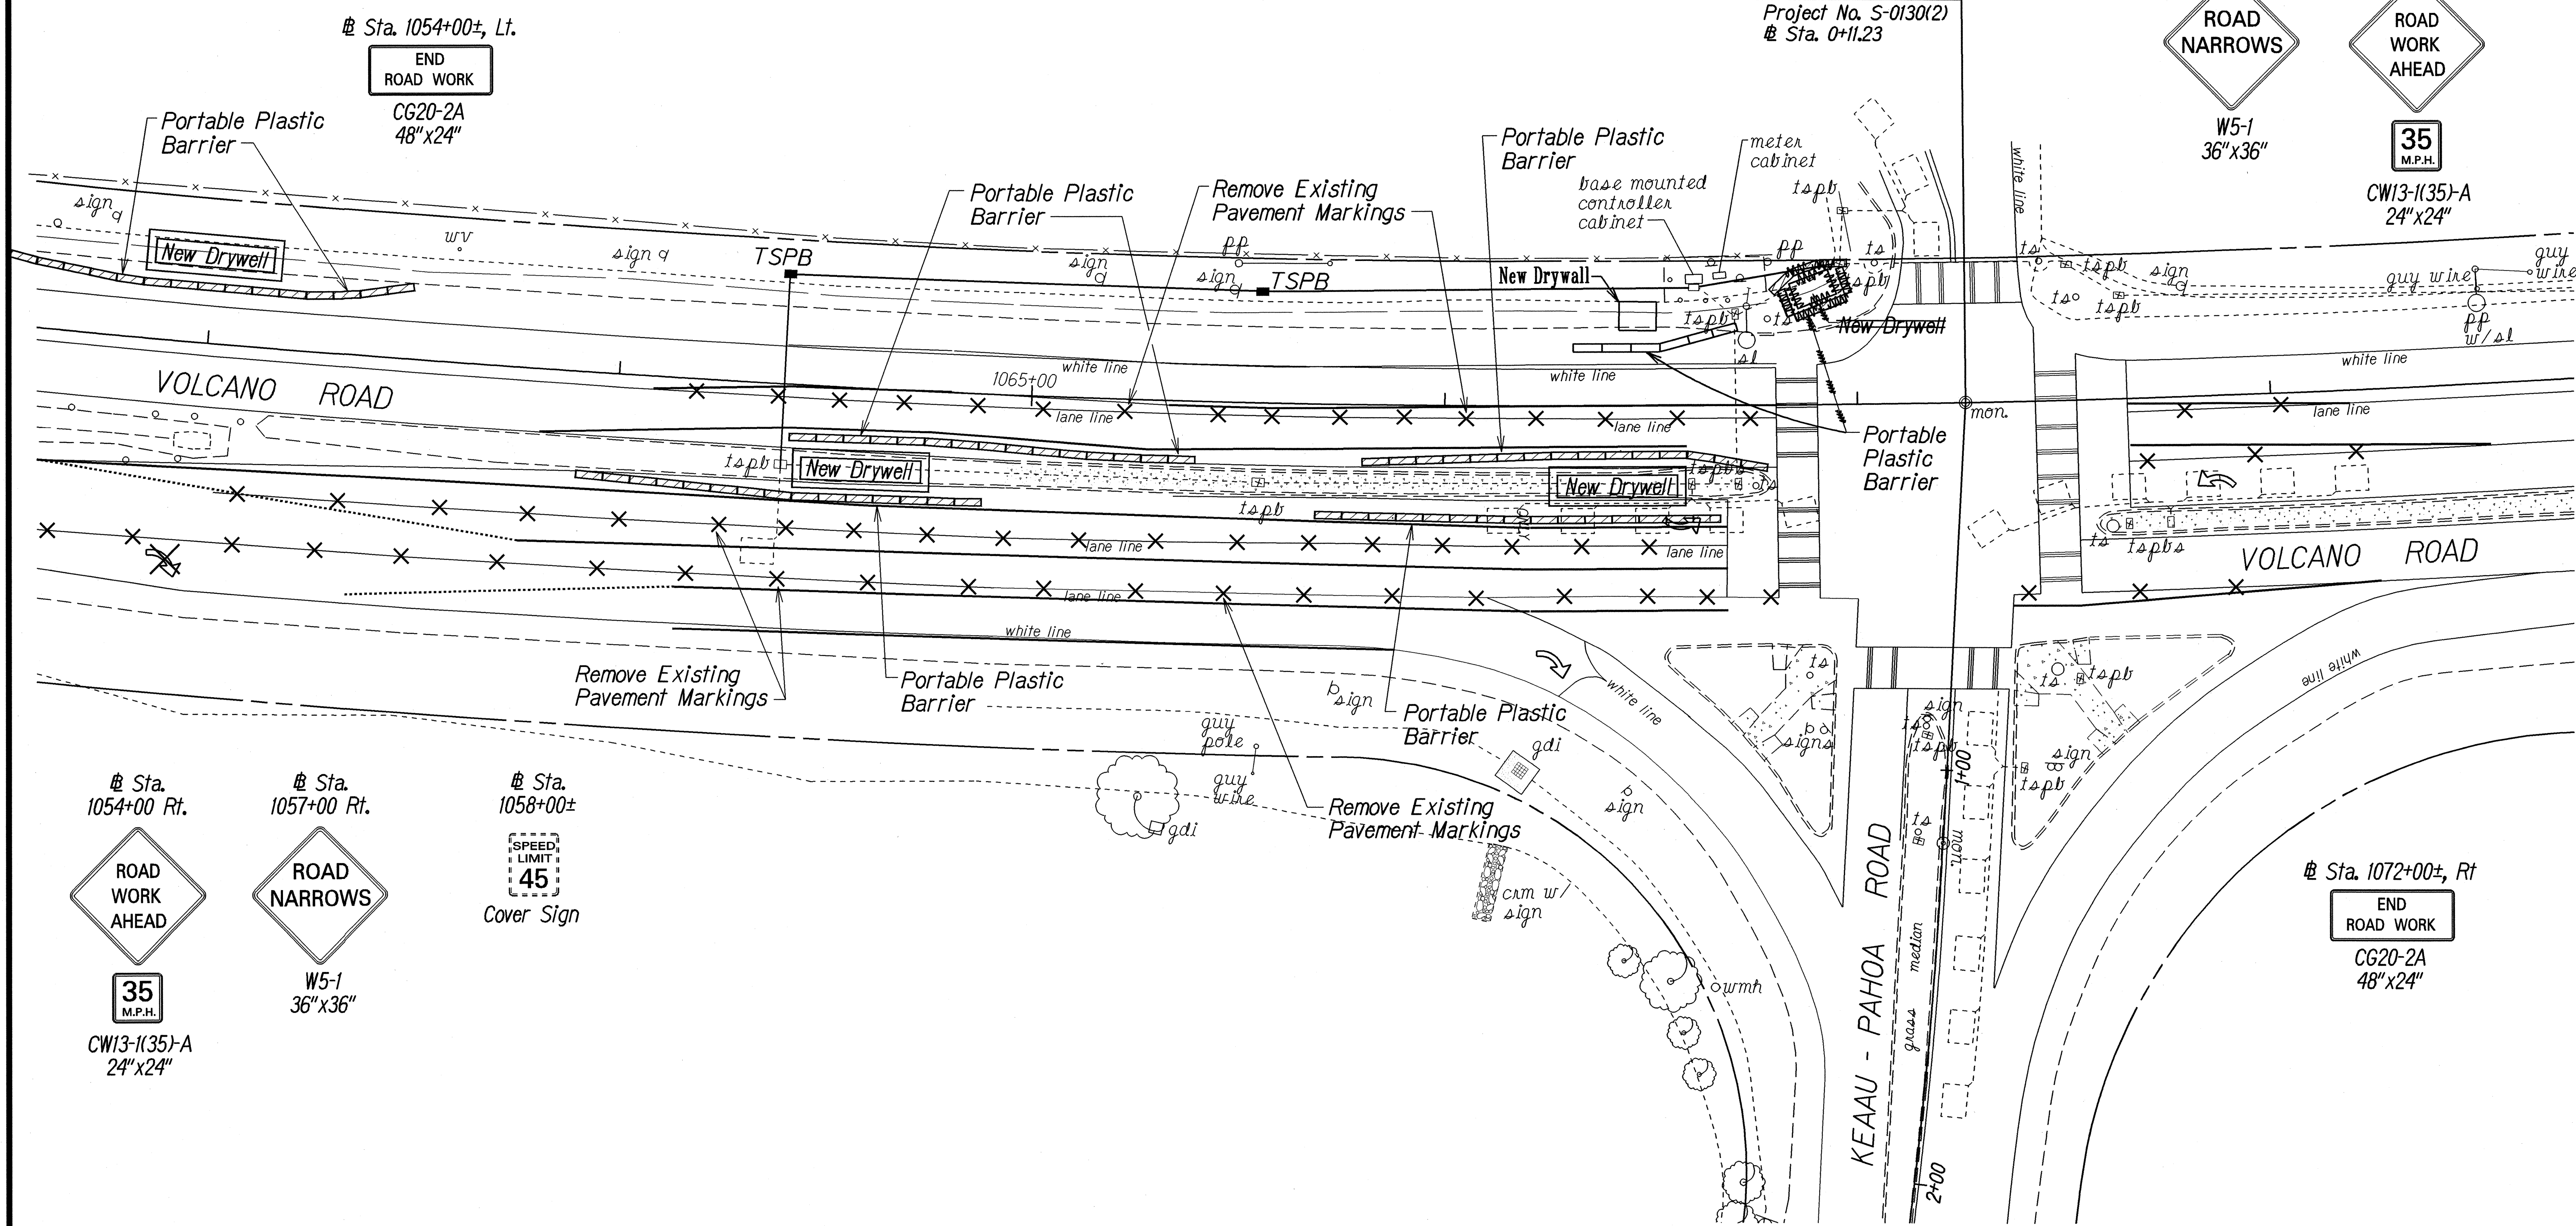

Sta. 1054+00 Rt.

 35
 M.P.H.
 CW13-1(35)-A
 24"x24"

Sta. 1057+00 Rt.

 W5-1
 36"x36"

Sta. 1058+00±

 45
 Cover Sign

SURVEY PLOTTED BY	DATE
DRAWN BY	10/27/97
TRACED BY	
NOTE BOOK	
QUANTITIES BY	
CHECKED BY	

LEGEND FOR AS-BUILT POSTINGS	
	Squiggly line for as-built deletion
	Double line for as-built deletion
Roadway	Text for as-built posting

CW20-1AD
 48"x48"

STATE OF HAWAII
 DEPARTMENT OF TRANSPORTATION
 HIGHWAYS DIVISION
TEMPORARY ROADWAY
PHASING PLAN
 VOLCANO ROAD DRAINAGE IMPROVEMENTS
 Vicinity of Keaa Town
 Federal Aid Project No. STP-011-2(30)
 Scale: 1"=20' Date: April, 1997
 SHEET No. 11 OF 13 SHEETS

"AS-BUILT"