




FED. ROAD DIST. NO.	STATE	FED. AID PROJ. NO.	FISCAL YEAR	SHEET NO.	TOTAL SHEETS
HAWAII	HAW.	BR-0100(58)	1998	8	16

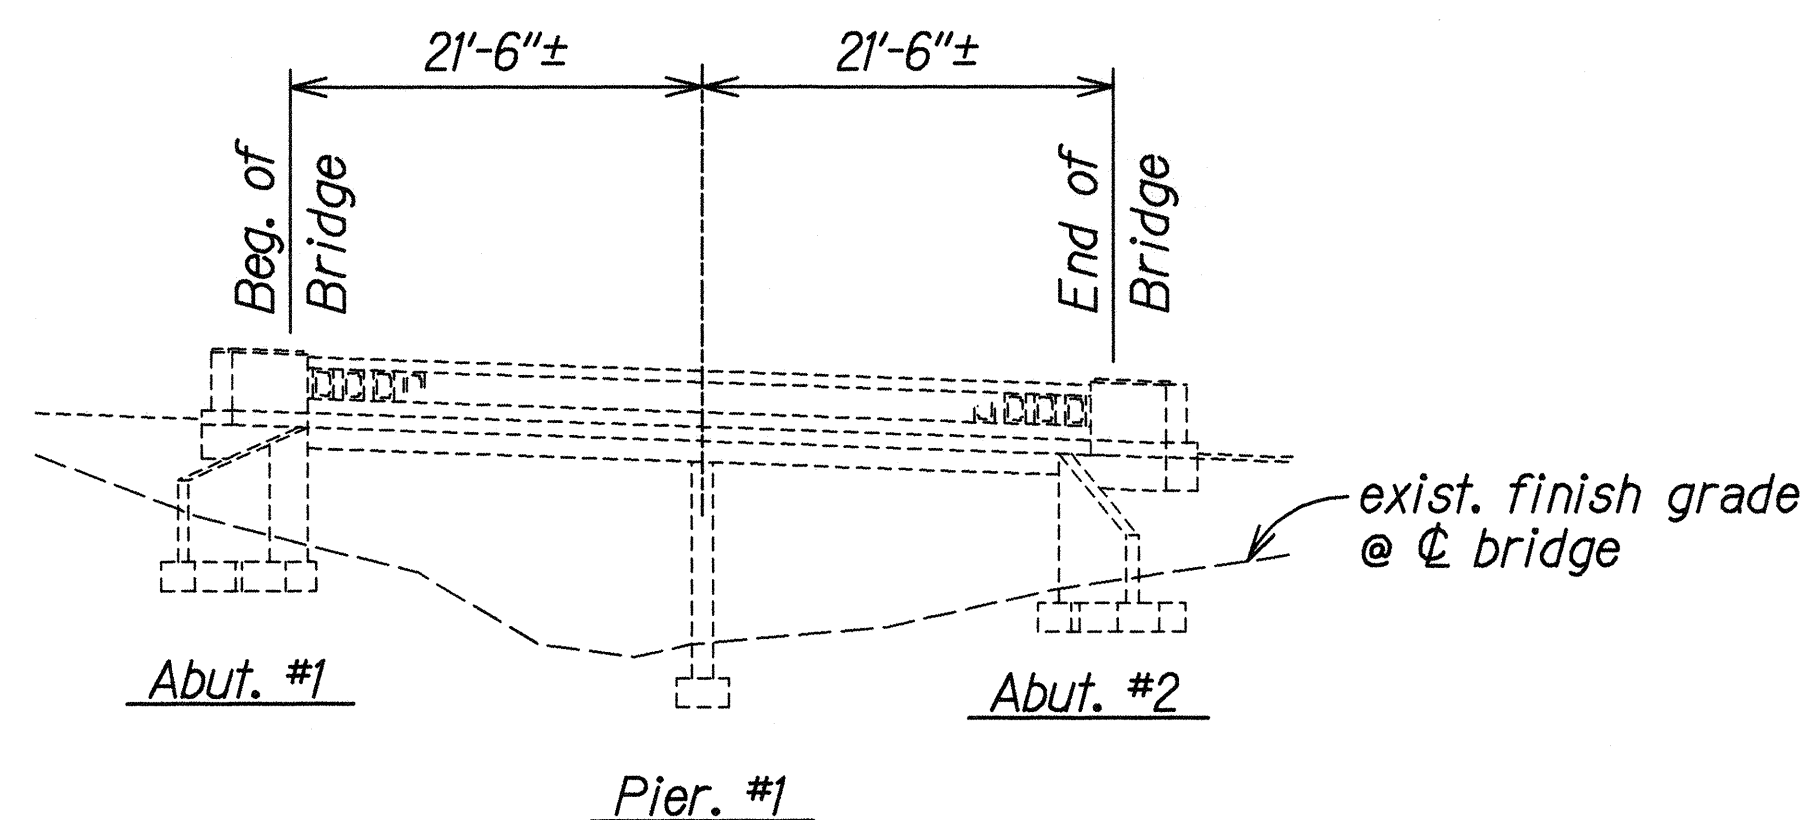

ELEVATION
Scale: 1" = 10'-0"

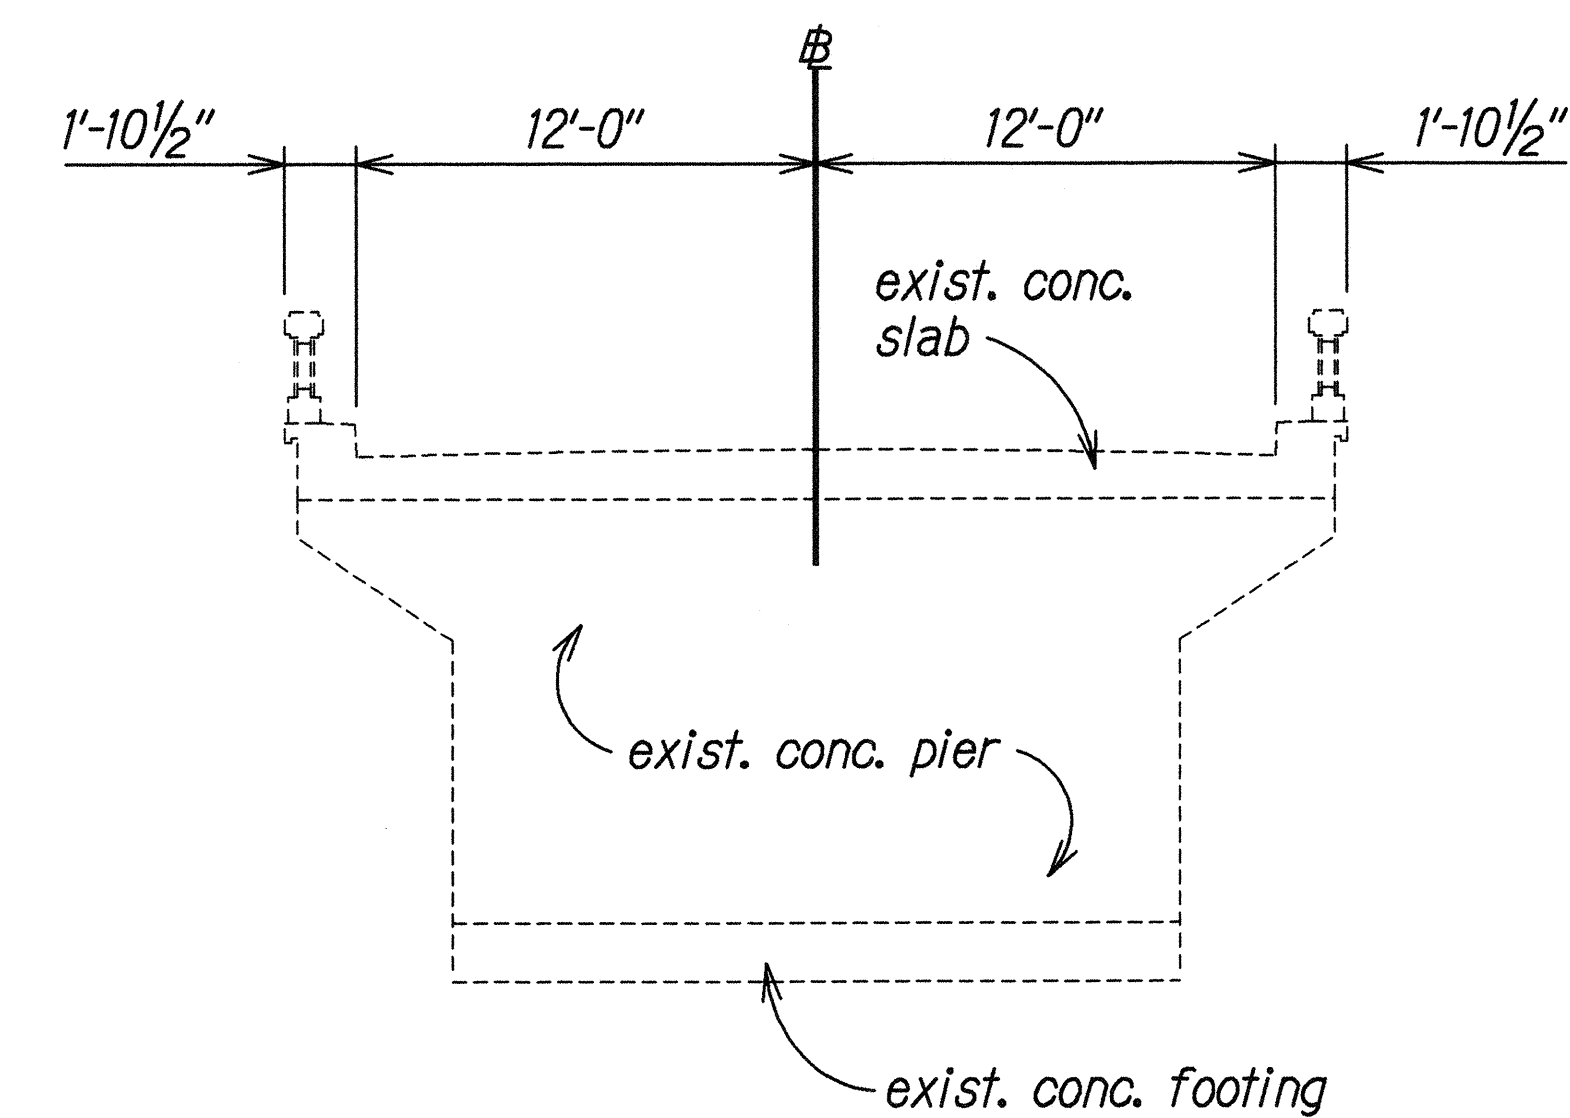

SECTION AT PIER
Scale: 1" = 5'-0"

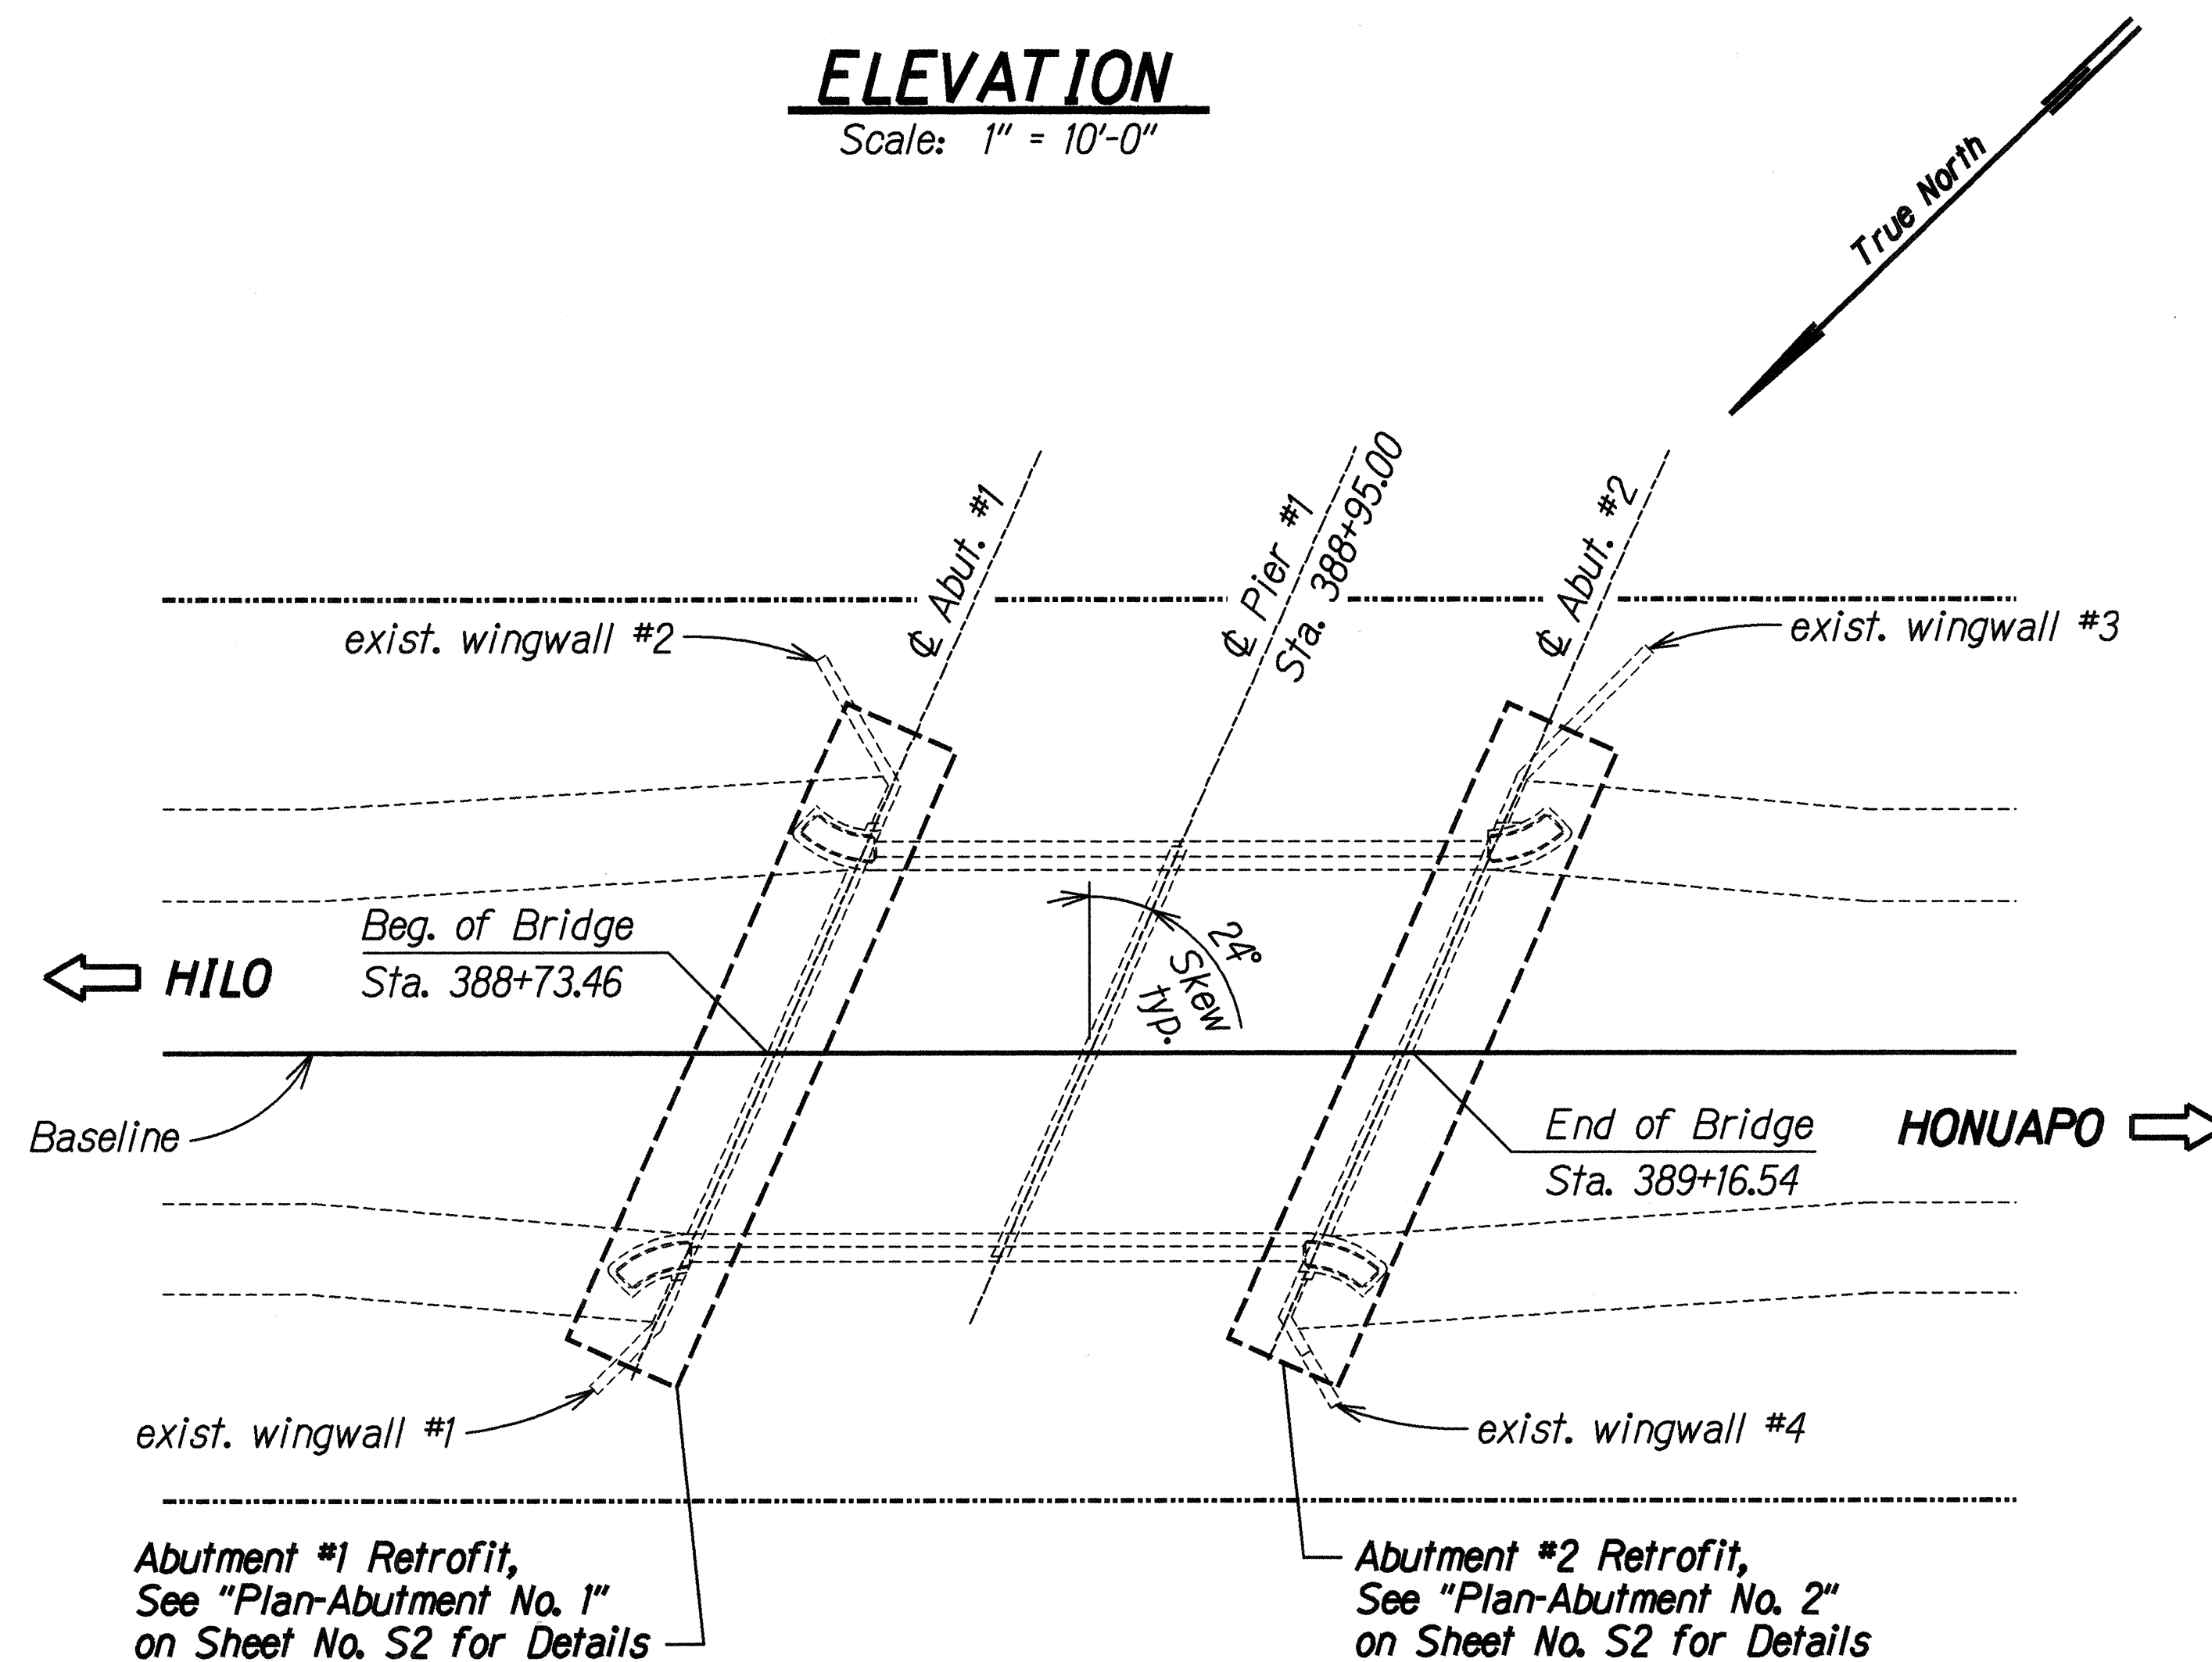

PLAN
Scale: 1" = 10'-0"

ESTIMATED QUANTITIES			
ITEM NO.	ITEM	QUANTITY	UNIT
653.1002	Drilling Holes and Installing Dowel Reinforcing Bars	32	Ea.

ORIGINAL PLAN	DATE
DESIGNED BY	MAY 1997
DRAWN BY	JHG
CHECKED BY	GO
INCHES	1/4"
SCALE	1" = 10'-0"
DATE	MAY 1997



THIS WORK WAS PREPARED BY
ME OR UNDER MY SUPERVISION
SIGNATURE

STATE OF HAWAII
DEPARTMENT OF TRANSPORTATION
HIGHWAYS DIVISION
KANANELU BRIDGE
PLAN, ELEVATION, SECTION AND
ESTIMATED QUANTITIES
SEISMIC RETROFIT OF VARIOUS BRIDGES
VICINITY OF PUNALUU
Fed. Aid Project No. BR-0100(58)
Scale: As Noted Date: Sept. 1997
SHEET No. **55** OF **16** SHEETS