


FED. ROAD DIST. NO.	STATE	FED. AID PROJ. NO.	FISCAL YEAR	SHEET NO.	TOTAL SHEETS
HAWAII	HAWAII	ER-12(2)	2001	26	145

Sta. (-)2+00 to Sta. (-)0+50
Hydro Mulch seeding added
to channel bottom & Slope
for erosion control.

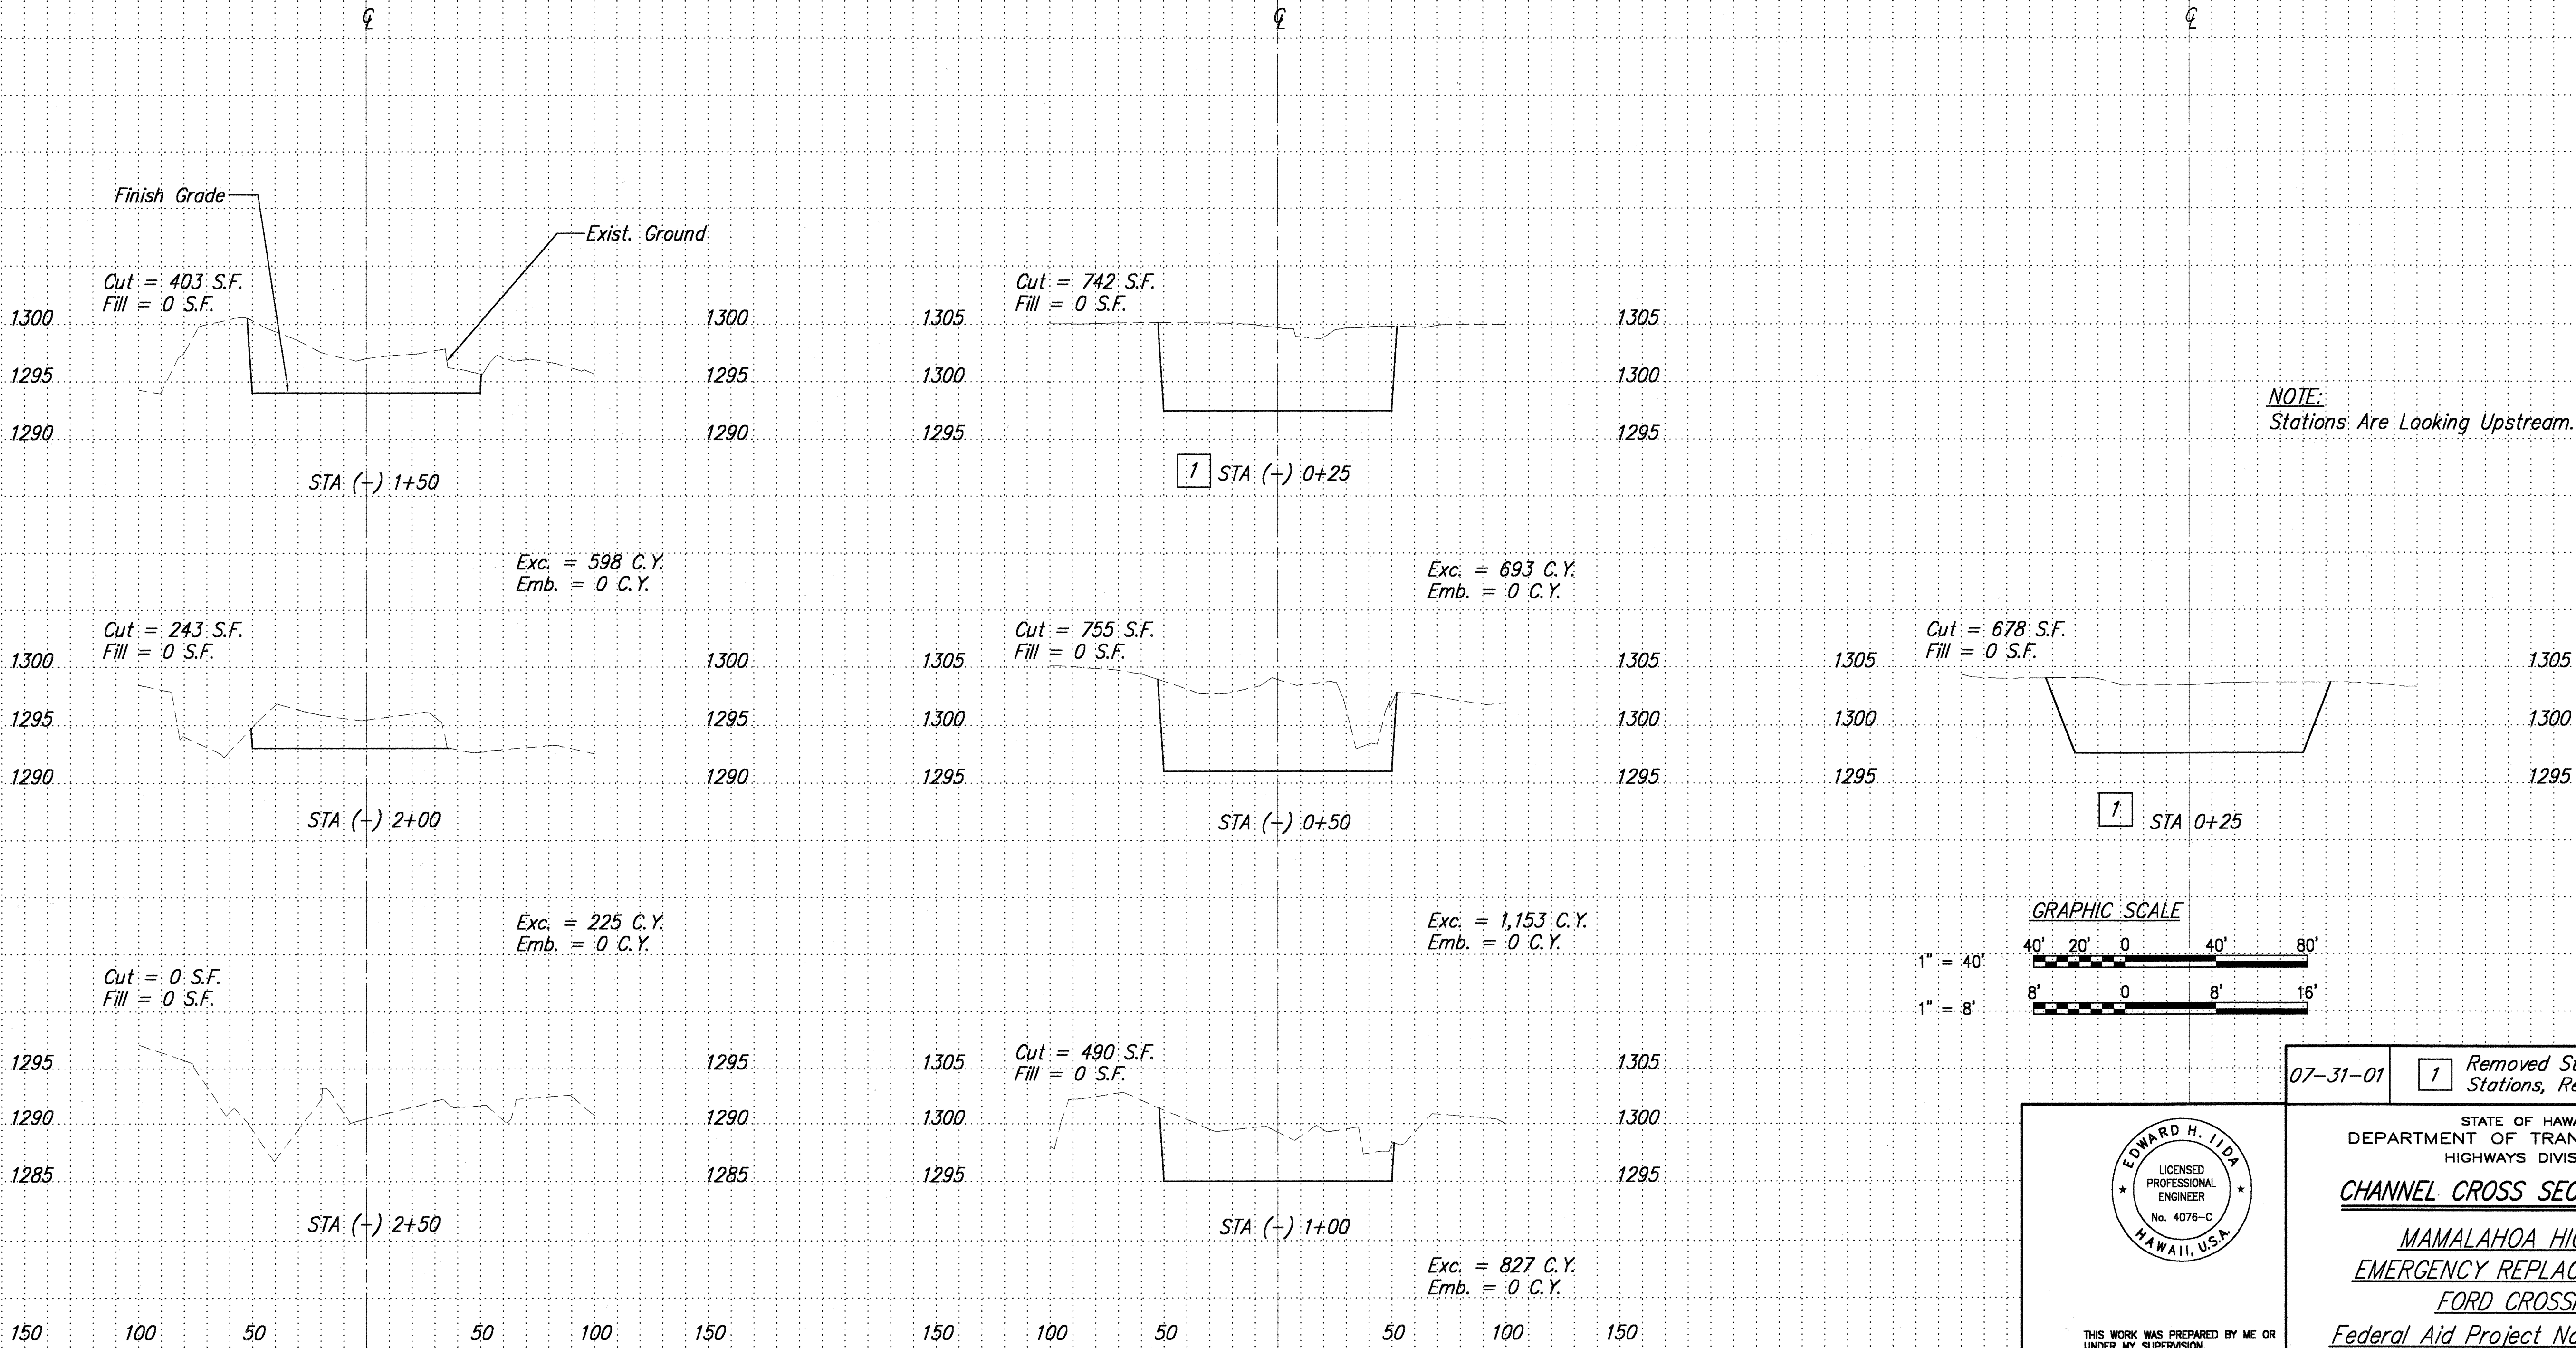


ORIGINAL PLAN	DATE
DESIGNED BY	
TRACED BY	
NOTED BY	
CHECKED BY	
DATE	

"AS-BUILT"

ADD. 26

FED. ROAD DIST. NO.	STATE	FED. AID PROJ. NO.	FISCAL YEAR	SHEET NO.	TOTAL SHEETS
HAWAII	HAWAII	ER-12(2)	2001	27	145

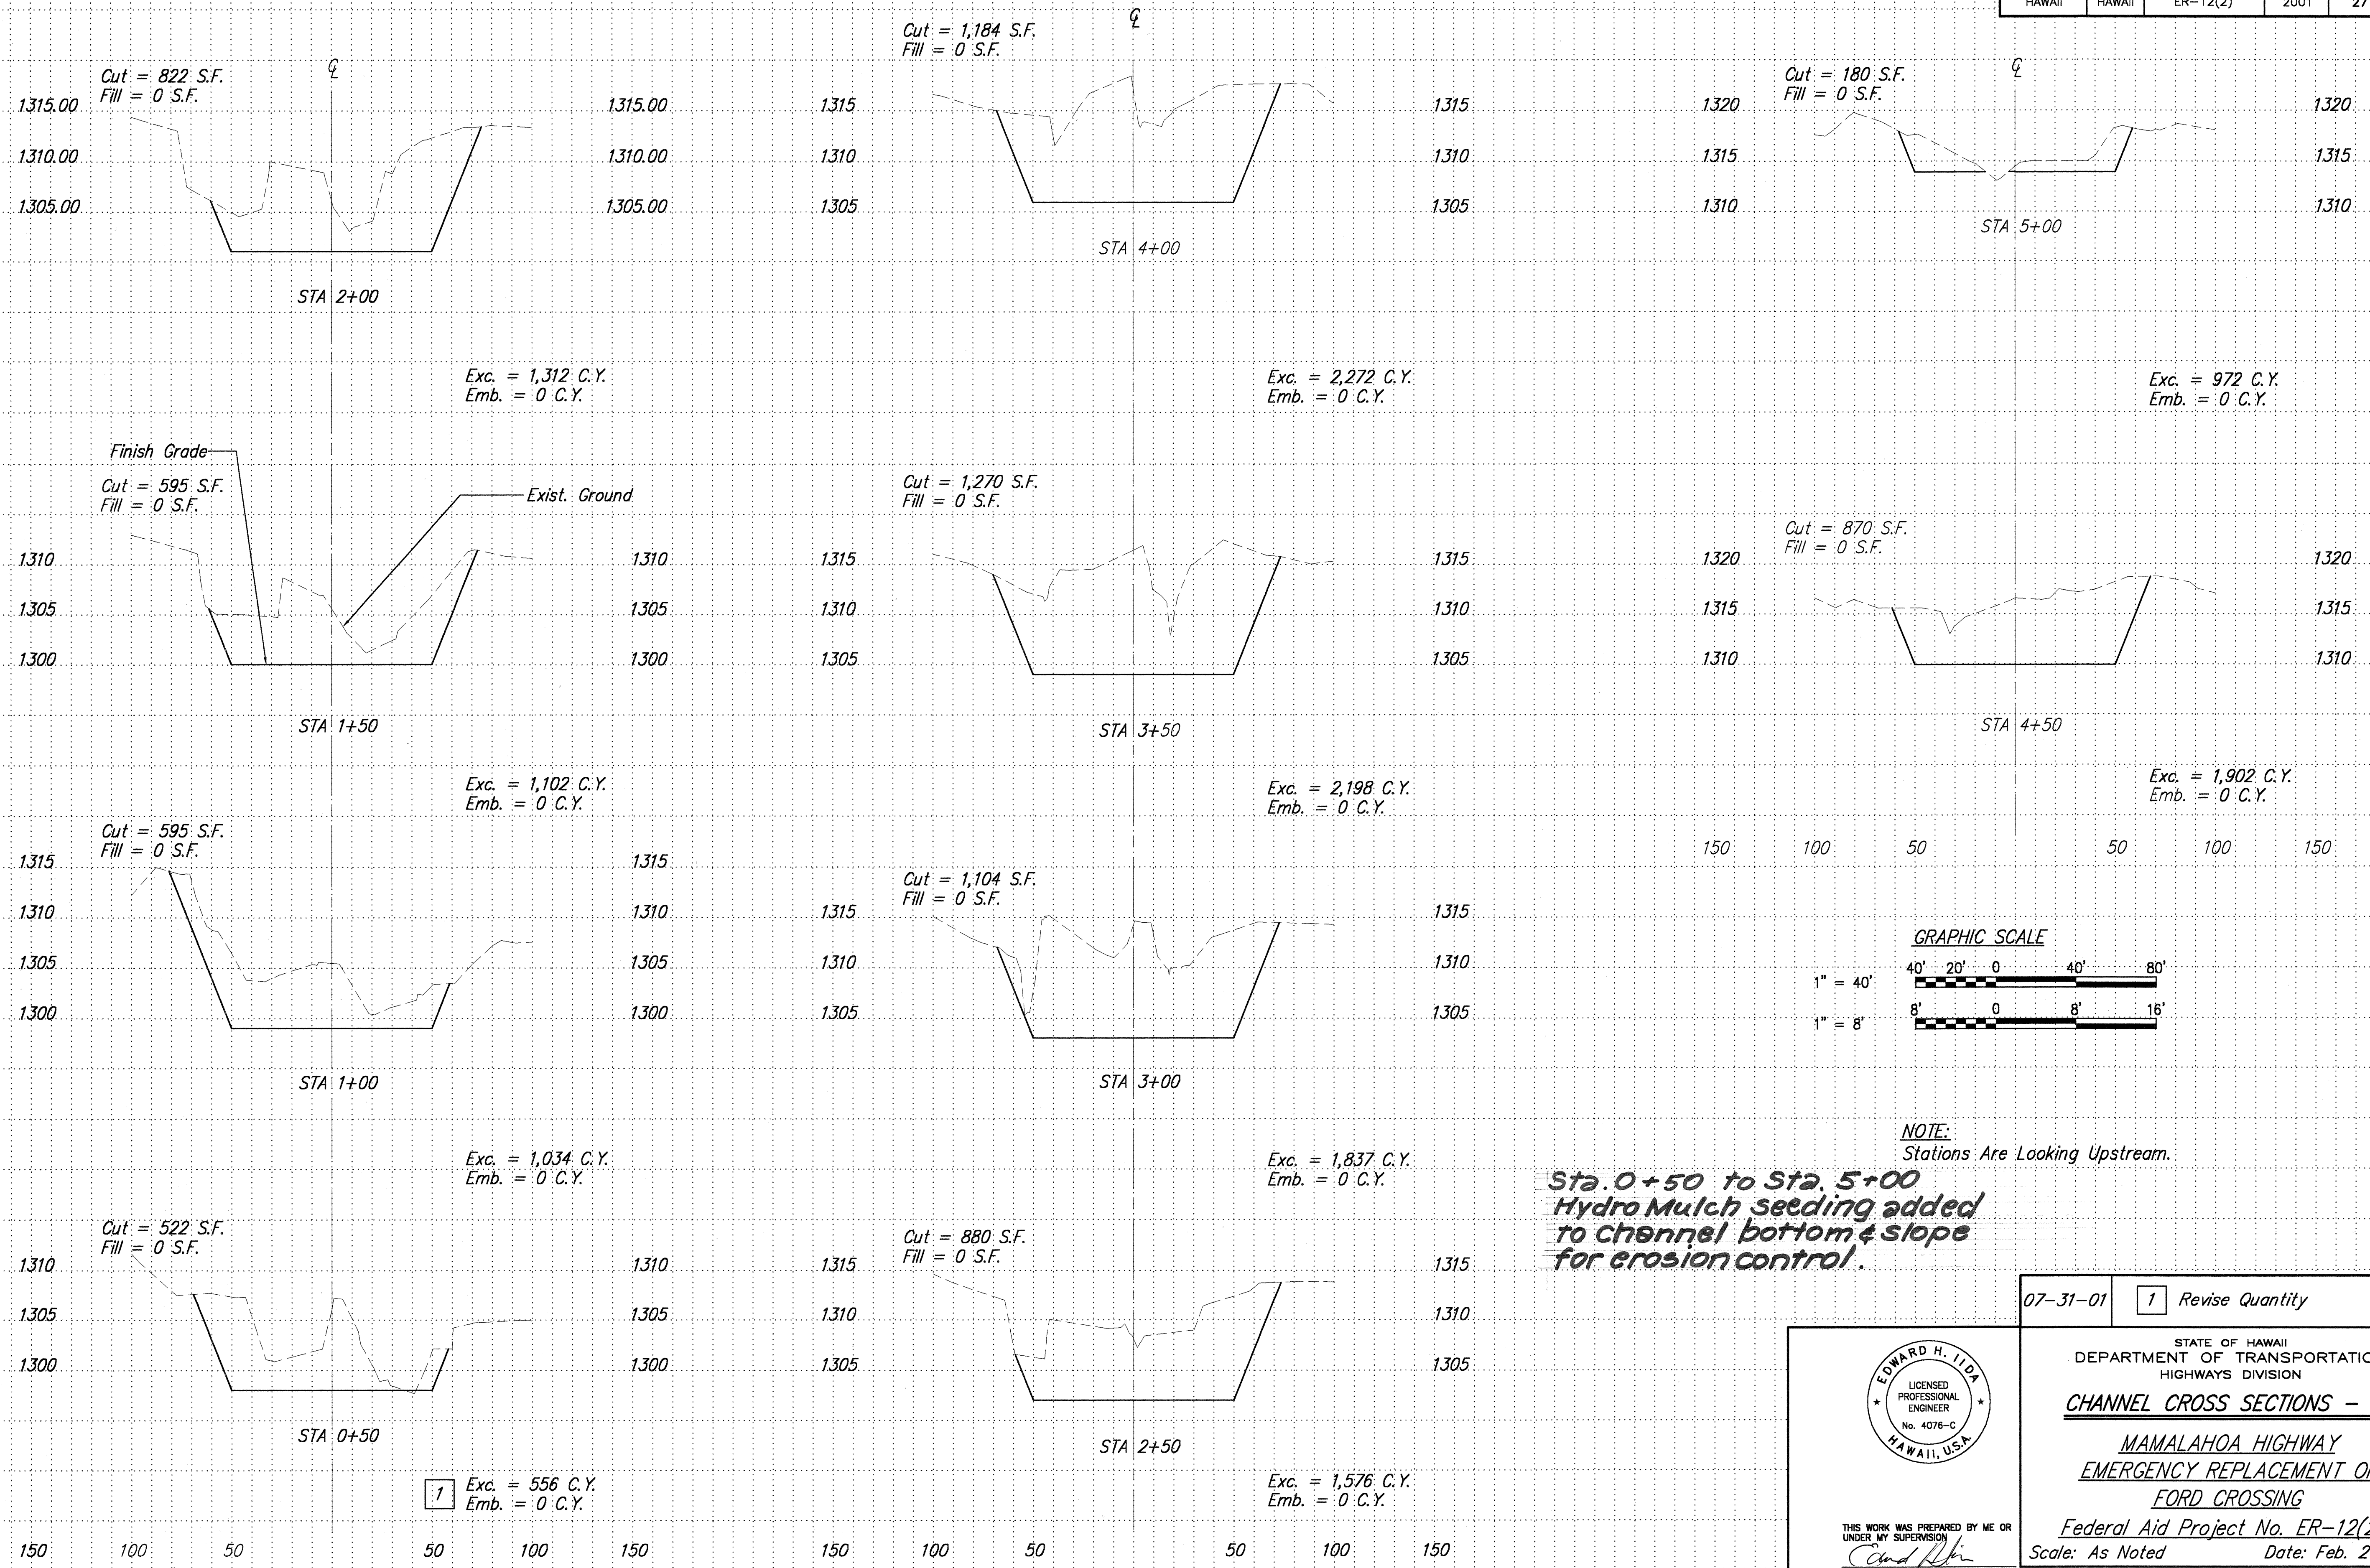

SURVEY PLOTTED BY	DATE
DESIGNED BY	
TRACED BY	
NOTE BOOK	
QUANTITIES BY	
CHECKED BY	

07-31-01

1 Revise Quantity

STATE OF HAWAII
DEPARTMENT OF TRANSPORTATION
HIGHWAYS DIVISION

CHANNEL CROSS SECTIONS - 2

MAMALAHOA HIGHWAY
EMERGENCY REPLACEMENT OF
FORD CROSSING

Federal Aid Project No. ER-12(2)
Scale: As Noted Date: Feb. 2001

SHEET No. AC-260F 29 SHEETS

EDWARD H. LIDA
LICENSED PROFESSIONAL ENGINEER
No. 4076-C
HAWAII, U.S.A.

THIS WORK WAS PREPARED BY ME OR UNDER MY SUPERVISION
Edward H. Lida
MITSUNAGA & ASSOCIATES

"AS-BUILT"