

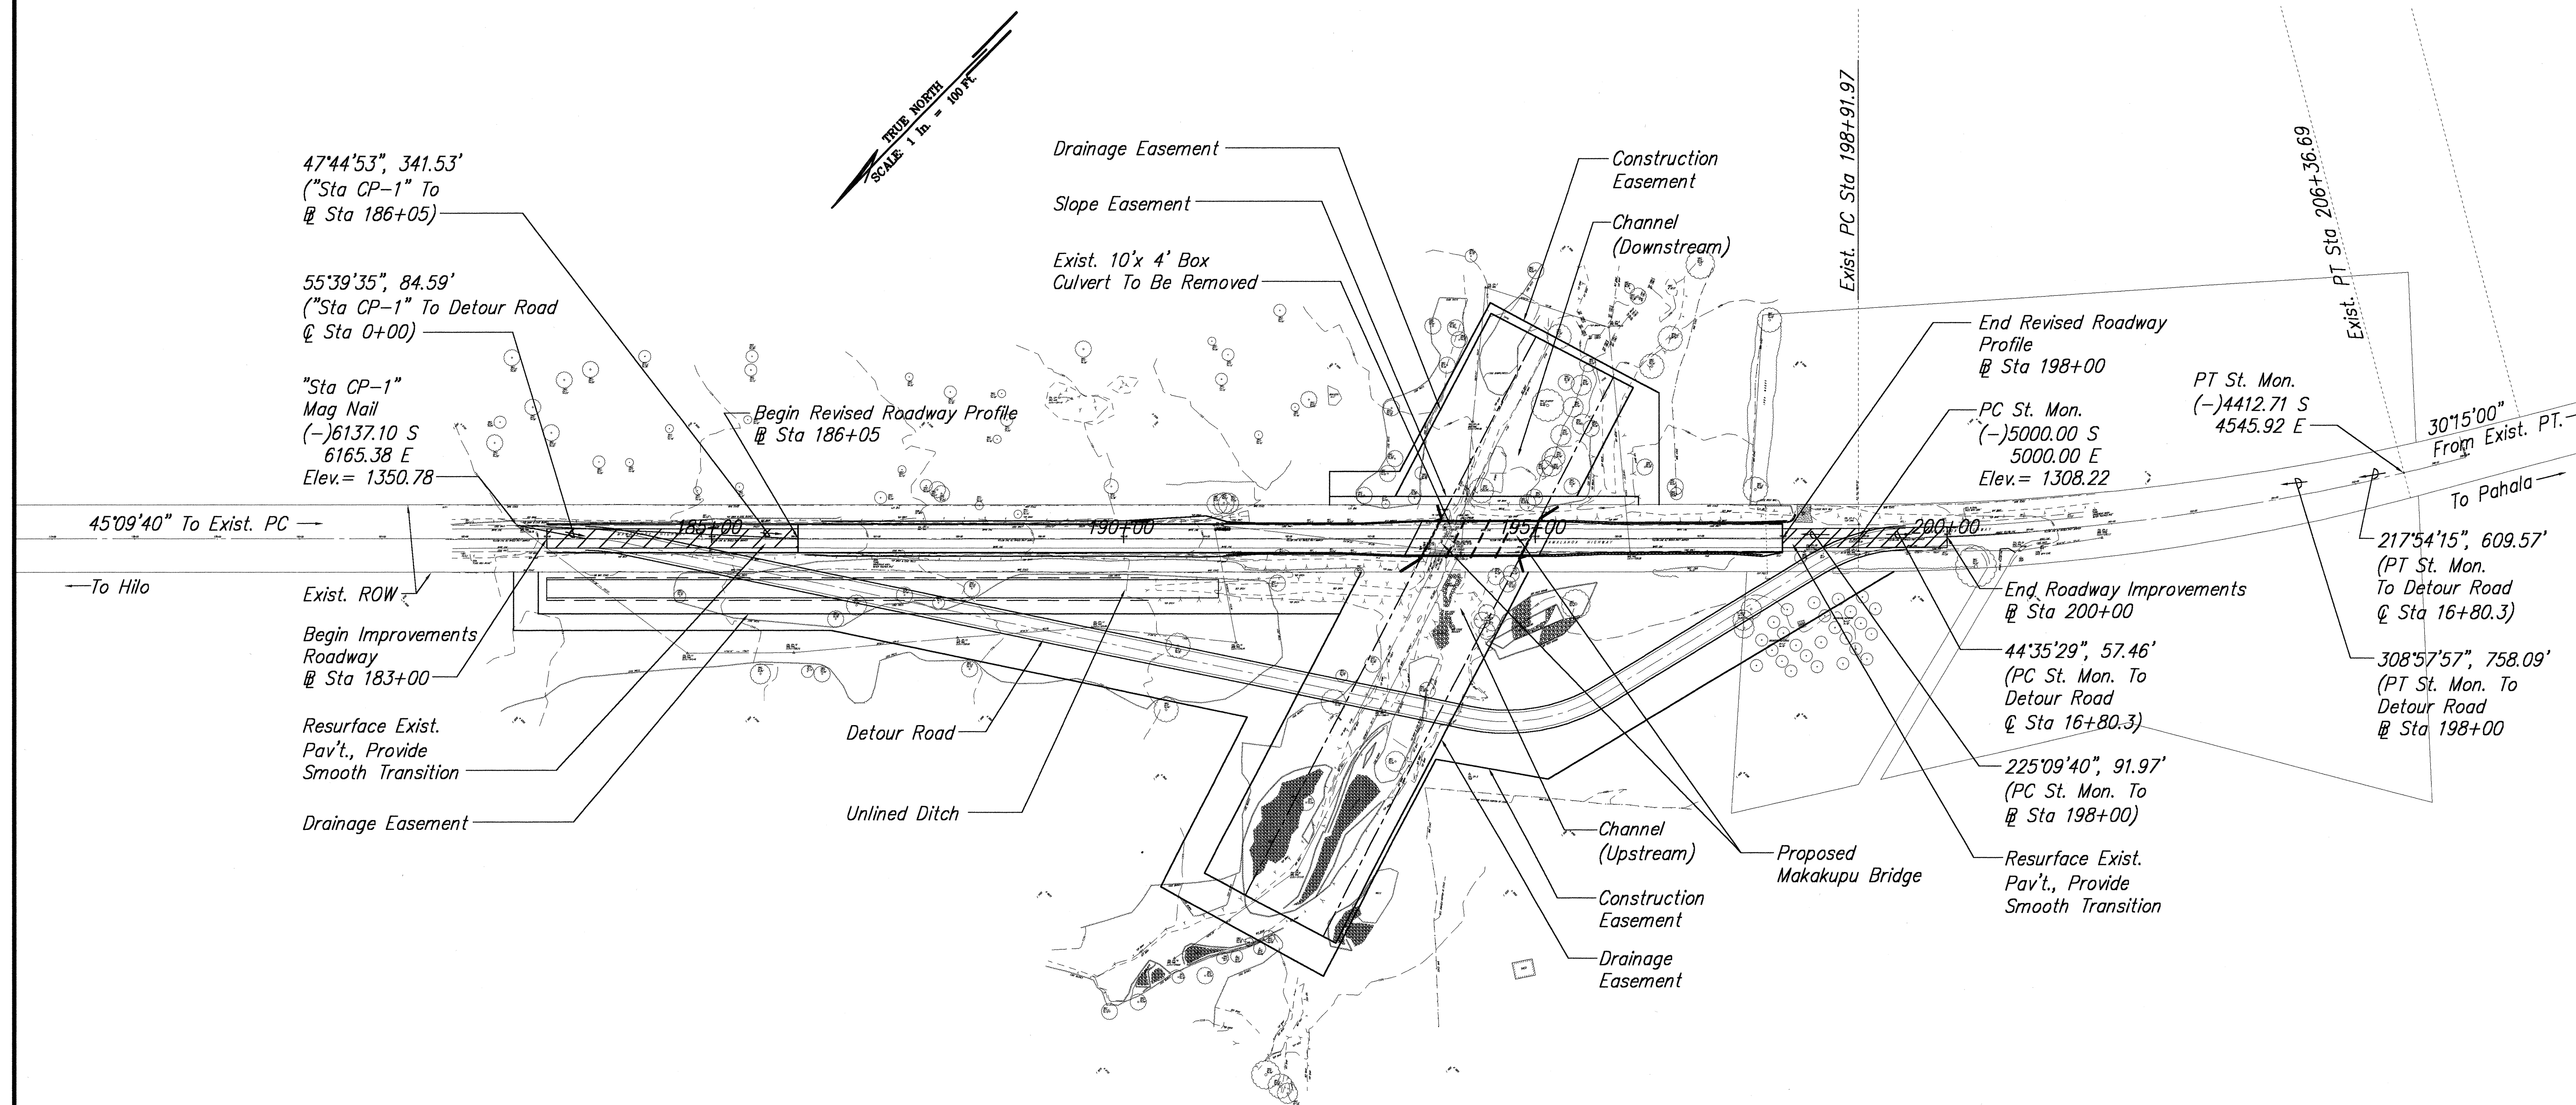


FED. ROAD DIST. NO.	STATE	FED. AID PROJ. NO.	FISCAL YEAR	SHEET NO.	TOTAL SHEETS
HAWAII	HAWAII	ER-12(2)	2001	8	145

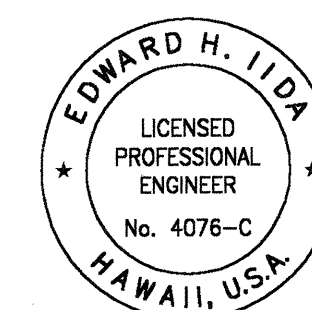

PLAN - GENERAL SITE
Scale: 1"=100'

GRAPHIC SCALE:

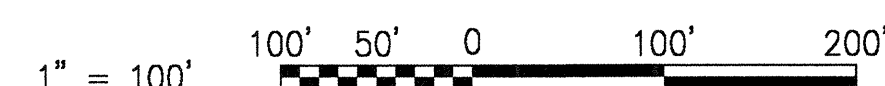

THIS WORK WAS PREPARED BY ME OR
UNDER MY SUPERVISION
Edward H. Iida
MITSUNAGA & ASSOCIATES

STATE OF HAWAII
DEPARTMENT OF TRANSPORTATION
HIGHWAYS DIVISION

GENERAL SITE PLAN

**MAMALAHOA HIGHWAY
EMERGENCY REPLACEMENT OF
FORD CROSSING**

Federal Aid Project No. ER-12(2)
Scale: As Noted Date: Feb. 2001

SHEET No. AC-7 OF 29 SHEETS