


FED. ROAD DIST. NO.	STATE	FED. AID PROJ. NO.	FISCAL YEAR	SHEET NO.	TOTAL SHEETS
HAWAII	HAW.	FLH-011-2(34)	2001	5	13

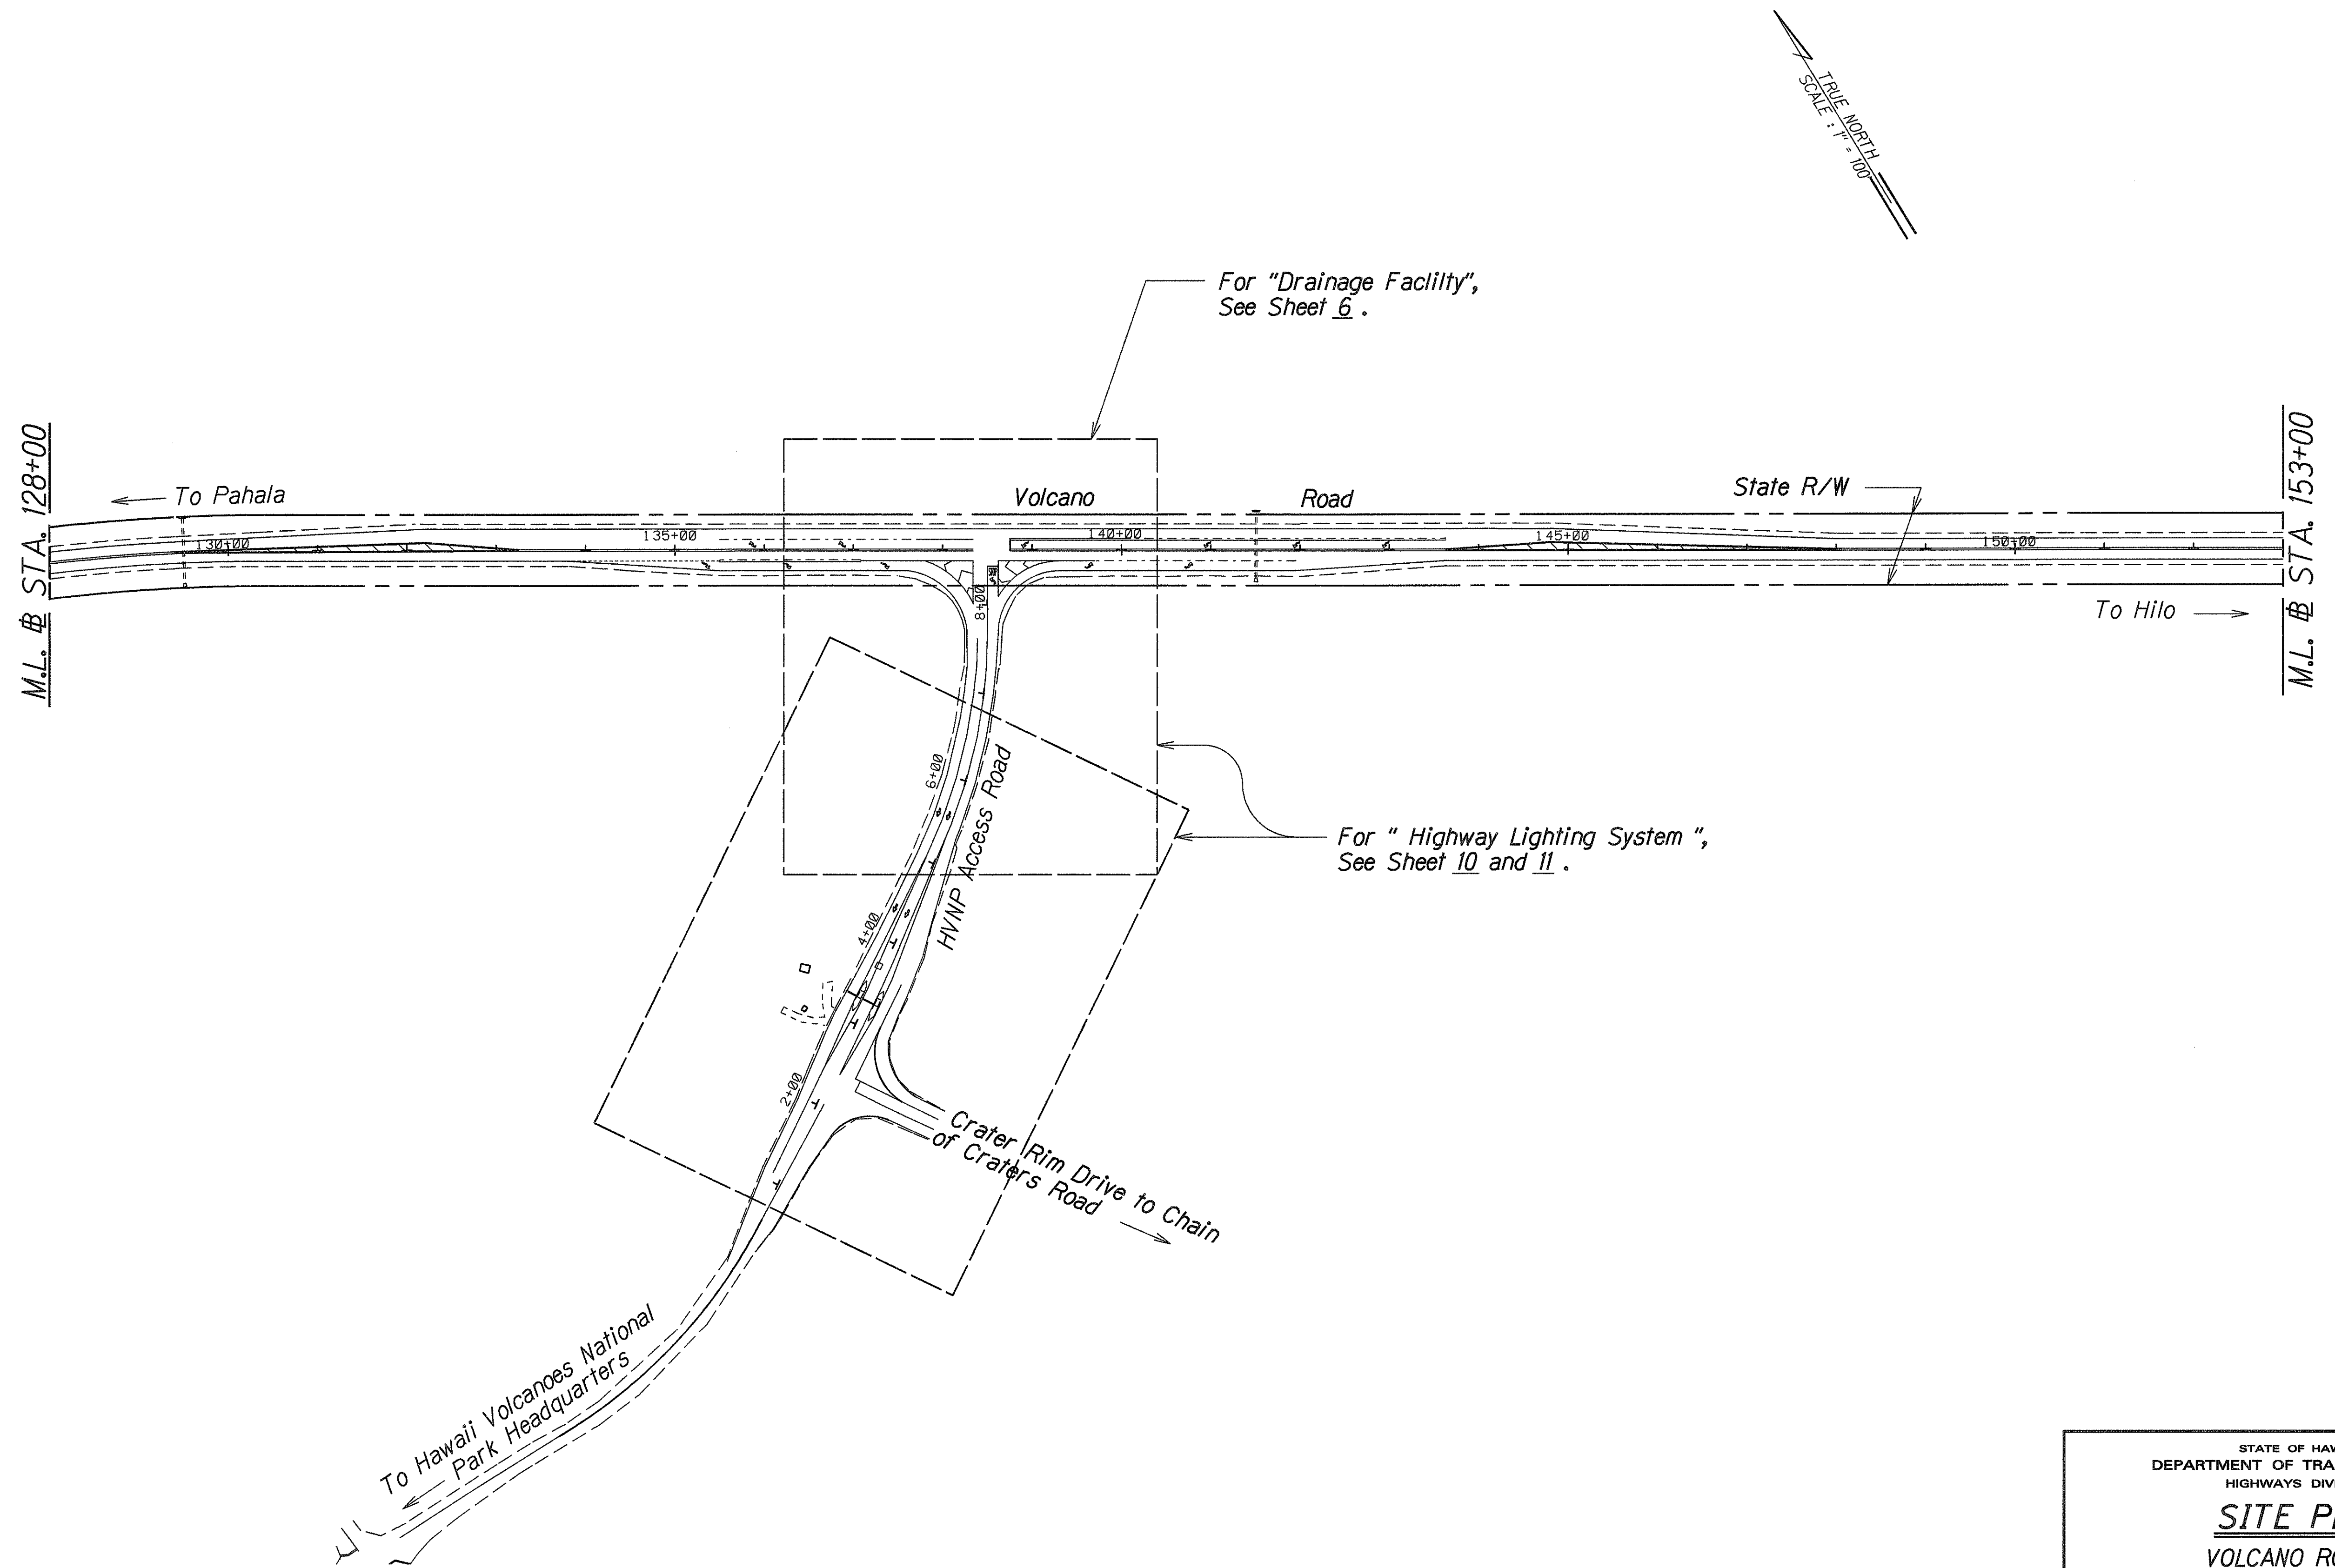

ORIGINAL PLAN	SURVEY PLOTTED BY	DATE
NOTE BOOK	DRAWN BY	
NOTES	TRACED BY	
QUANTITIES BY	CHECKED BY	
NO. 506500000		

STATE OF HAWAII
DEPARTMENT OF TRANSPORTATION
HIGHWAYS DIVISION

SITE PLAN
VOLCANO ROAD
INTERSECTION IMPROVEMENTS FOR
THE HVNP MAIN ENTRANCE
FED. AID PROJECT NO. FLH-011-2(34)
Scale: 1" = 100' Date: Nov., 1999

SHEET No. 1 OF 1 SHEETS