
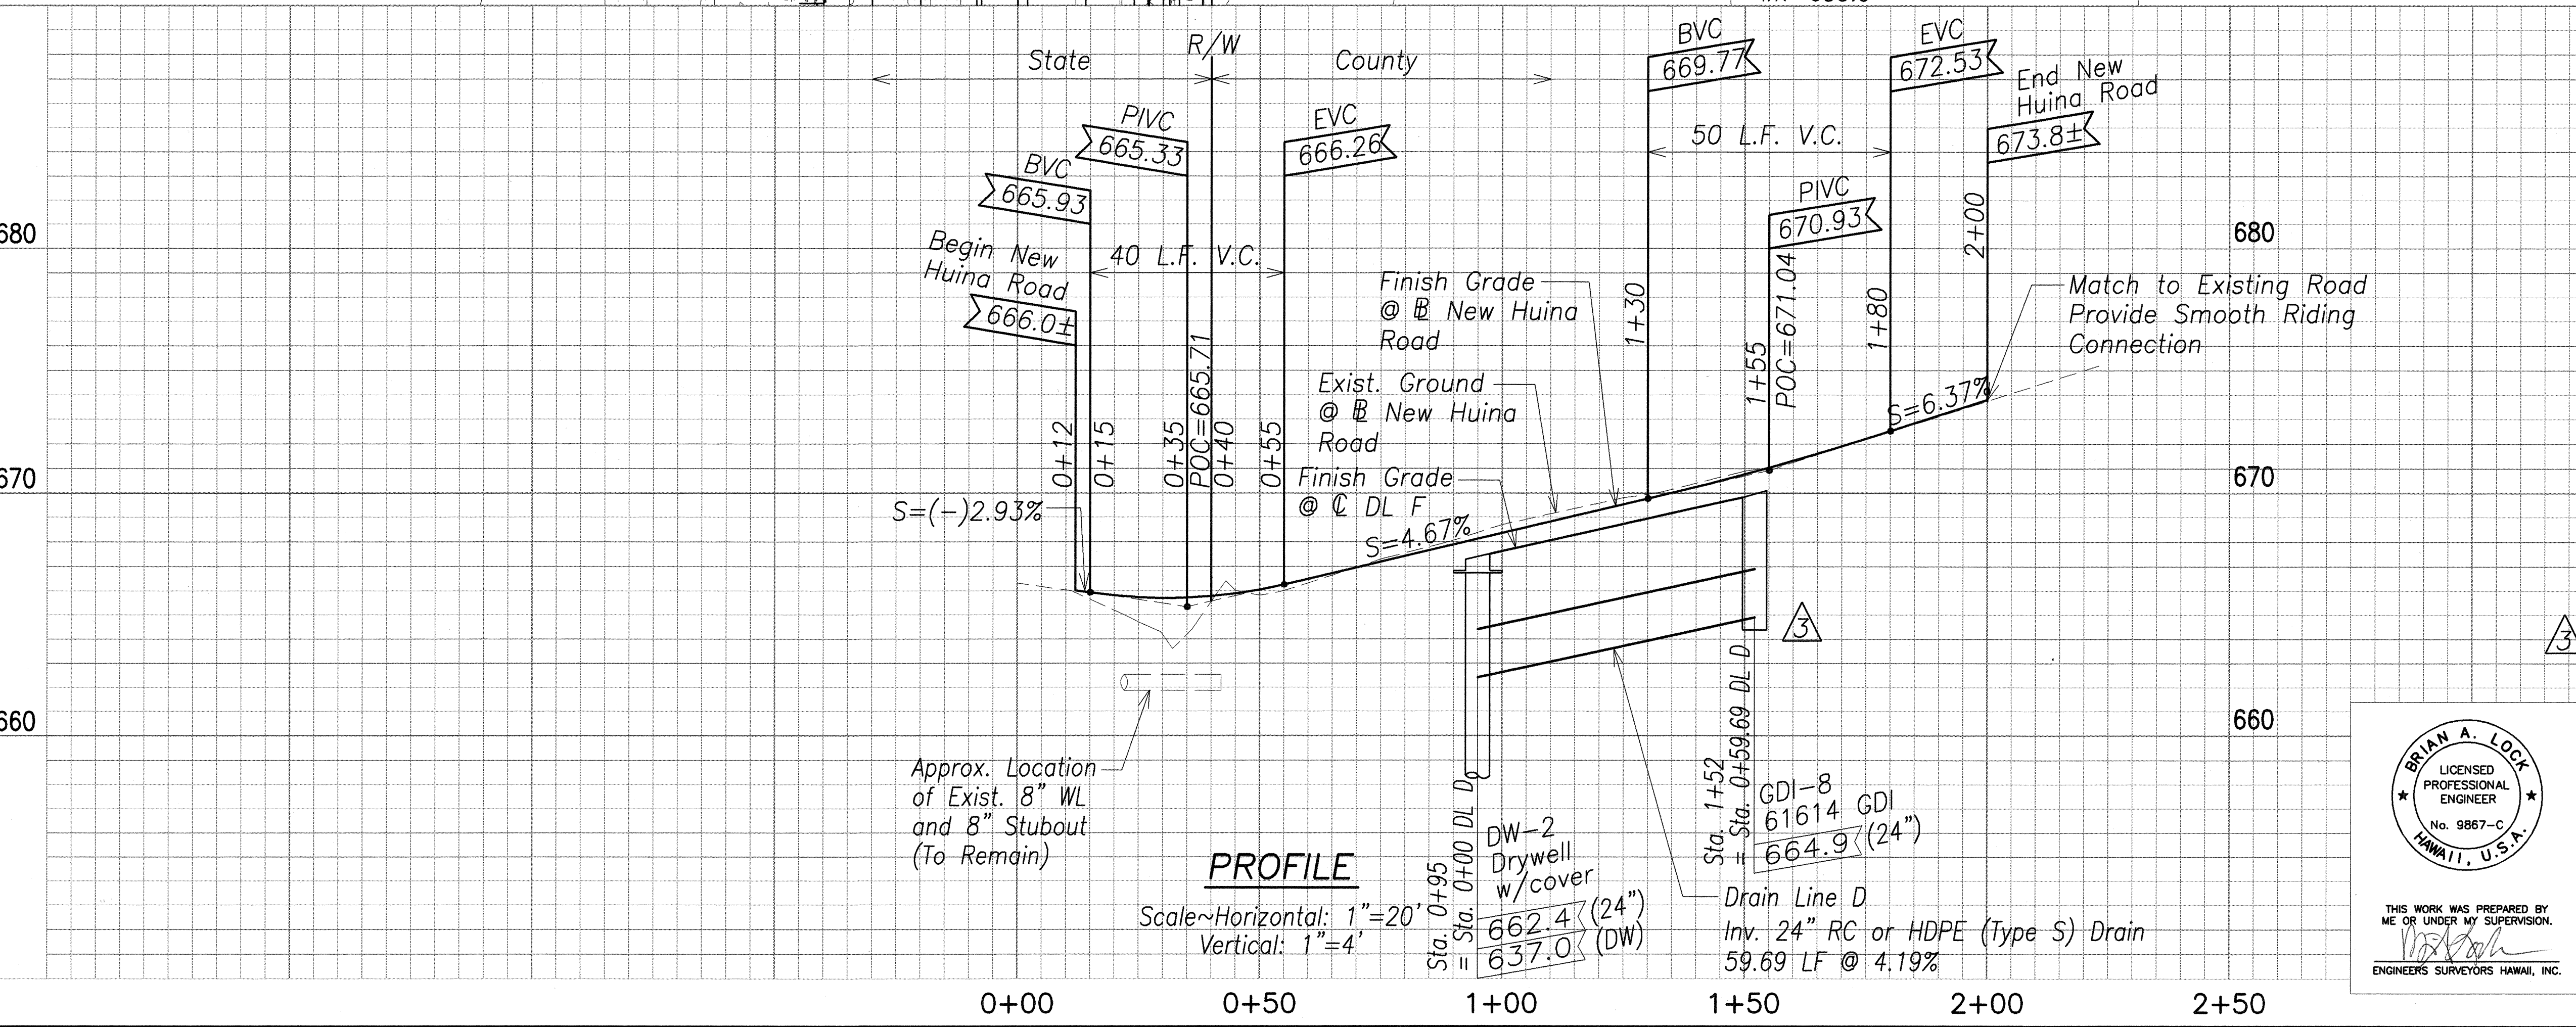



FED. ROAD DIST. NO.	STATE	PROJ. NO.	FISCAL YEAR	SHEET NO.	TOTAL SHEETS
HAWAII	HAW.	11M-01-00	2002	ADD. 18	65

LEGEND

-
-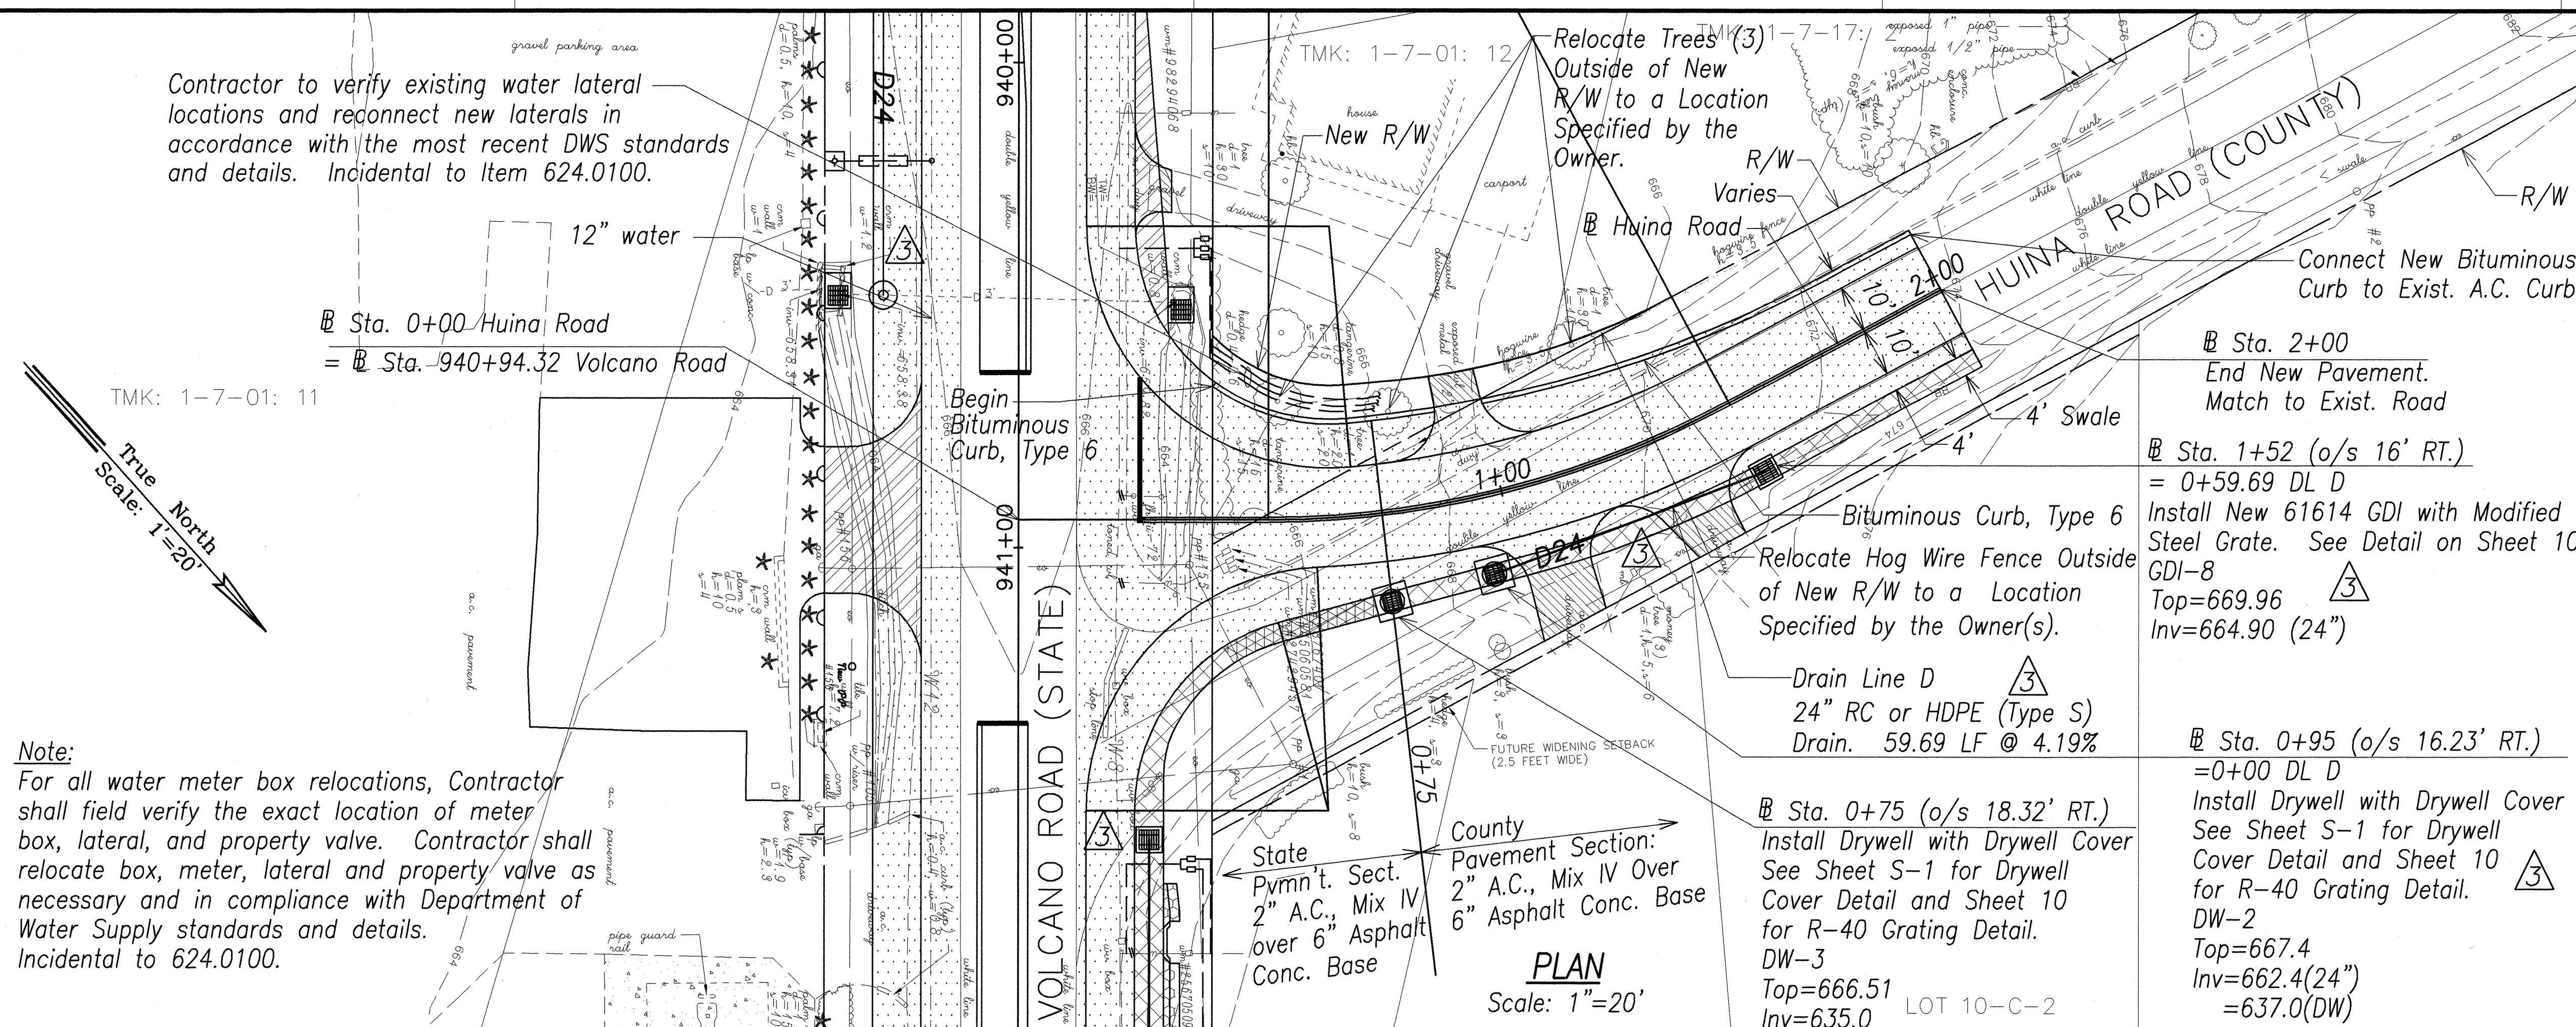
04/29/02	Revised DL A; Added DL C, AND DL D.
Date	Revision

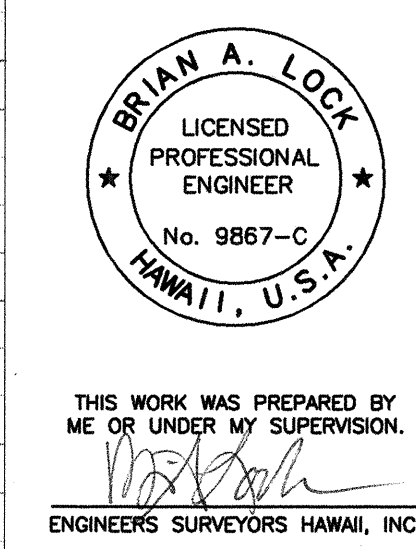

STATE OF HAWAII
DEPARTMENT OF TRANSPORTATION
HIGHWAYS DIVISION

PLAN AND PROFILE

**VOLCANO ROAD INTERSECTION
IMPROVEMENTS AT HUINA ROAD**
Project No. 11M-01-00

Scale: 1" = 20' Date: April 2002

SHEET No. 1 OF 1 SHEETS