


FED. ROAD DIST. NO.	STATE	FED. AID PROJ. NO.	FISCAL YEAR	SHEET NO.	TOTAL SHEETS
HAWAII	HAW.	ER-12(3)	2002	12	107

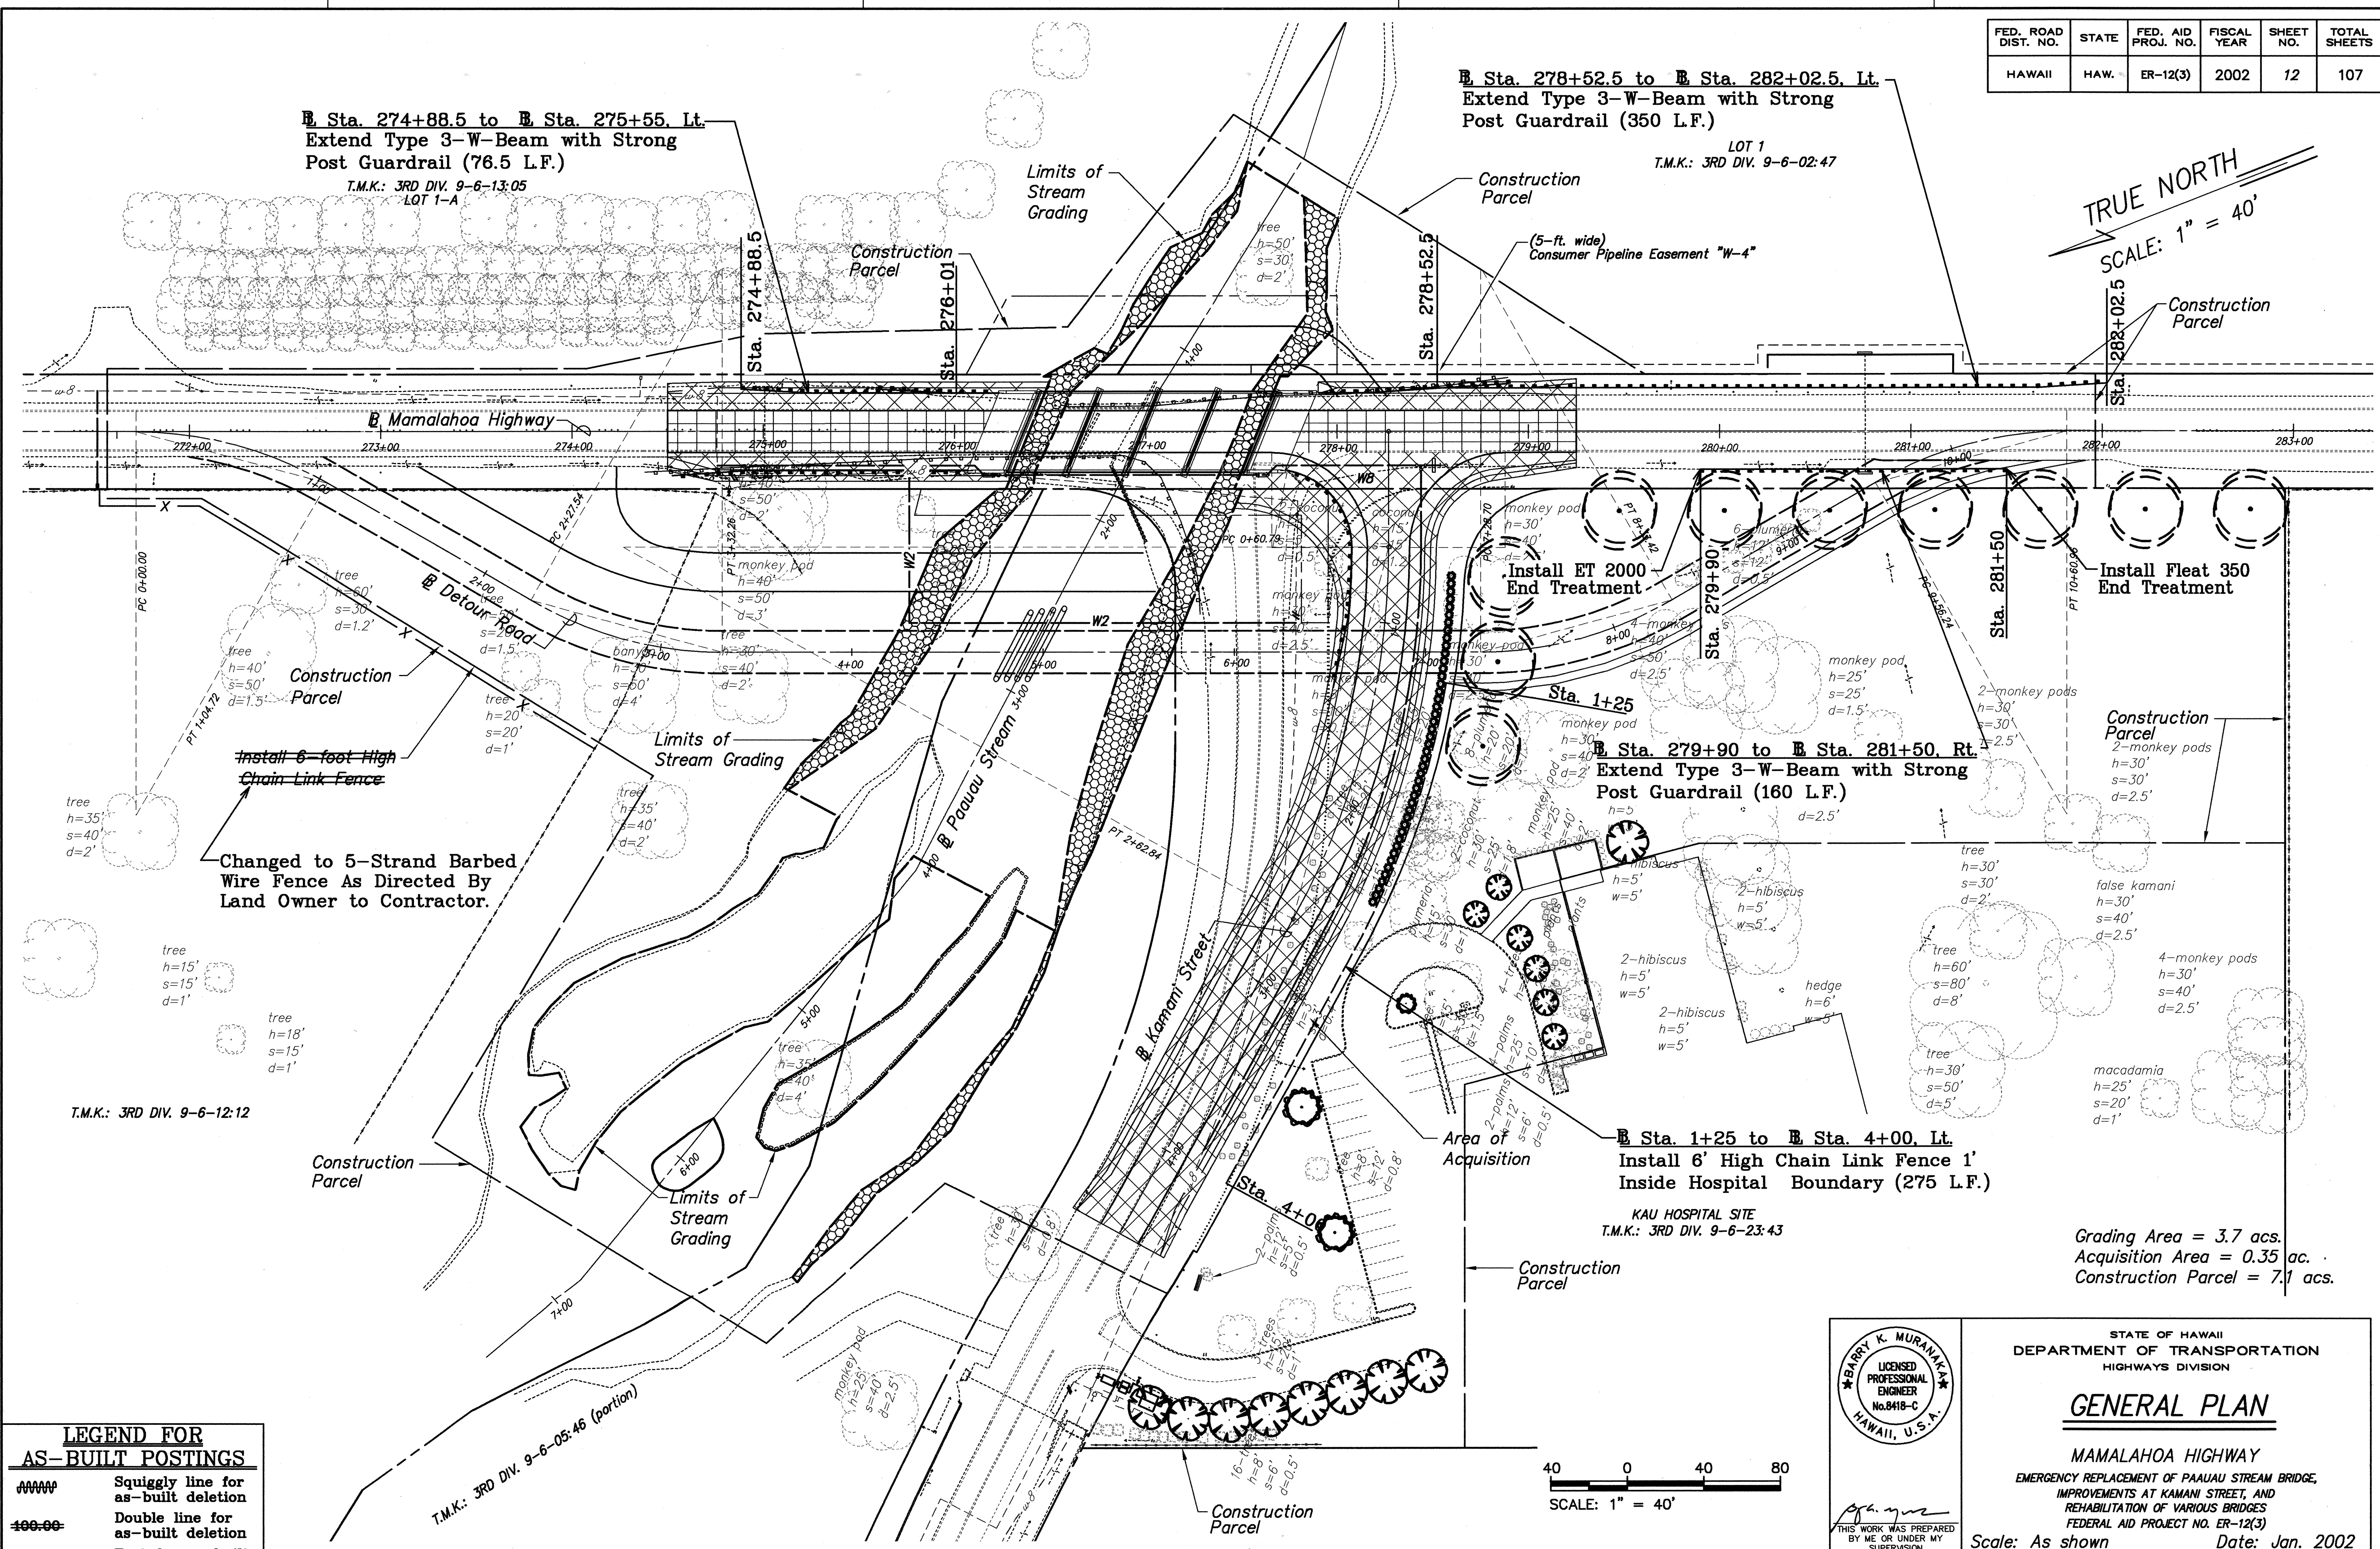


P.M.: BKM
CURRENT OPR: rki
PREV. OPR:
CURRENT TIME: Jul 11, 2003 - 4:42pm
LAST SAVED BY: rki
LAST MODIFIED: Fri, 11 Jul 2003 - 4:03pm

PREP: G:\K000-01\ACAD\FILE: K0005.dwg
BEGIN: 12/26/00
SCALE: 1"=1'

DATE	SURVEY PLOTTED BY
	DRWN BY
	TRACED BY
	DESIGNED BY
	QUANTITIES BY
	CHECKED BY
	NO.

LEGEND FOR AS-BUILT POSTINGS	
~~~~~	Squiggly line for as-built deletion
==	Double line for as-built deletion
Text	Text for as-built posting

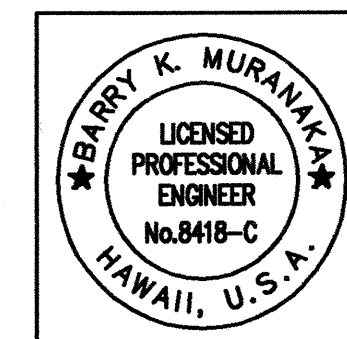

STATE OF HAWAII  
DEPARTMENT OF TRANSPORTATION  
HIGHWAYS DIVISION

**GENERAL PLAN**

MAMALAHOA HIGHWAY  
EMERGENCY REPLACEMENT OF PAAUI STREAM BRIDGE,  
IMPROVEMENTS AT KAMANI STREET, AND  
REHABILITATION OF VARIOUS BRIDGES  
FEDERAL AID PROJECT NO. ER-12(3)

Scale: As shown Date: Jan. 2002

SHEET NO. 1 OF 1 SHEETS