


	PAVEMENT MARKING SUMMARY					
	DESCRIPTION	QUANTITY				
	Pavement Markers Type A Type C Type D Type H Type J	Ea. 84 Ea. 55 Ea. Ea. Ea.				
*	Tape — Type I or Thermoplastic Extrusion 4—inch Pavement Stripe (White)	L.F. L.F. L.F. L.F. 950 L.F. L.F.				
**	Tape — Type II or Thermoplastic Extrusion 4—inch Pavement Stripe (White)	1000 L.F L.F. 2258 L.F L.F L.F L.F.				
***	Tape — Type III or Thermoplastic Extrusion 4—inch Pavement Stripe (White) 4—inch Pavement Stripe (Yellow) 8—inch Pavement Stripe (White) 12—inch Pavement Stripe (White) Crosswalk Markings ————————————————————————————————————	L.F. 25 L.F L.F. 55 L.F Ea Ea Ea.				

- * Tape, Type I or Thermoplastic Extrusion (No passing zones, channelizing lines, solid lines or pavement arrows)
- ** Tape, Type II or Thermoplastic Extrusion (Transverse median markings, transverse shoulder markings, channelizing islands or edge striping)
- *** Tape, Type III or Thermoplastic Extrusion (Guide lines, stop lines, extension of edge lines or crosswalk markings)

	REFLECTOR MARKER SUMMARY							
TYPE	WITH POST	WITH FLEXIBLE POST	WITHOUT POST					
RM-3 (YELLOW)	34	·						
RM-4 (YELLOW)	12							
RM-5 (WHITE)	12							
OM II		2	20					

FED. ROAD DIST. NO.	STATE	FED. AID PROJ. NO.	FISCAL YEAR	SHEET NO.	TOTAL SHEETS
HAWAII	HAW.	ER-12(3)	2002	47	107

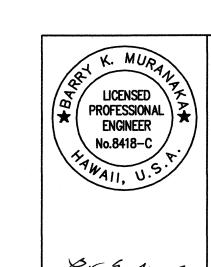

STATE OF HAWAII DEPARTMENT OF TRANSPORTATION HIGHWAYS DIVISION

TRAFFIC AND PAVEMENT MARKINGS SUMMARY

MAMALAHOA HIGHWAY

EMERGENCY REPLACEMENT OF PAAUAU STREAM BRIDGE,
IMPROVEMENTS AT KAMANI STREET, AND
REHABILITATION OF VARIOUS BRIDGES
FEDERAL AID PROJECT NO. ER-12(3) THIS WORK WAS PREPARED BY ME OR UNDER MY SUPERVISION

THIS WORK WAS PREPARED FEDERAL AS Shown

Date: Jan. 2002

SHEET NO. 1 OF 1 SHEETS